

UNIT 2

Gate 1


KEY

North Canyon  
Estates Homes

Gate/ Pedestrian

Common Area

UNIT 1

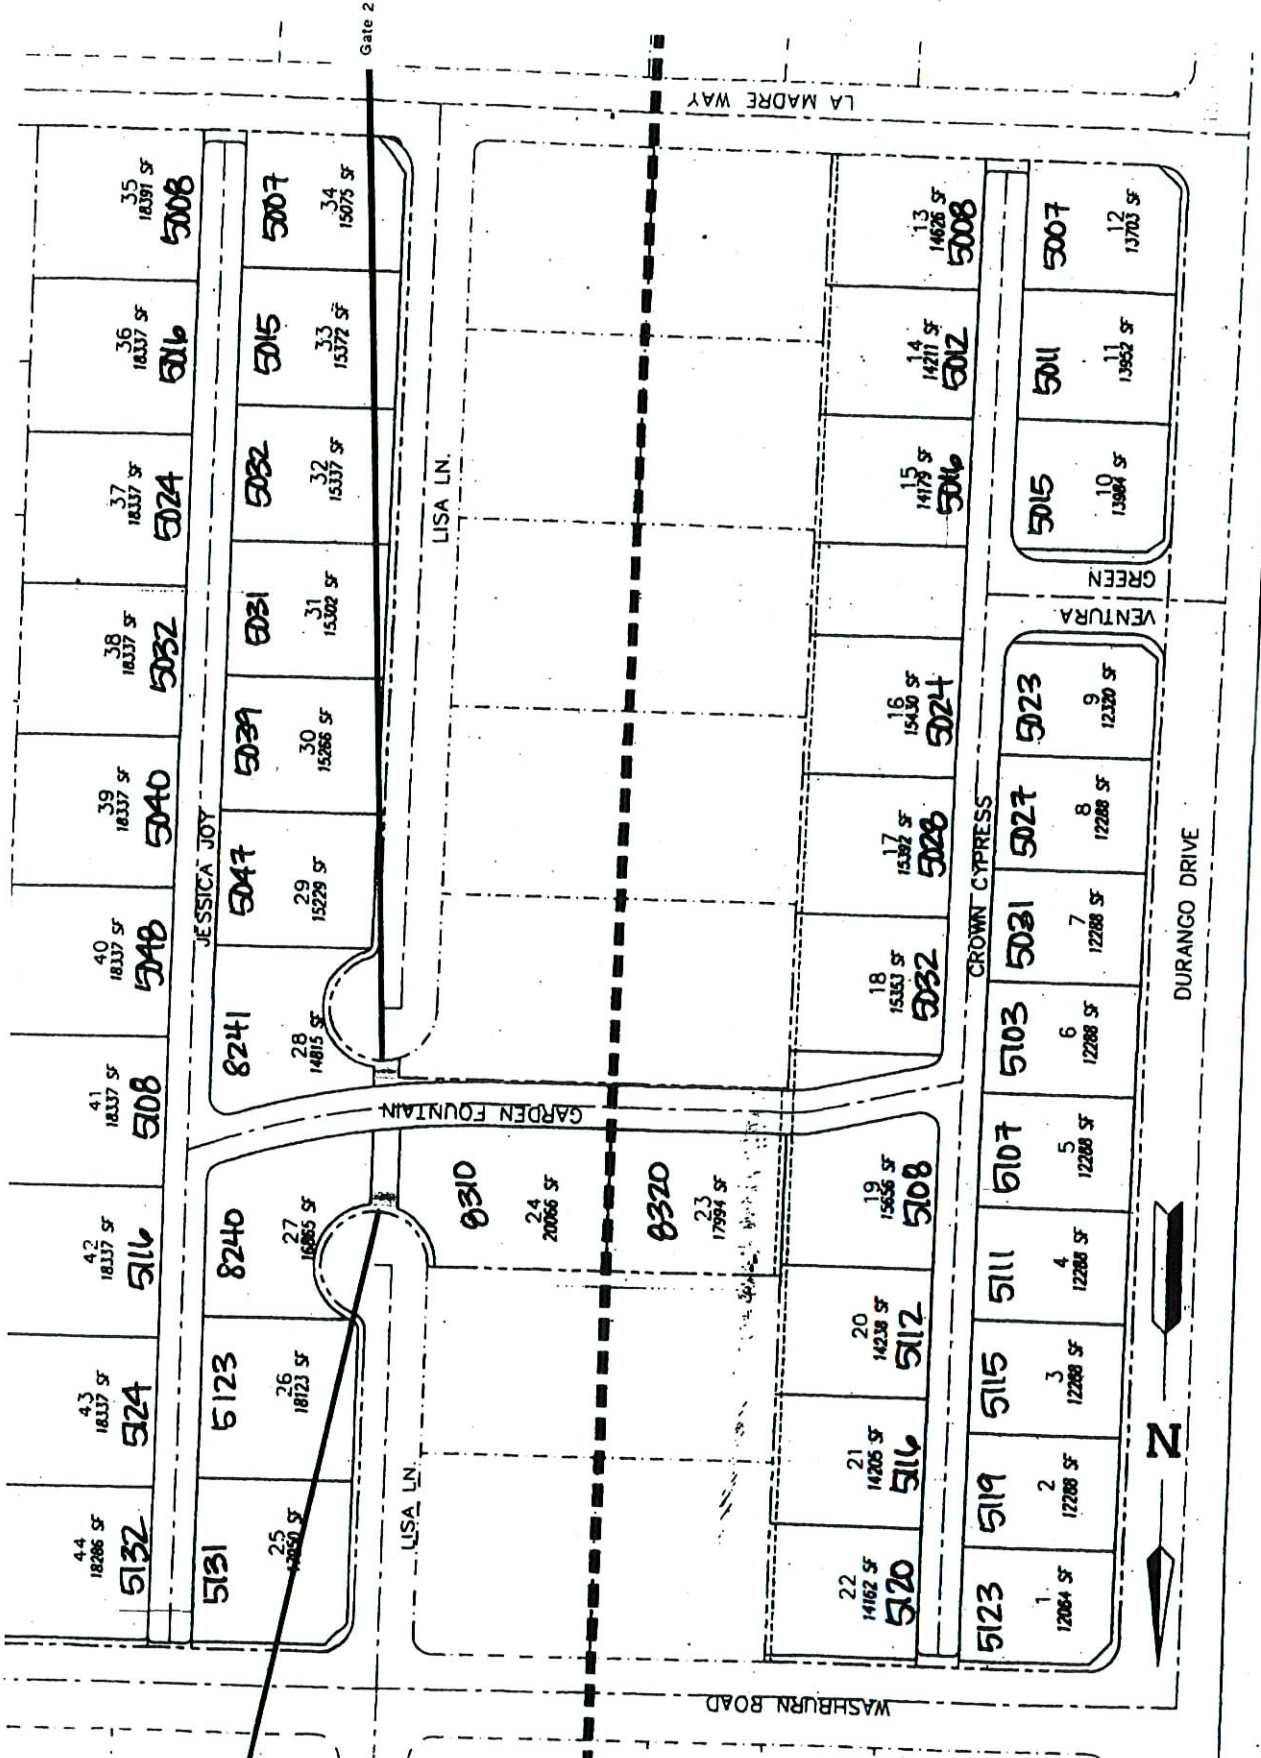

RQR-32160  
12-17-08 CC