


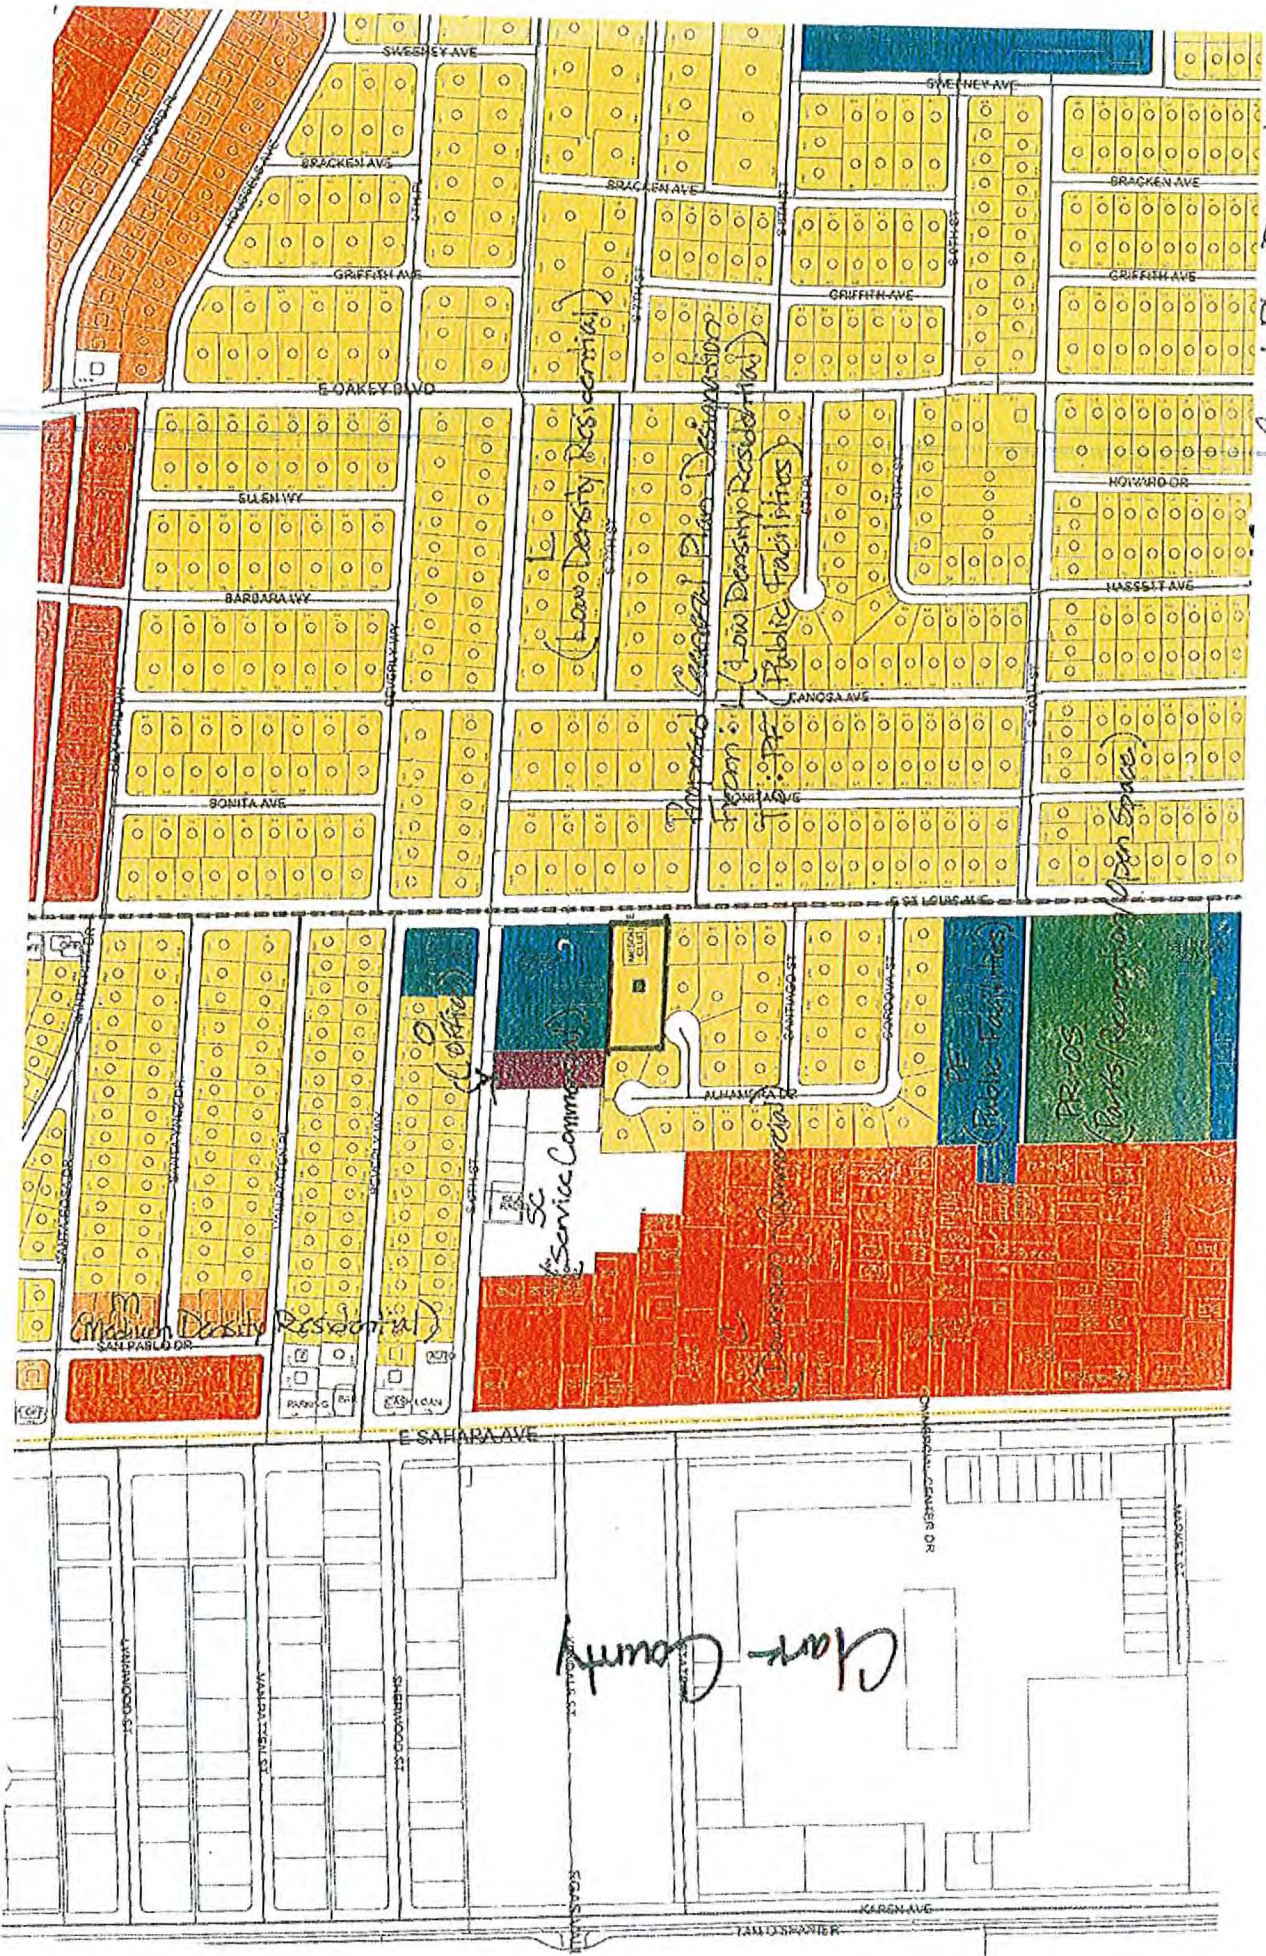



General Plan Designation

GPA-32139
01/08/09 PC