



PLANNING & DEVELOPMENT DEPARTMENT

STATEMENT OF FINANCIAL INTEREST

Case Number: **SUP-33536** APN: 138-12-110-012
Name of Property Owner: Guidas Northridge Plaza, LLC
Name of Applicant: Jing YAO Li
Name of Representative: DuWayne Stacy

To the best of your knowledge, does the Mayor or any member of the City Council or Planning Commission have any financial interest in this or any other property with the property owner, applicant, the property owner or applicant's general or limited partners, or an officer of their corporation or limited liability company?

☐ Yes

☒ No

If yes, please indicate the member of the City Council or Planning Commission who is involved and list the name(s) of the person or persons with whom the City Official holds an interest. Also list the Assessor's Parcel Number if the property in which the interest is held is different from the case parcel.

City Official: _____

Partner(s): _____

APN: _____


Signature of Property Owner: [Signature]

Print Name: GUIDAS SAKYS


Subscribed and sworn before me

This 12th day of February, 2009

[Signature]
Notary Public in and for said County and State

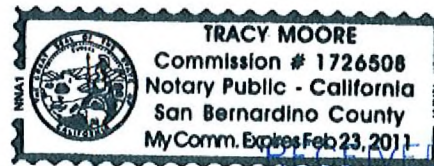


FEB 19 2009

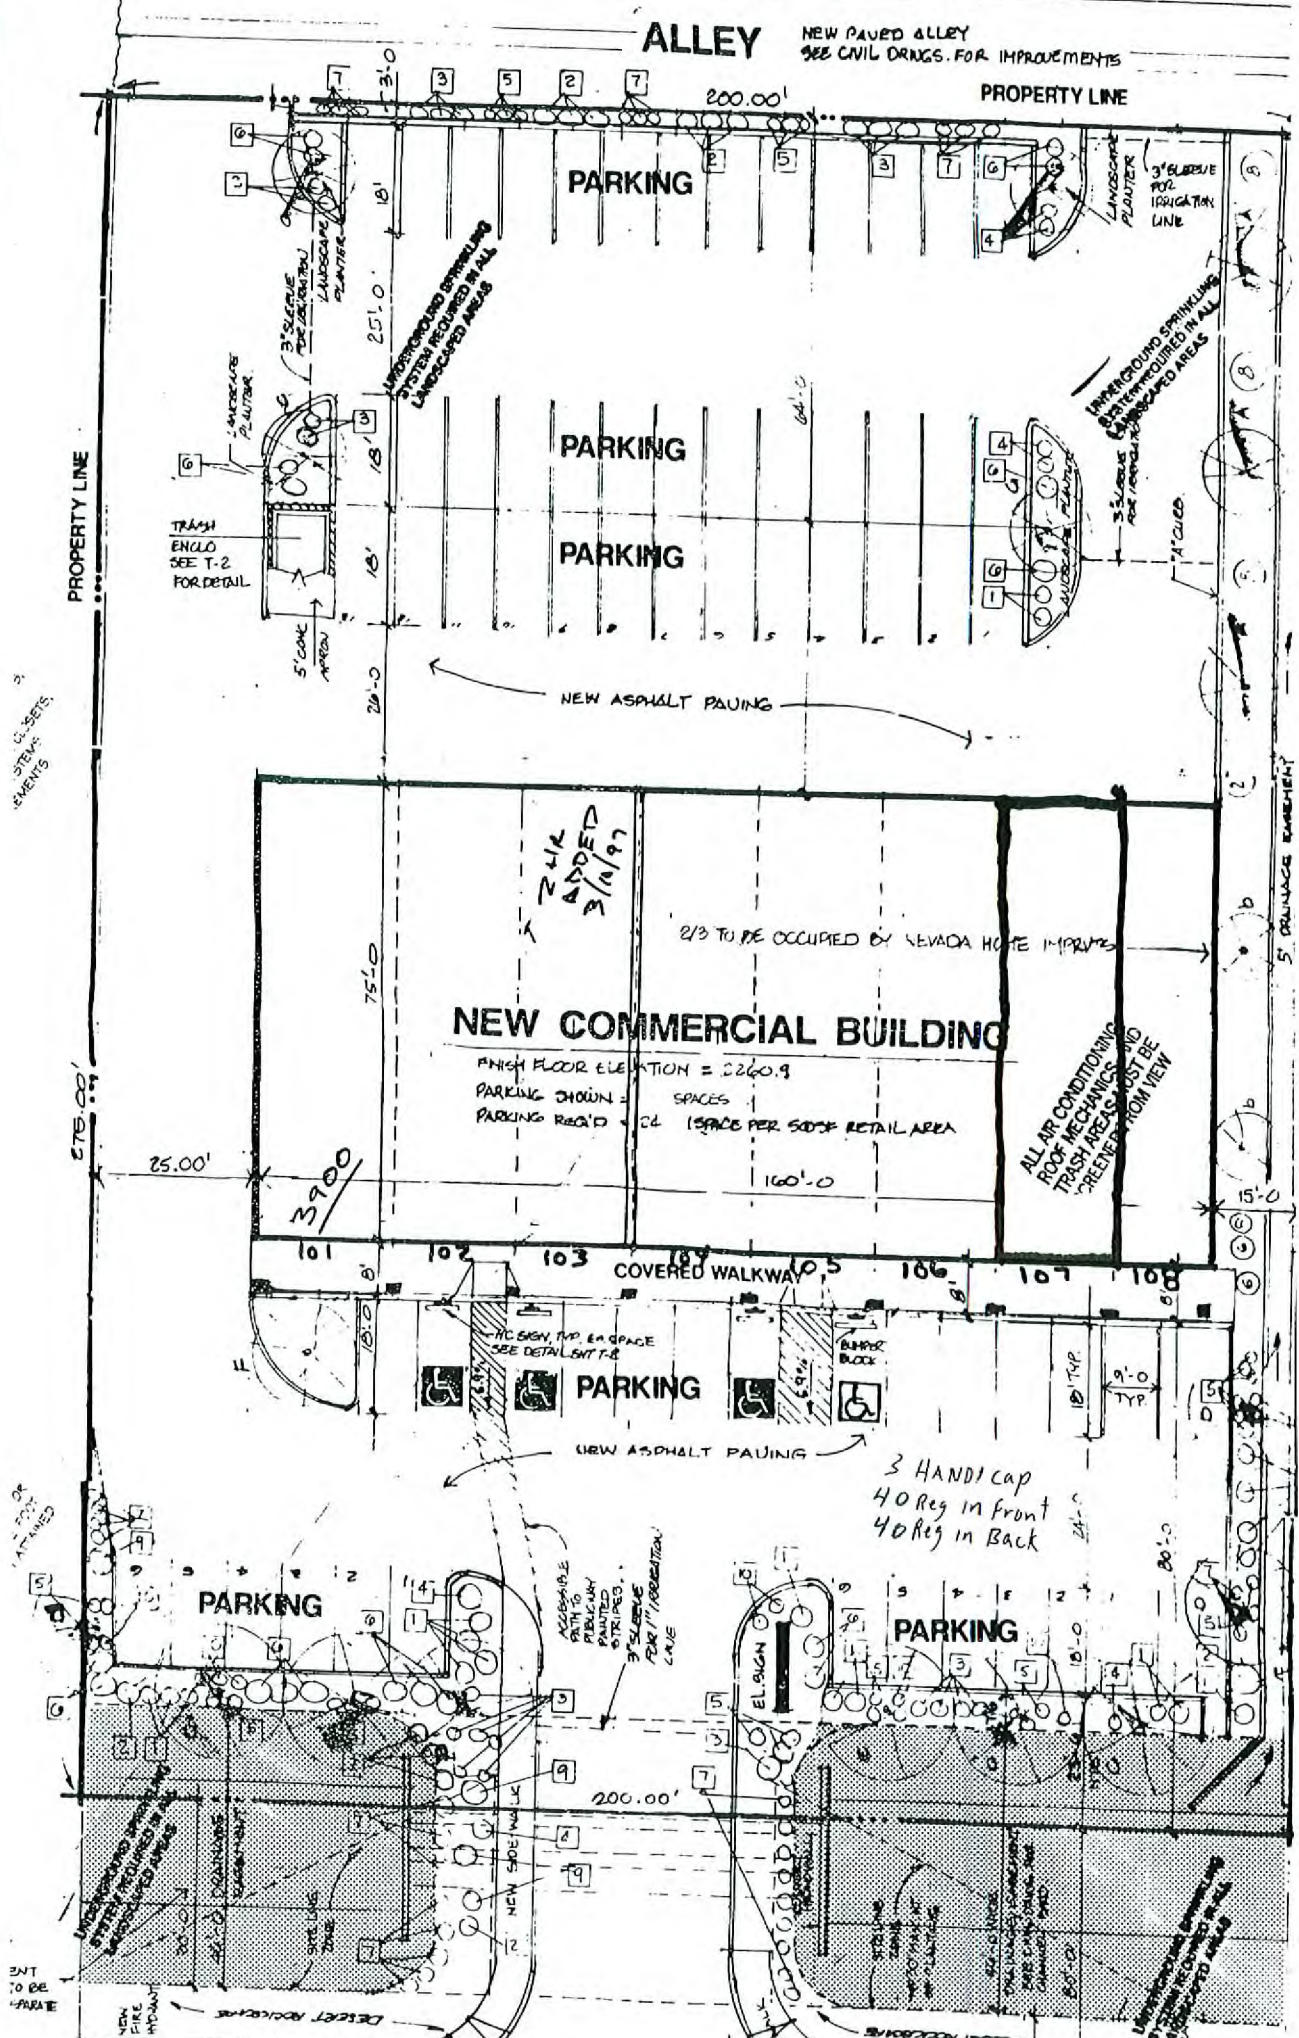

SUP-33536
04/09/09 PC

RECEIVED
FEB 19 2009

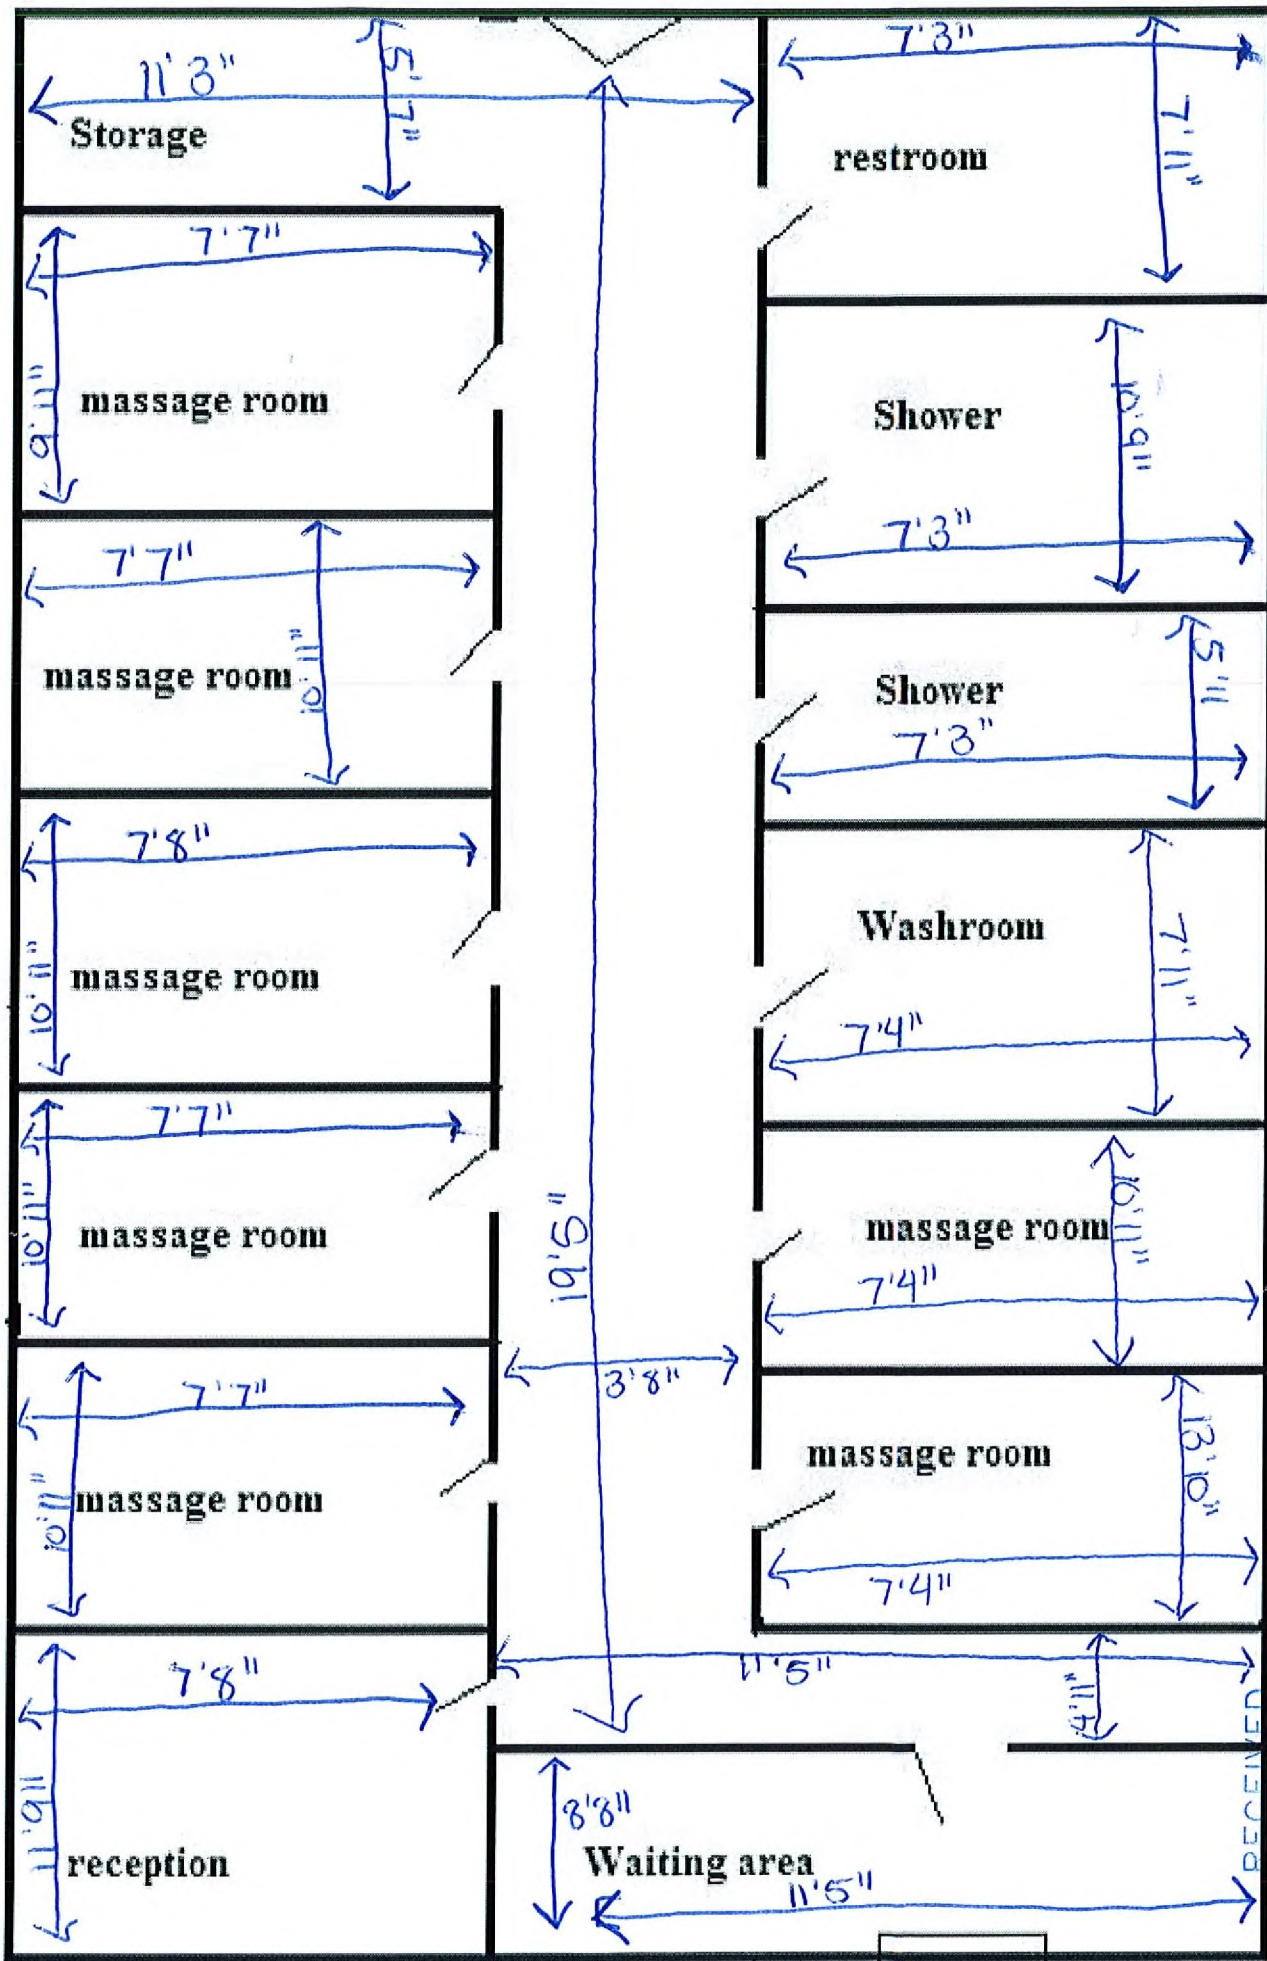

* not drawn to scale

Page 3 of 3

SUP-33536
04/09/09 PC

FEB 19 2009