



PLANNING & DEVELOPMENT DEPARTMENT

STATEMENT OF FINANCIAL INTEREST

Case Number: **SUP-33604** APN: _____

Name of Property Owner: Quail Valley View LLC

Name of Applicant: ANNIE PHILLIPS

Name of Representative: ANNIE PHILLIPS

To the best of your knowledge, does the Mayor or any member of the City Council or Planning Commission have any financial interest in this or any other property with the property owner, applicant, the property owner or applicant's general or limited partners, or an officer of their corporation or limited liability company?

☐ Yes

☒ No

If yes, please indicate the member of the City Council or Planning Commission who is involved and list the name(s) of the person or persons with whom the City Official holds an interest. Also list the Assessor's Parcel Number if the property in which the interest is held is different from the case parcel.

City Official: _____

Partner(s): _____

APN: _____


Signature of Property Owner: Patricia L. Krom


Print Name: PATRICIA L. KROM

Subscribed and sworn before me

This 17th day of February, 20 09


Tanesha Williams Clark Nevada
Notary Public in and for said County and State

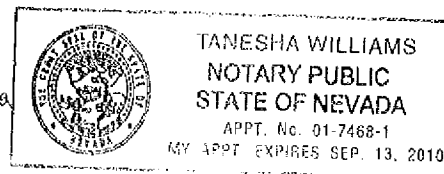

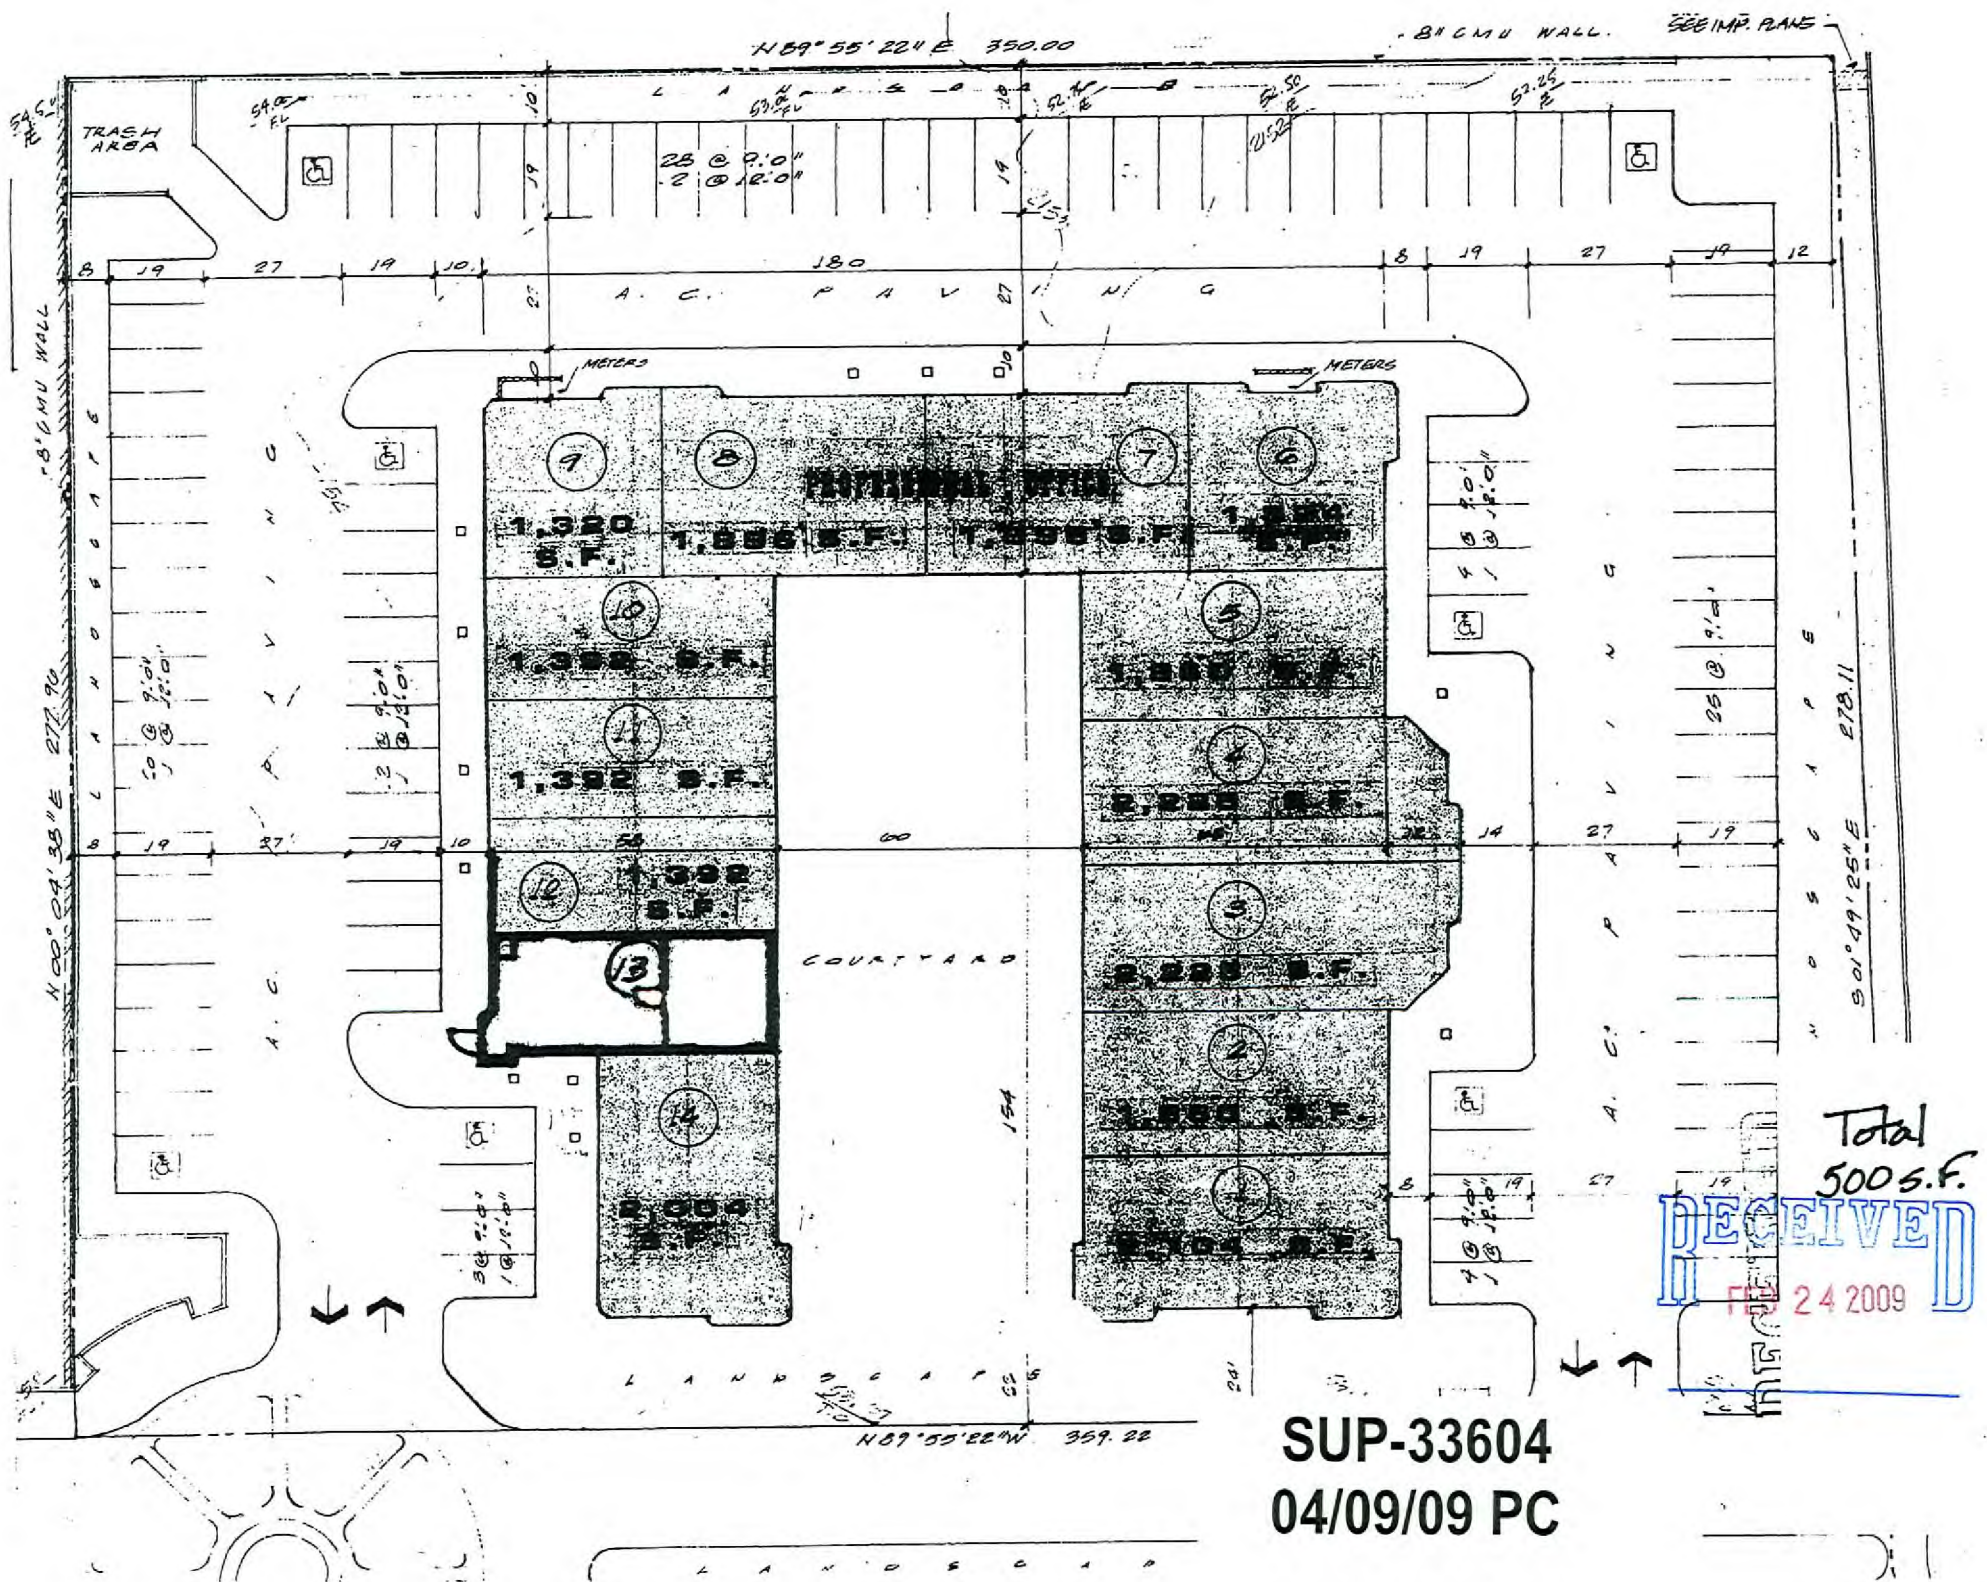

RECEIVED
MAR 17 2009

My office is outlined in yellow
the other part is blocked off
Annie Phillips

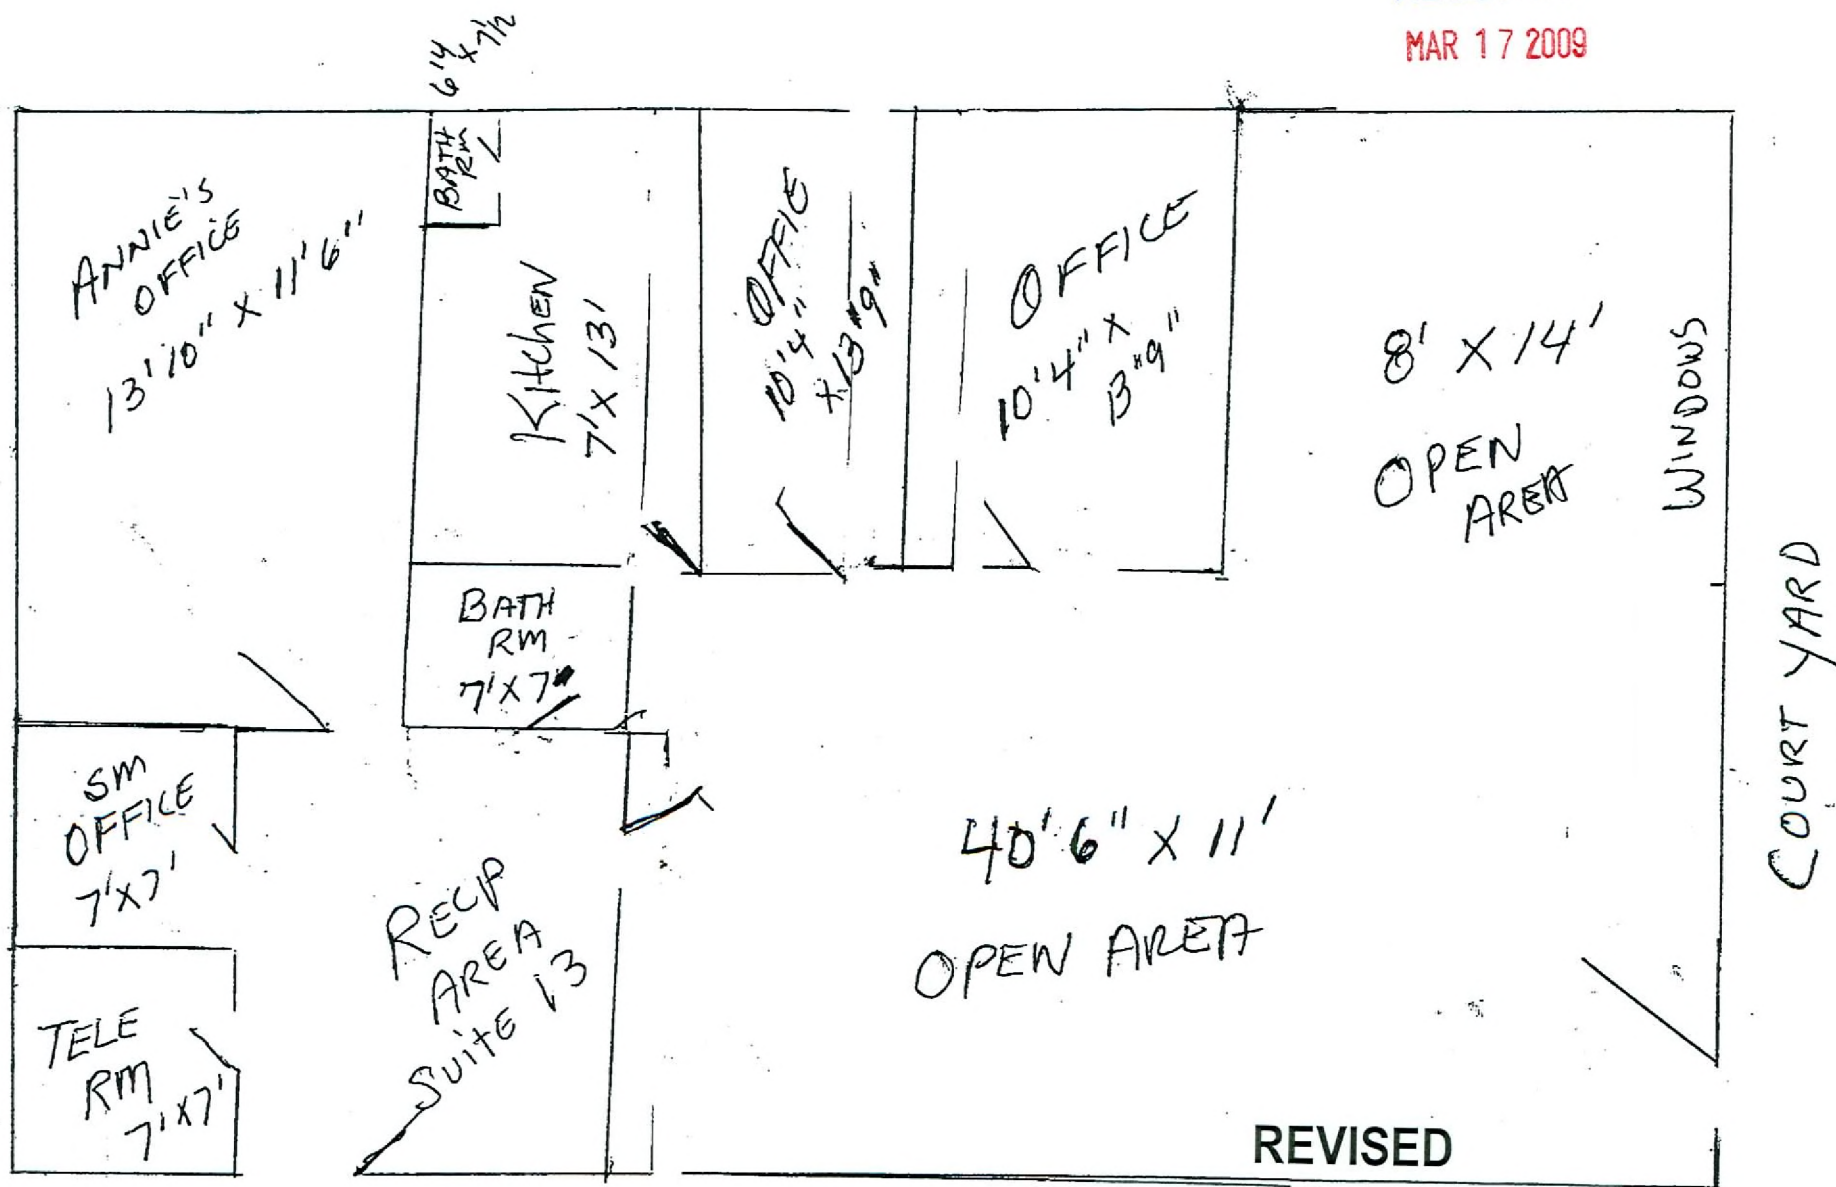

REVISED

SUP-33604
04/09/09 PC