

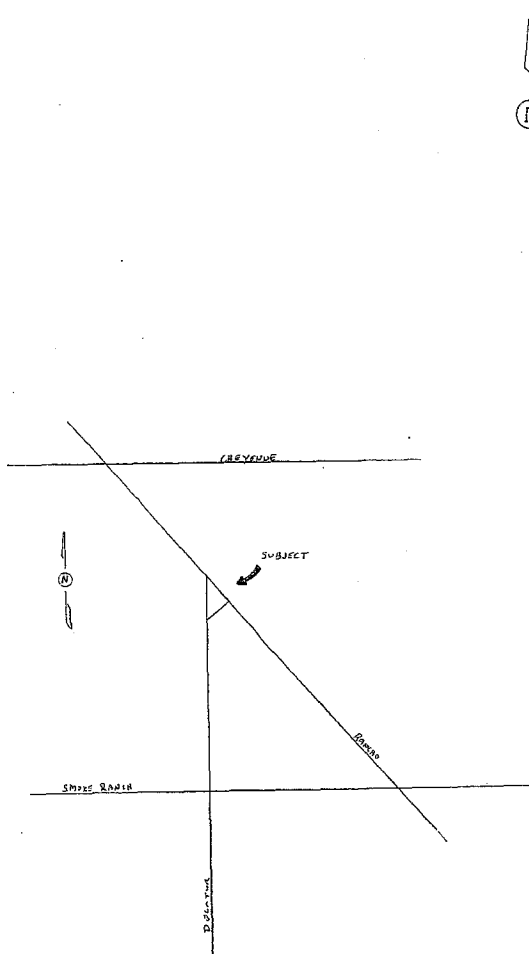


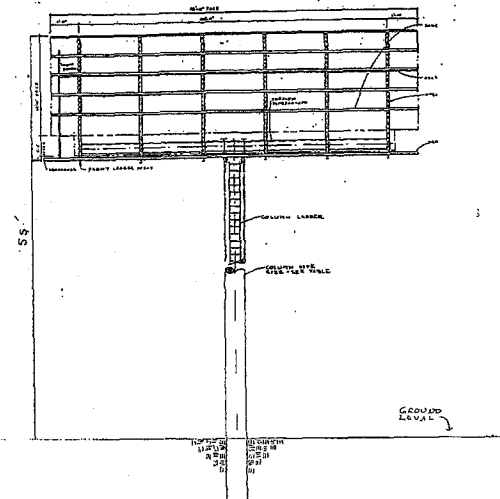

DECATUR

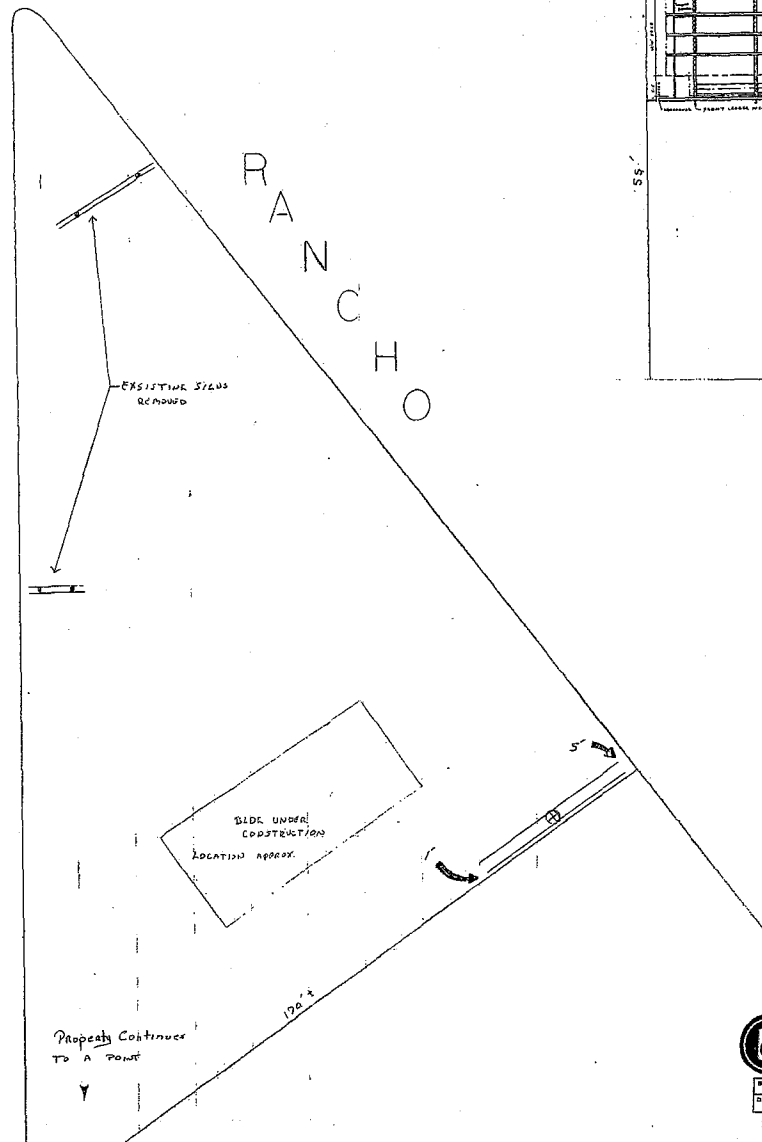

ch DONREY ch

SCALE: 1" = 10'	DRAWING NUMBER: 1	PROJECT: M.S. WEINS RELOCATION
DATE: 7-24-97		
1221 West Bonanza Road Drawn By Michael Petrac Phone 382-5020		

RQR-33320
04/09/09 PC