



PLANNING & DEVELOPMENT DEPARTMENT

STATEMENT OF FINANCIAL INTEREST

Case Number: **WVR-32158** APN: 125-20-214-041

Name of Property Owner: SPINNAKER HOMES V L L C

Name of Applicant: Royal Construction

Name of Representative: TCE

To the best of your knowledge, does the Mayor or any member of the City Council or Planning Commission have any financial interest in this or any other property with the property owner, applicant, the property owner or applicant's general or limited partners, or an officer of their corporation or limited liability company?

☐ Yes

☒ No

If yes, please indicate the member of the City Council or Planning Commission who is involved and list the name(s) of the person or persons with whom the City Official holds an interest. Also list the Assessor's Parcel Number if the property in which the interest is held is different from the case parcel.

City Official: _____

Partner(s): _____

APN: _____

Signature of Property Owner: _____

Print Name: STEPHEN B. KIZENBERG, PRESIDENT

Subscribed and sworn before me

This 22nd day of May, 2008

Bonnie Funnell
Notary Public in and for said County and State



NOV 25 2008

WVR-32158
01/08/09 PC

SPINNAKER • TOWNCENTER - UNIT 4
SIDEWALK EXHIBIT

ROYAL CONSTRUCTION
451 W. CHELSEA AVENUE, SUITE 105 LAS VEGAS, NV 89032
FAC(702) 873-7775

THOMSON CONSULTING ENGINEERS
3277 E. WARD SPRINGS ROAD, SUITE 400
LAS VEGAS, NEVADA 89120
702-932-6125 FAX: 702-932-6129

KEYMAP

VICINITY MAP
NOT TO SCALE

Centennial	Buranga		
	Tropical		Eltham
	El Capitan		Dorrell
	Camblet		
Fort Apache			

REBERTLY M. CARTER

[illegible]

12+00

13+00

SYMBOL	BOTANICAL NAME	COMMON NAME	SIZE	QT Y
TREES:				
	CHITALPA TASKENTENSIS 'PINK DAWN'	PINK DAWN CHITALPA	36" BOX	4
	FRAXINUS VELUTINA 'RIO GRANDE'	PAN-TAX ASH TREES LOCATION (RELATIVE AS NEEDED)	36" BOX	14
	ROBINIA AUBIGUA 'PURPLE ROBE'	PURPLE ROBE LOCUST	36" BOX	10
	WASHINGTONIA ROBUSTA	MEXICAN FAN PALM	25 BTH	52
SHRUBS:				
	CORDIA BOISSIERI	TEXAS OLIVE	15 GAL	1
	DASYLIRION LONGISSIMUM	MEXICAN GRASS TREE	15 GAL	48
	HESPERALOE PARVIFLORA	RED YUCCA	5 GAL	78
	LANTANA MONTEVIDENSIS	TRAILING LANTANA	5 GAL	96
	LEUCOPHYLLUM FRUTESCENS 'GREEN CLOUD'	GREEN CLOUD TEXAS RANGER	5 GAL	40
	MULHENERGIA RIGENS	DEER GRASS	5 GAL	49
	MYRTUS COMMUNIS 'COMPACTA'	DWARF MYRTLE	5 GAL	277
	ROSMARINUS OFFICINALIS 'TUSCAN BLUE'	UPRIGHT ROSEMARY	5 GAL	196
	SALVIA NEMOROSA 'OSTTRESLAND'	PURPLE SPIKE SAGE	1 GAL	94
	TEUCRIUM CHAMADERYNS	GERMANDER	5 GAL	117

- NOTES:
1. ALL PLANTING AREAS TO RECEIVE MOVABLE GROUND COMPOSED GRANITE COBBLES, SIZE 3" TO 6" DEPTH
 2. REMOVE ONLY DEAD LEAVES, LIMBS AND FRONDS FROM PLANTS; DO NOT PRUNE OR SHAPE. CONTRACTOR WILL BE RESPONSIBLE FOR REPLACING ANY AND ALL PLANTS DEEMED NOT ACCEPTABLE BY LANDSCAPE ARCHITECT.
 3. SIGHT VISION/RESTRICTIONS WILL MAKE IMPOSSIBLE TO FULFILL THE TOWN CENTER STANDARDS FOR CORNER CONDITIONS; NO ACCEENT TREE WILL BE PLACED AT THE FOLLOWING LOCATIONS: FORT APACHE & UMBELAND CORNERS AND DEER SPRINGS TROPICANE CORNER.
 4. 18" THICK RWP-404P INSTALLATION ALONG DORRILL LAWN PER TOWN CENTER DEVELOPMENT ELIMINATES THE POSSIBILITY OF ANY SHRUB INSTALLATION.
 5. CONTRACTOR TO VERIFY LOCATION OF EXISTING LANDSCAPE AND RELOCATE ACCORDING TO PLAN.

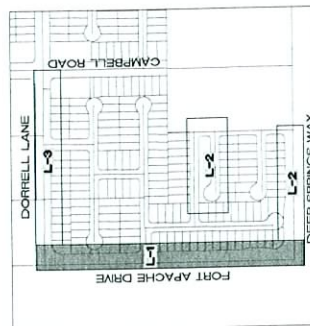

KEY MAP

NOT TO SCALE

RECEIVED

FEB 26 2009






GRAPHIC SCALE


WVR-32158





03/12/09 PC

REVISÉ

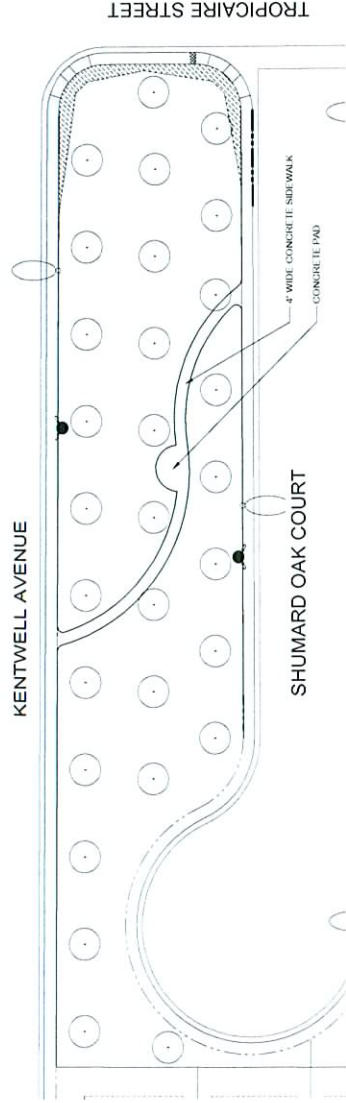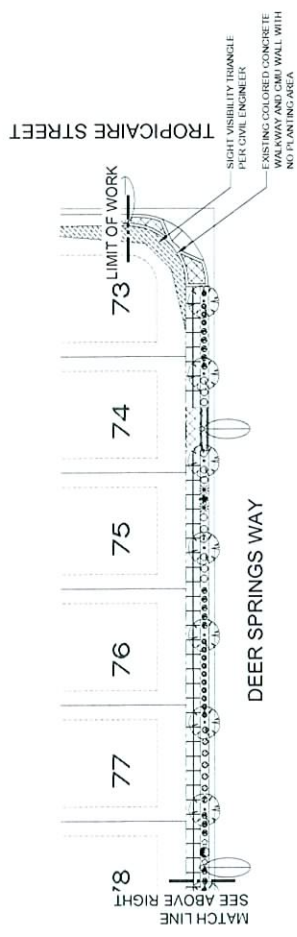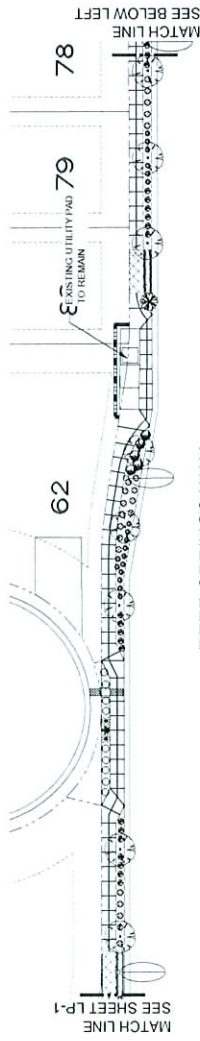

WVR-32158
03/12/09 PC
REVISED

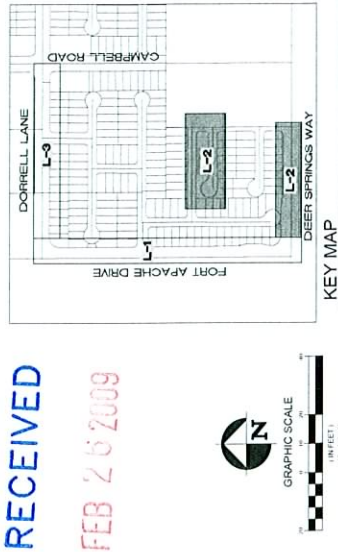[illegible]

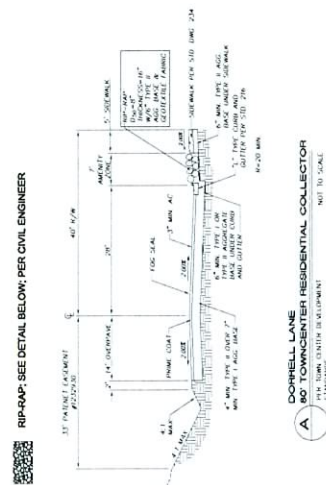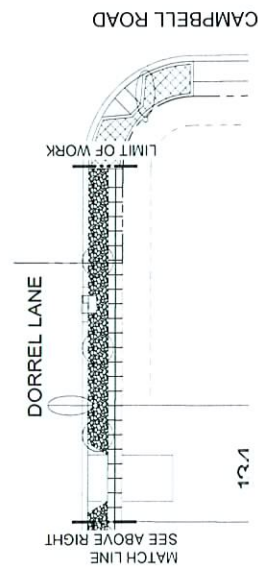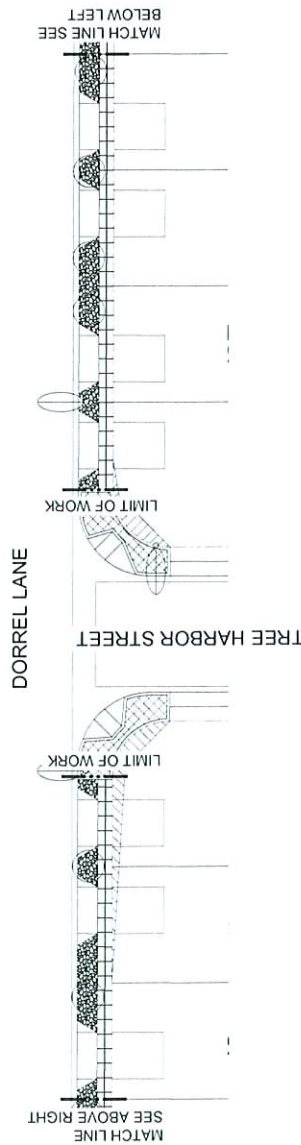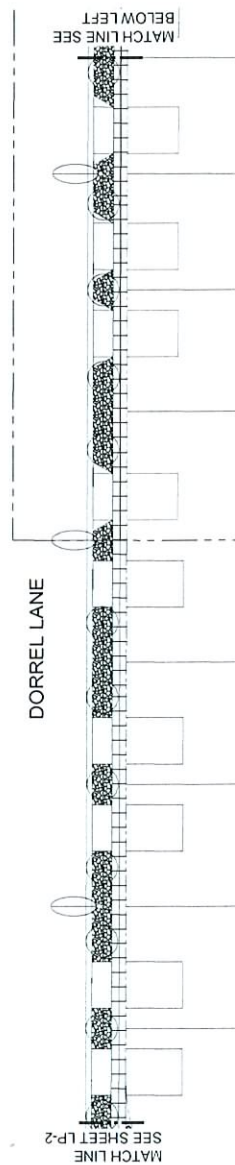

WVR-32158
03/12/09 PC
REVISED

PLANTING LEGEND:


SYMBOL	BOTANICAL NAME	COMMON NAME	SIZE	QTY
	CHITALPA TASKENTENSIS PINK DAWN	PINK DAWN CHITALPA	30" HOX	0
	EXISTING TREE TO REMAIN			21
	FRAXINUS VULPINATA GRACILE	FAN-LEAF ASH HONEY LOCUST TREE IS A LOCATION HONEY LOCUST	30" HOX	0
	ROBINIA AMBIGUA PURPLE RUBEE	PURPLE RUBEE LOCUST	30" HOX	0
	WASHINGTONIA KOBUSIA	MEXICAN FAN PALM	25 HTH	0
	CORDEA BURSERI	TEXAS OLIVE	15 GAL	0
	DASYLEIRON LONGISSIMUM	MEXICAN GRASS TREE	15 GAL	0
	HESTERALOE PARVIFLOA	RED YUCCA	5 GAL	0
	LANTANA MONTEVERDIS	TRAILING LANTANA	5 GAL	0
	LEUCOPHYLLUM FRUTESCENS GREEN CLOUDY	GREEN CLOUD TEXAS GANDER	5 GAL	0
	MULLENERGIA RIGENS	DEER GRASS	5 GAL	0
	MYRTUS COMMUNIS COMPACTA	DWARF MYRTLE	5 GAL	0
	ROSMARINUS OFFICINALIS TUSCAN BLUE	UPRIGHT ROSEMARY	5 GAL	0
	SALVIA NEMOROSA VERTRELIANT	PURPLE SPINE SAGE	1 GAL	0
	TEUCRIUM CHAMALYDYS	GERMANIER	5 GAL	0

NOTES:

1. ALL PLANTING AREAS TO RECEIVE MOJAVE GOLD DECOMPOSED GRANITE COBBLE, SIZE 3" TO 4" 6" DEPTH
2. REMOVE ONLY DEAD LEAVES, LIMBS AND FRONDS FROM PLANTS; DO NOT PRUNE OR SHAPE. CONTRACTOR WILL BE RESPONSIBLE FOR REPLACING ANY AND ALL PLANTS DEEMED NOT ACCEPTABLE BY LANDSCAPE ARCHITECT.
3. SIGHT VISIBILITY RESTRICTIONS WILL TAKE IMPOSSIBLE TO FULFILL THE TOWN CENTER STANDARDS FOR CORNER CONDITIONS; NO ACCENT TREE WILL BE PLACED AT THE FOLLOWING LOCATIONS: FORT APACHE & UMBELAND CORNERS AND DEER SPRINGS TROPICANE CORNER.
4. 16" THICK RIP-RAP INSTALLATION ALONG DORRELL LANE PER TOWN CENTER DEVELOPMENT ELIMINATES THE POSSIBILITY OF ANY SHRUB INSTALLATION.
5. CONTRACTOR TO VERIFY LOCATION OF EXISTING LANDSCAPE AND RELOCATE ACCORDING TO PLAN.

RECEIVED

FEB 26 2009

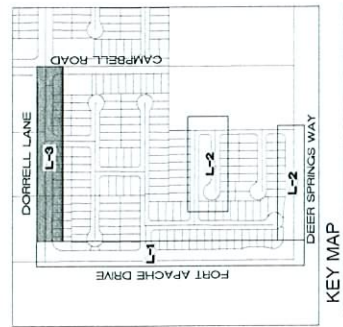

NOT TO SCALE

