


WVR-32158
SUPPLEMENTAL
03/26/09 PC

after final agenda

3-26-09 12
Date Item

72-172-14


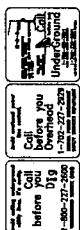


REVISION	DATE	BY	CHKD
1	03/26/09	WVR	WVR
2	03/26/09	WVR	WVR
BASE OF BEARING


RECEIVED
MAR 24 2009

LEGEND
PROPERTY LINE / RIGHT-OF-WAY
1" TYPE CURB AND GUTTER
5" TYPE CURB
EXISTING CURB AND GUTTER
PROPOSED INTERIOR LOT LINE (SIZE AS SHOWN)
PROPOSED EXTERIOR LOT LINE (SIZE AS SHOWN)
EXISTING UTILITY (AS SHOWN)
CROSS CUTTER
WETLANDS
OUT OF FALL SLOPE
PROPOSED PAVEMENT AREA
PROPOSED ELEVATION (DESCRIPTION AS SHOWN)
EXISTING ELEVATION (DESCRIPTION AS SHOWN)
LOT NUMBER
PAVEMENT
PAVED FLOOR ELEVATION
EXISTING FLOOR ELEVATION
FUTURE FLOOR ELEVATION
SMALL POINT ELEVATION

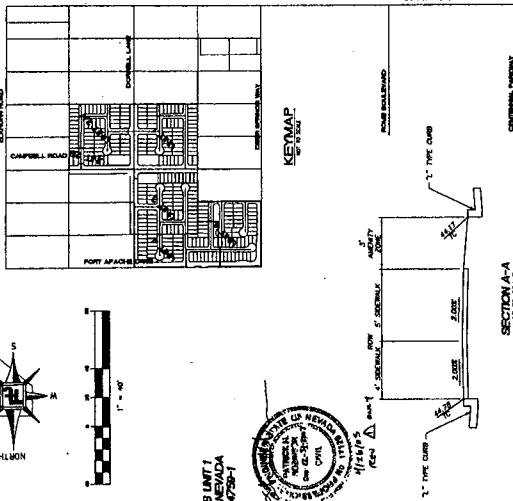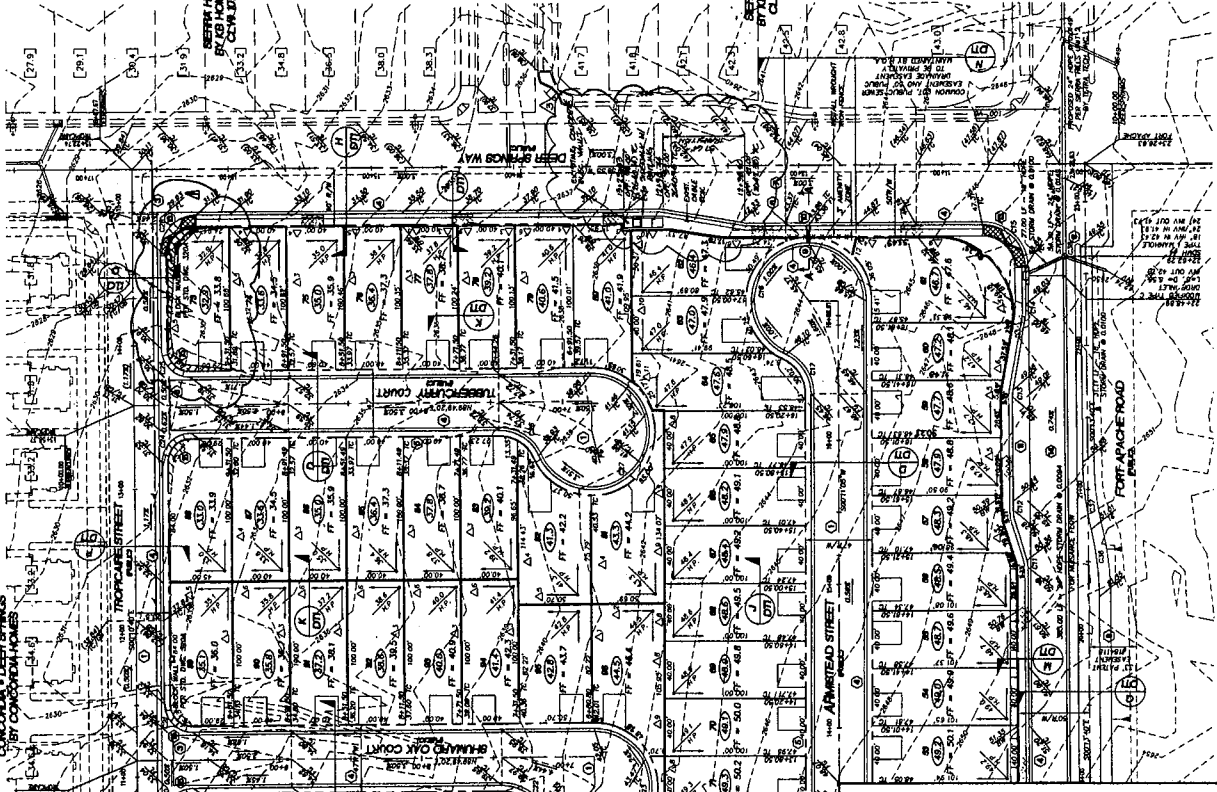

CONSTRUCTION NOTES


SPINNAKER AT TOWNCENTER - UNIT 4
CITY OF LAS VEGAS
GRADING PLAN
TETRA TECH, INC.
ROYAL CONSTRUCTION

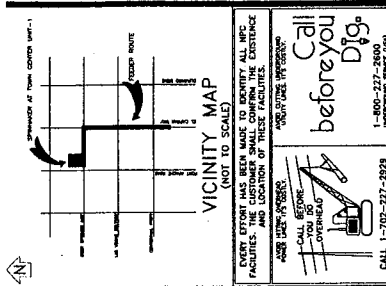

VICINITY MAP
(NOT TO SCALE)

EVERY EFFORT HAS BEEN MADE TO VERIFY EXISTENCE AND LOCATION OF THESE FACILITIES.

Call before you Dig
DEER SPRINGS 2009

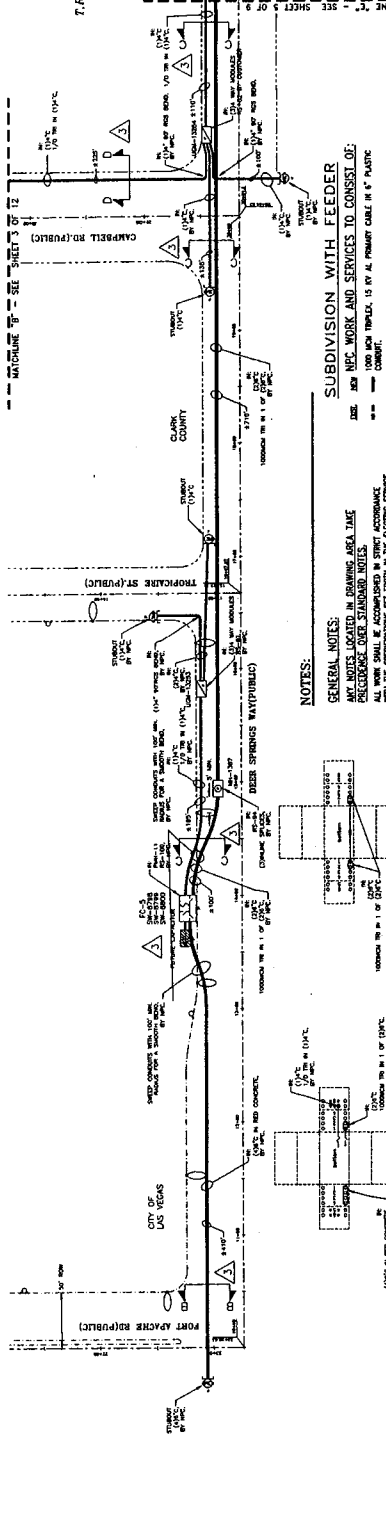

REVISIONS

NO.	DESCRIPTION	DATE	BY

TYPE OF CABLE:
STANDARD
DATE OF CONTRACT
DATE OF INSTALLATION
DATE OF INSPECTION
DATE OF TESTING
DATE OF COMPLETION



NEC INFORMATION:
COORDINATOR: THERM, GARYIN
PHONE: 857-4308
DESIGNER: J. KING/K. ALURED
DCA: 857-4355
INSPECTOR: 378-3895
SCHEDULING: 857-4114/857-4116/857-4118

DISTRICT: LAS VEGAS

CUSTOMER INFORMATION:
DEVELOPER: SPINNAKER HOMES, LLC
ENGINEER: JETRA TECH, INC.
CONTRACT: REN YOUNG 768-7035

APPROVAL DATE: 05/08/2009

AGENCY: CITY OF LAS VEGAS/CLARK COUNTY

APPROVAL DATE: 10/28/2009 00:13:00


