



PLANNING & DEVELOPMENT DEPARTMENT

STATEMENT OF FINANCIAL INTEREST

Case Number: RQR-32710 APN: 137-34-818-003

Name of Property Owner: TERRIBLE HERBST, INC.

Name of Applicant: TERRIBLE HERBST, INC.

Name of Representative: SEAN HIGGINS

To the best of your knowledge, does the Mayor or any member of the City Council or Planning Commission have any financial interest in this or any other property with the property owner, applicant, the property owner or applicant's general or limited partners, or an officer of their corporation or limited liability company?

☐ Yes

☒ No

If yes, please indicate the member of the City Council or Planning Commission who is involved and list the name(s) of the person or persons with whom the City Official holds an interest. Also list the Assessor's Parcel Number if the property in which the interest is held is different from the case parcel.

City Official: _____

Partner(s): _____

APN: _____


Signature of Property Owner: _____

Print Name: Jerry Herbst

Subscribed and sworn before me

This 22 day of January, 20 09

Jenifer E. Cannon
Notary Public in and for said County and State

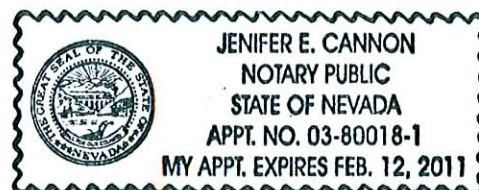

RECEIVED
JAN 23 2009

REQUIRED			
1. C-MARKET	3,550	a. f. @ 1/250	15.0
PROVIDED			
1. HANDICAP			1.0
2. STANDARD			21.0
TOTAL:			22.0
OCCUPANT LOAD		= 118	

SITE PLAN

1/16" = 1'-0" See sheet SD2 for site keynotes



OFFICE DRAWER COPY

1 ENLARGED CONC. PUMP PLAIN SCALE 1/4" = 1'-0"

RQR-32710
03-04-09 CC

STOREFRONT NOTES

1. THE CHAMFOL DETAILS DIMENSIONS ARE GENERAL IN NATURE AND VARY TO THE GENERAL STOREFRONT SYSTEM APPEARANCE, SIZE, ETC. CONDITIONS SHALL BE DETERMINED BY THE MANUFACTURER.
2. THE STOREFRONT MANUFACTURER SHALL DESIGN THE SYSTEM AND ATTACHMENT TO THE BUILDING STRUCTURE. THE MANUFACTURER SHALL BE RESPONSIBLE FOR THE DESIGN, FABRICATION, INSTALLATION AND PROTECTION OF ALL MANUFACTURED COMPONENTS. THE MANUFACTURER SHALL BE RESPONSIBLE FOR THE DESIGN, FABRICATION, INSTALLATION AND PROTECTION OF ALL MANUFACTURED COMPONENTS.
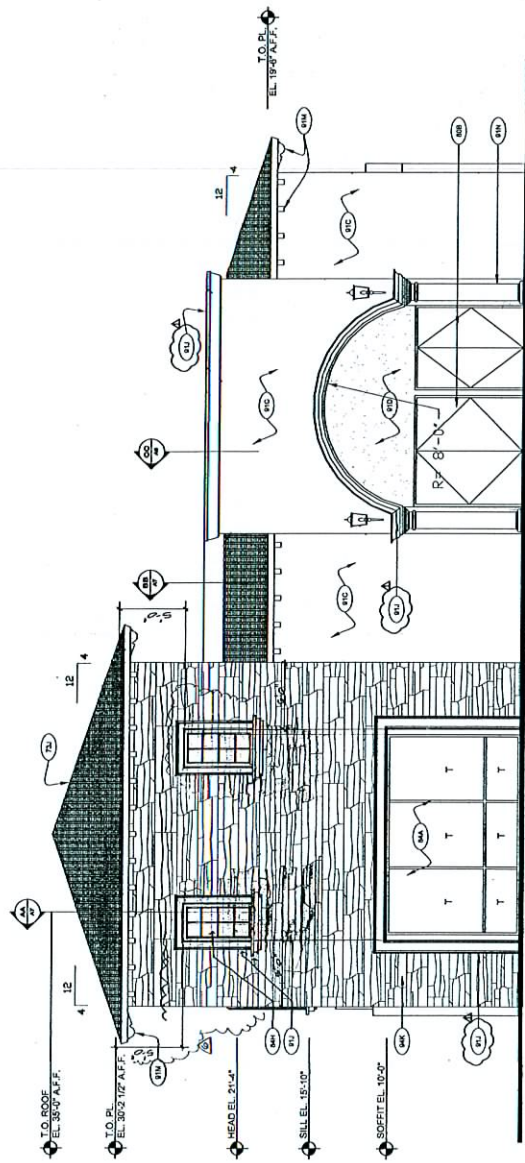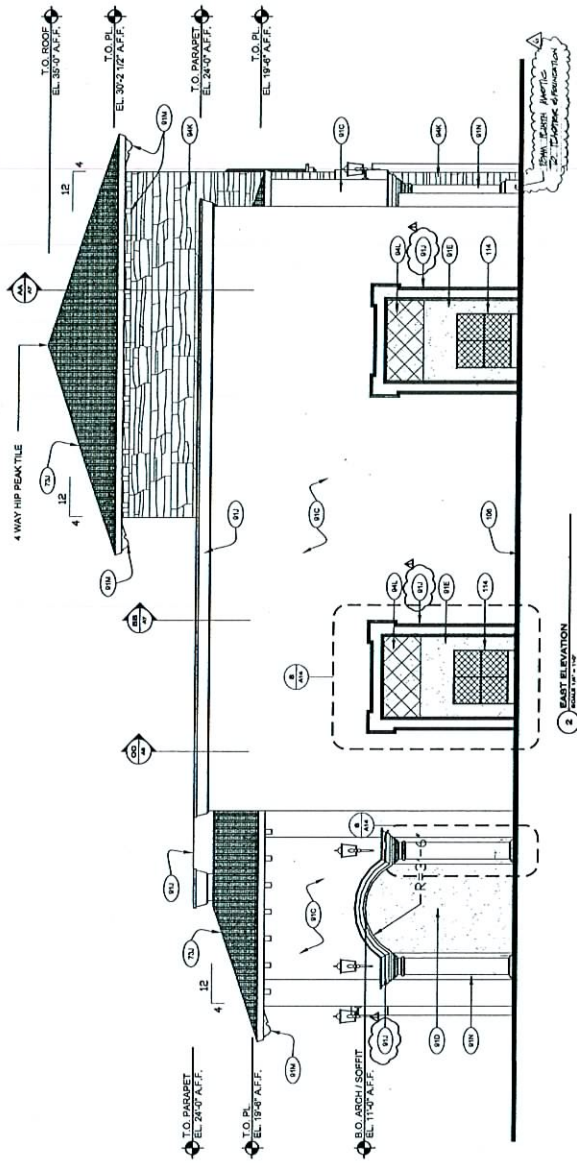

1 WEST ELEVATION
SCALE 1/8" = 1'-0"

RQR-32710
03-04-09 CC

RECEIVED
JAN 23 2009

REVISION
1/25/09

ERROL HILL
ARCHITECT LTD.

1614 WARDLAND PKWY LAS VEGAS, NV 89104



LAS VEGAS, NV 89119



HERBST OIL CO.
5195 LV BLVD. SO.



PROJECT: VISTA COMMONS "SUMMERLIN"
APR: 2/2/07
DATE: 2/2/07

A 40007


SHEET NO.

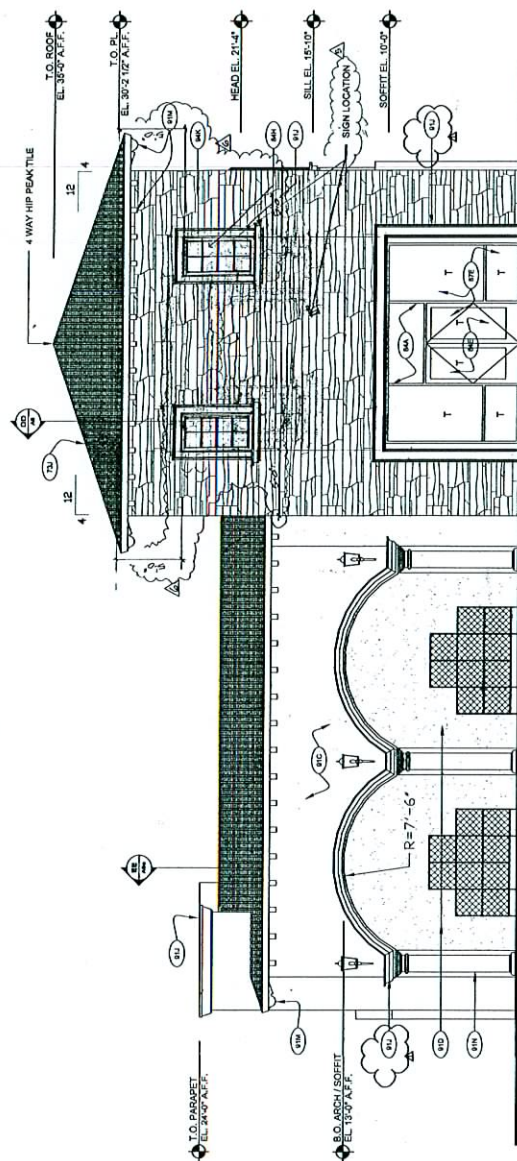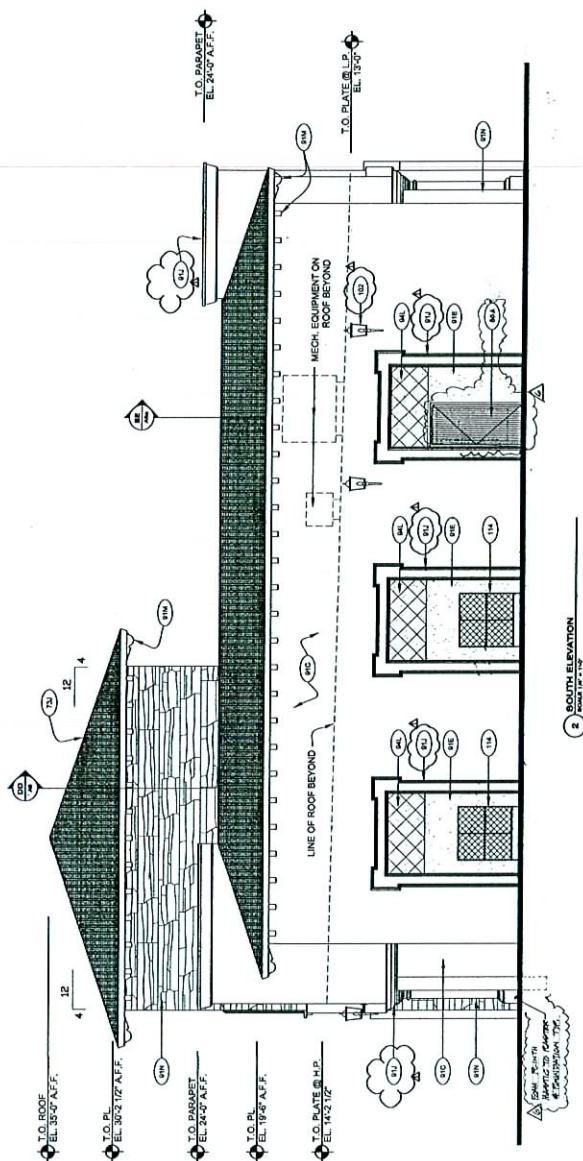



RQR-32710
03-04-09 CC

1 NORTH ELEVATION

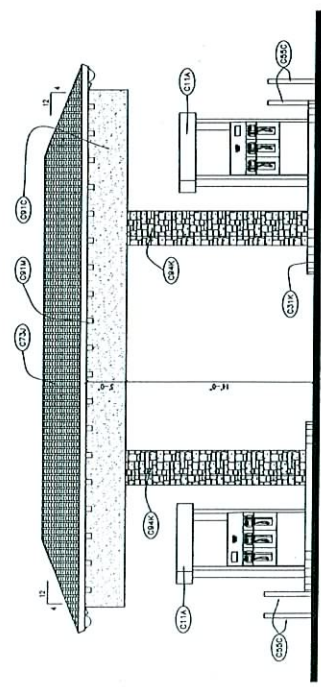

2 CANOPY END ELEVATION
1/8" - 1'-0"

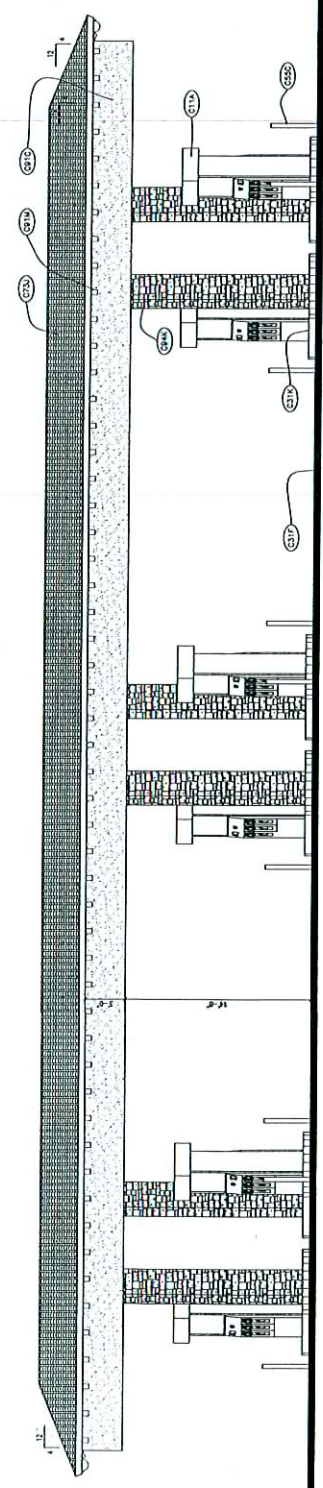

1 CANOPY FRONT ELEVATION
 $\frac{1}{8}'' = 1'-0''$

RECEIVED
JAN 23 2009

RQR-32710
03-04-09 CC