



PLANNING & DEVELOPMENT DEPARTMENT

STATEMENT OF FINANCIAL INTEREST

Case Number: **VAR-32995**

APN: 138-23-301-002

Name of Property Owner: Becker & Sons, L.L.C., A Nevada Limited Liability

Name of Applicant: AMVIN LLC (PINKAOW THAI RESTAURANT COMPANY)

Name of Representative: Kiattipol Kitisoros

To the best of your knowledge, does the Mayor or any member of the City Council or Planning Commission have any financial interest in this or any other property with the property owner, applicant, the property owner or applicant's general or limited partners, or an officer of their corporation or limited liability company?

☐ Yes

☒ No

If yes, please indicate the member of the City Council or Planning Commission who is involved and list the name(s) of the person or persons with whom the City Official holds an interest. Also list the Assessor's Parcel Number if the property in which the interest is held is different from the case parcel.

City Official: _____

Partner(s): _____

APN: _____

Signature of Property Owner: _____

Print Name: Barry W. Becker

Manager

Subscribed and sworn before me

This 12 day of January, 2009


Melissa Hamilton
Notary Public in and for said County and State



RECEIVED
JUN 12 2009

SHEET INDEX

- 20 SITE PLAN, 2006 IBC CODE ANALYSIS, PROJECT DATA
- A-1 FLOOR PLAN OF EXISTING RESTAURANT, LIST OF EQUIPMENT
- A-2 FLOOR PLAN OF EXISTING RESTAURANT, FINISH SCHED.
- A-3 REFLECTED CEILING PLAN, CEILING SHAFT BRACE
- M-1 AIR CONDITIONING PLAN
- M-2 HOOD DETAILS
- E-1 POWER PLAN FOR SECTION, PANEL SCHED, ELEC LEGEND
- E-2 LIGHTING PLAN FOR SECTION, MINOR LIGHTING COMPLIANCE
- P-1 PLUMBING PLAN, HOT, COLD & GAS PIPING

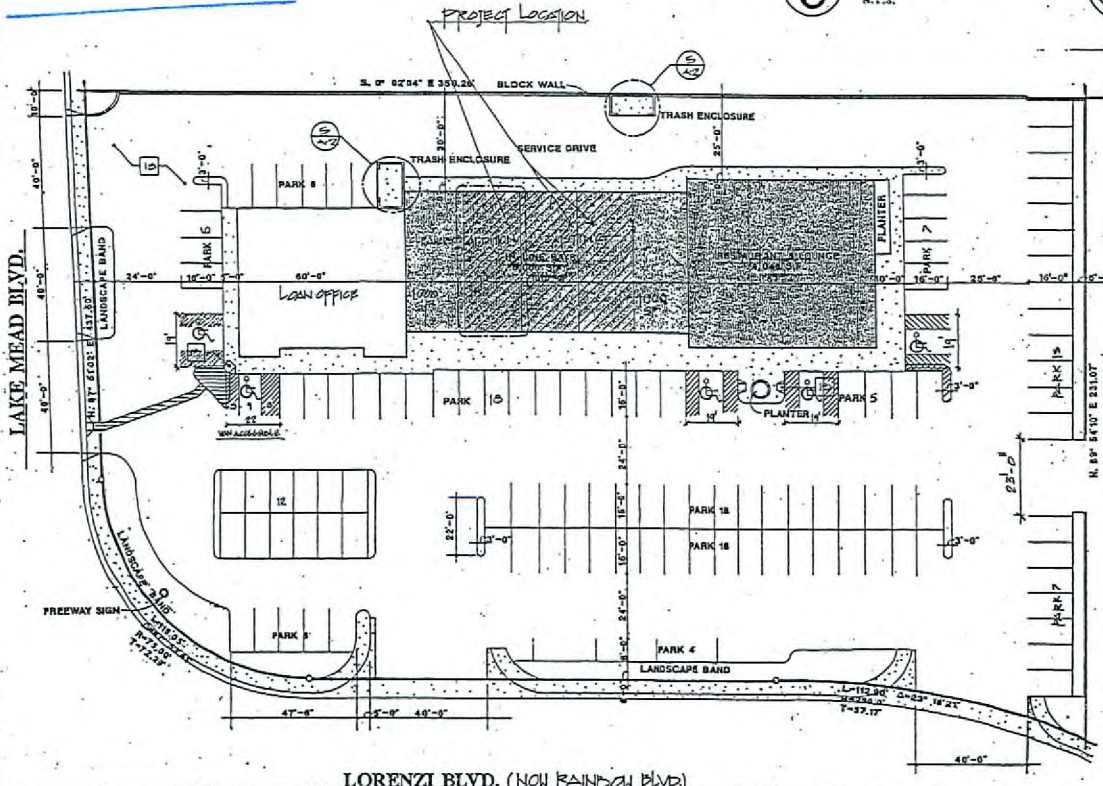

1 site plan
SCALE 1" = 20'-0"

PARKING REQUIRED:

LOAN OFFICE	1 PER 250 SF	25%
	(1404 + 430) = 1834 SF + 250	
	13 SPACES REQUIRED	
DRY CLEANING	1 PER 250 SF	8.4%
	100 + 650 = 750	
	3 SPACES REQUIRED	
RESTAURANT	(1404 + 430) + 20 = 1854 SF	25.2%
	3000 SF - 1404 - 430 = 1166 SF	
	1166 SF + 200 = 1366 SF	
	3 SPACES REQUIRED	
SERVICE AREA	2 PER CHAIR, 1 PER CHAIR	8.4%
	3 x 2 = 6 SPACES REQUIRED	
DRINKING ESTABLISHMENT	1 PER 50 SF SERVICE AREA + 1 PER EMPLOYEE	3.4%
	75 (SERVICE AREA) OF 4040 SF = 3030	
	3030 + 50 = 3080 SF	
	3080 SF + 0 EMPLOYEE @ 1 SPACE EACH CHAIR = 62 SPACES REQUIRED	
	13 + 4 + 3 + 10 + 67 = 103 SPACES REQUIRED	
	117 SPACES PROVIDED	
	INCLUDING SHADY SPACES	

8 INDICATES 8' X 16' SPACES - ALL OTHERS ARE 9' X 16'

2 PROJECT INFORMATION

APPLICABLE BUILDING CODE - IBC 2006

PROPOSED USE:	RESTAURANT	CHAP. 3 SECTION 302
OCCUPANCY CLASSIFICATION:	A-2	CHAP. 8 SECTION 802.5
TYPE OF CONSTRUCTION:	5B	
FIRE SPRINKLERS YES/NO:	YES	
STORIES:	ONE	
LOT AREA:		
BUILDING AREA (TENANT):	3000	SQ. FT.
OCCUPANT LOAD:	SECTION 1004	LOAD FACTOR
	TABLE 1004.4-1	
BLDG.	SF.	15
DINING	SF. 1404 + 430 = 1834	15
KITCHEN	SF. 1240.52	200
RESTAURANT	SF. 3040.00	100
HALLWAYS	SF. 217.34	100
DRY CLEANING	SF. 5271	20
		13416 = 195

EXITING REQUIREMENTS	CHAP. 10 TABLE 1003 & 1004
EXIT DOORS = OCCUPANT LOAD x 0.2	195 x 0.2 = 39
EXIT WIDTH REQUIRED	39
EXIT WIDTH PROVIDED	6 DOORS 6' x 8' = 216
PLUMBING FIXTURES	CHAP. 29 TABLE 2901, 2902 TABLE 2902.1
W.C. REQUIRED	
W.C. PROVIDED	
LAVATORY REQUIRED	
LAVATORY PROVIDED	

PARKING
EXISTING PROVIDED BY BLDG. COMPLEX

ENERGY COMPLIANCE STATEMENT
BUILDING ENVELOPE IS EXISTING AND WILL NOT BE ALTERED BY THIS PROJECT.

REVISIONS	BY
1	2009
2	2009
3	2009
4	2009
5	2009
6	2009
7	2009
8	2009
9	2009
10	2009

Global Management & Construction
300 V. Spring Mountain, Suite 51 Las Vegas, NV 89102
Tel: 702-255-5516 License # 0005588 Fax: 702-565-0004

PINK KAO THAI RESTAURANT
TENANT IMPROVEMENT
1738 NORTH RAINBOW LAS VEGAS, NEVADA 89102

DRAWN	DATE
CHECKED	2009
1-20-09	2009
JOB NO.	
SHEET	
CO.	

VAR-32995
02/26/09 PC

VAR-32995
02/26/09 PC


DATE	02/26/09
BY	PC
CHECKED	
DESIGNED	
PROJECT	
SHEET	




REVISIONS	

WALL LEGEND
 Hatched wall existing wall
 Solid wall to be removed
 Dashed wall existing wall
 Thin line existing wall

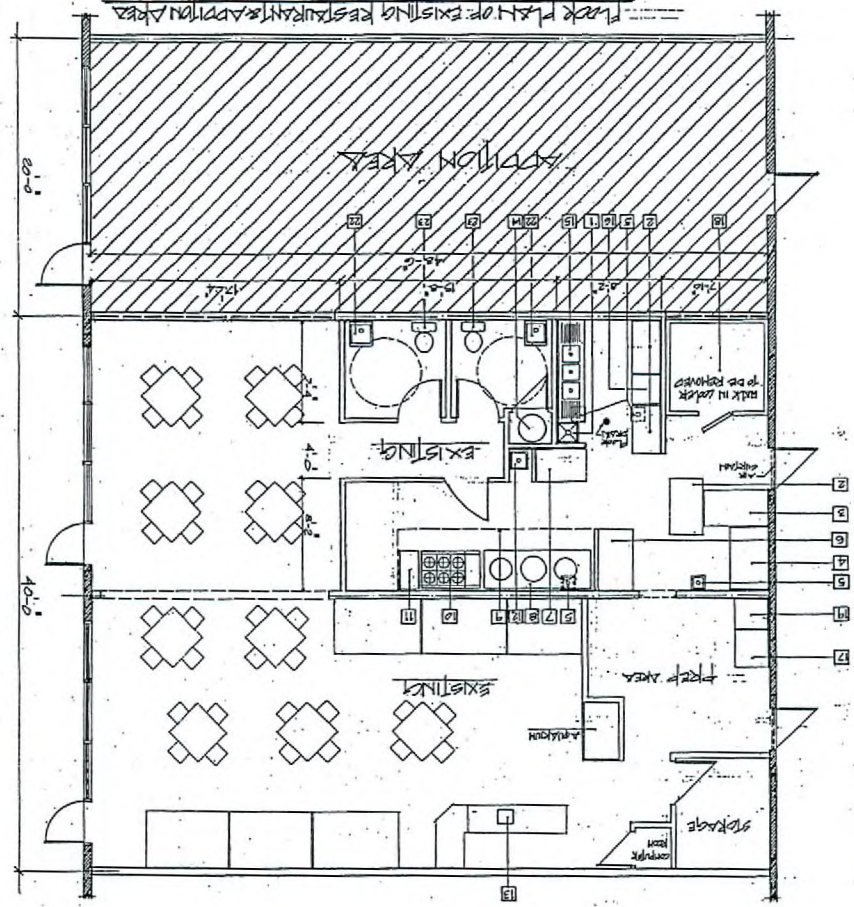


RECEIVED
JAN 12 2009

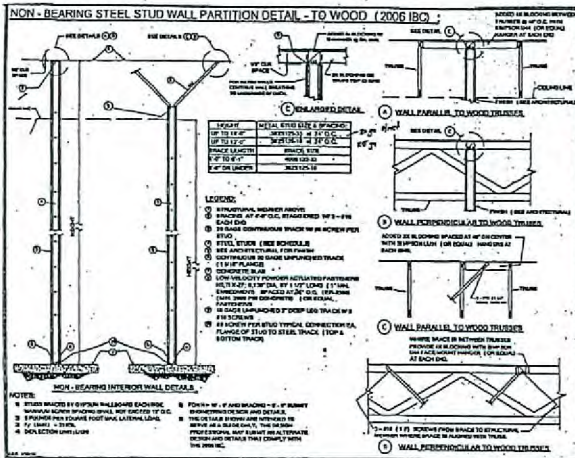

LIST OF EQUIPMENT, EXISTING & NEW

1. MOP SINK
2. WORK TABLE, SPANLESS, 24'x60"
3. FREEZER
4. REFRIGERATOR
5. FLOOR SINK
6. WORK TABLE (FROM TO GO)
7. REFRIG. TABLE 28'x30', MODEL 1850-10-10, 0.6 G.A.M.P.
8. CHINESE WOK EACH BURNER RATE 10000 BTU
9. HOOD 14'-0" x 4'-4"
10. RANGE, 6 BURNER W/GRIDDLE 48"x32" MODEL 1850-10-10, 0.6 G.A.M.P.
11. FRIER 18 1/2" x 30 1/2" MODEL 1850-10-10, 0.6 G.A.M.P.
12. HAND SINK
13. CASH REGISTER
14. WATER HEATER
15. 3 G.P.T. SINK 10" MODEL 067416
16. DISHWASHER (12 PLACE) MODEL 1850-10-10, 0.6 G.A.M.P.
17. ICE MAKER 27"x35"
18. WALK IN COOLER 7'-0" x 7'-0"
19. COKE MACHINE
20. HAND PACKAGING TABLE
21. COOLER 28 1/2" x 24"
22. LAUNDRY
23. WATER CLOSET
24. OFFICE
25. RICE COOKER MODEL 1850-10-10, 0.6 G.A.M.P.
26. NEW HOOD 20' x 4' (N)
27. SINK RANGE COOKER MODEL 1850-10-10, 0.6 G.A.M.P.
28. WALK IN FREEZER 6'-0" x 7'-0" (N)
29. 2 COMP. SINK (N)
30. UTILITY

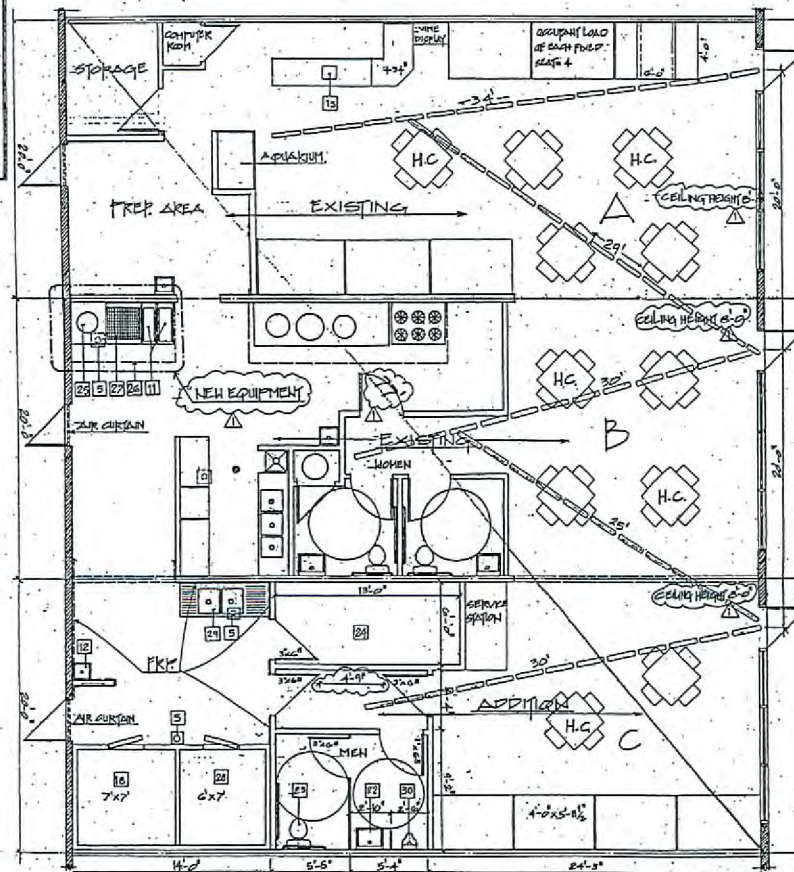

FLOOR PLAN EXISTING & ADDITION 1/4" = 1'-0"

INTERIOR FINISH SCHEDULE						
	FLOOR	BASE	WALLS	CEILING	DOORS	WINDOWS

DINING AREA A 312.56 SF
 312.56 ÷ 15 = 20.84 OCCUPANT
