


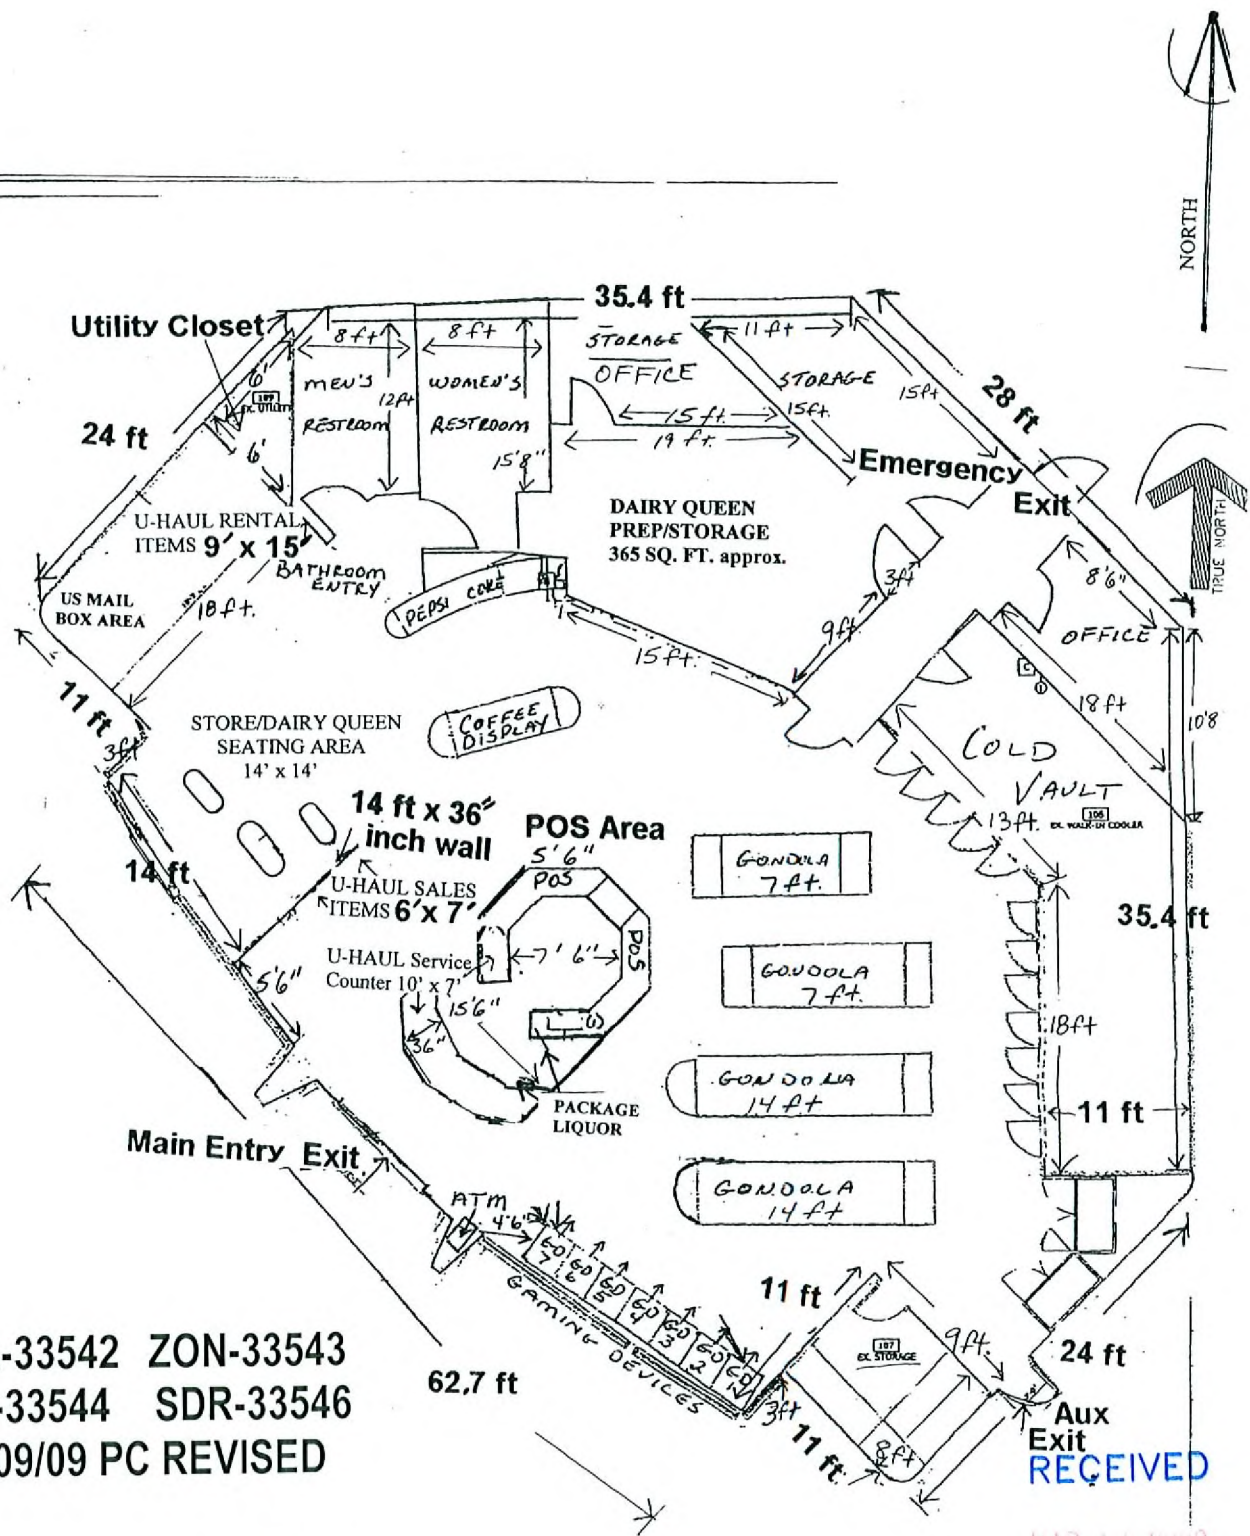

GPA-33542 ZON-33543
 SUP-33544 SDR-33546
 04/09/09 PC REVISED

REDCARD, LLC dba
 CONVENIENCE SUPER STORE
 8490 Westcliff Drive
 Las Vegas, NV 89145

ASSESSOR PARCEL NUMBER
 138-28-401-009

3,598 SQUARE FEET

SCALE 1 Inch equals 12 feet

Max Occupancy-119

Per M-Mercantile Load Factor