



PLANNING & DEVELOPMENT DEPARTMENT

STATEMENT OF FINANCIAL INTEREST

Case Number: **VAR-33522** APN: 139-31-410-010
Name of Property Owner: SUSAN WHITE
Name of Applicant: SUSAN WHITE
Name of Representative: SUSAN WHITE

To the best of your knowledge, does the Mayor or any member of the City Council or Planning Commission have any financial interest in this or any other property with the property owner, applicant, the property owner or applicant's general or limited partners, or an officer of their corporation or limited liability company?

_____ Yes

X No

If yes, please indicate the member of the City Council or Planning Commission who is involved and list the name(s) of the person or persons with whom the City Official holds an interest. Also list the Assessor's Parcel Number if the property in which the interest is held is different from the case parcel.

City Official: _____

Partner(s): _____

APN: _____

Signature of Property Owner: SUSAN Schaal White

State of Nevada
County of Clark


Print Name: SUSAN SCHAAF WHITE


Subscribed and sworn before me

This 29 day of January, 2009

Sonia Pitts

Notary Public in and for said County and State

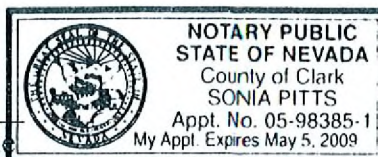

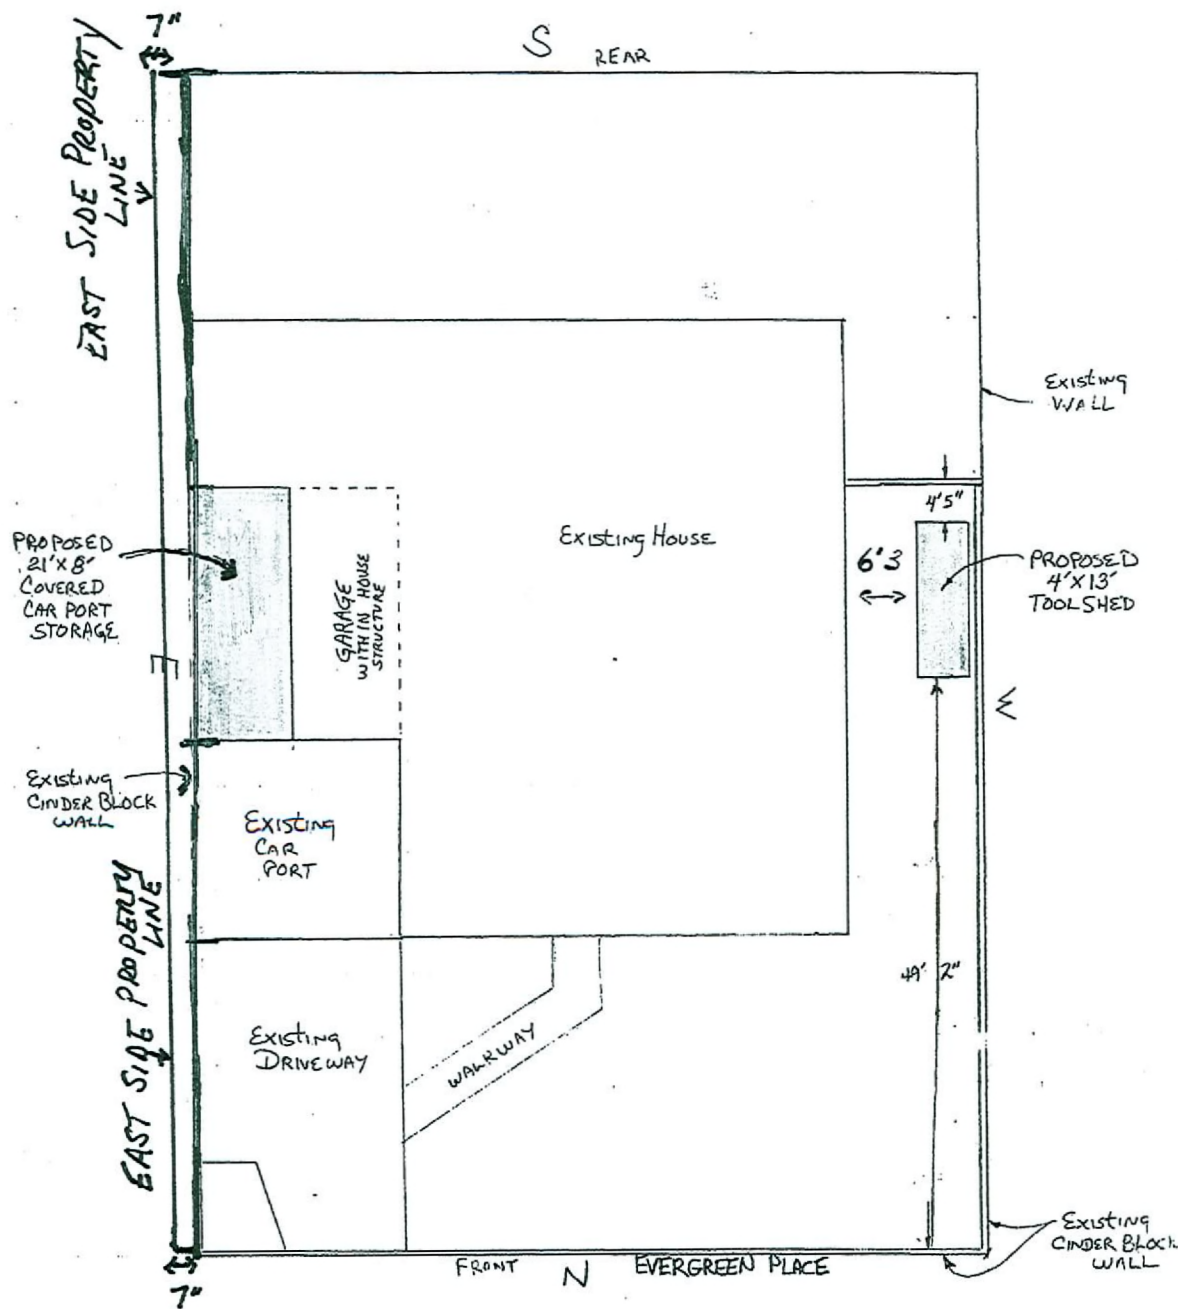

RESIDENTIAL SITE PLAN

SUSAN & DENNIS WHITE
4601 EVERGREEN PLACE

LOT 501
BLOCK 21
SUB HYDE PARK #3
PARCEL # 139-31-410-010
ZONE R-1


RECEIVED

MAR 03 2009

VAR-33522
REVISED
04/09/09 PC

ORIGINAL DRAWING
SCALE: $\frac{1}{8}" = 1'-0"$

FLOOR PLAN

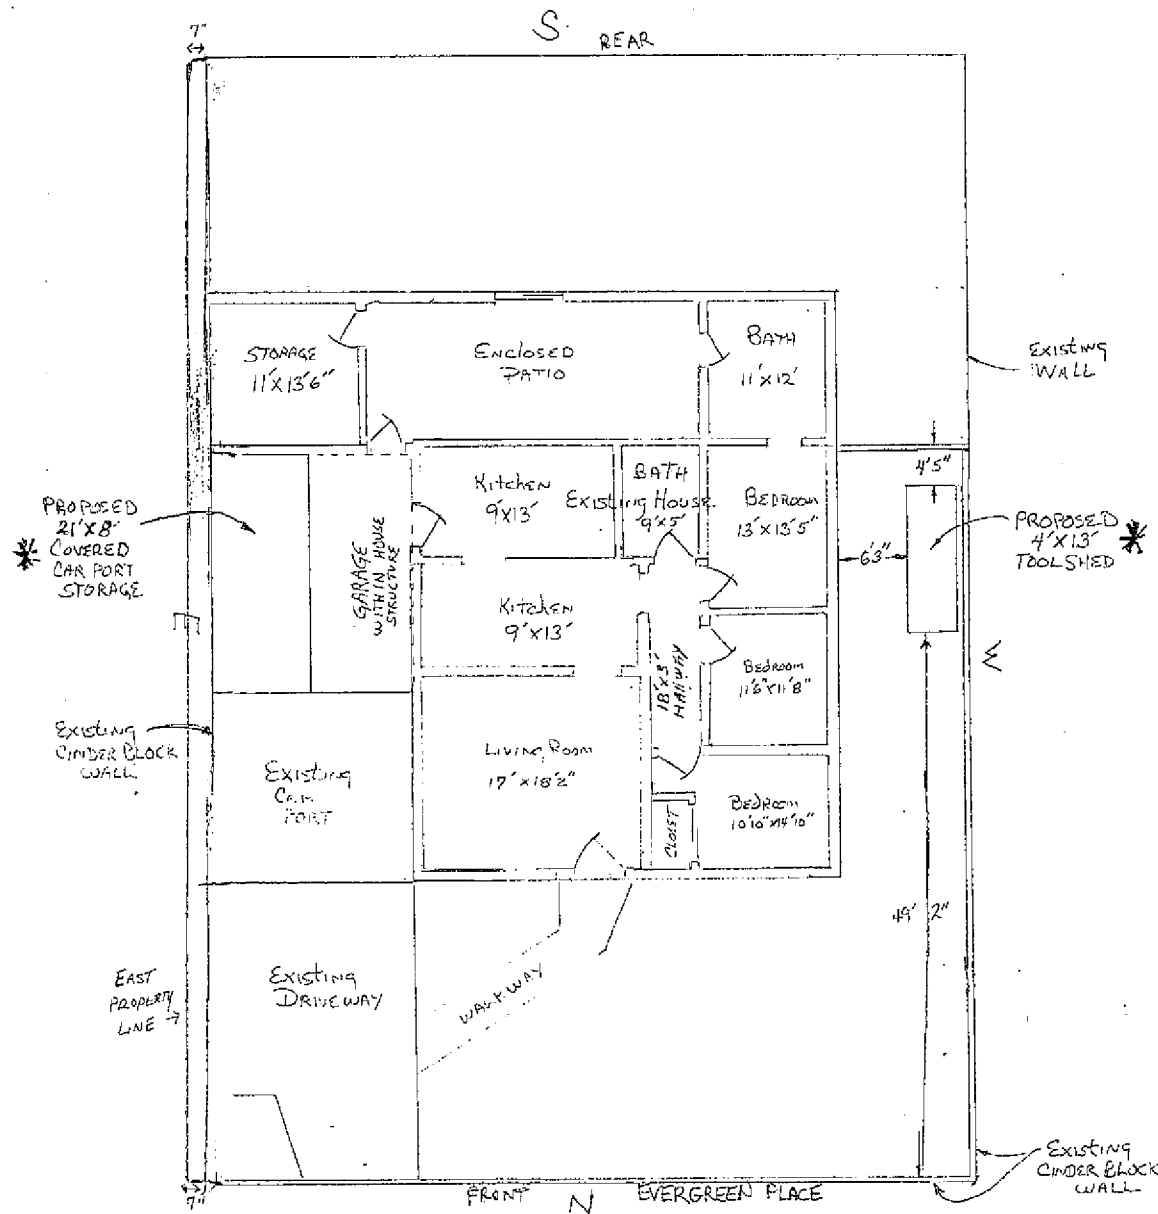

RESIDENTIAL SITE PLAN

SUSAN & DENNIS WHITE
4601 EVERGREEN PLACE

LOT 501
BLOCK 21
SUB HYDE PARK #3
PARCEL #139-31-410-010
ZONE R-1

VAR-33522
REVISED
04/09/09 PC

ORIGINAL DRAWING
SCALE: 1/8" = 1'-0"

RECEIVED

MAY 10 2009