


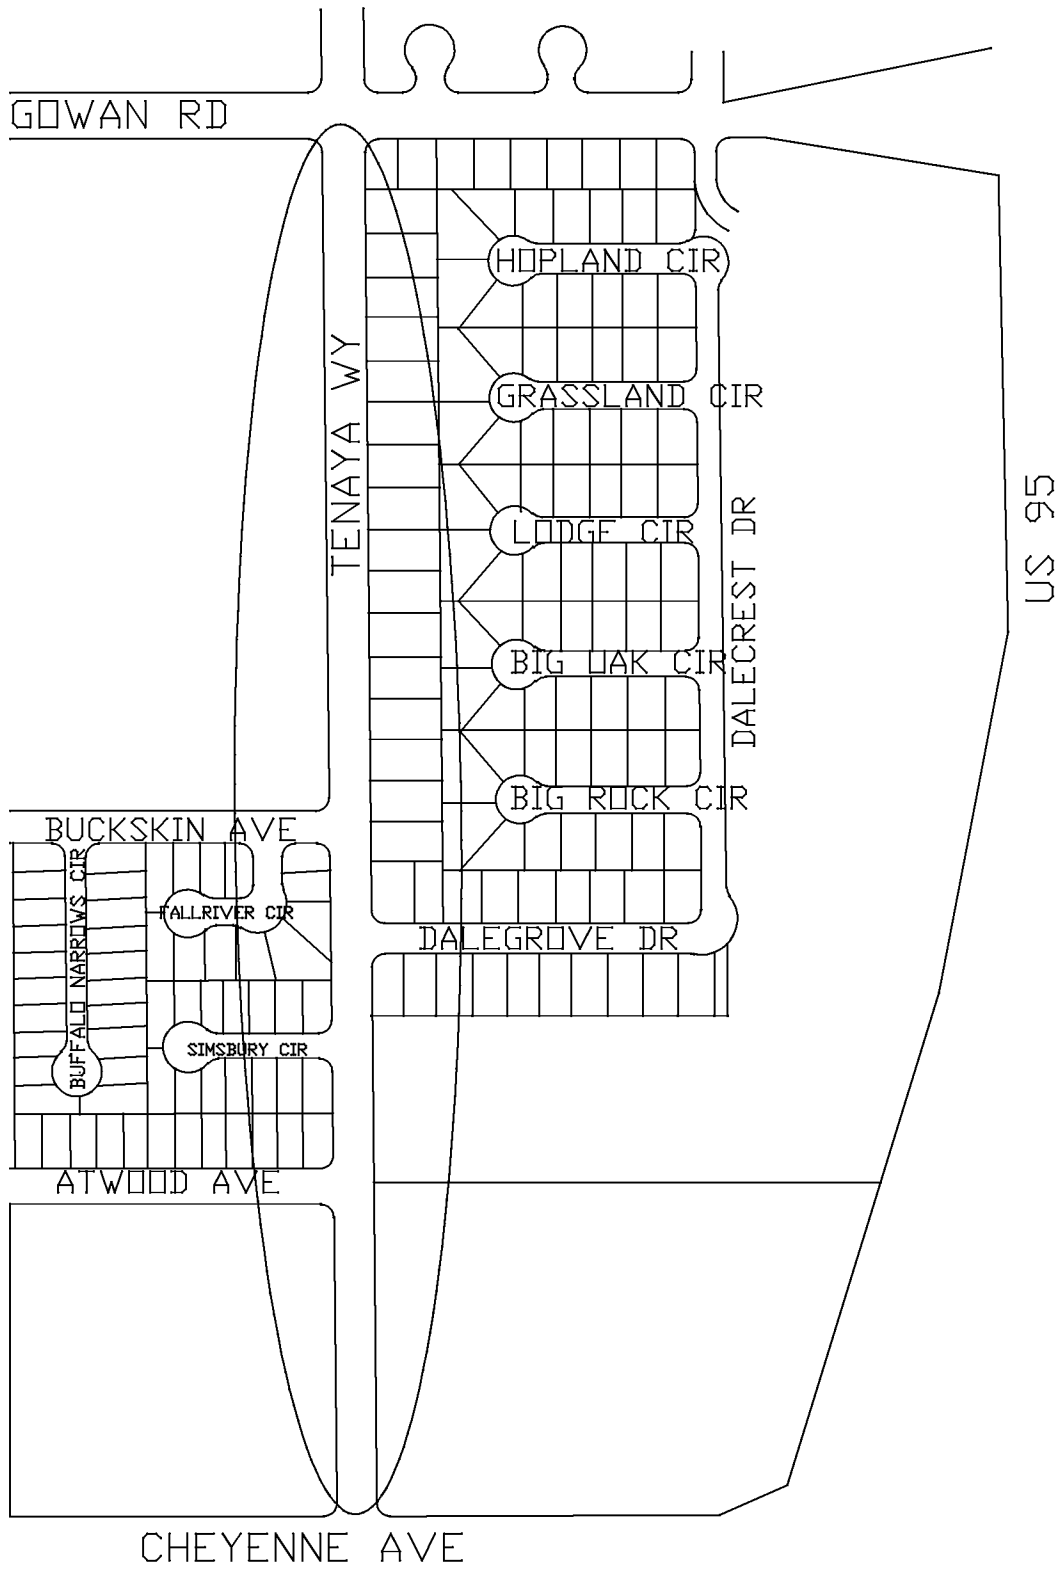

○ PROPOSED SPEED LIMIT CHANGE