



PLANNING & DEVELOPMENT DEPARTMENT

STATEMENT OF FINANCIAL INTEREST

Case Number: **SUP-33743** APN: _____

Name of Property Owner: Alexo Stewart Enterprises Inc.

Name of Applicant: Leon Hacker

Name of Representative: _____

To the best of your knowledge, does the Mayor or any member of the City Council or Planning Commission have any financial interest in this or any other property with the property owner, applicant, the property owner or applicant's general or limited partners, or an officer of their corporation or limited liability company?

_____ Yes

X No

If yes, please indicate the member of the City Council or Planning Commission who is involved and list the name(s) of the person or persons with whom the City Official holds an interest. Also list the Assessor's Parcel Number if the property in which the interest is held is different from the case parcel.

City Official: _____

Partner(s): _____

APN: _____

Signature of Property Owner: _____

Print Name: Robert M. Munkach


Subscribed and sworn before me

This 2nd day of March, 2009
Sylvia Daves Grieb
Notary Public in and for said County and State



ALSCO STEWART ENTERPRISES LAMB LUST STREET
201 707 7200

ALSCO STEWART ENTERPRISES LAMB LUST STREET
201 707 7200

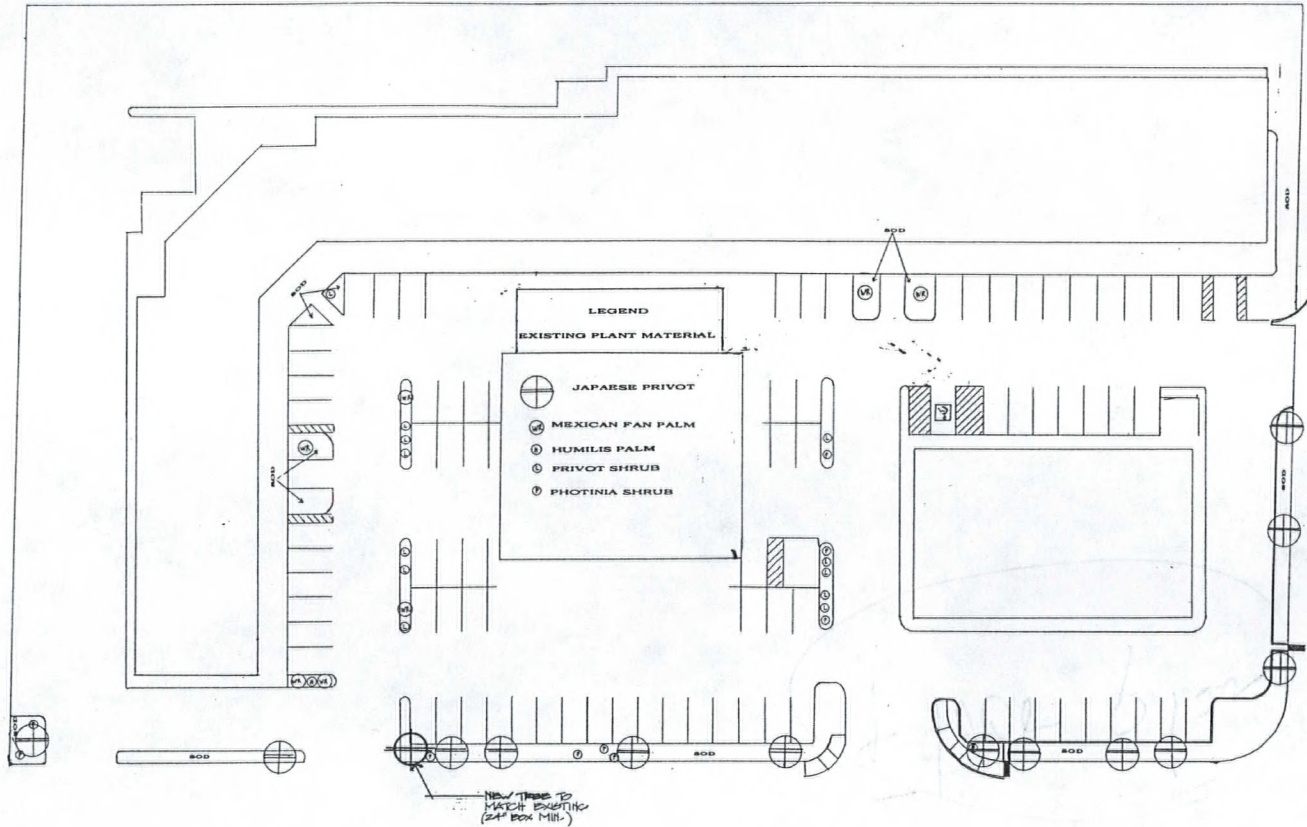

DATE	DESCRIPTION

NCI
NIGRO
CONSTRUCTORS, INC.
200 ROUTE 208
SUITE 200
LAI VEGAS, NV 89407
PHONE (702) 345-8800
FAX (702) 345-8806
CONTRACTOR LICENSE
#63 00026

ORIGIN: 2007 2/20/07

ORIGIN: 2007 2/20/07
POLYMER UNLIMITED
LANDSCAPE LLC

ALSCO STEWART ENTERPRISES
RETAIL BUILDING AT
LAMB BLVD. & STEWART AVE

ADDITIONAL
LANDSCAPE
INFORMATION

BY: STWART, LUST
DATE: 2/20/07
PROJECT: 33743
SHEET: 10 OF 10

ALS1.3

RECEIVED

SUP-33743
04/23/09 PC

MAR 09 2009

