



PLANNING & DEVELOPMENT DEPARTMENT

STATEMENT OF FINANCIAL INTEREST

Case Number: SUP-34014 APN: 163-02-415-001

Name of Property Owner: Rainbow Sahara Center No. 2, Inc.

Name of Applicant: EZPAWN Nevada, Inc.

Name of Representative: Maren Parry

To the best of your knowledge, does the Mayor or any member of the City Council or Planning Commission have any financial interest in this or any other property with the property owner, applicant, the property owner or applicant's general or limited partners, or an officer of their corporation or limited liability company?

☐ Yes

☒ No

If yes, please indicate the member of the City Council or Planning Commission who is involved and list the name(s) of the person or persons with whom the City Official holds an interest. Also list the Assessor's Parcel Number if the property in which the interest is held is different from the case parcel.

City Official: _____

Partner(s): _____

APN: _____


Signature of Property Owner: _____

Print Name: Michael J. Natter

Subscribed and sworn before me

This 3rd day of March, 2009
Linda B. Castle Notary Public
Notary Public in and for said County and State



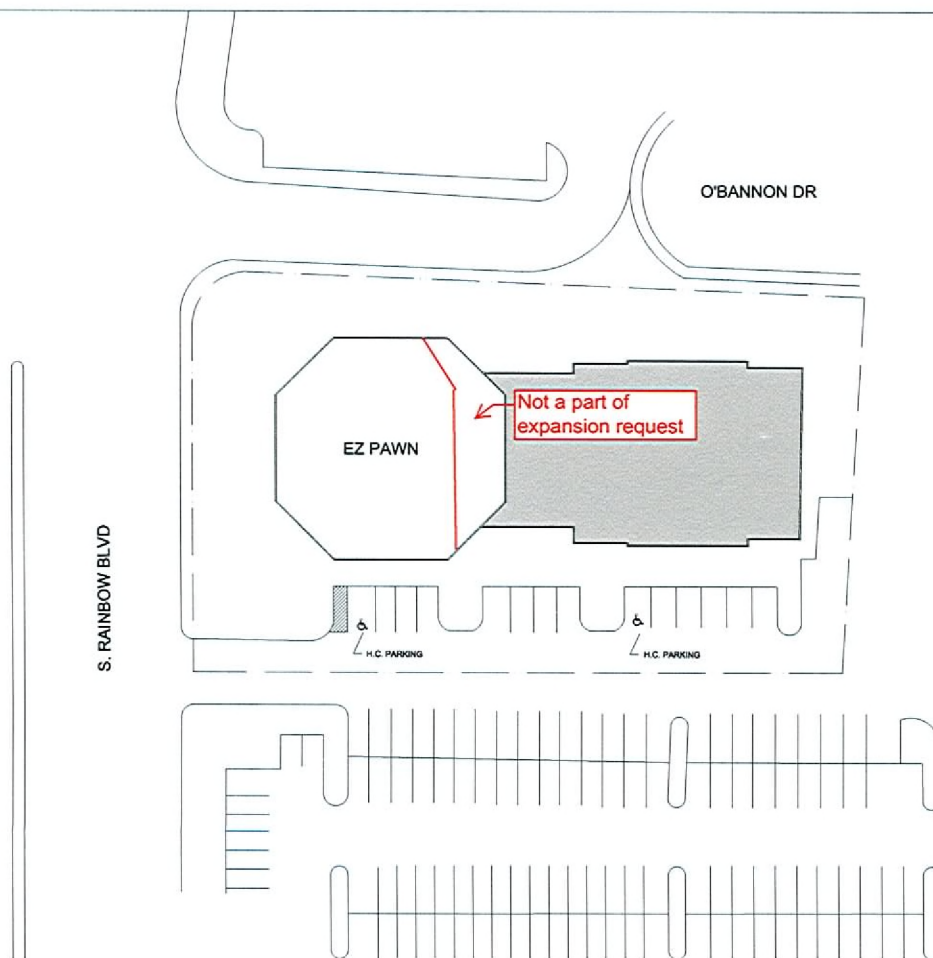

1 SITE PLAN
SCALE: N.T.S.

RECEIVED

APR 22 2009

SUP-34014
REVISED
05/14/09 PC

William E. Franz Architect
ARCHITECTS AND INTERIORS ASSOCIATES, INC.
1000 S. RAINBOW BLVD., SUITE 100, LAS VEGAS, NV 89104

EZ PAWN
2000 S. RAINBOW
LAS VEGAS, NEVADA

File Name: 05248-A01
Project No: 05248
Date: 03/07/2009
Drawn By: RL
Checked By: RL

SHEET
A0.1




Franz
 Franz, Albert Lazo Co. & Associates, Inc.
 Architect/Planning/Interior Architects
 4005 International Plaza Suite 510
 Dallas, Texas 75244-1900
 (817) 731-2422

EZ PAWN
 2200 S. RAINBOW
 LAS VEGAS, NV

Person

No. Name: 00035A1
 Project No: 00340
 Date: 03-03-09
 Drawn By: RLJ
 Checked By: RLJ

A1

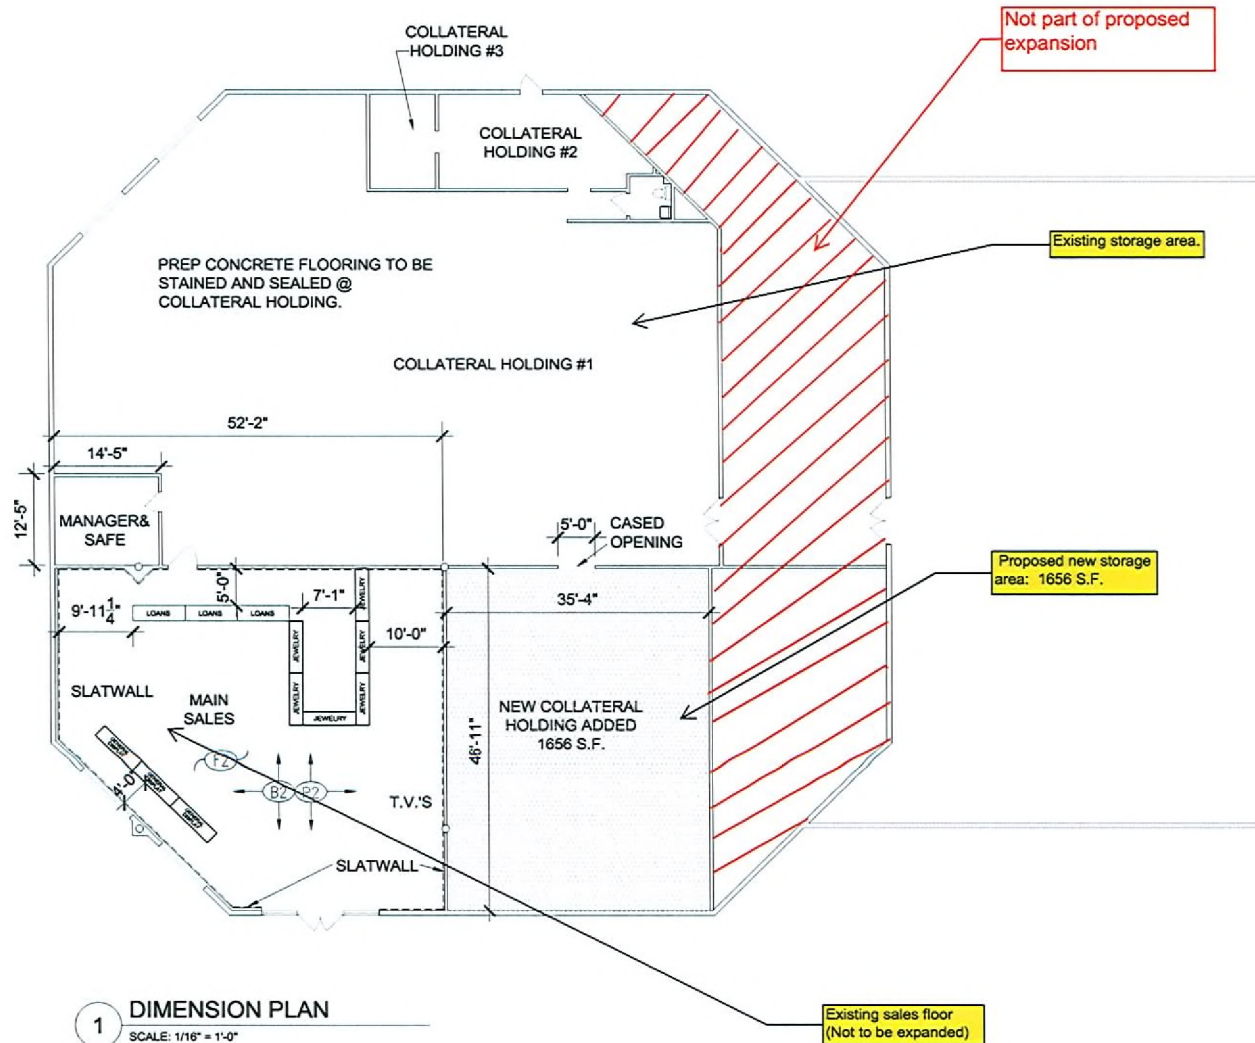

RECEIVED

APR 23 2009

SUP-34014
REVISED
05/14/09 PC