



PLANNING & DEVELOPMENT DEPARTMENT

STATEMENT OF FINANCIAL INTEREST

Case Number: EOT-34509 APN: 140-30-601-006

Name of Property Owner: Living Waters Baptist Church

Name of Applicant: Same

Name of Representative: DRC Engineering / Jolene Granberg

To the best of your knowledge, does the Mayor or any member of the City Council or Planning Commission have any financial interest in this or any other property with the property owner, applicant, the property owner or applicant's general or limited partners, or an officer of their corporation or limited liability company?

☐ Yes

☒ No

If yes, please indicate the member of the City Council or Planning Commission who is involved and list the name(s) of the person or persons with whom the City Official holds an interest. Also list the Assessor's Parcel Number if the property in which the interest is held is different from the case parcel.

City Official: _____

Partner(s): _____

APN: _____

Signature of Property Owner:

Layton Sonerholm

Print Name: Layton Sonerholm

Subscribed and sworn before me

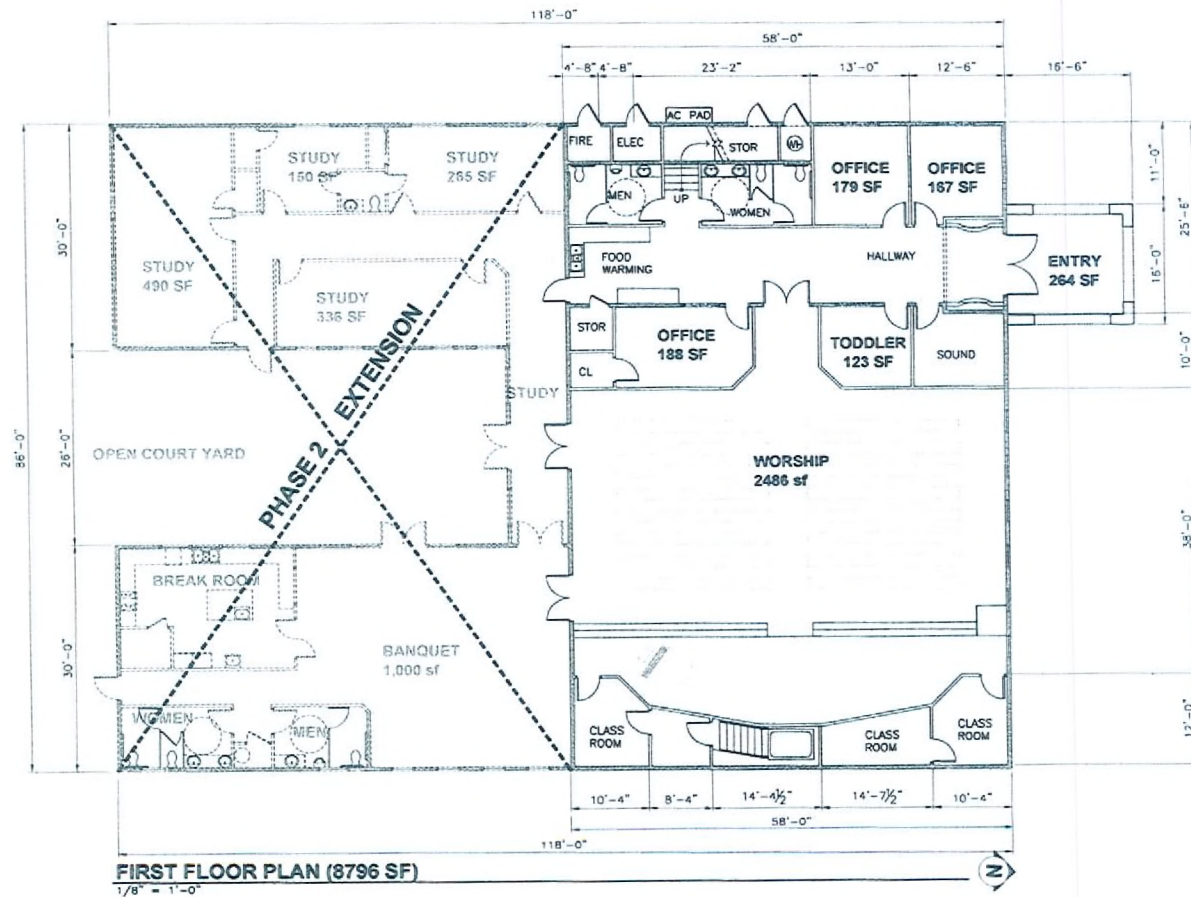
This 12th day of May, 20 09

Susan L. King
Notary Public in and for said County and State



[illegible]

RECEIVED
MAY 14 2009

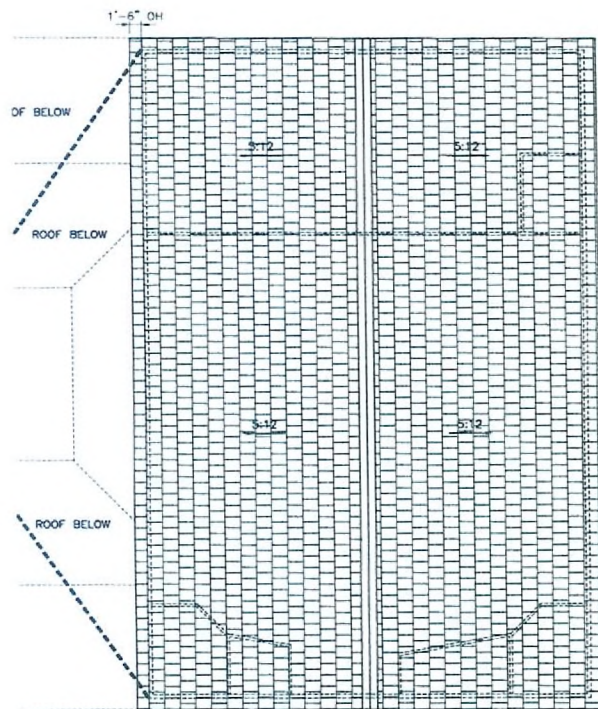


EOT-34509
07-01-09 CC

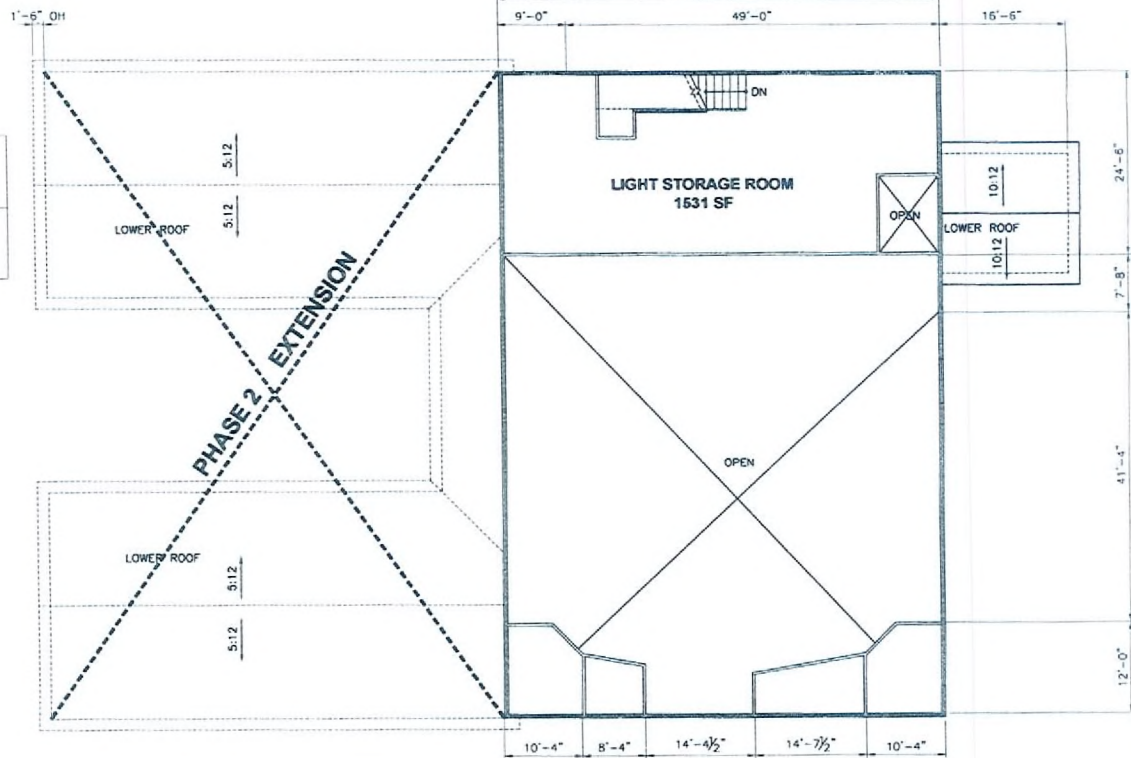
RECEIVED

MAY 14 2009

No.	Revisions
PROPOSED: LIVING WATER BAPTIST CHURCH Sandhill Road Las Vegas - 89110 APN. No. 14030601006	
Date 11-20-05	
Scale AS NOTED	
JOB	
Drawn XY	
Sheet	
A1	
Of	Sheets -



ROOF PLAN
1/8" = 1'-0"



SECOND FLOOR AND LOWER ROOF PLAN (1531 SF)
1/8" = 1'-0"



No.	Revisions

Contractor
Address
Las Vegas, Nevada 89118
Phone: 702-., Fax: 702-
Contractor Lic. NV. -

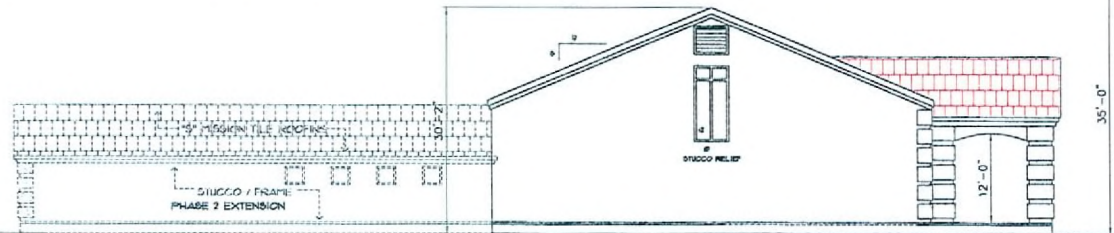
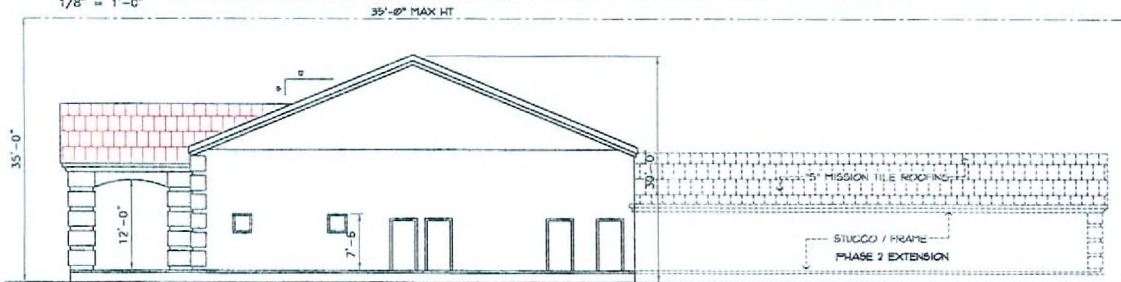
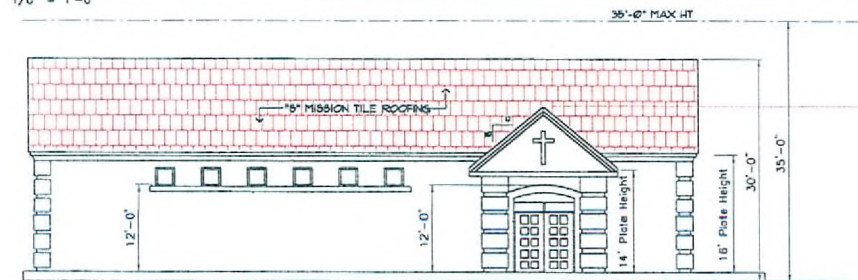
PROPOSED:
LIVING WATER BAPTIST CHURCH
Sandhill Road
Las Vegas - 89110
APN. No. 14030601006

Date 11-20-08
Scale AS NOTED
JOB
Drawn XY
Sheet
A2
Of Sheets -

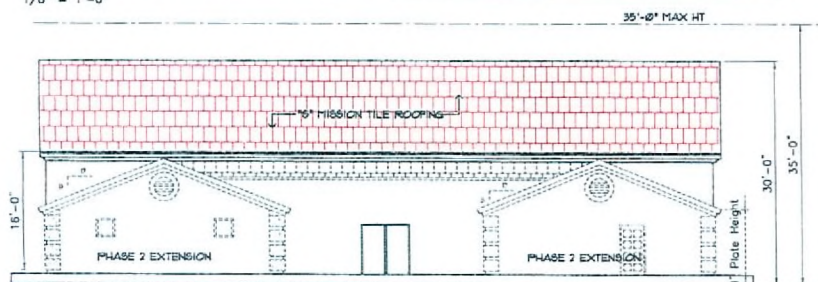
EOT-34509
07-01-09 CC

RECEIVED

MAY 14 2009


$$1/8^n \approx 1'-0^n$$

$$\frac{1}{8''} = 1'-0''$$


$1/8" = 1'-0"$


$$\frac{1}{8}'' = 1'-0''$$

PROPOSED:	Contractor Address Las Vegas, Nevada 89118 Phone: 702 --, Fax: 702 -- Contractor Lic. No.	No.	Revisions
LIVING WATER BAPTIST CHURCH			
Sandhill Road			
Las Vegas -- 89110			
APN. No. 14030601006			
Date 11-20-96			
Scale AS NOTE			
JOB			
Drawn XY			
Sheet			
Of Sheets			