



PLANNING & DEVELOPMENT DEPARTMENT

STATEMENT OF FINANCIAL INTEREST

Case Number: **RQR-33798** APN: 138 03 602 015
Name of Property Owner: Mini-Markas, Inc.
Name of Applicant: Clear Channel Outdoor
Name of Representative: Rod Carter

To the best of your knowledge, does the Mayor or any member of the City Council or Planning Commission have any financial interest in this or any other property with the property owner, applicant, the property owner or applicant's general or limited partners, or an officer of their corporation or limited liability company?

☒ Yes ☐ No

If yes, please indicate the member of the City Council or Planning Commission who is involved and list the name(s) of the person or persons with whom the City Official holds an interest. Also list the Assessor's Parcel Number if the property in which the interest is held is different from the case parcel.

City Official: Ric Torres dell

Partner(s): Chetrik Development

APN: 162-03-410-007

Signature of Property Owner: Will King, Pres.

Print Name: Will King


Subscribed and sworn before me

This 3rd day of April, 2009

[Signature]
Notary Public in and for said County and State



CRAIG ROAD

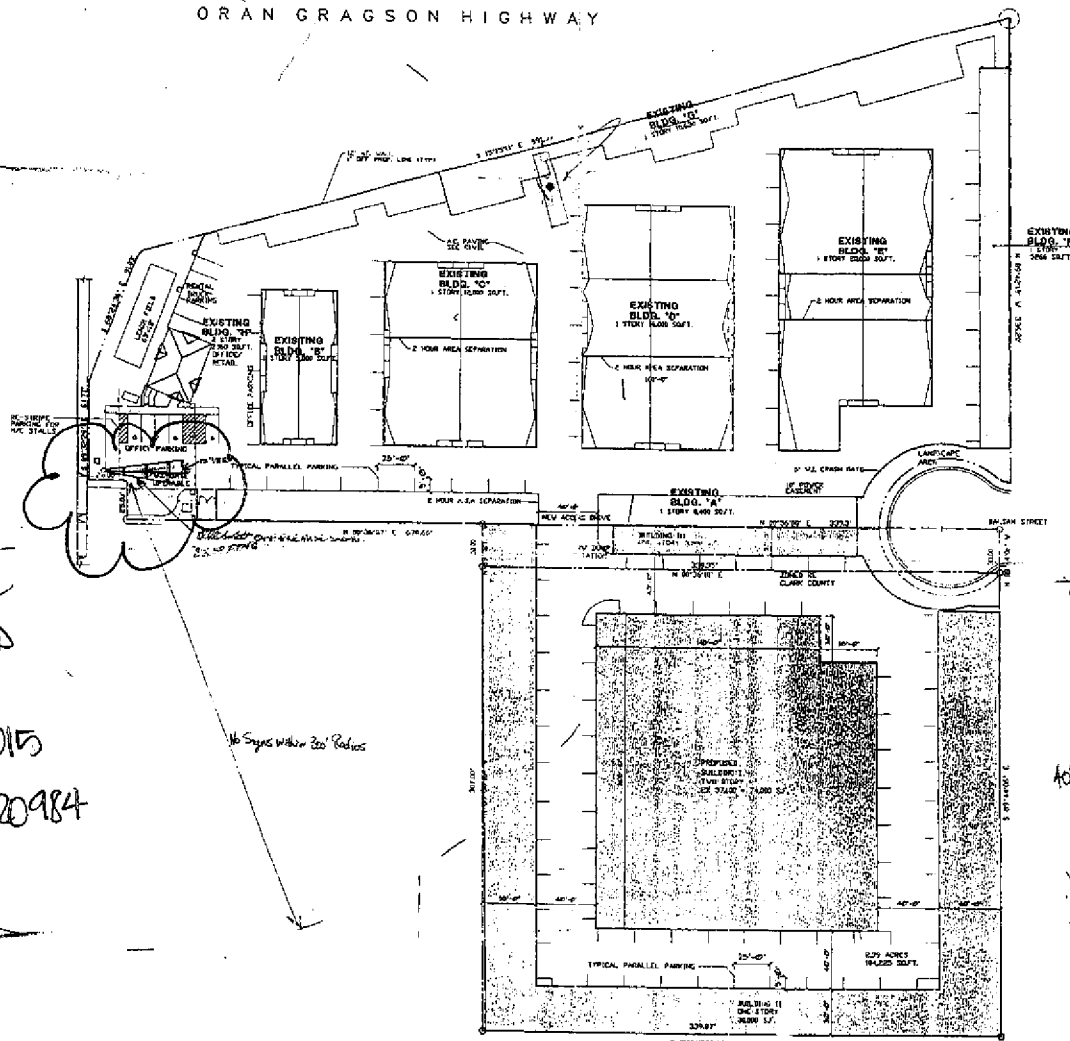


138-03-602-015

Permit # 97-020984

SITE / ROOF PLAN

SCALE: 1"=40'-0"

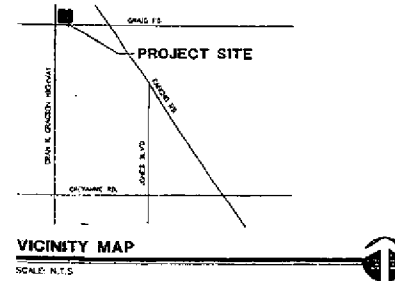


sheet title
SITE PLAN
KEMP MINI STORAGE
job title

job no:
date:
drawn by:
AJF
checked by:

U-298-94
12/27/94 BZA
Swisher & Hall
AIA, LIMITED
Architecture and Planning
1705 J. Rinder, Suite 25, La Vegas, NV. 89106 (702) 565-2822

sheet no.
A10
of of

RQR-33798
05/28/09 PC

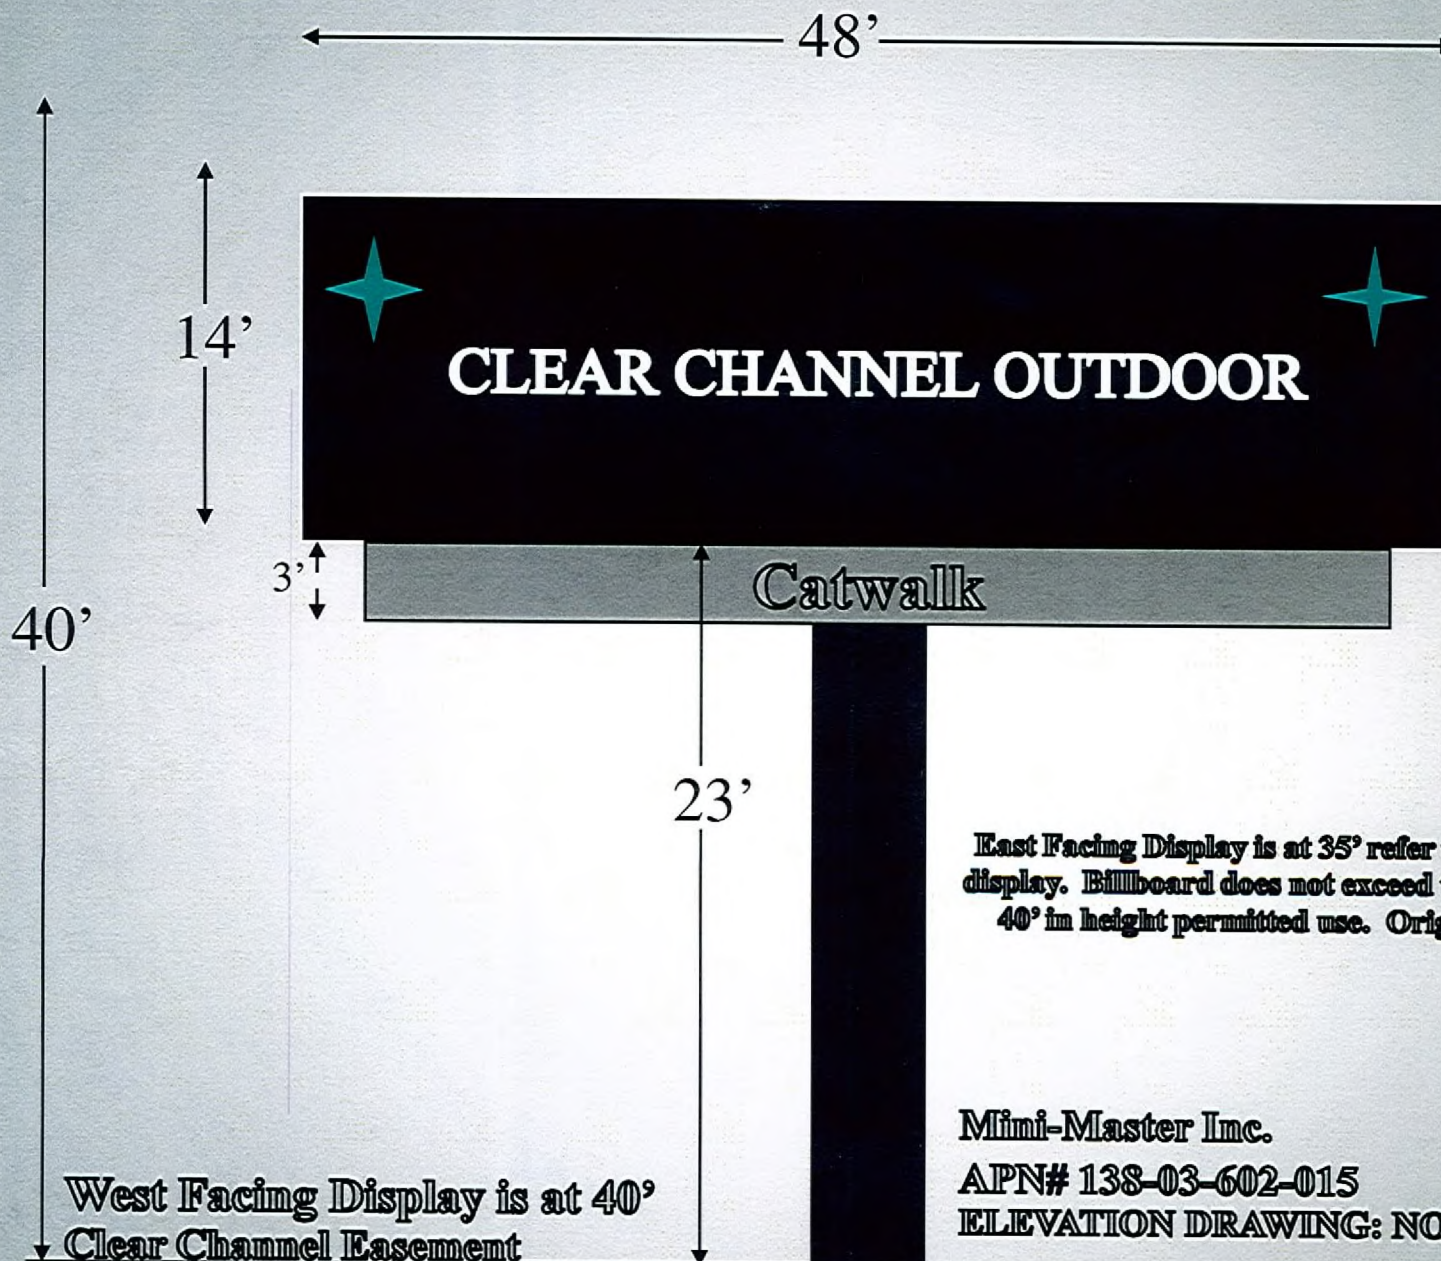

RQR-33798
05/28/09 PC