



PLANNING & DEVELOPMENT DEPARTMENT

STATEMENT OF FINANCIAL INTEREST

Case Number: SUP-34014 APN: 163-02-415-001

Name of Property Owner: Rainbow Sahara Center No. 2, Inc.

Name of Applicant: EZPAWN Nevada, Inc.

Name of Representative: Maren Parry

To the best of your knowledge, does the Mayor or any member of the City Council or Planning Commission have any financial interest in this or any other property with the property owner, applicant, the property owner or applicant's general or limited partners, or an officer of their corporation or limited liability company?

☐ Yes

☒ No

If yes, please indicate the member of the City Council or Planning Commission who is involved and list the name(s) of the person or persons with whom the City Official holds an interest. Also list the Assessor's Parcel Number if the property in which the interest is held is different from the case parcel.

City Official: _____

Partner(s): _____

APN: _____

Signature of Property Owner: _____


Print Name: Michael J. Natter

Subscribed and sworn before me

This 3rd day of March, 2009
Linda B. Castle, Notary Public

Notary Public in and for said County and State



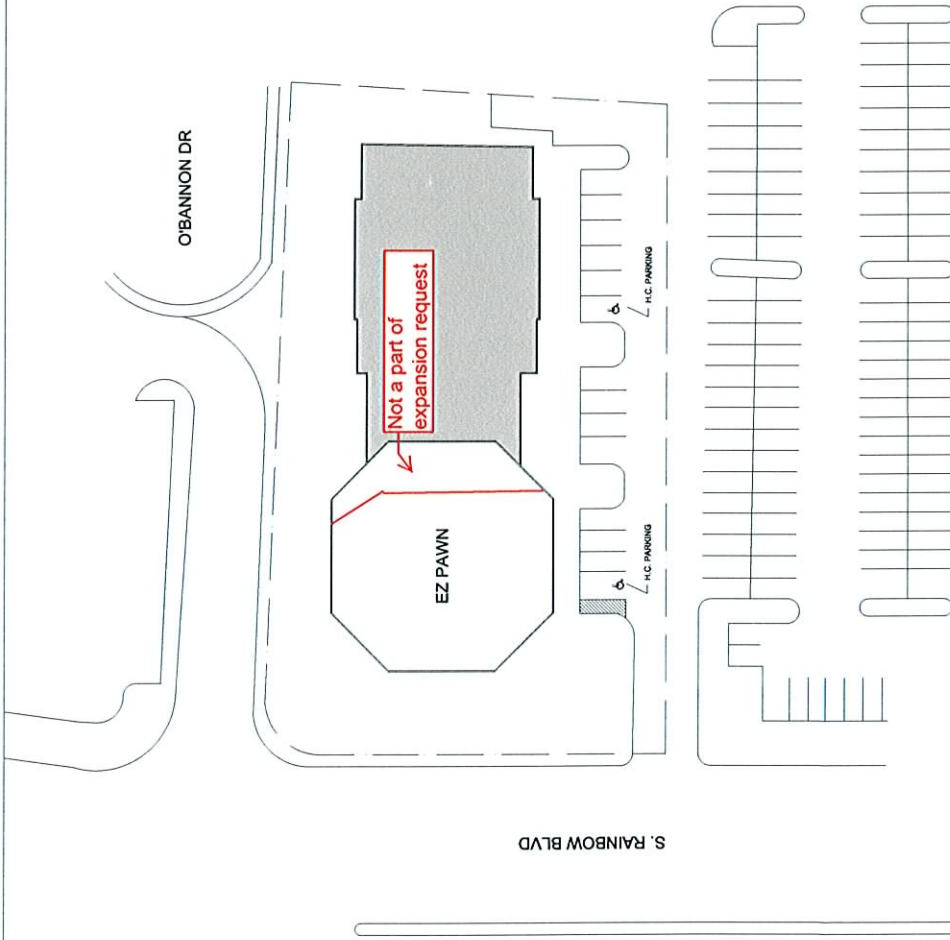

RECEIVED

APR 22 2009

SUP-34014

REVISED

05/14/09 PC

1 SITE PLAN
SCALE: N.T.S.

File Name: 06245-A0-1
Project No: 06245
Date: 03/02/2009
Drawn By: RLJ
Created By: RLJ

A0.1

EZ PAWN
2200 S. RAINBOW
LAS VEGAS, NEVADA

William E. Franz Architect
ARCHITECTS, INC. 1000 S. RAINBOW BLVD. SUITE 100
LAS VEGAS, NEVADA 89102



Frlc
Fritz Jeanes Lazo Corp & Associates, Inc.
Architectural Planning & Construction
4005 Westpark Plaza Suite 510
Fort Worth, Texas 76109
(817) 731-0022

EZ PAWN
2200 S. RAINBOW
LAS VEGAS, NV

REVISIONS


File Name: 06245-A1
Project No: 06245
Date: 03-03-09
Drawn By: RLJ
Checked By: RLJ

A1

RECEIVED

APR 22 2009

SUP-34014
REVISED
05/14/09 PC

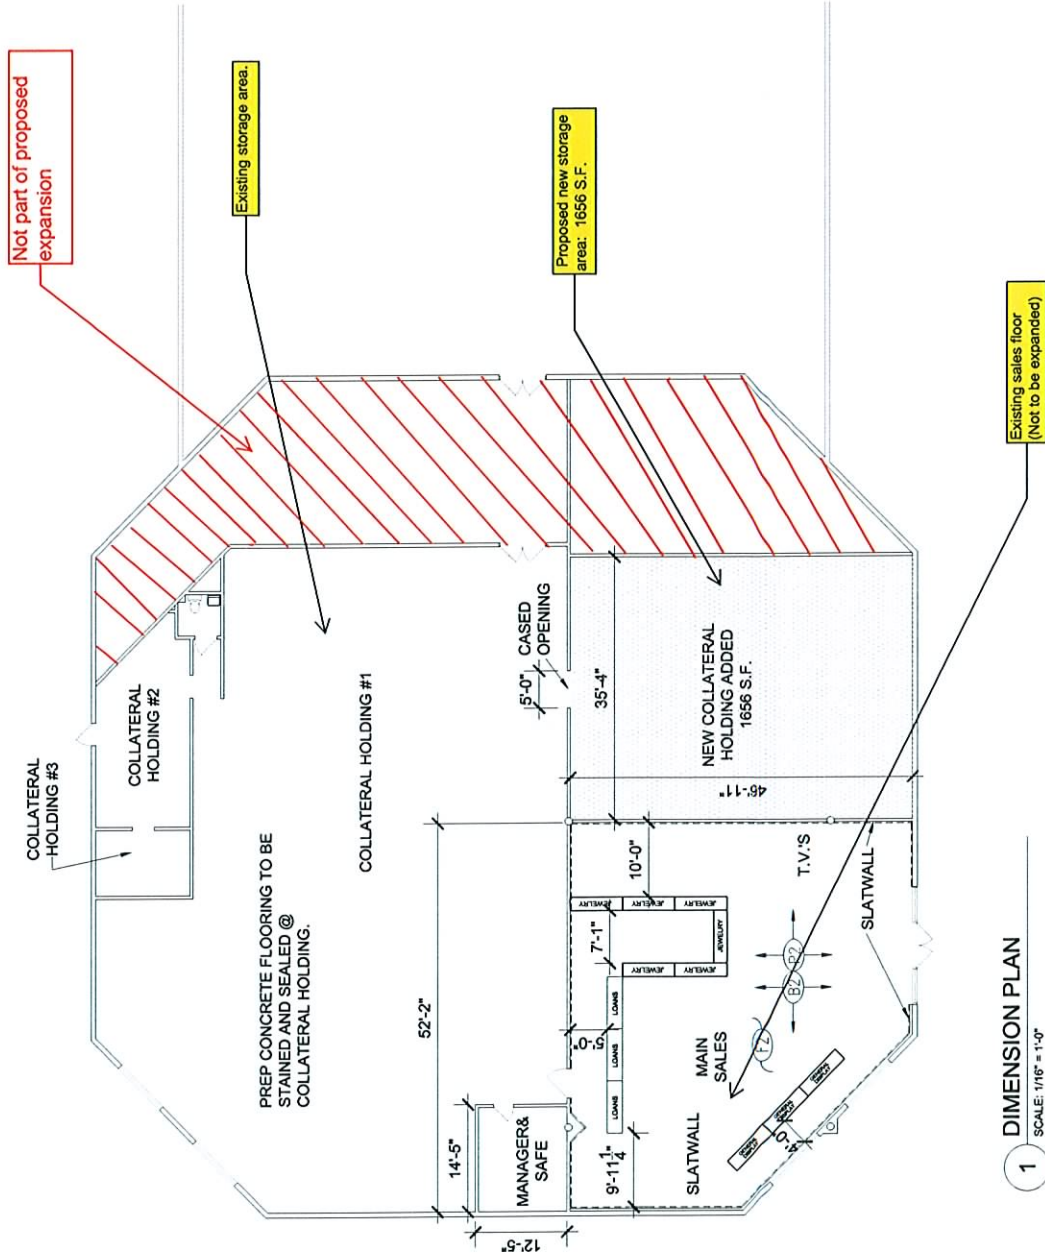

1 DIMENSION PLAN
SCALE: 1/16" = 1'-0"