



PLANNING & DEVELOPMENT DEPARTMENT

STATEMENT OF FINANCIAL INTEREST

Case Number: **VAR-34465** APN: **163-08-220-003**

Name of Property Owner: **LORRAINE - WAUD FAMILY TRUST**

Name of Applicant: **JOHN WAUD**

Name of Representative: **JOHN WAUD**

To the best of your knowledge, does the Mayor or any member of the City Council or Planning Commission have any financial interest in this or any other property with the property owner, applicant, the property owner or applicant's general or limited partners, or an officer of their corporation or limited liability company?

☐ Yes

☒ No

If yes, please indicate the member of the City Council or Planning Commission who is involved and list the name(s) of the person or persons with whom the City Official holds an interest. Also list the Assessor's Parcel Number if the property in which the interest is held is different from the case parcel.

City Official: _____

Partner(s): _____

APN: _____

Signature of Property Owner: _____


Print Name: **JOHN WAUD**

Subscribed and sworn before me

This **11th** day of **May**, 20 **09**

State of Nevada County of Clark
Notary Public in and for said County and State

Diana S. Menesini

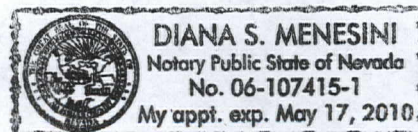

KEY NOTES


LOT AREA: 20267 SQ. FT. (46 ACRES)

LOT COVERAGE: (7,908 SQ. FT. UNDER ROOF) = 39.0%



RECEIVED
MAY 12 2009

VAR-34465
06/25/09 PC

DATE: 05-12-08
 PROJECT: WALD RESIDENCE
 SHEET: 01001

JOHN B. WALD
 ZONING: 05-12-08
 ASSASSORS PARCEL NUMBER: 163-08-220-003
 2909 COAST LINE COURT
 LAS VEGAS, NV 89117

KEY NOTES

1. EXISTING LOT AREA: 20,267 SQ. FT. (46 ACRES)
 2. LOT COVERAGE: 17,908 SQ. FT. UNDER ROOF = 88.4%

1. EXISTING LOT AREA: 20,267 SQ. FT. (46 ACRES)
 2. LOT COVERAGE: 17,908 SQ. FT. UNDER ROOF = 88.4%

RECEIVED
 MAY 12 2009

VAR-34465
 06/25/09 PC

PERMIT DATE: _____
 PERMIT NUMBER: _____
 PROJECT NAME: _____
 SHEET NO.: _____

JOHN B. WALD
 ZONING: 05-12-08
 2909 COAST LINE COURT
 LAS VEGAS, NV 89117
 ASSESSORS PARCEL NUMBER - 163-08-220-003

JOHN B. WALD
 ZONING: 05-12-08
 2909 COAST LINE COURT
 LAS VEGAS, NV 89117
 ASSESSORS PARCEL NUMBER - 163-08-220-003

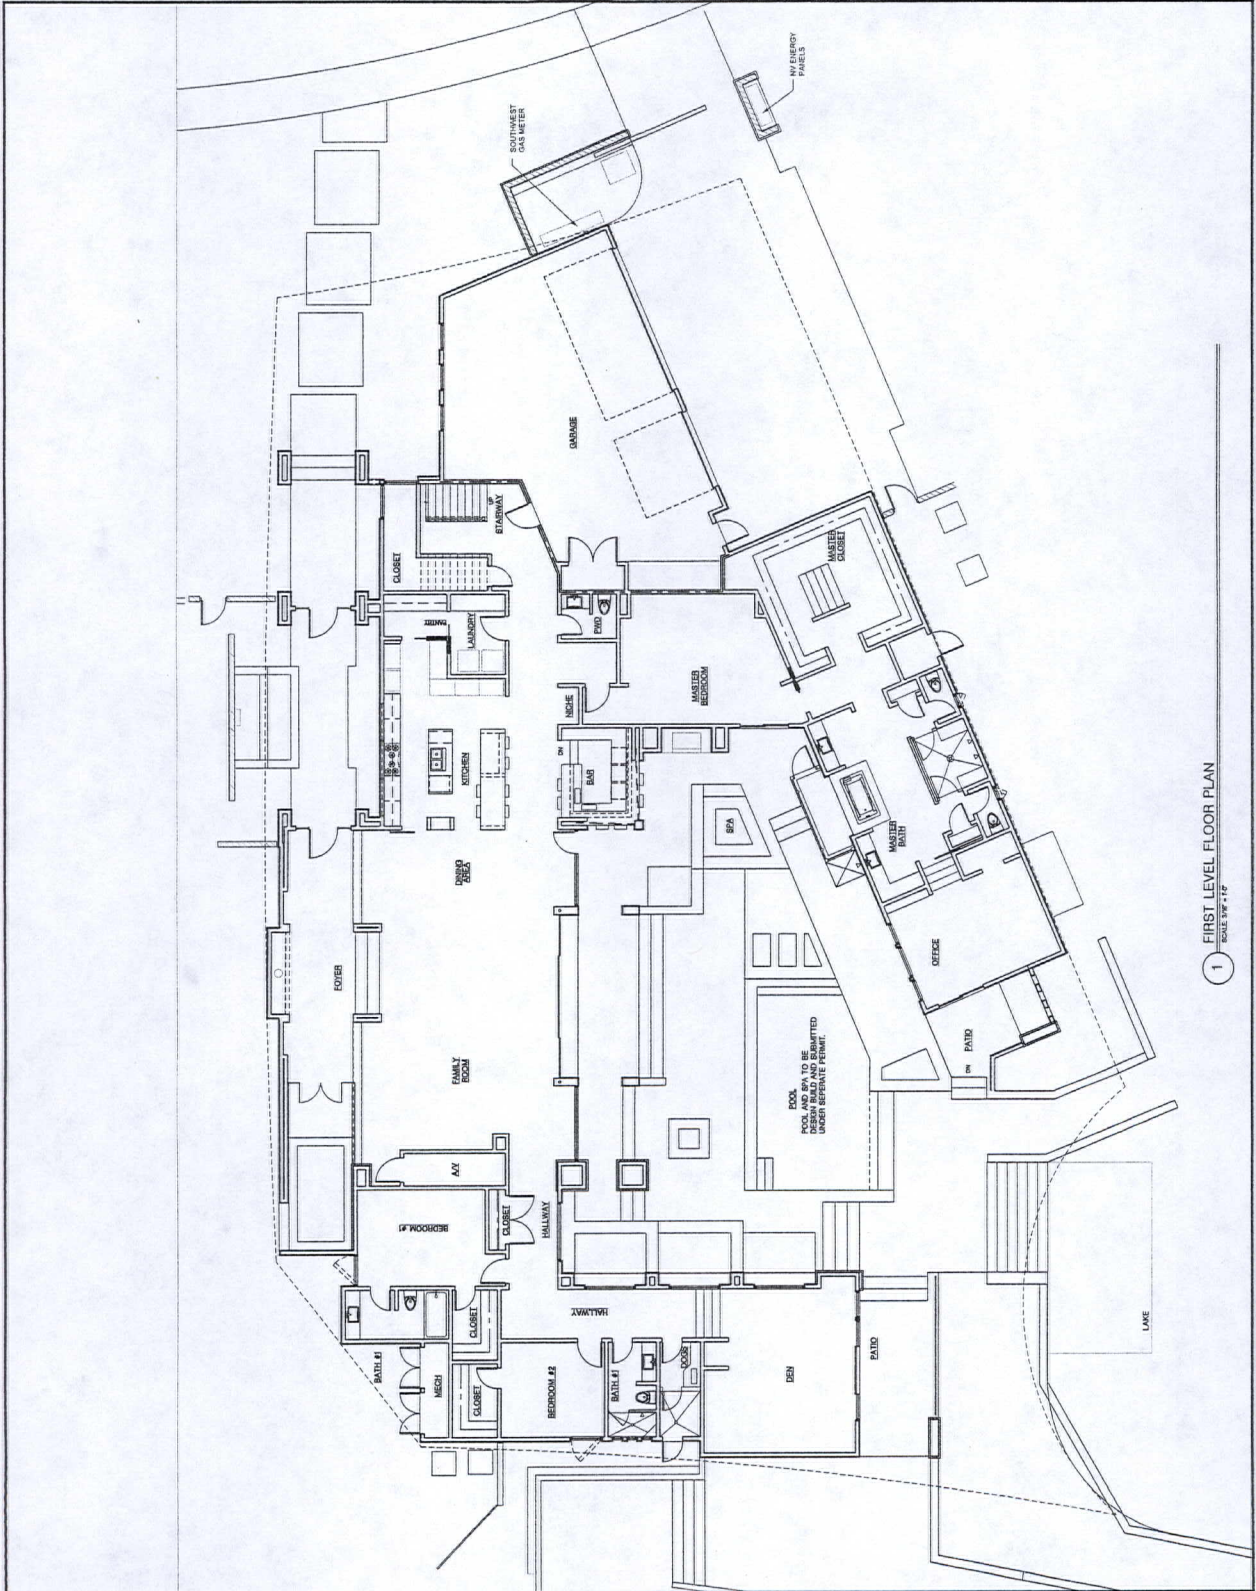

FLOOR PLAN
 A1.01

1 FIRST LEVEL FLOOR PLAN
 SCALE: 1/8" = 1'-0"

RECEIVED
 MAY 12 2009

VAR-34465
 06/25/09 PC




JOB NUMBER: 07001

MAC 623 780

JOHN B. WALD


ZONING : 05-12-08

WALD RESIDENCE
2909 COAST LINE COURT
LAS VEGAS, NV 89117
ESSORS PARCEL NUMBER - 163-08-22-20

ASSESSORS PARCEL NUMBER - 163-08-220-003

SECOND LEVEL
FLOOR PLAN AND
LOW ROOF PLAN

A1.02

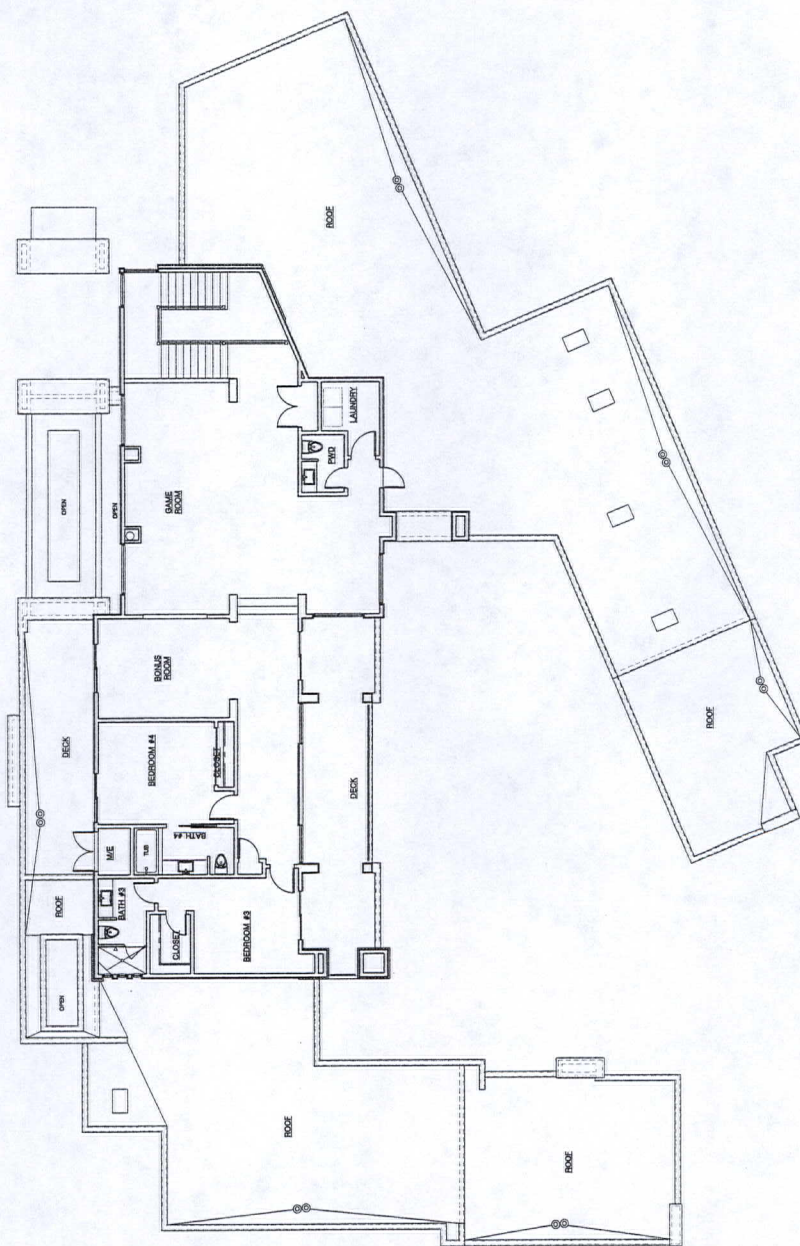

1 SECOND LEVEL FLOOR PLAN AND LOW ROOF PLAN
SCALE: 1/8" = 1'-0"

RECEIVED
MAY 12 2009

VAR-34465
06/25/09 PC

KEY NOTES

- [illegible]

- [illegible]

- [illegible]

- [illegible]

- [illegible]

PERMIT ISSUE DATE:
REVISION:

JOB NUMBER: 07001


NAC 623.780

JOHN B. WALD


WALD RESIDENCE
2909 COAST LINE COURT
LAS VEGAS, NV 89117
ASSESSORS PARCEL NUMBER - 163-08-220-003

EXTERIOR ELEVATIONS


A2.00

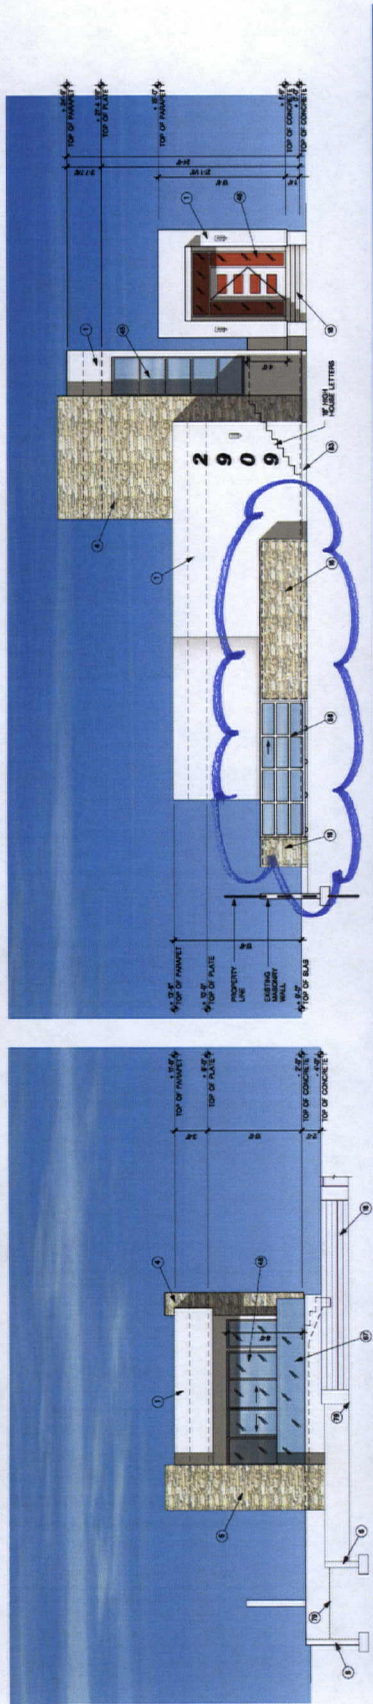

ELEVATION

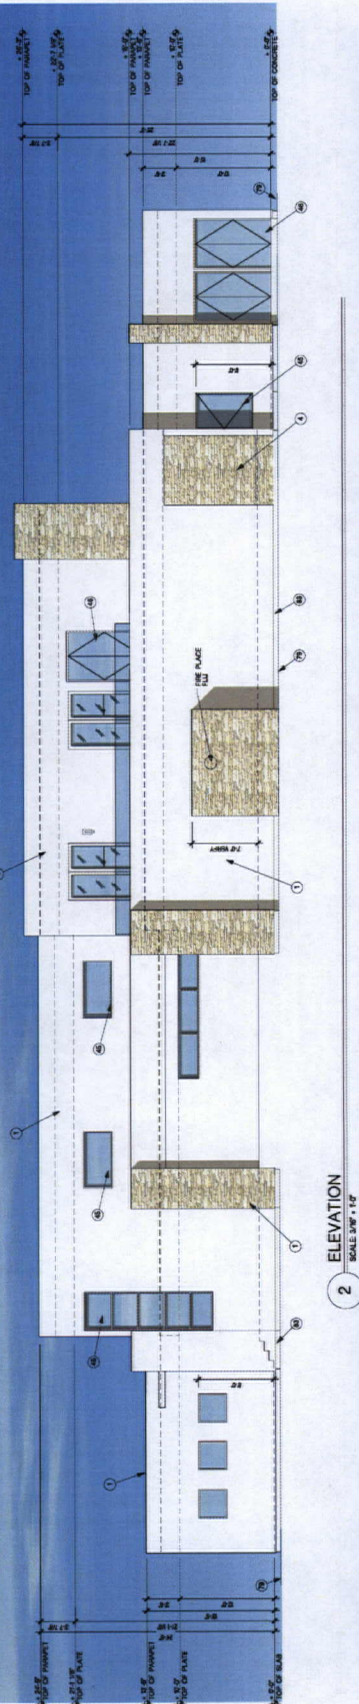ELEVATION

ELEVATION

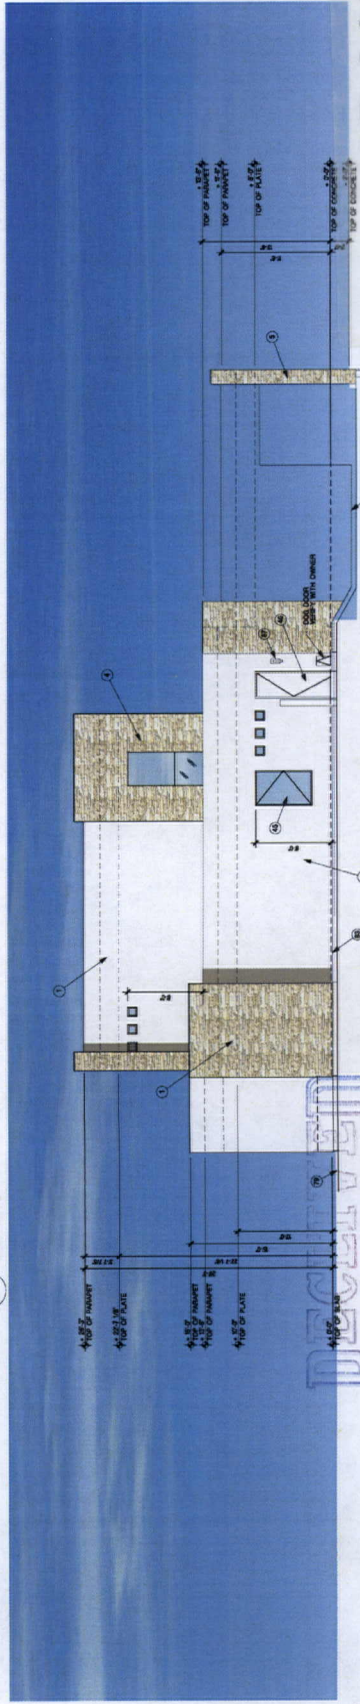

EVALUATION

VAR-34465

06/25/09 PC

12 2009

RECEIVED
MAY 12 2009

5' 0" High Enclosure