



PLANNING & DEVELOPMENT DEPARTMENT

STATEMENT OF FINANCIAL INTEREST

Case Number: **SUP-34596** APN: _____

Name of Property Owner: _____

Name of Applicant: VINNY-BOY'S ITALIAN MARKET PLACE

Name of Representative: _____

To the best of your knowledge, does the Mayor or any member of the City Council or Planning Commission have any financial interest in this or any other property with the property owner, applicant, the property owner or applicant's general or limited partners, or an officer of their corporation or limited liability company?

_____ Yes

_____ ☒ No

If yes, please indicate the member of the City Council or Planning Commission who is involved and list the name(s) of the person or persons with whom the City Official holds an interest. Also list the Assessor's Parcel Number if the property in which the interest is held is different from the case parcel.

City Official: _____


Partner(s): _____

APN: _____


Signature of Property Owner: _____

Print Name: ALAN MERRELL II

Subscribed and sworn before me

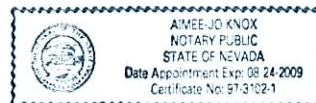This 8 day of June, 2009Amee Jo Knox
Notary Public in and for said County and State

· EL CAMINO

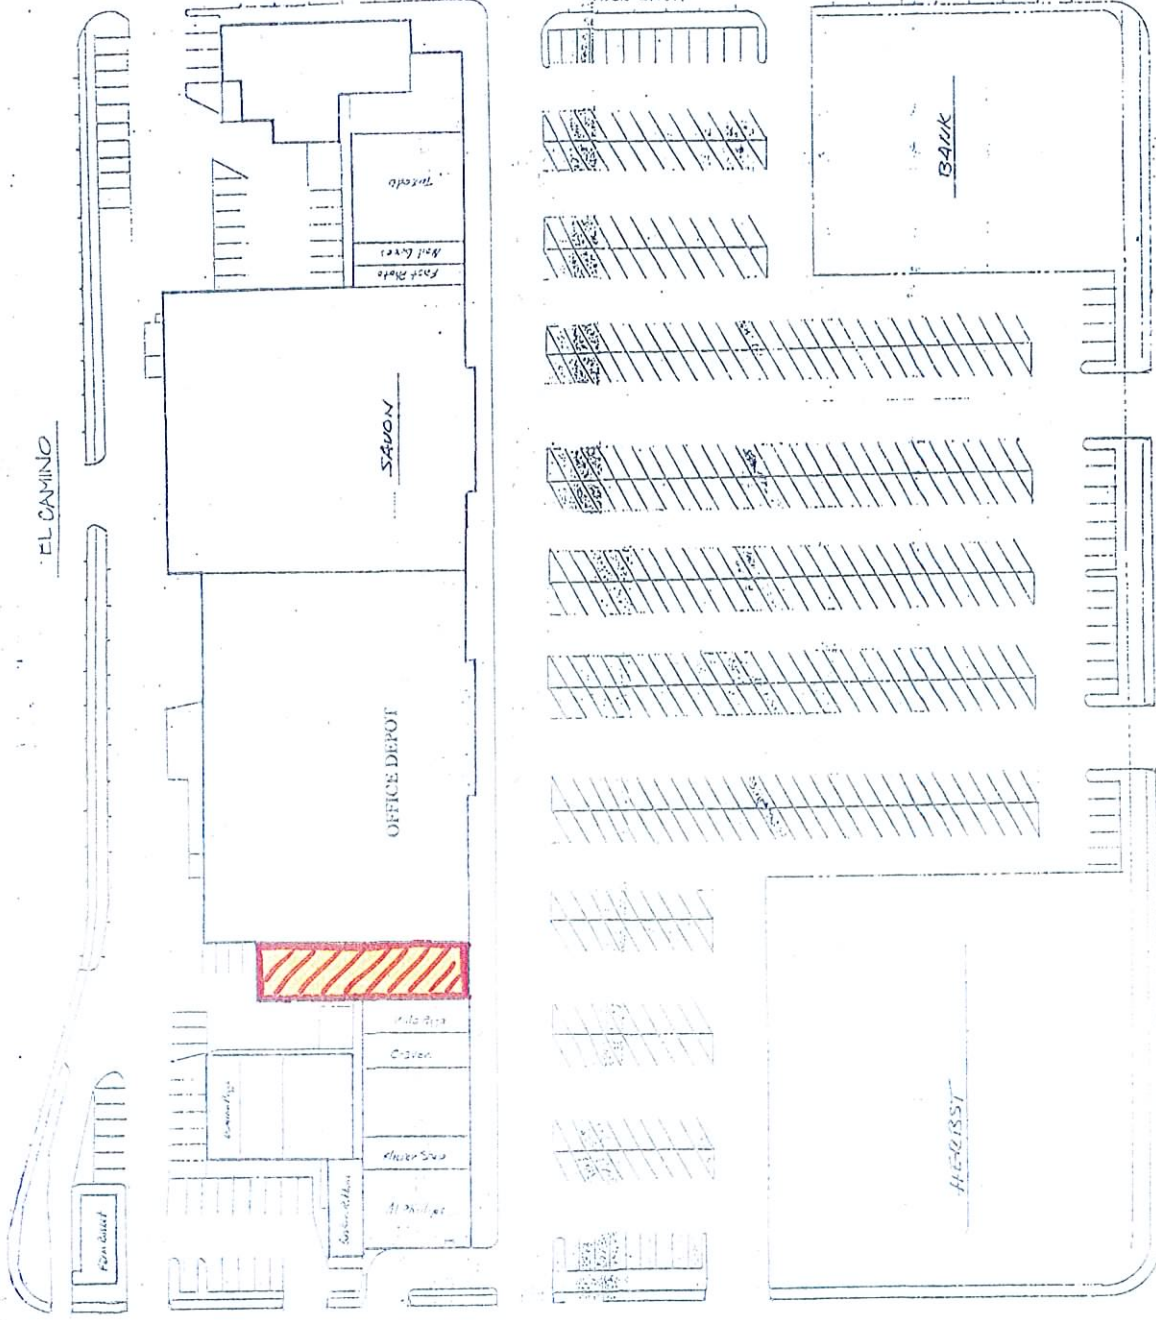

VALLEY VIEW


JUN 12 2009

**SUP-34596
REVISED
07/09/09 PC**

Vinnys Boys Italian Market
3620 W Sahara Ave #2
Las Vegas, NV 89102

Contact: Vinny

OVERALL SQ
FOOTAGE = 4,375 S.F.

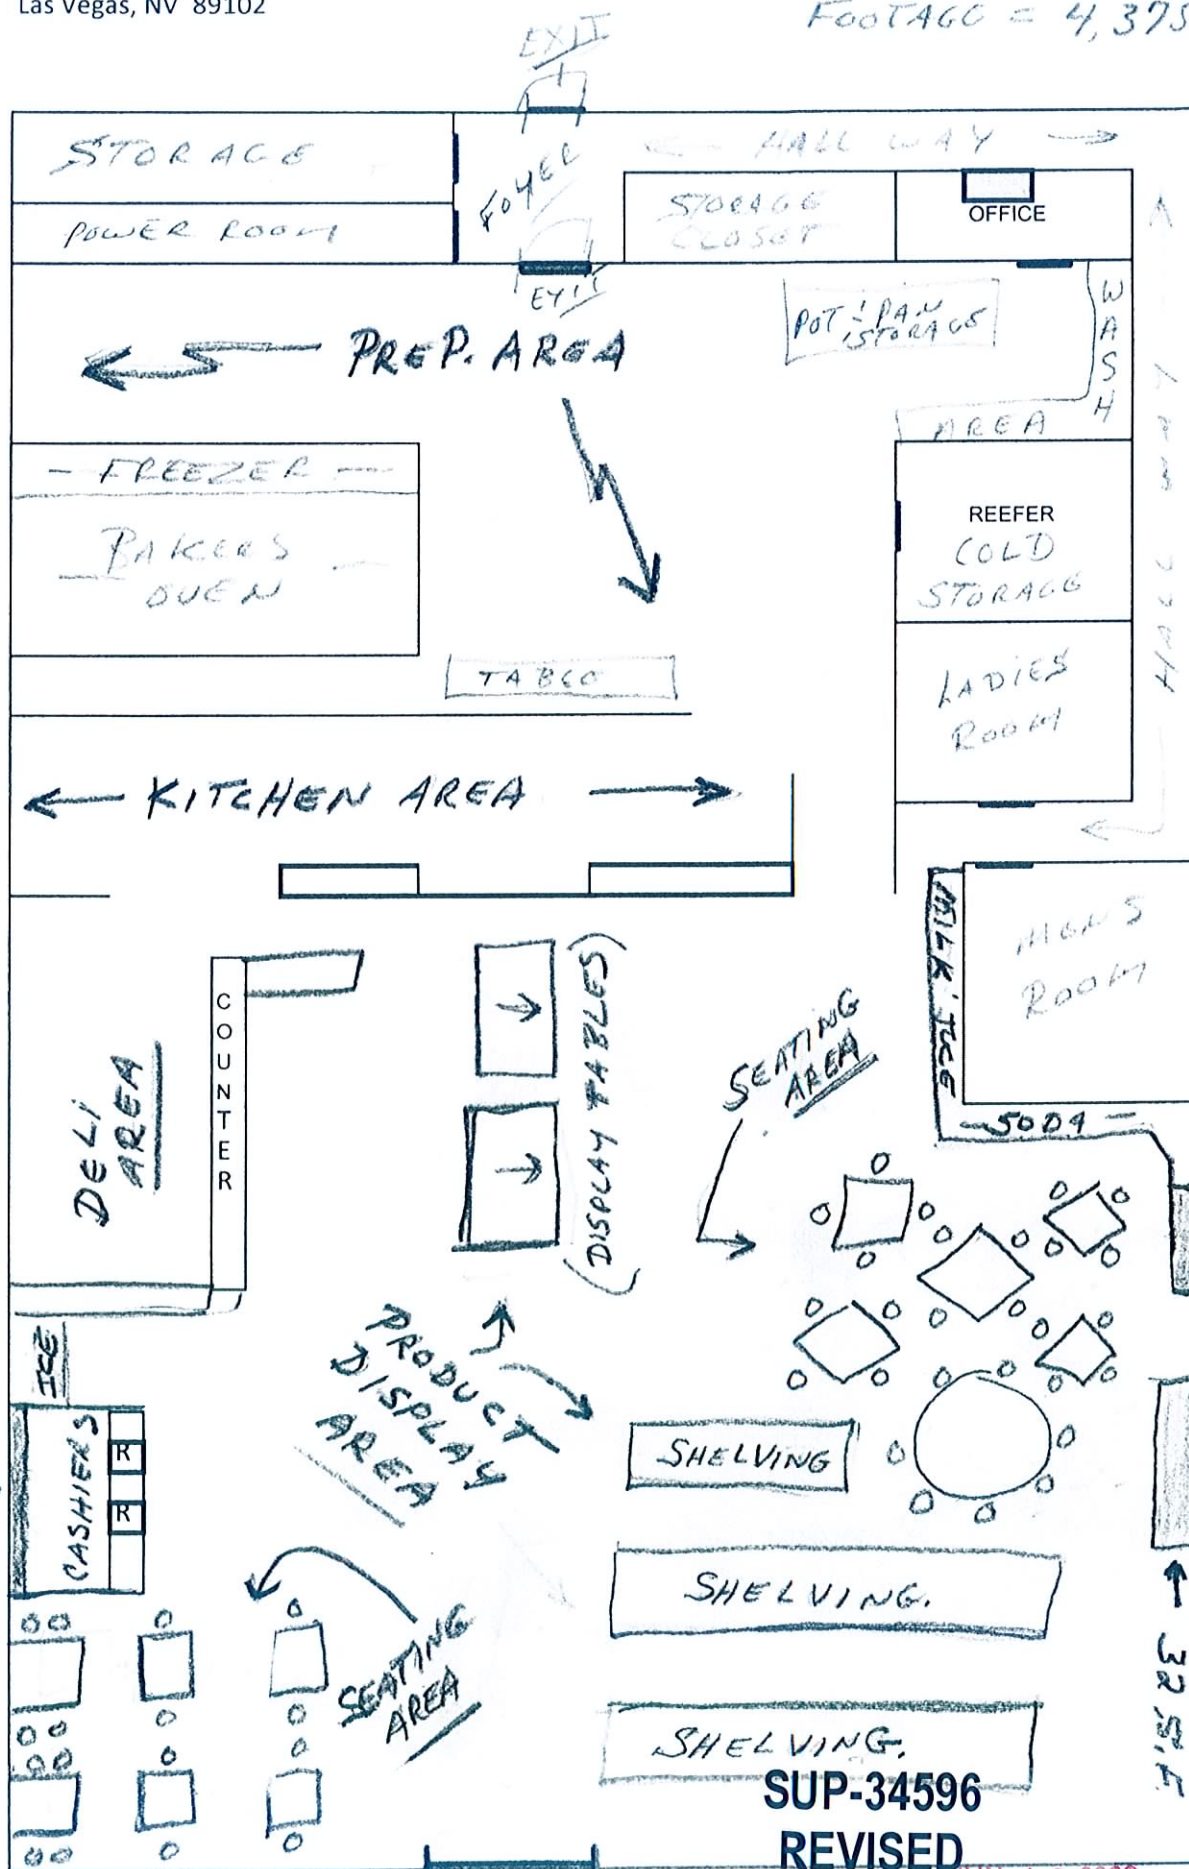

SHADED AREA IS FOR
EXPENSIVE WINE DISPLAY (2'X16')
32 S.F.

(4'X4')
16 SF.
SHADED AREA
COLD BEER/WINE
DISPLAY

IN-EXPENSIVE WINE
DISPLAY I.E. GALLON
BOTTLES - 16 CT. (4'X8')

SUP-34596

REVISED

JUN 12 2009

ENTRANCE / EXIT 07/09/09 PC