



RQR-34844

Name of Representative: The Skancke Company

 No

APN: _____

Print Name: _____



f:\depot\Application Packet\Statement of Financial Interest.doc

SITE PLAN

I-15 E/L N. CHARLESTON



I-515

I-95

DOUBLE
SIDED
BILLBOARD

TENT BUILDING

TENT BUILDING

TENT BUILDING

W. DISCOVERY DR.

CITY PARKWAY

APN # 139-33-511-004

S. GRAND CENTRAL PARKWAY


RECEIVED

JUN 11 2009

RQR-34844
08/13/09 PC

L-36-26-01
J83

9

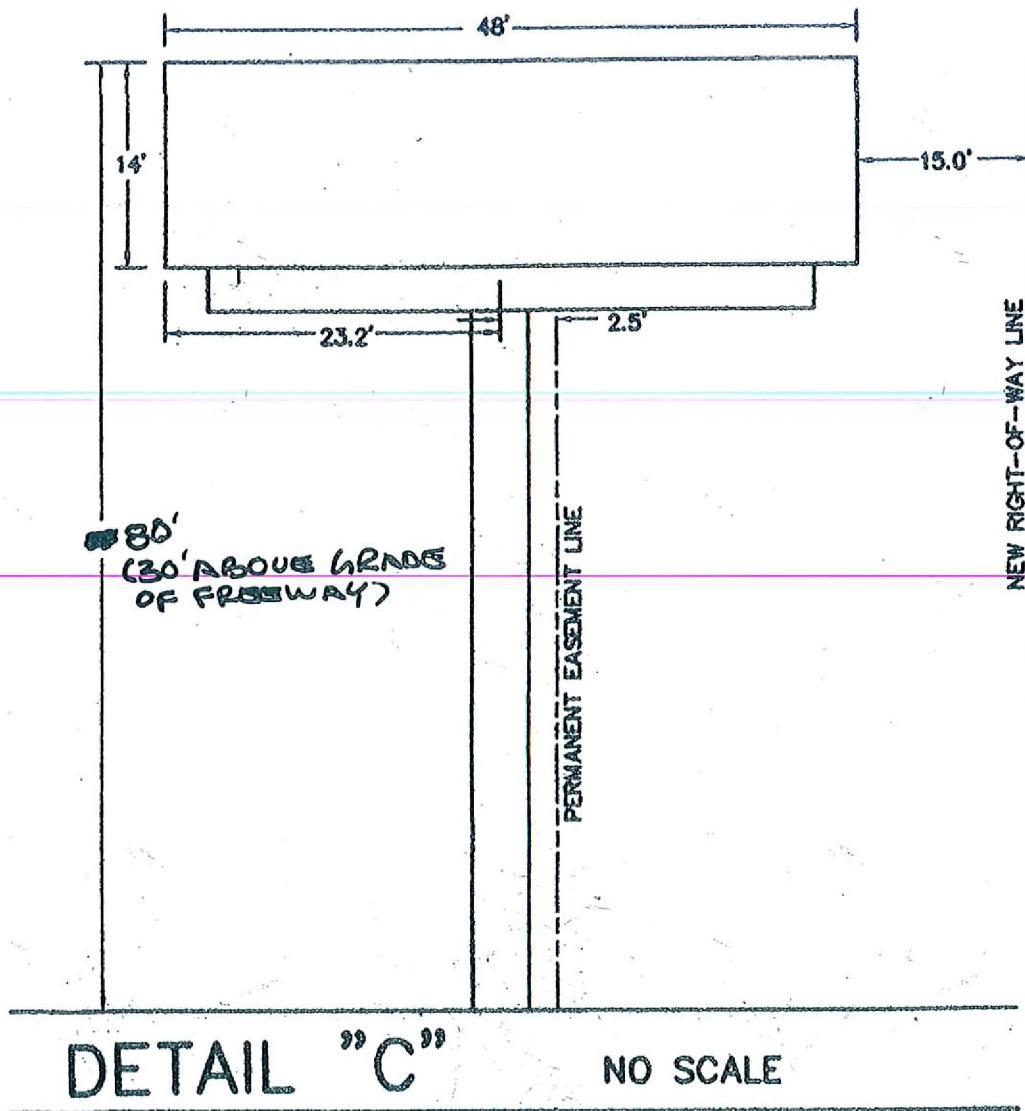

RECEIVED

JUN 11 2009

RQR-34844
08/13/09 PC