



PLANNING & DEVELOPMENT DEPARTMENT

STATEMENT OF FINANCIAL INTEREST

Case Number: SUP-34598 APN: 162-09-102-002

Name of Property Owner: 2701 WESTWOOD LLC, ROBERT BRANDO

Name of Applicant: DR. KIT WEATHERS

Name of Representative: LAW OFFICES OF JAY BROWN

To the best of your knowledge, does the Mayor or any member of the City Council or Planning Commission have any financial interest in this or any other property with the property owner, applicant, the property owner or applicant's general or limited partners, or an officer of their corporation or limited liability company?

☐ Yes

☒ No

If yes, please indicate the member of the City Council or Planning Commission who is involved and list the name(s) of the person or persons with whom the City Official holds an interest. Also list the Assessor's Parcel Number if the property in which the interest is held is different from the case parcel.

City Official: _____

Partner(s): _____


APN: _____


Signature of Property Owner: 


Print Name: Robert Brandy

Subscribed and sworn before me

This 26th day of May, 20 09

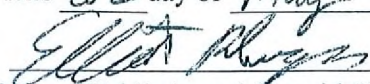
Notary Public in and for said County and State

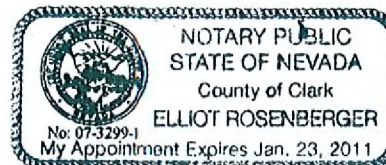

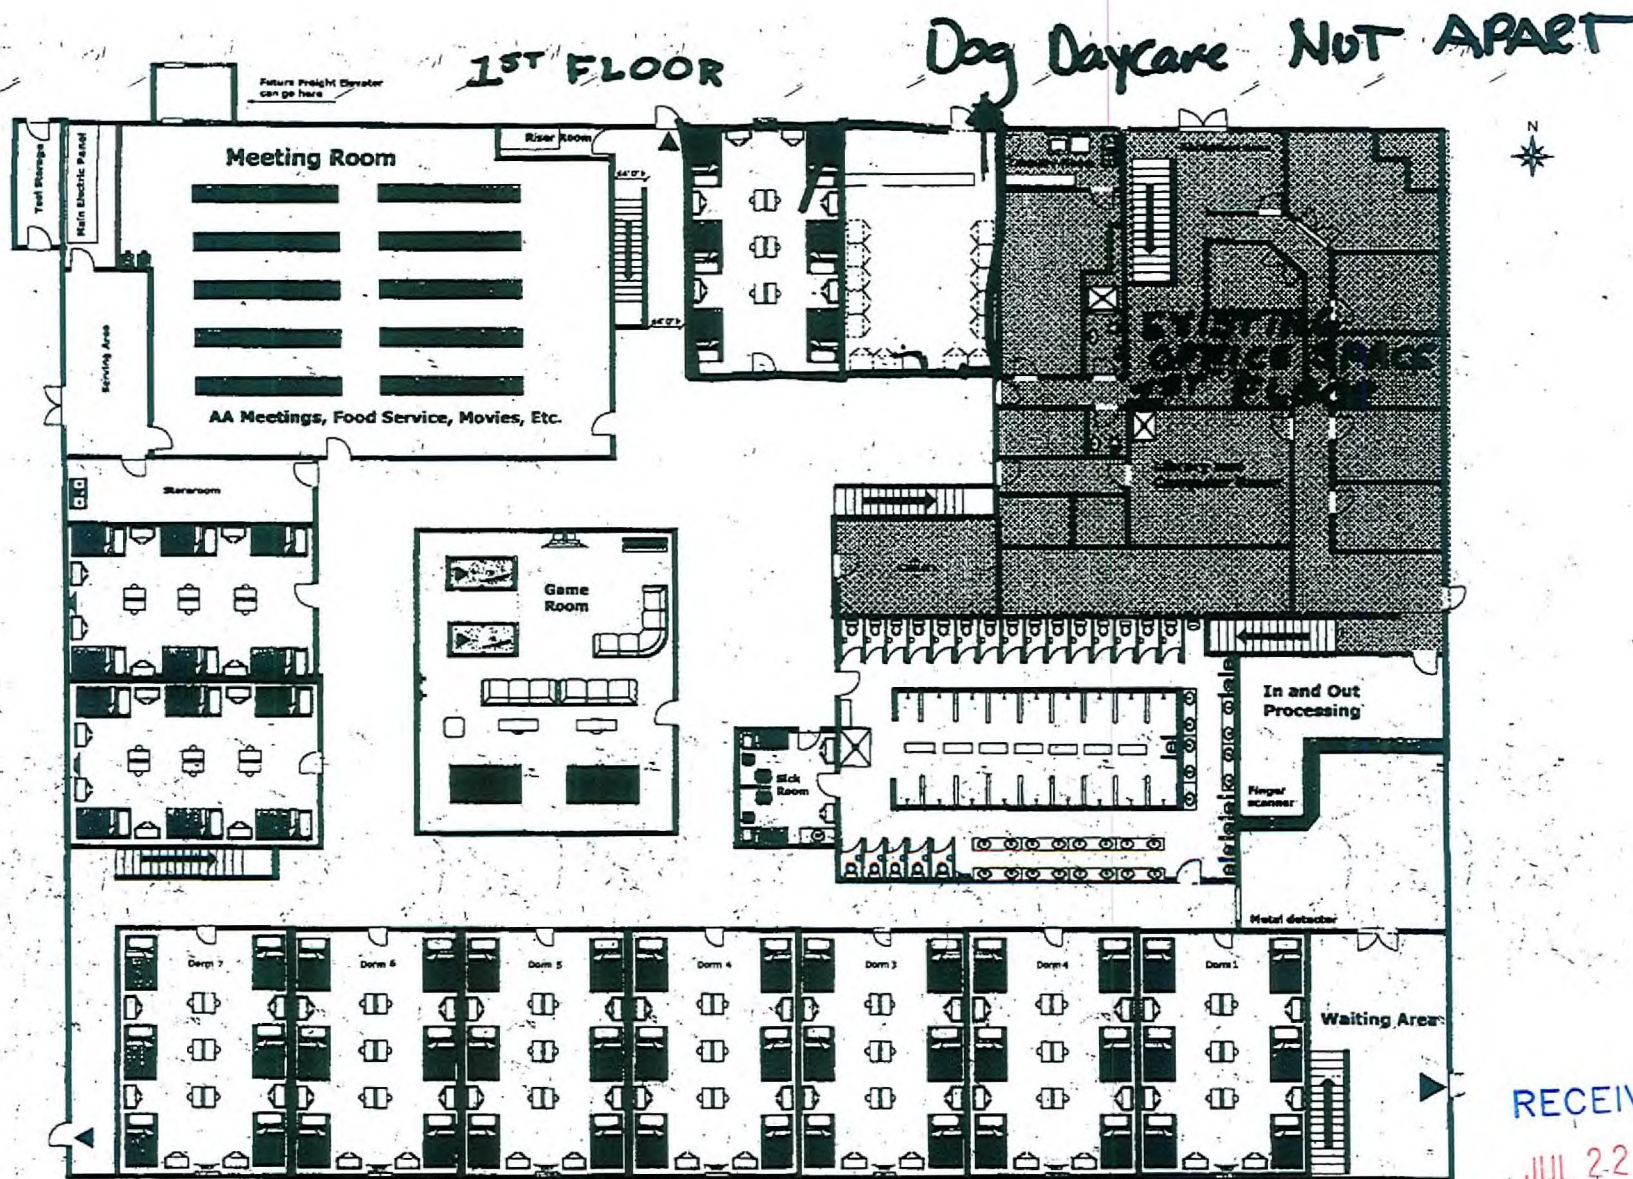

2701 Westwood Drive - First Floor - Ten 30' x 20' Dorms - 12 people per dorm
Golden Passages - 702-341-0987

SUP-34598

REVISED

08/13/09 PC

RECEIVED

JUL 22 2009