



PLANNING & DEVELOPMENT DEPARTMENT

STATEMENT OF FINANCIAL INTEREST

Case Number: **WVR-35710** APN: 125-20-810-002
Name of Property Owner: Montecito Partners LLC
Name of Applicant: Montecito Partners LLC
Name of Representative: Martin Harris Construction

To the best of your knowledge, does the Mayor or any member of the City Council or Planning Commission have any financial interest in this or any other property with the property owner, applicant, the property owner or applicant's general or limited partners, or an officer of their corporation or limited liability company?

☐ Yes

☒ No

If yes, please indicate the member of the City Council or Planning Commission who is involved and list the name(s) of the person or persons with whom the City Official holds an interest. Also list the Assessor's Parcel Number if the property in which the interest is held is different from the case parcel.

City Official: _____

Partner(s): _____

APN: _____

Signature of Property Owner: _____

Print Name: Michael S. Curless

Subscribed and sworn before me

This 31st day of March, 2009

[Signature]
Notary Public in and for said County and State



Sarah E. Kuester
#553566
Hamilton County
My Commission Expires on:
September 11, 2014



IMPROVEMENT PLANS FOR MONTECITO POINT

APN# 125-20-810-002

LAUTH

7887 E. BELLEVUE AVENUE, SUITE 900
ENGLEWOOD, COLORADO, 80111
(720) 279-5400 - PHONE
(720) 279-5319 - FAX

DEVELOPER
LAUTH PROPERTY GROUP
7887 E. BELLEVUE AVE., SUITE 900
ENGLEWOOD, CO 80111

NOTES:
1. NORTH: MONTECITO POINT, BEING THE BEARING OF THE WEST LINE OF THE NORTH 1/4 SECTION 20, TOWNSHIP 19 NORTH, RANGE 90 EAST, MEAS. AC. SHOWN IN SECTION 20, TOWNSHIP 19 NORTH, RANGE 90 EAST, MEAS. AC. SHOWN IN RECORDS OF THE CITY OF LAS VEGAS, NEVADA.


INDEX	
NO.	SHEET NAME
1	C1.1 COVER SHEET

APPROVAL OF THESE PLANS BY THE CITY ENGINEER IS LIMITED TO THE TECHNICAL ASPECTS OF THE PLANS. THE CITY ENGINEER DOES NOT ASSUME RESPONSIBILITY FOR THE ACCURACY OF THE INFORMATION PROVIDED TO THE CITY ENGINEER. 

REV #	REV DESCRIPTION	SHEET NO.	DATE

LANDSCAPE VE. CHANNELS

WVR-35710

10/08/09 PC

LAUTH

LAUTH PROPERTY GROUP
317-848-6500 • info@lauth.com

LAUTH PROPERTY GROUP
317-848-6500 • info@lauth.com

CITY OF LAS VEGAS
PLANNING & DEVELOPMENT




Core and Sh
6605 Grand
Las Vegas, N


39


1-800-368-2041
PRAIRIE

PROJECT OFFICE DATE

WVR-35710
10/08/09 PC

0162600

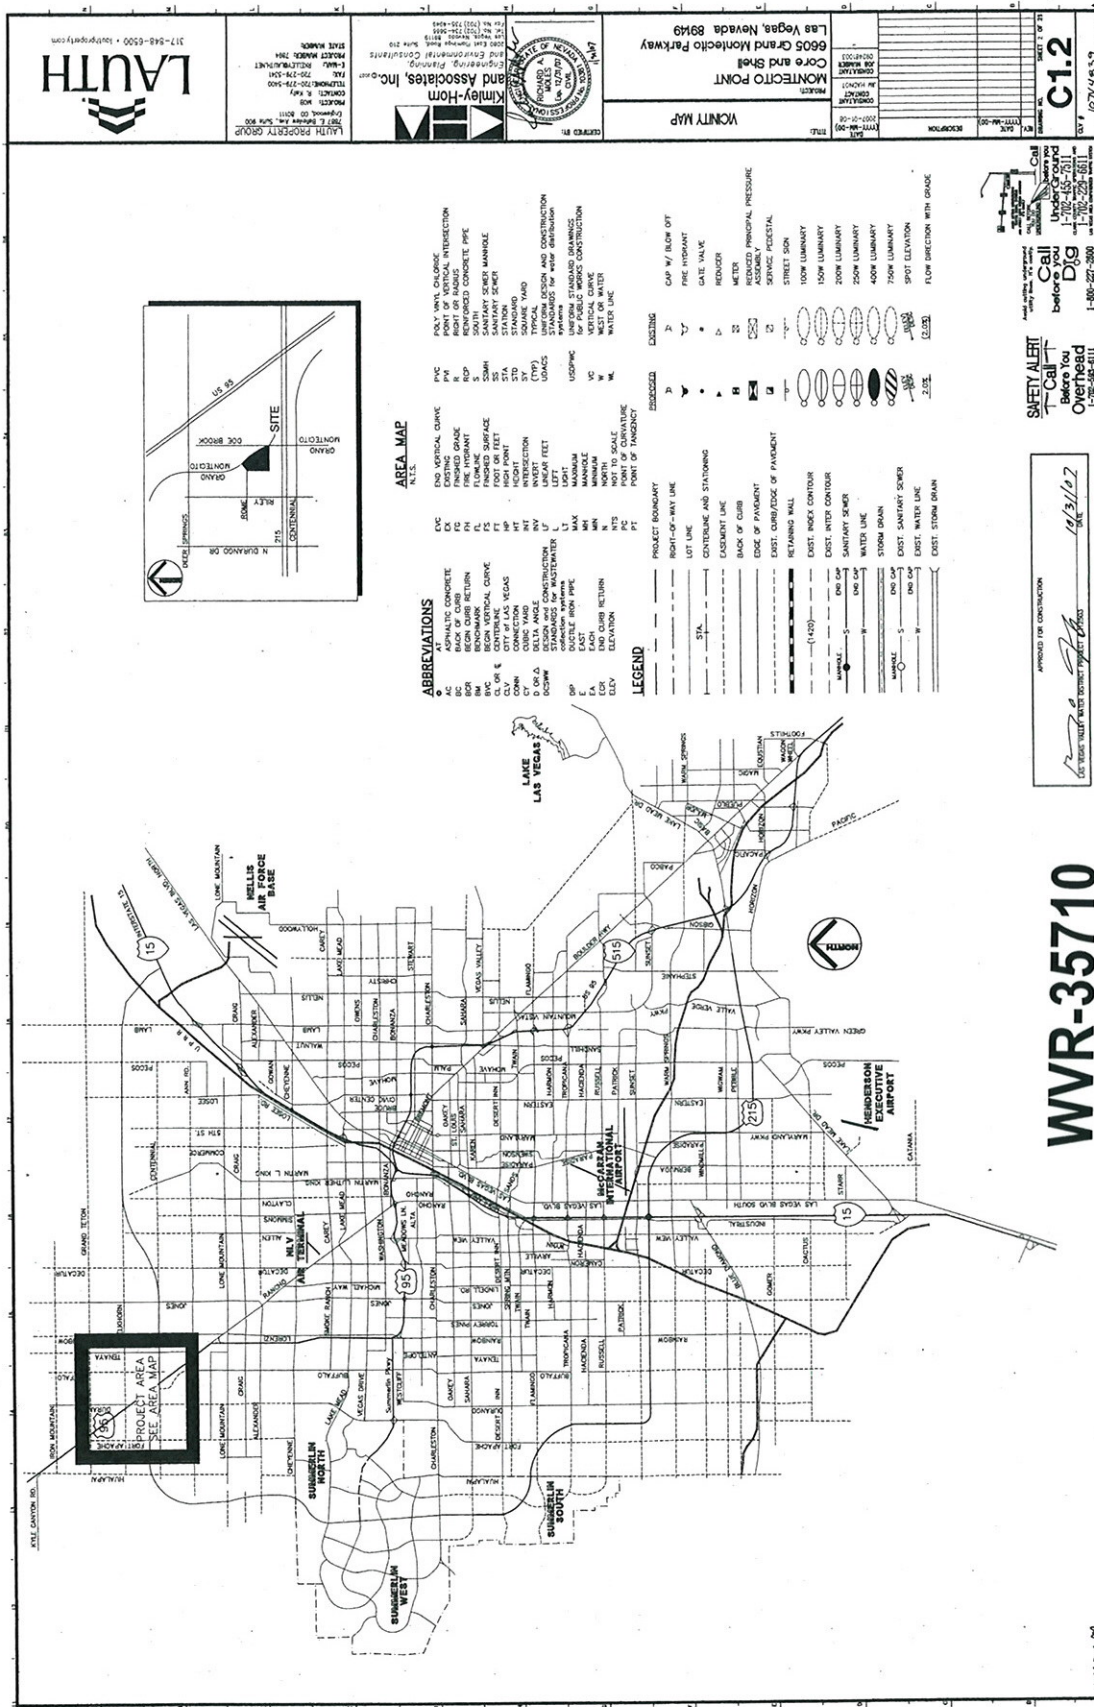

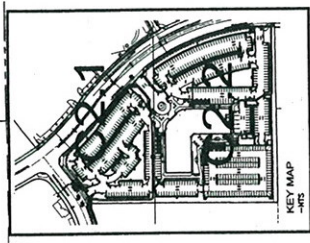


WVR-35710
10/08/09 PC





CITY OF LAS VEGAS
PLANNING & DEVELOPMENT

CLY # 107V4839

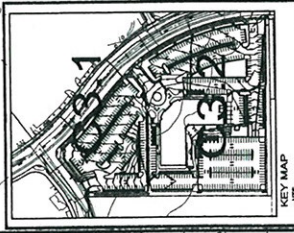

WVR-35710
10/08/09 PC

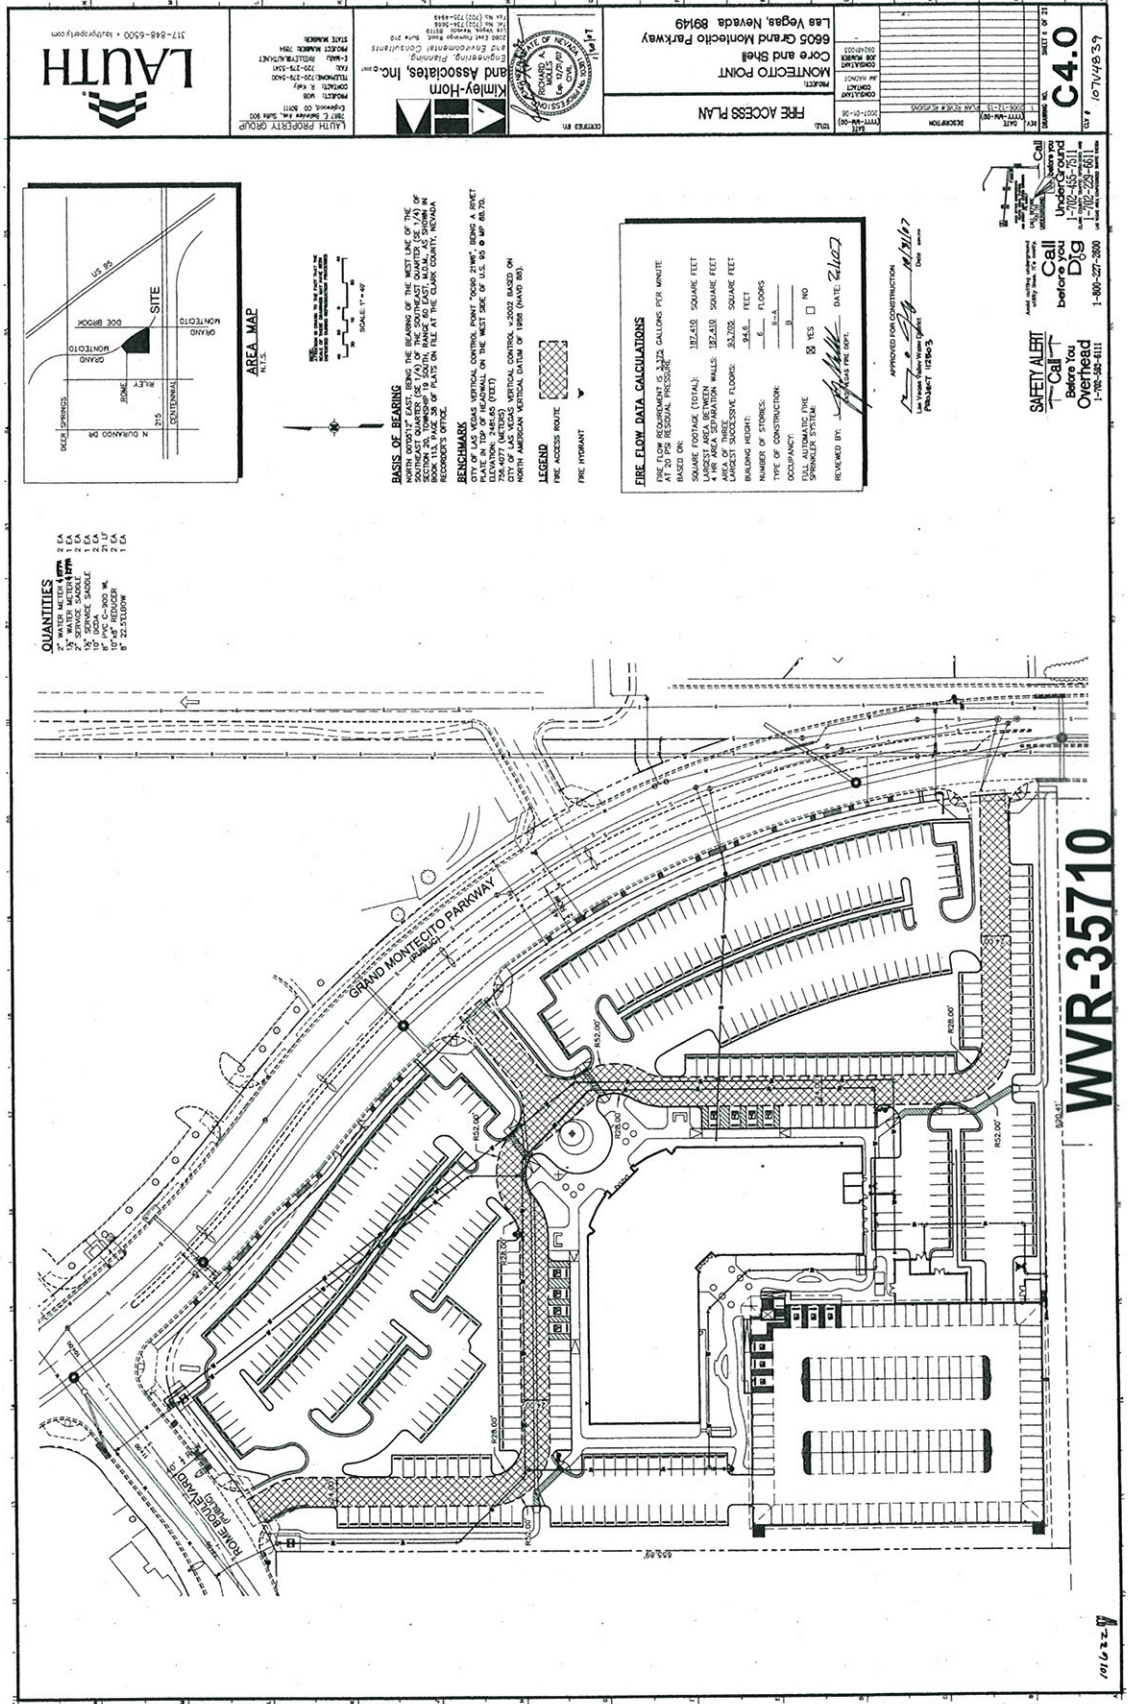

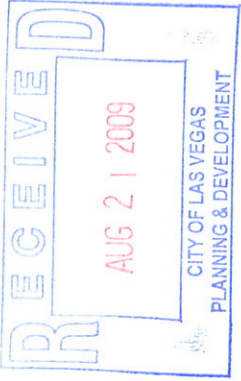





LAUTH



FIRE FLOW DATA CALCULATIONS

FULL AUTOMATIC FIRE SPRINKLER SYSTEM ☐ YES ☐ NO ☐
REVIEWED BY: *[Signature]* DATE 2/4/07
FOR 4500 FIRE DEPT.

SEWER FLOW

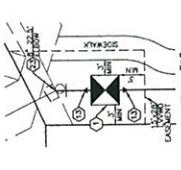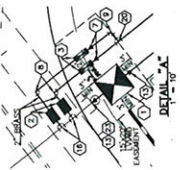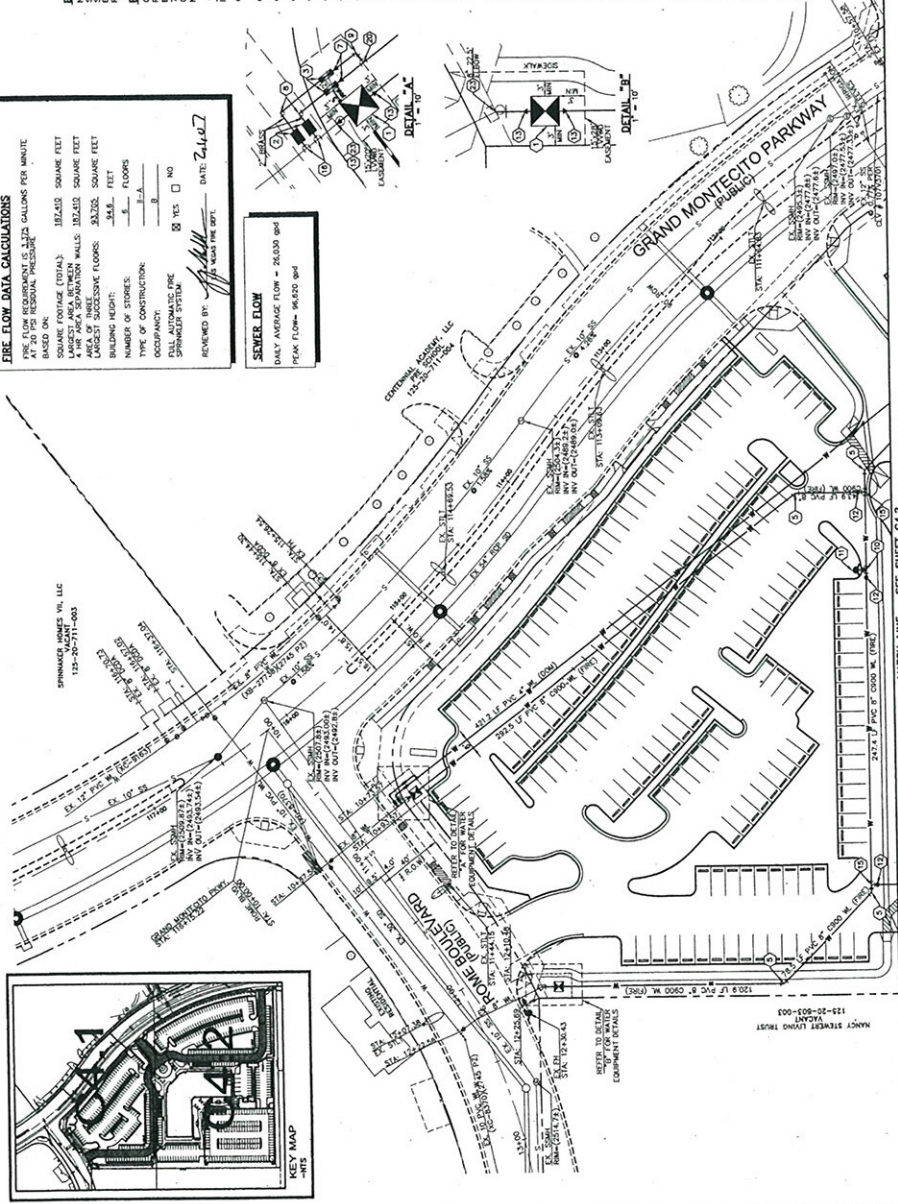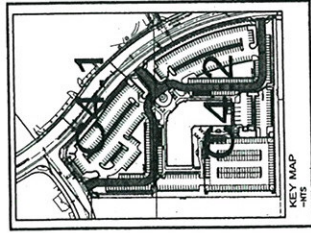

- NOTES:**
1. ALL EXISTING UTILITY LOCATIONS SHOWN HEREIN ARE APPROXIMATE. ONLY IT SHALL BE THE CONTRACTOR'S RESPONSIBILITY TO VERIFY THE LOCATION OF ALL EXISTING UTILITIES PRIOR TO CONSTRUCTION. THE CONTRACTOR SHALL BE RESPONSIBLE FOR OBTAINING ALL NECESSARY PERMITS AND SHALL BE RESPONSIBLE FOR THE PROTECTION OF ALL EXISTING UTILITIES. 
 2. CONTRACTOR TO FIELD VERIFY EXISTING SURVEY ELEVATION PRIOR TO CONSTRUCTION.
 3. THIS PROPERTY MAY HAVE STATIC WATER PRESSURE IN EXCESS OF 100 PSI. THE CONTRACTOR SHALL BE RESPONSIBLE FOR THE PROTECTION OF ALL EXISTING UTILITIES. 
 4. CONTRACTOR TO FIELD VERIFY EXISTING SURVEY ELEVATION PRIOR TO CONSTRUCTION.
SAFETY ALERT
Call before you dig
1-800-227-4111

APPROVALS
10/08/09 PC

WVR-35710

10/08/09 PC

INSTALLATION OF DOUBLE CHECK DETECTOR ASSEMBLY (2.10)
THE DOUBLE CHECK DETECTOR ASSEMBLY SHALL BE INSTALLED IN ACCORDANCE WITH THE LOCAL CODES AND CONSTRUCTION STANDARDS. THE CONTRACTOR SHALL BE RESPONSIBLE FOR THE PROTECTION OF ALL EXISTING UTILITIES. 

REDUCED PRESSURE PRINCIPLE ASSEMBLY (2.2)
APPROVED REDUCED PRESSURE PRINCIPLE ASSEMBLY SHALL BE INSTALLED IN ACCORDANCE WITH THE LOCAL CODES AND CONSTRUCTION STANDARDS. THE CONTRACTOR SHALL BE RESPONSIBLE FOR THE PROTECTION OF ALL EXISTING UTILITIES. 

UTILITY PLAN 1
6605 Grand Montecito Parkway
Las Vegas, Nevada 89149
Core and Shell
Montecito Point

C4.1
10/08/09 PC


RECEIVED
AUG 21 2009
CITY OF LAS VEGAS
PLANNING & DEVELOPMENT

CITY OF LAS VEGAS
PLANNING & DEVELOPMENT


WVR-35710
10/08/09 PC


CITY OF LAS VEGAS
PLANNING & DEVELOPMENT

AUG 21 2009

RECEIVED

FILE
A-005
DATE
11/05/08

PROJECT
MONTICITO OFFICE BUILDING
Core and Shell
Las Vegas, Nevada



SEM
6775 Corporate Blvd
Suite 200
Las Vegas, NV 89148
702.735.0000
www.sem-nv.com

LAUTH
866.848.6500 - www.lauth.net


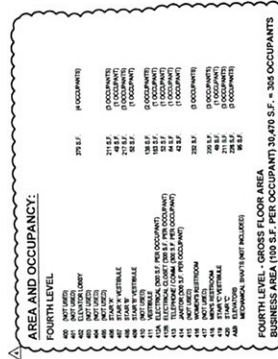CITY OF LAS VEGAS
PLANNING & DEVELOPMENT

WVR-35710
10/08/09 PC

RECEIVED
AUG 21 2009
CITY OF LAS VEGAS
PLANNING & DEVELOPMENT




1 PARKING GARAGE PLAN (LOWER LEVEL)
1/8" = 1'-0"



2 PARKING GARAGE PLAN (UPPER LEVEL)
1/8" = 1'-0"

WVR-35710
10/08/09 PC

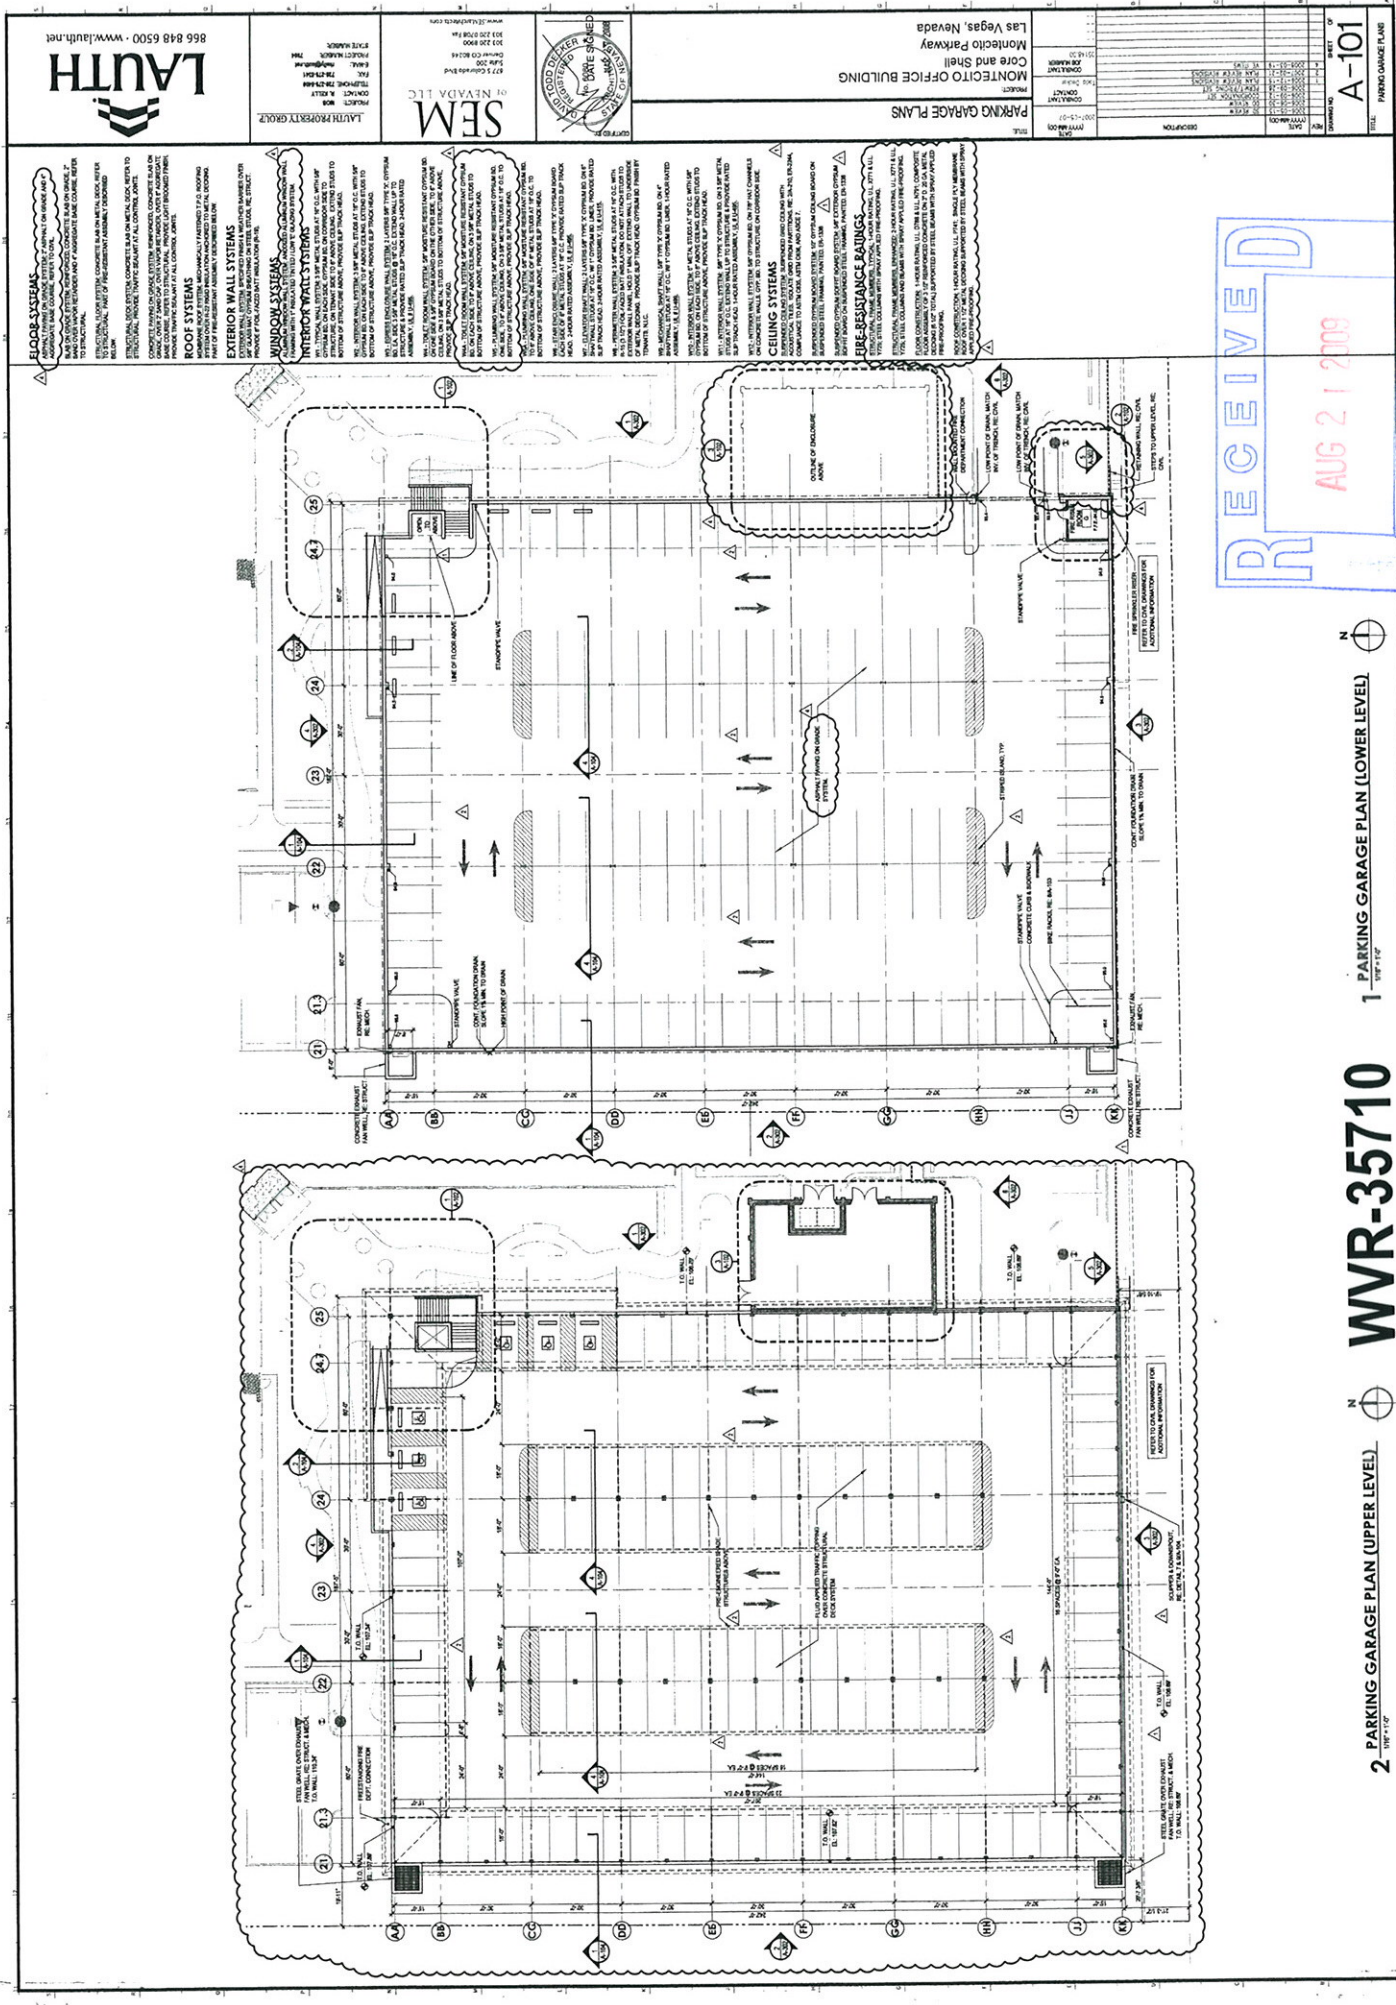



LAUTH
866 848 6500 - www.lauth.net

SEM
ON NEVADA LLC



PARKING GARAGE PLANS
MONTICLO OFFICE BUILDING
Core and Shell
Las Vegas, Nevada


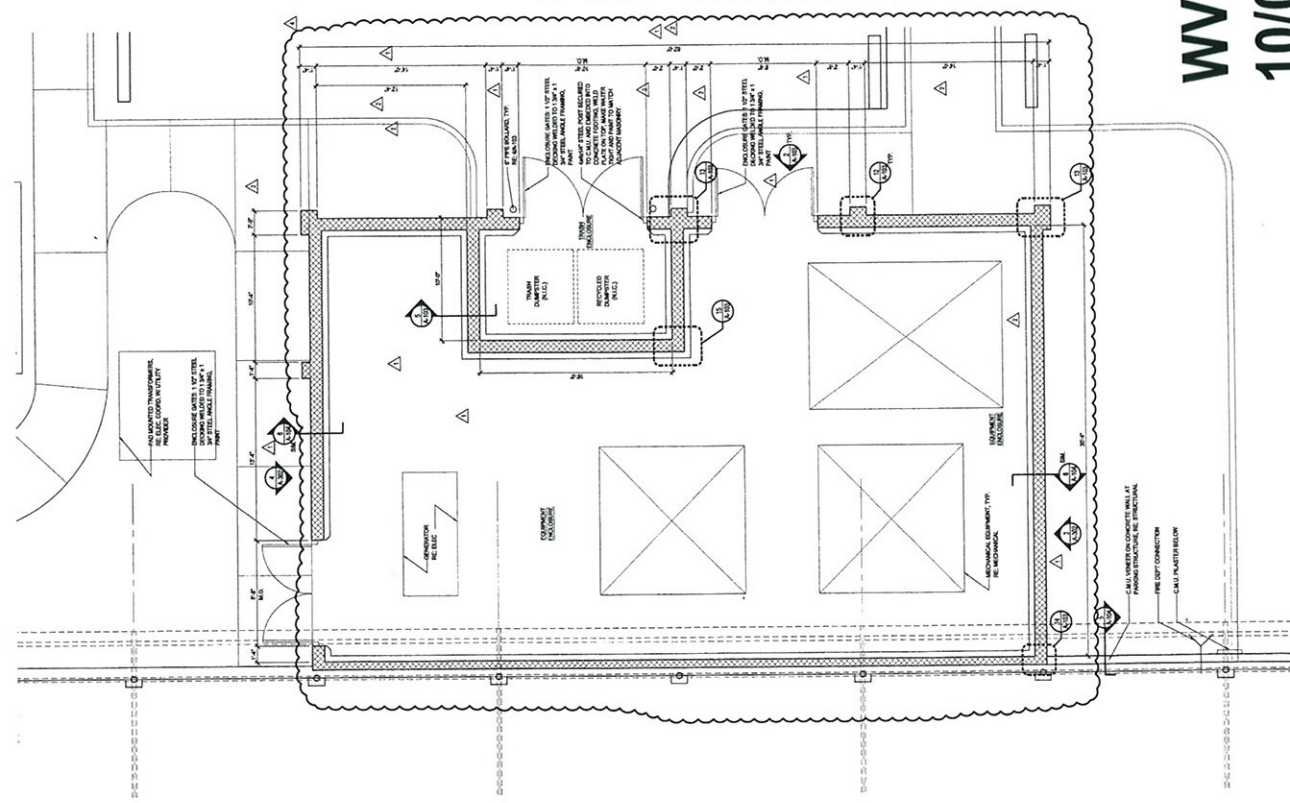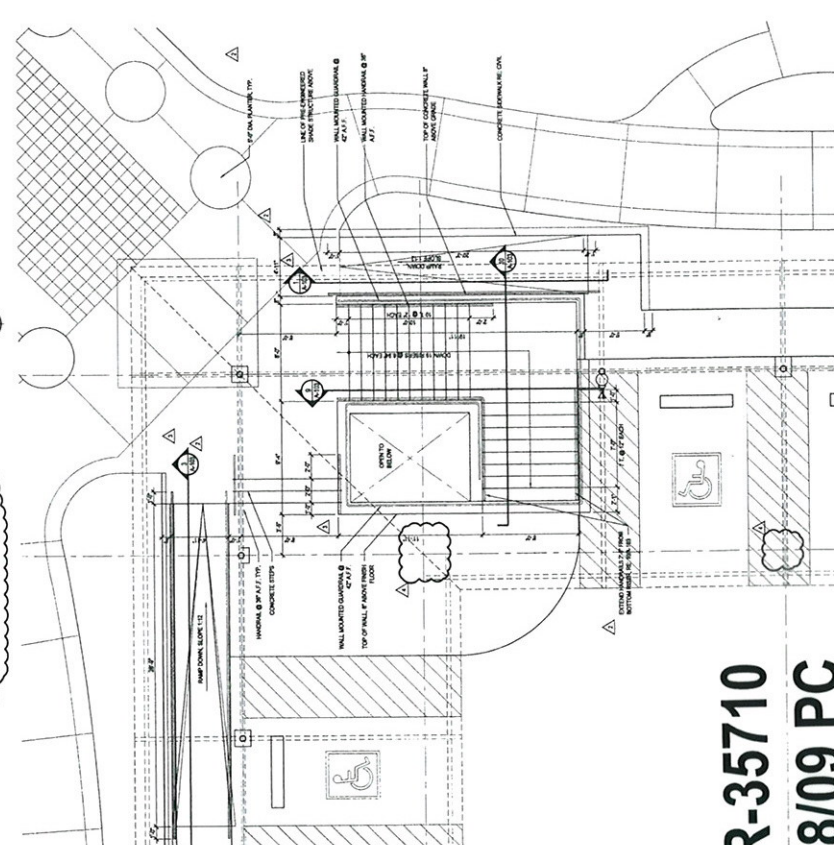

WVR-35710
10/08/09 PC



1 ENLARGED ENTRY PLAZA PLAN

- ENLARGED ENCLOSURE PLAN





WVR-35710
10/08/09 PC

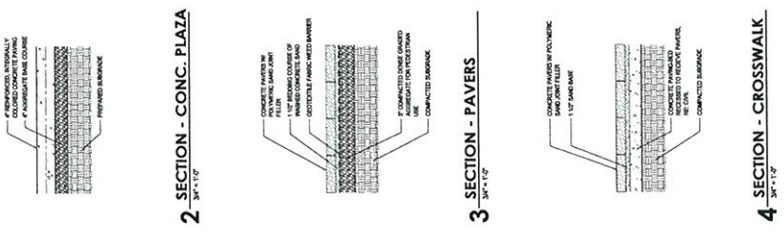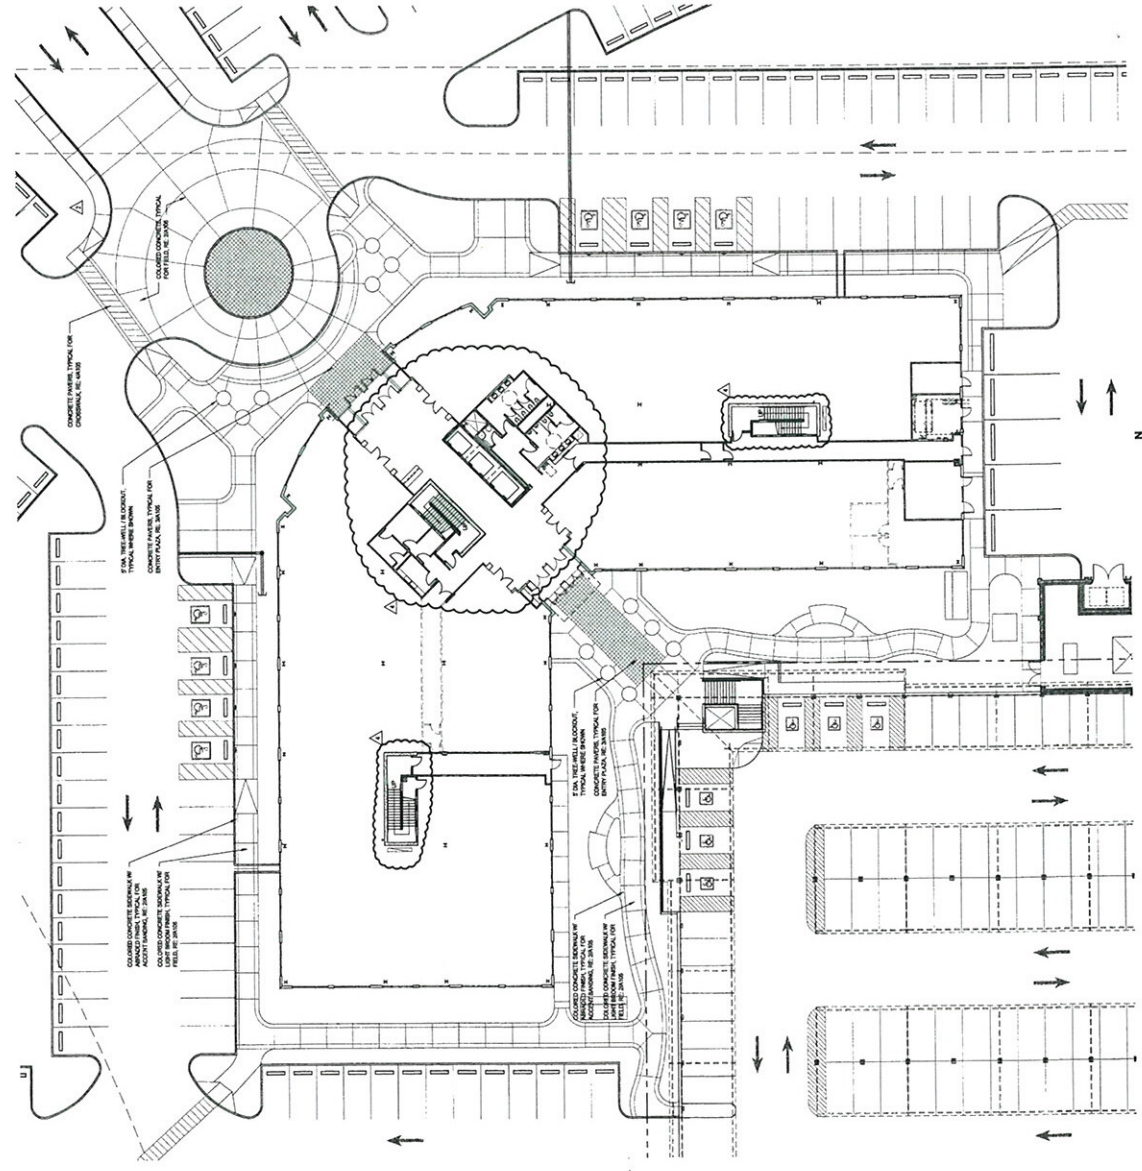



WVR-35710

10/08/09 PC

SCOPE OF WORK:

RECEIVED

CITY OF LAS VEGAS

PLANNING & DEVELOPMENT

GENERAL NOTES:

1. FINISH FLOOR ELEVATION OF WALL CORRESPONDING TO U.S.G.S. ELEVATION OF 2602.97 AS A DATUM POINT. SEE CIVIL.
2. ALL INTERIOR DIMENSIONS ARE FROM FINISHED FACE-OF-WALL UNLESS NOTED OTHERWISE.

3. ALL INTERIOR WALLS ARE TYPE III, UNLESS NOTED OTHERWISE.

4. NOT USED

5. PROVIDE 2 HOUR FIRE RATED ENCLOSURE AT EXIT PASSAGEWAYS, STAIRS & ELEVATOR ENCLOSURES AND EXTENSIONS. 2-HOUR

WASH STATE

6. PROVIDE AIA COMPLIANT FIRE EXTINGUISHERS AS REQUIRED BY GOVERNING JURISDICTION. VERIFY ALL LOCATIONS WITH FIRE

DEPARTMENT AND ARCHITECT PRIOR TO INSTALLATION.

7. ALL ANGLE WALLS SHOWN ARE 45° UNLESS NOTED OTHERWISE.

4. REFER TO A-750 SERIES FOR WILSON / INSULITE.

8. REFER TO SHEET A-22 FOR WALL PANEL ELEVATIONS.

10

10

10


LAUTH
866 848 6500 • www.lauth.net

LAUTH PROPERTY GROUP


FLOOR PLAN (SECOND LEVEL)

DATE (YYYY-MM-DD) 2-05-07
CONSULTANT CONTACT 8 0434
CONSULTANT JON MARRIS 45 00

[illegible]

A-201

FLOOR PLAN (SECOND LEVEL)

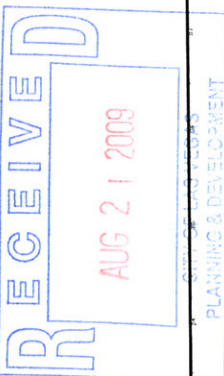

WVR-35710
10/08/09 PC

1 FLOOR PLAN (THIRD LEVEL)
1/8" = 1'-0"

SYMBOL LEGEND:
(B) T.E.A. FLOOR CONTROL ASSEMBLY
D-1 P.A.V. FIRE HOSE VALVE



SCOPE OF WORK:
SCOPE OF WORK RELATED TO COMMON AREA INTERIORS IS INTENDED TO CONVEY A GENERAL LEVEL OF QUALITY AND MINIMUM STANDARDS. DESIGN OF COMMON AREA SPACES WILL BE FURTHER REFINED AND FINISH MATERIAL SELECTIONS COMPLETED WITH A FUTURE SET OF DESIGN DOCUMENTS.

GENERAL NOTES:

1. PROVIDE ONE (1) PANEL FOR EACH 10' OF WALL CORRESPONDING TO U.S.D.A. ELEVATION OF FINISH FLOOR AT GATE PIER. ONE (1) PANEL PER 10' OF WALL.
2. ALL INTERIOR WALLS SHALL BE FINISHED WITH PAPER OF WALL FINISH NOTED OTHERWISE.
3. ALL INTERIOR WALLS ARE TYPE 1 UNLESS NOTED OTHERWISE.
4. NOT USED.
5. PROVIDE 1 HOUR FIRE RATED ENCLOSURE AT JOINT ASSOCIATE WITH EXTERIOR WALL.
6. PROVIDE 1 HOUR FIRE RATED ENCLOSURE AT JOINT ASSOCIATE WITH EXTERIOR WALL.
7. PROVIDE AN ADJUSTABLE RETROFLECTOR AS REQUIRED BY COORDINATING AGENCY. VERIFY ALL LOCATIONS WITH THE DEPARTMENT AND ADJUSTMENT PRIOR TO INSTALLATION.
8. ALL WALLS WILL SHOWN ARE 6' UNLESS NOTED OTHERWISE.
9. REFER TO SPEC SECTIONS FOR INTERIOR FINISHES.
10. REFER TO SPEC SECTIONS FOR WALL PANEL LEANINGS.

ABBREVIATIONS LEGEND:

MONTECITO OFFICE BUILDING
Store and Shell
Montecito Parkway
Las Vegas, Nevada

SEM
OF NEVADA LLC

LAUTH PROPERTY GROUP
PROJECT: BOB
CONTACT: R. KELLY
TELEPHONE: 774-274-6448
FAX: 774-274-6341
E-MAIL: rmk@lauth.net
PROJECT NUMBER: 7744
STATE NUMBER:



LAUTH
866 848 6500 • www.lauth.net








ABBREVIATIONS LEGEND:
 (N/A) NOT APPLICABLE

GENERAL NOTES:



WVR-35710

10/08/09 PC

SCOPE OF WORK:

RECEIVED
AUG 21 2009
CITY OF LAS VEGAS
PLANNING & DEVELOPMENT

GENERAL NOTES:

1. PRESTIGE TOOTH GLASS BLOCK SHALL BE USED FOR ALL ELEVATION OF ZENITH AS A MINIMUM.
2. ALL INTERIOR DIMENSIONS SHALL BE IN FEET AND INCHES UNLESS NOTED OTHERWISE.
3. ALL INTERIOR WALLS ARE TYPE 1 UNLESS NOTED OTHERWISE.
4. NOT USED.
5. PROVIDE 2-HOUR FIRE RATED STAIR & ELEVATOR ENCLOSURES UNLESS NOTED OTHERWISE.
6. PROVIDE ADA COMPLIANT FLOORING UNLESS NOTED OTHERWISE.
7. ALL ANGLE WALLS SHOWN AND NOTED OTHERWISE.
8. REFER TO ARCHITECT DRAWINGS FOR MORE INFORMATION.
9. REFER TO SHEET A-3 FOR MORE INFORMATION.

ABBREVIATIONS LEGEND:

(40) *minor*

CEILING SYSTEMS

SOUNDPROOF CEILING SYSTEMS
ACOUSTICAL TILES. ISOLATE GRID FOR COMPLIANCE TO ASTM C672, ASTM C

SUSPENDED GYPSUM BOARD SYSTEM
SUSPENDED STEEL FRAMING, PAINTED

SUSPENDED CYCLING SPRINT BOARD
SPRINT BOARD ON SUSPENDED STEEL

FIRE-RESISTANCE

STRUCTURAL FRAME MEMBERS, EN-
VIRONMENTAL COLLAPSE AND BEAMS

FLOOR CONSTRUCTION: 1-1/2" RADIUM
FLOOR CONTAINS V OF 3 1/2" REINFORC
FLOOR ASSEMBLY V OF 3 1/2" REINFORC


ROOF CONSTRUCTION THROUGH ROOF
ROOF OVER 1 1/2" METAL DECKING SL
APPLIED FIRE-PROOFING.

ABBREVIATIONS LE

100

10

--

GENERAL NOTES:

2. ALL INTERIOR DIMENSIONS ARE UNLESS NOTED OTHERWISE.

3. ALL INTERIOR WALLS ARE TYPE

4. NOT USED.

5. PROVIDE 2 HOUR FIRE RATED STAIR & ELEVATOR ENCLOSURE ENCLOSURE SHOWN ■■■ ■■

8. PROVIDE AIA COMPLIANT FIRM GOVERNING JURISDICTION, VERIFICATION AND ARCHITECT

7. ALL ANGLE WALLS SHOWN ARE

8. REFER TO SHEET A-303 FOR W

1

[illegible]

1

LAUTH
866 848 6500 • www.lauth.net

LAUTH PROPERTY GROUP
PROJECT: MOB
CONTACT: M. KELLY
TELEPHONE: 702-734-0400
FAX: 702-734-0411
E-MAIL: mky@lauth.com
PROJECT MANAGER: JIMMY
STATE MANAGER



FLOOR PLAN (FIFTH LEVEL)

DATE
(YYYYMMDD)
2007-05-07

CONSULTANT
CONTACT
2006-05-07

CONSULTANT
JOB NUMBER
20142 00

[illegible]

DRIVING NO.
A-204


WVR-35710
10/08/09 PC




RECEIVED
 AUG 21 2009
 CITY OF LAS VEGAS
 PLANNING & DEVELOPMENT

WVR-35710
10/08/09 PC

1-CEILING PLAN (FIRST LEVEL)

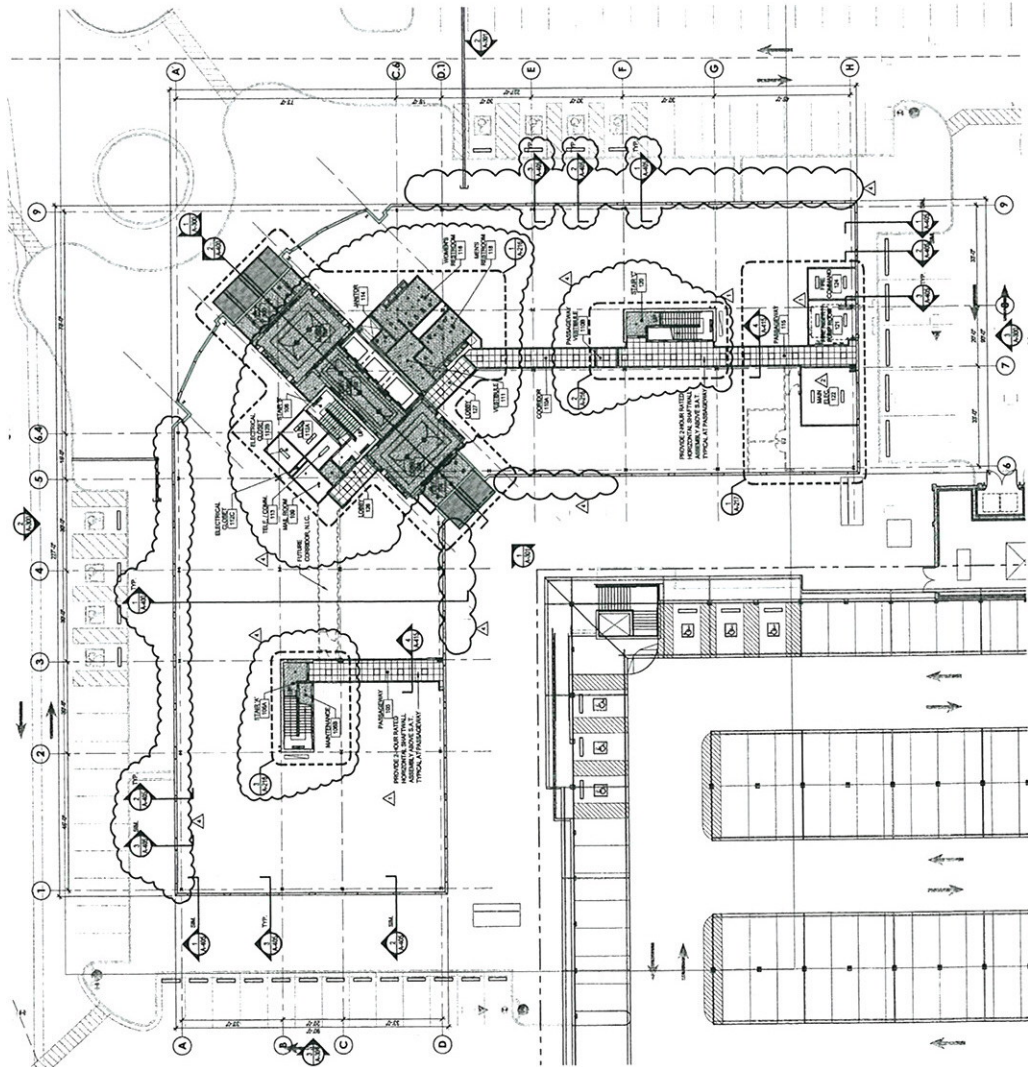

2-STABILIZER CEILING DETAIL

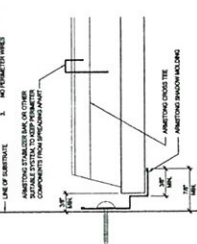





LAUTH
 866.648.6500 • www.lauth.net






WVR-35710
10/08/09 PC



LAUTH PROPERTY GROUP
PROJECT MGR
CONTACT: N. KELLY
TELEPHONE: 728-278-6888
FAX: 728-278-6741
E-MAIL: nkelly@lauth.com
PROJECT MANAGER: TARA
STATE AGENCY:

CEILING PLAN (SECOND LEVEL)


[illegible]


RECEIVED
AUG 21 2009
CITY OF LAS VEGAS
PLANNING & DEVELOPMENT

WVR-35710
10/08/09 PC

1-CEILING PLAN (FIFTH LEVEL)

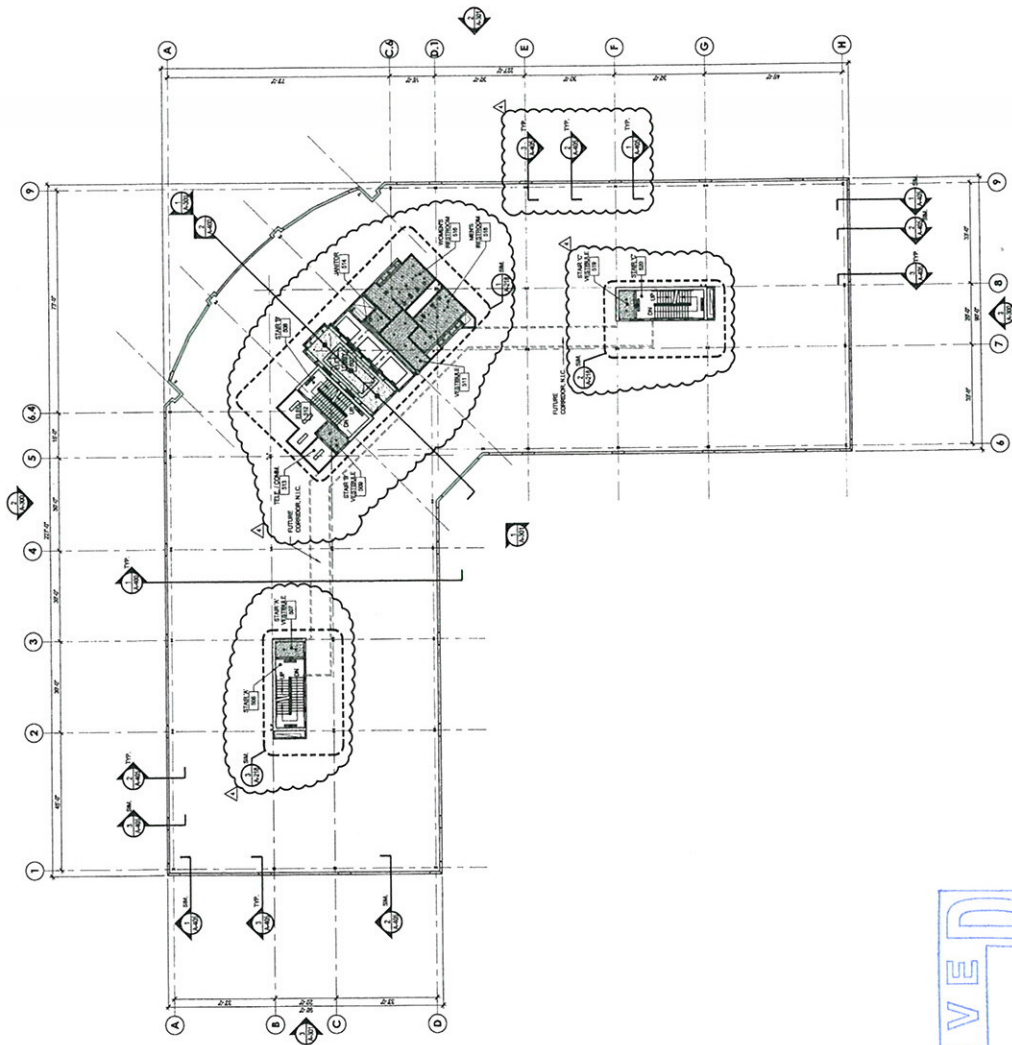

GENERAL NOTES:
1. REFER TO THE ARCHITECT'S GENERAL NOTES FOR THE CEILING SYSTEM.
CEILING LEGEND:
LAUTH
866 848 6500 • www.lauth.net

SEM
5101 S. GARDEN BLVD
SUITE 200
LAS VEGAS, NV 89148
TEL: 702.735.1100
FAX: 702.735.1101
WWW.SEM-ARCHITECTS.COM


LAUTH PROPERTY GROUP
PROJECT: 100
OWNER: A. LAUTH
DESIGNER: SEM
DATE: 10/08/09

CEILING PLAN (FIFTH LEVEL)
Montecito Parkway
Core and Shell
Las Vegas, Nevada



WVR-35710
10/08/09 PC

1 CEILING PLAN (SIXTH LEVEL)

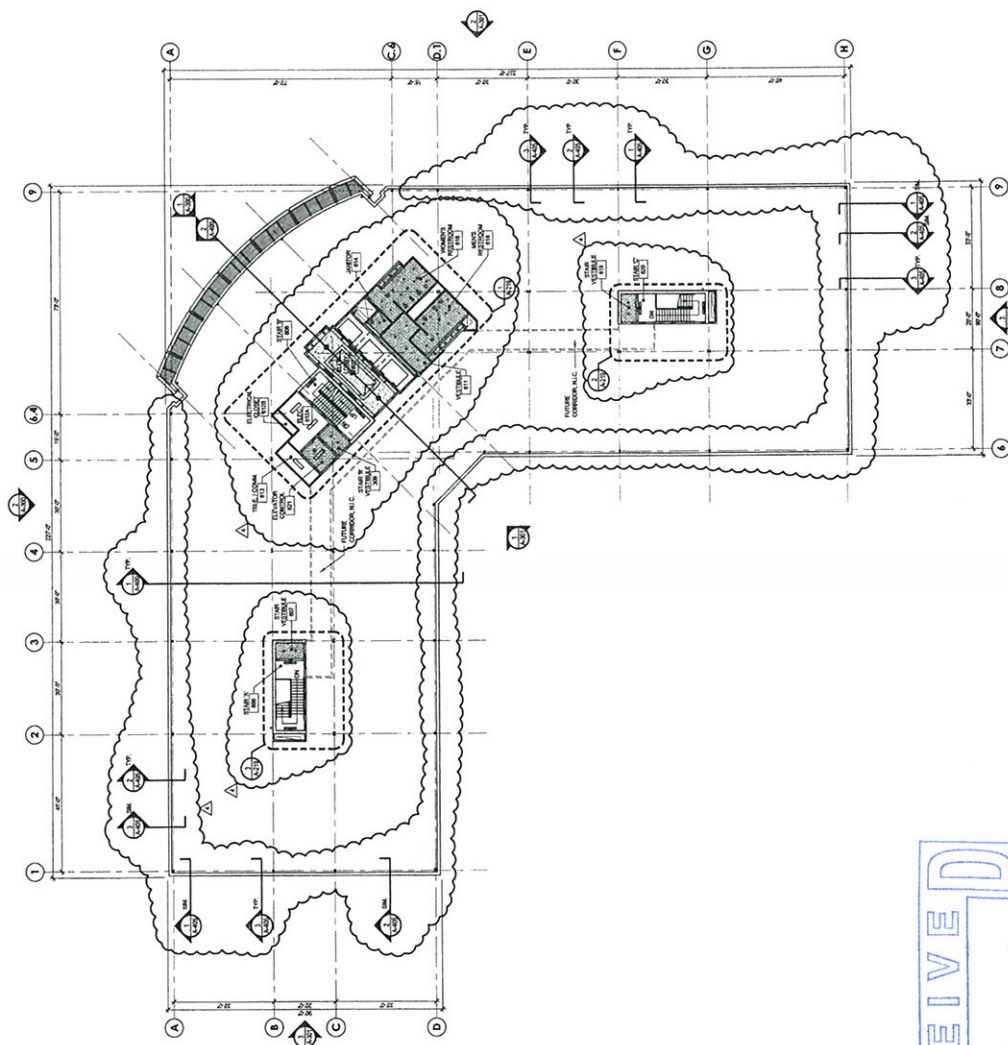

CEILING PLAN (SIXTH LEVEL)

DATE: 10/08/09

PROJECT: MONTICITO OFFICE BUILDING
LOCATION: MONTICITO PARKWAY
SHEET: A-215

DESCRIPTION: CEILING PLAN (SIXTH LEVEL)

RECEIVED
 AUG 21 2009
 CITY OF LAS VEGAS
 PLANNING & DEVELOPMENT


WVR-35710
 10/08/09 PC

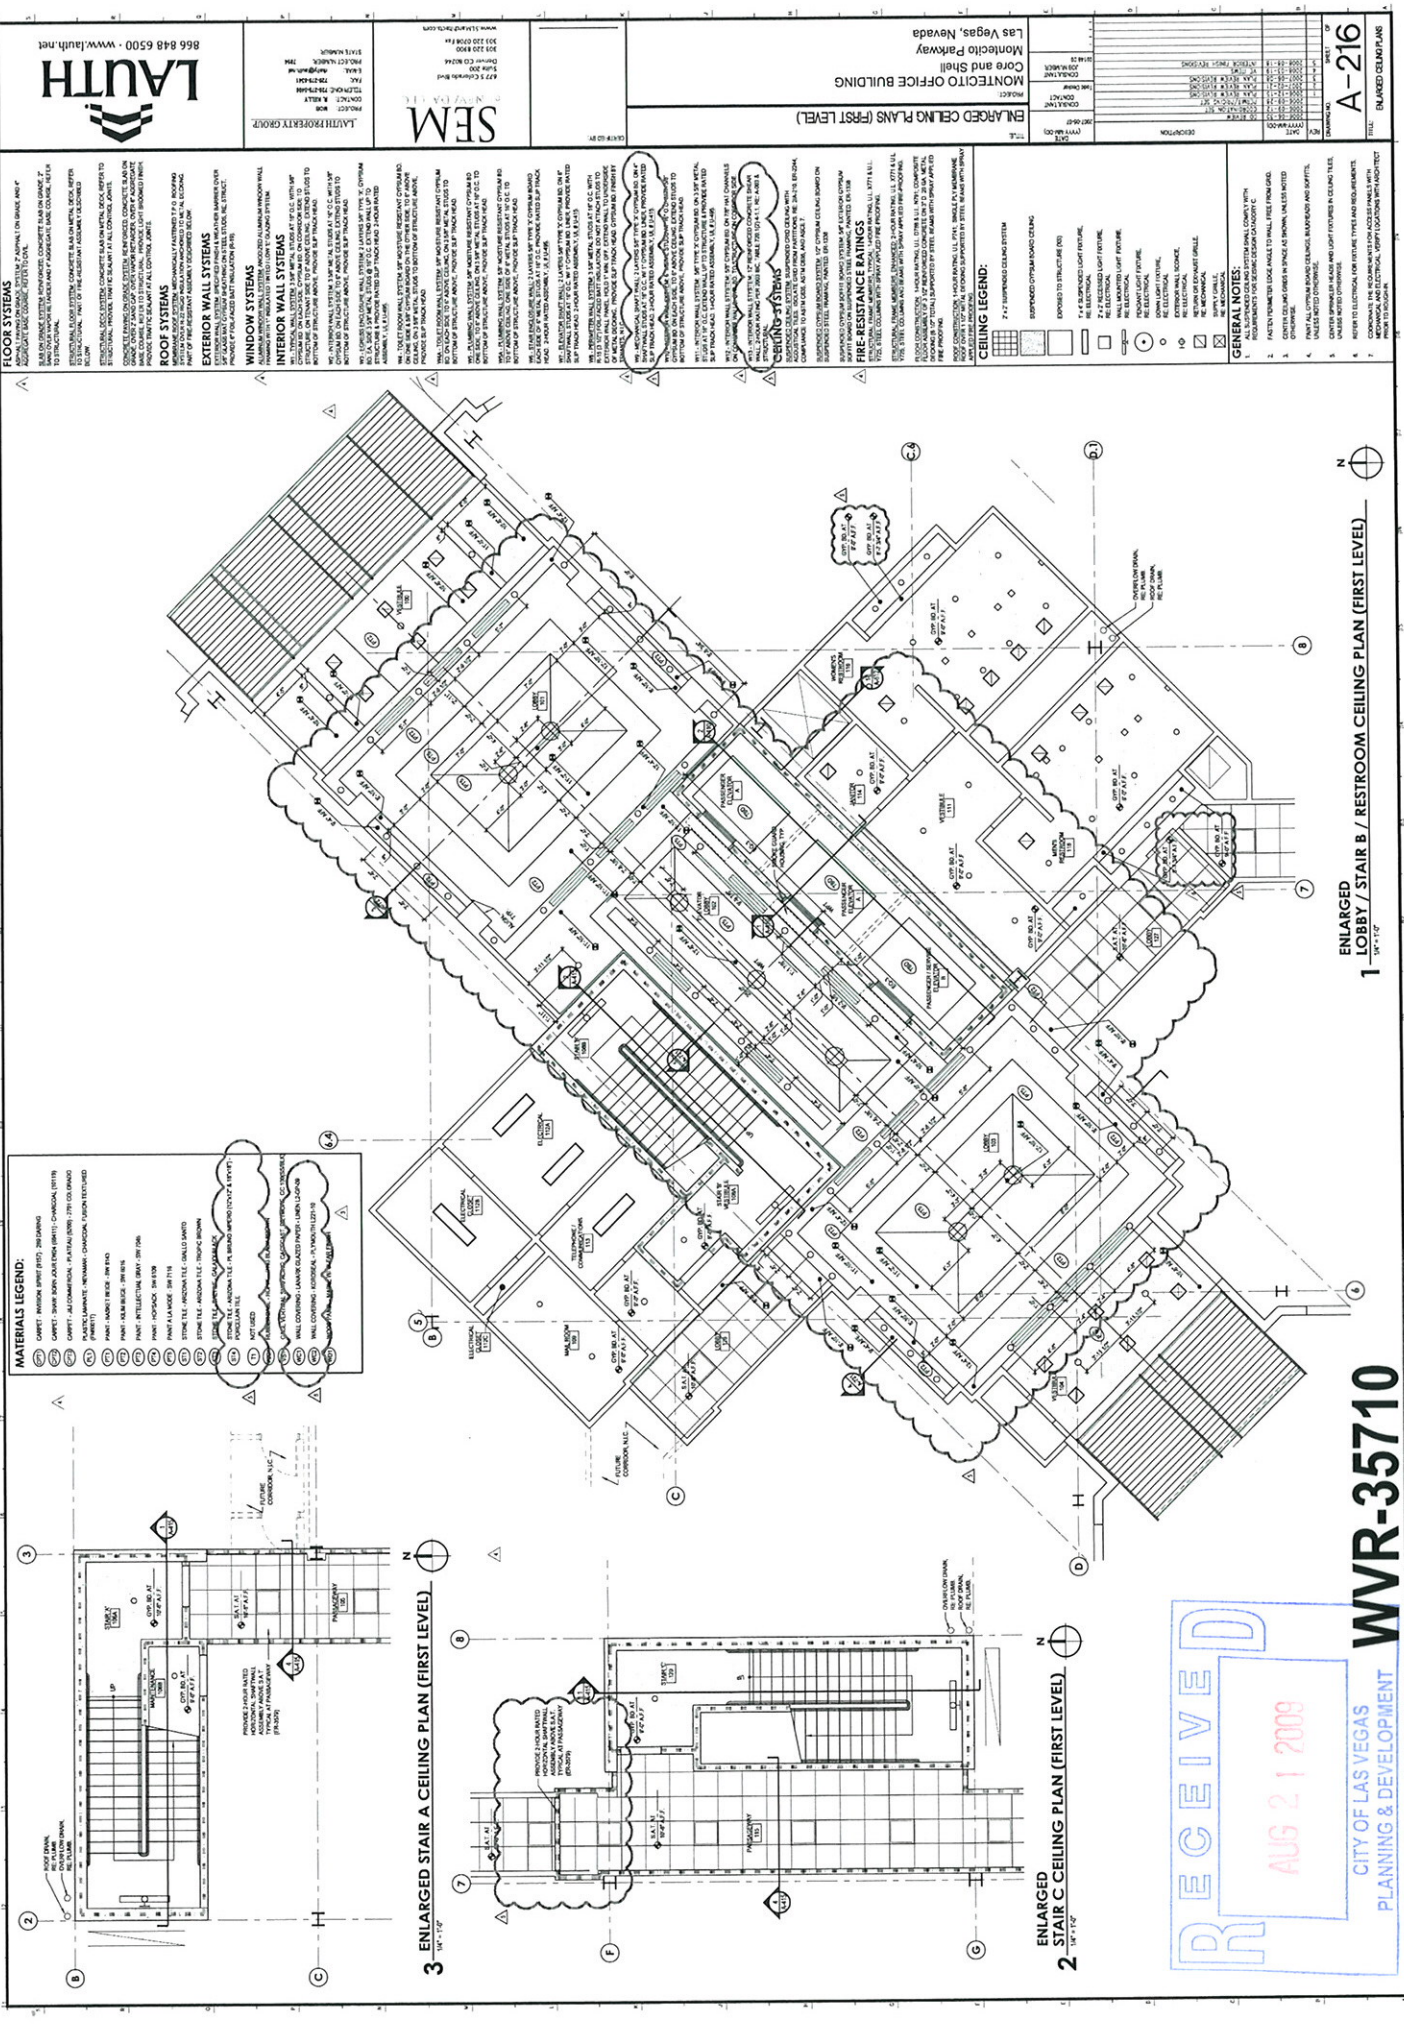


RECEIVED
AUG 21 2009
CITY OF LAS VEGAS
PLANNING & DEVELOPMENT

WVR-35710
10/08/09 PC

1 ENLARGED VESTIBULE / UTILITY PLAN (FIRST LEVEL)
1/4" = 1'-0"

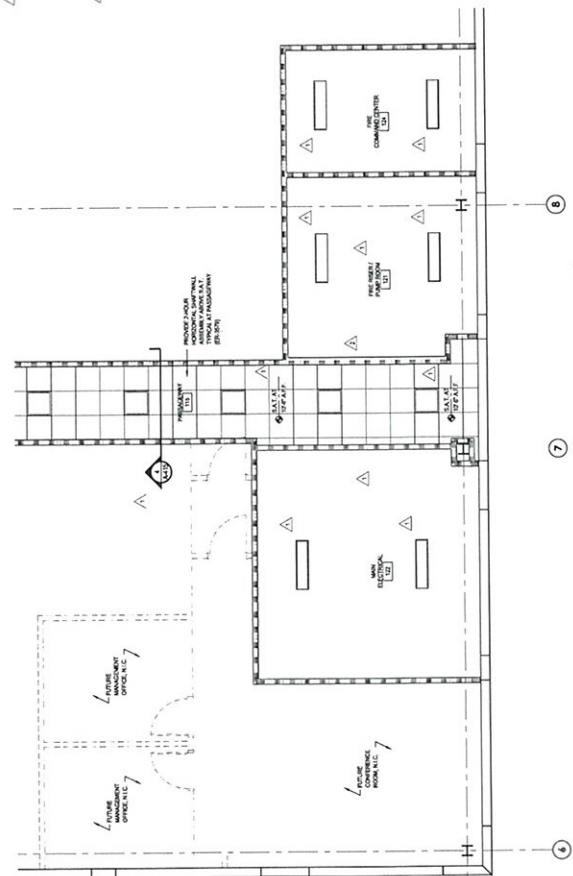

2 ENLARGED PASSAGEWAY 105 PLAN (FIRST LEVEL)
1/4" = 1'-0"

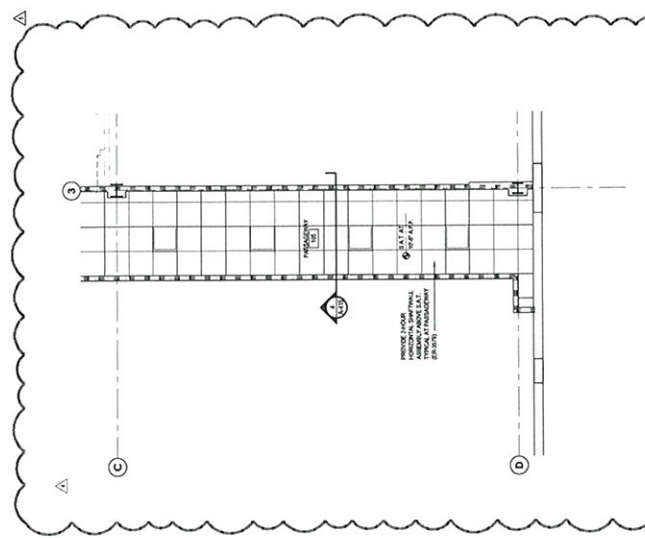











ENLARGED CEILING PLANS (FIRST LEVEL)
Core and Shell
Montecito Parkway
Las Vegas, Nevada

GENERAL NOTES:
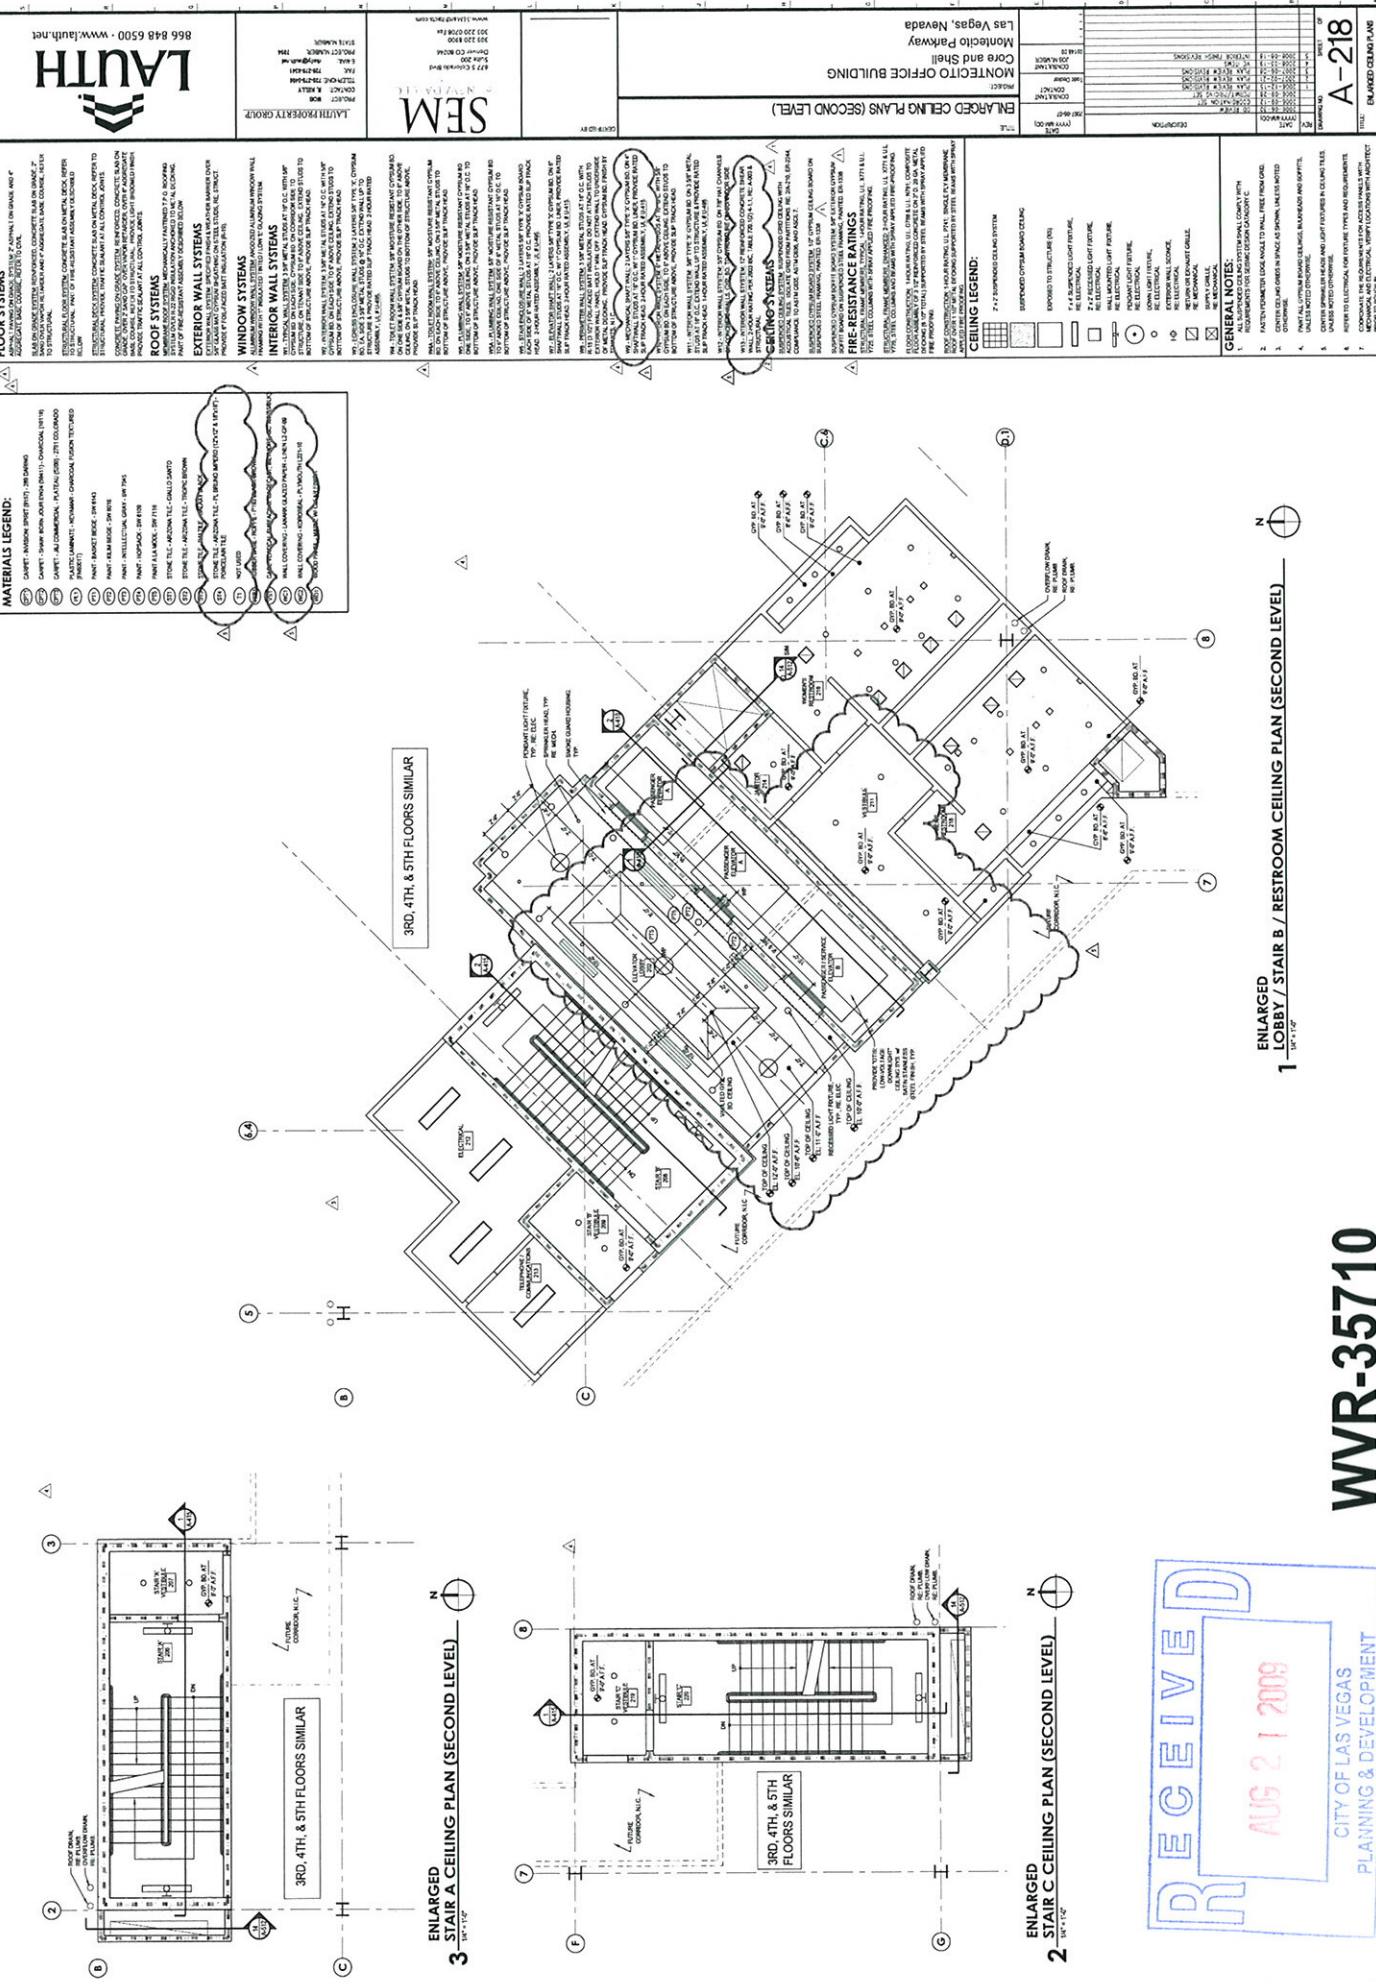

LAUTH 866 848 6500 • www.lauth.net	SEM LAUTH PROPERTY GROUP	LAUTH 866 848 6500 • www.lauth.net	LAUTH 866 848 6500 • www.lauth.net	LAUTH 866 848 6500 • www.lauth.net	LAUTH 866 848 6500 • www.lauth.net	LAUTH 866 848 6500 • www.

ENLARGED STAIR C CEILING PLAN (SECOND LEVEL)

ENLARGED STAIR B / RESTROOM CEILING PLAN (SECOND LEVEL)

ENLARGED STAIR C CEILING PLAN (SECOND LEVEL)

ENLARGED STAIR B / RESTROOM CEILING PLAN (SECOND LEVEL)

3RD, 4TH, & 5TH FLOORS SIMILAR

2ND FLOOR SIMILAR

WVR-35710

10/08/09 PC

CITY OF LAS VEGAS PLANNING & DEVELOPMENT

RECEIVED

AUG 21 2009

RECEIVED
AUG 2 | 2009
CITY OF LAS VEGAS
PLANNING & DEVELOPMENT

WVR-35710
10/08/09 PC

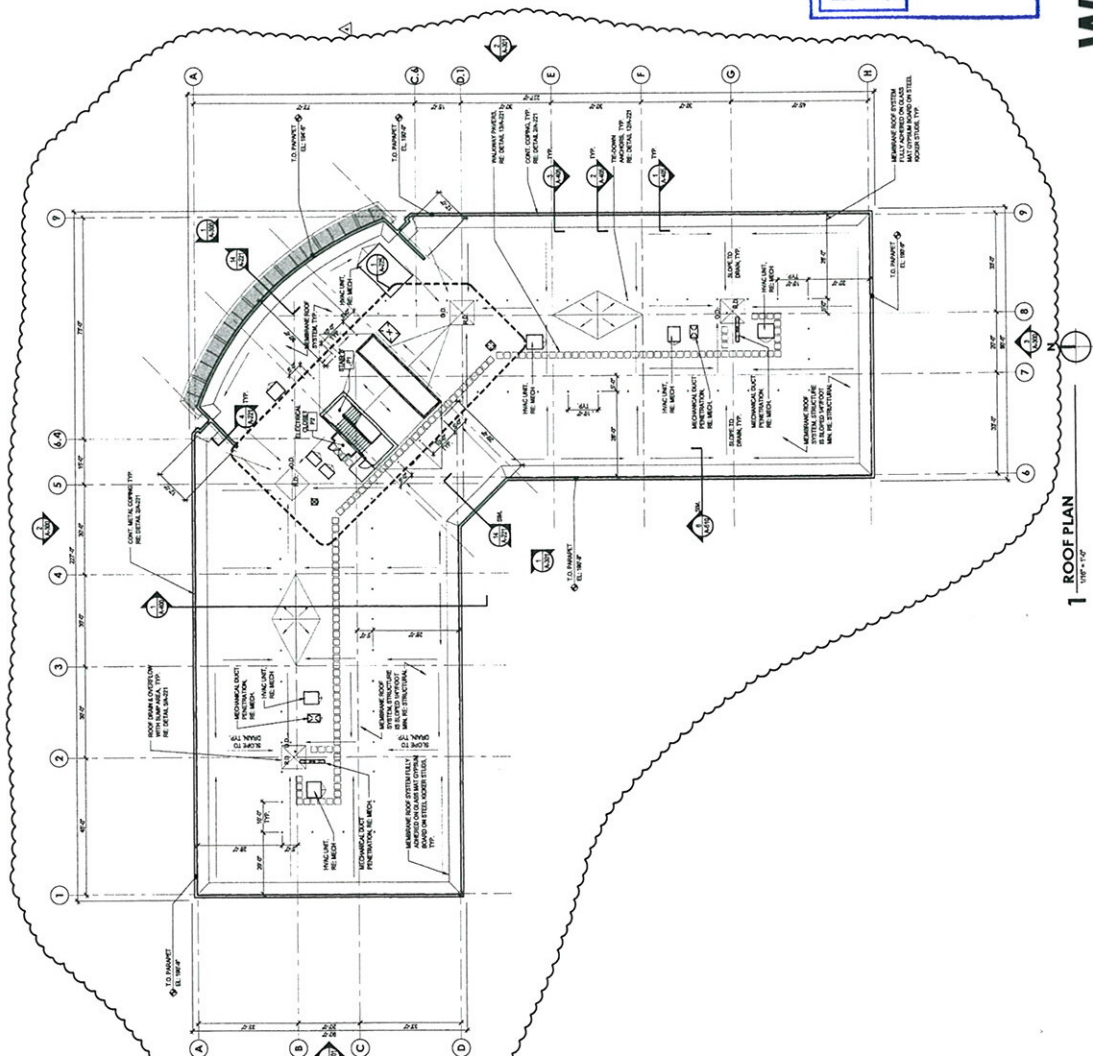


1 - ROOF PLAN
10/8/09



WVR-35710
10/08/09 PC

RECEIVED
AUG 21 2009
CITY OF LAS VEGAS
PLANNING & DEVELOPMENT

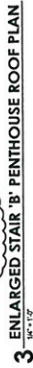

2 ENLARGED STAIR 'B' REFLECTED CEILING PLAN


WVR-35710
10/08/09 PC

RECEIVED

CITY OF LAS VEGAS
PLANNING & DEVELOPMENT


2 NORTH ELEVATION
1/16" = 1'-0"

3 SOUTH ELEVATION


PC1 INTEGRALLY COLLOID, CONCRETE REINFORCEMENT UNIT 100

WVR-35710
10/08/09 PC

RECEIVED

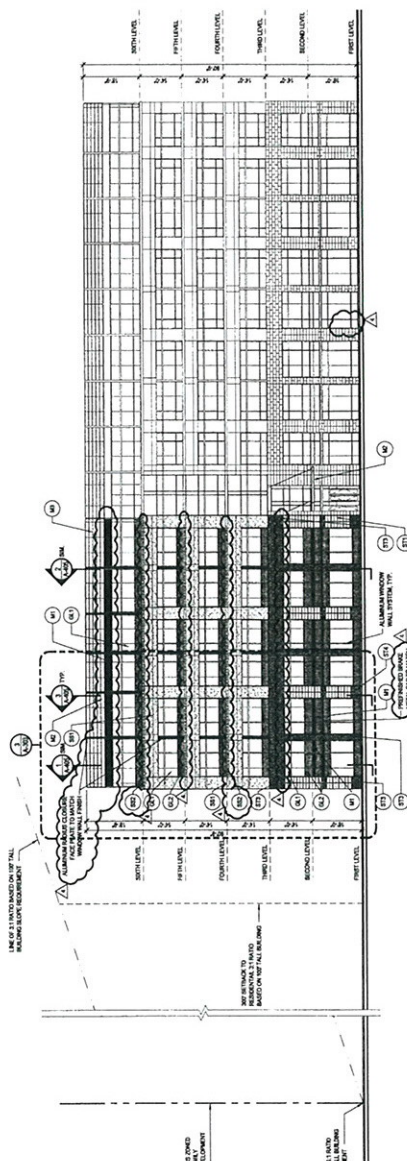
CITY OF LAS VEGAS
PLANNING & DEVELOPMENT

3 WEST ELEVATION
1/8" = 1' - 0"

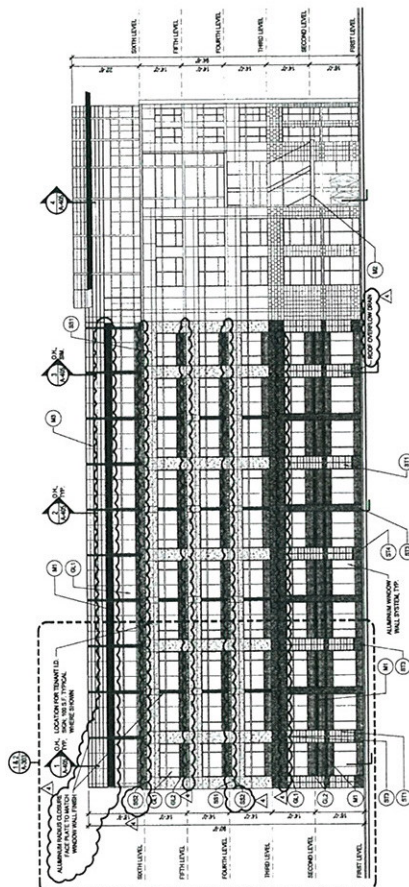

2 EAST ELEVATION
108° + 12°

PARTIAL ELEVATION AT BACK ENTRY
1/16" = 1'-0"

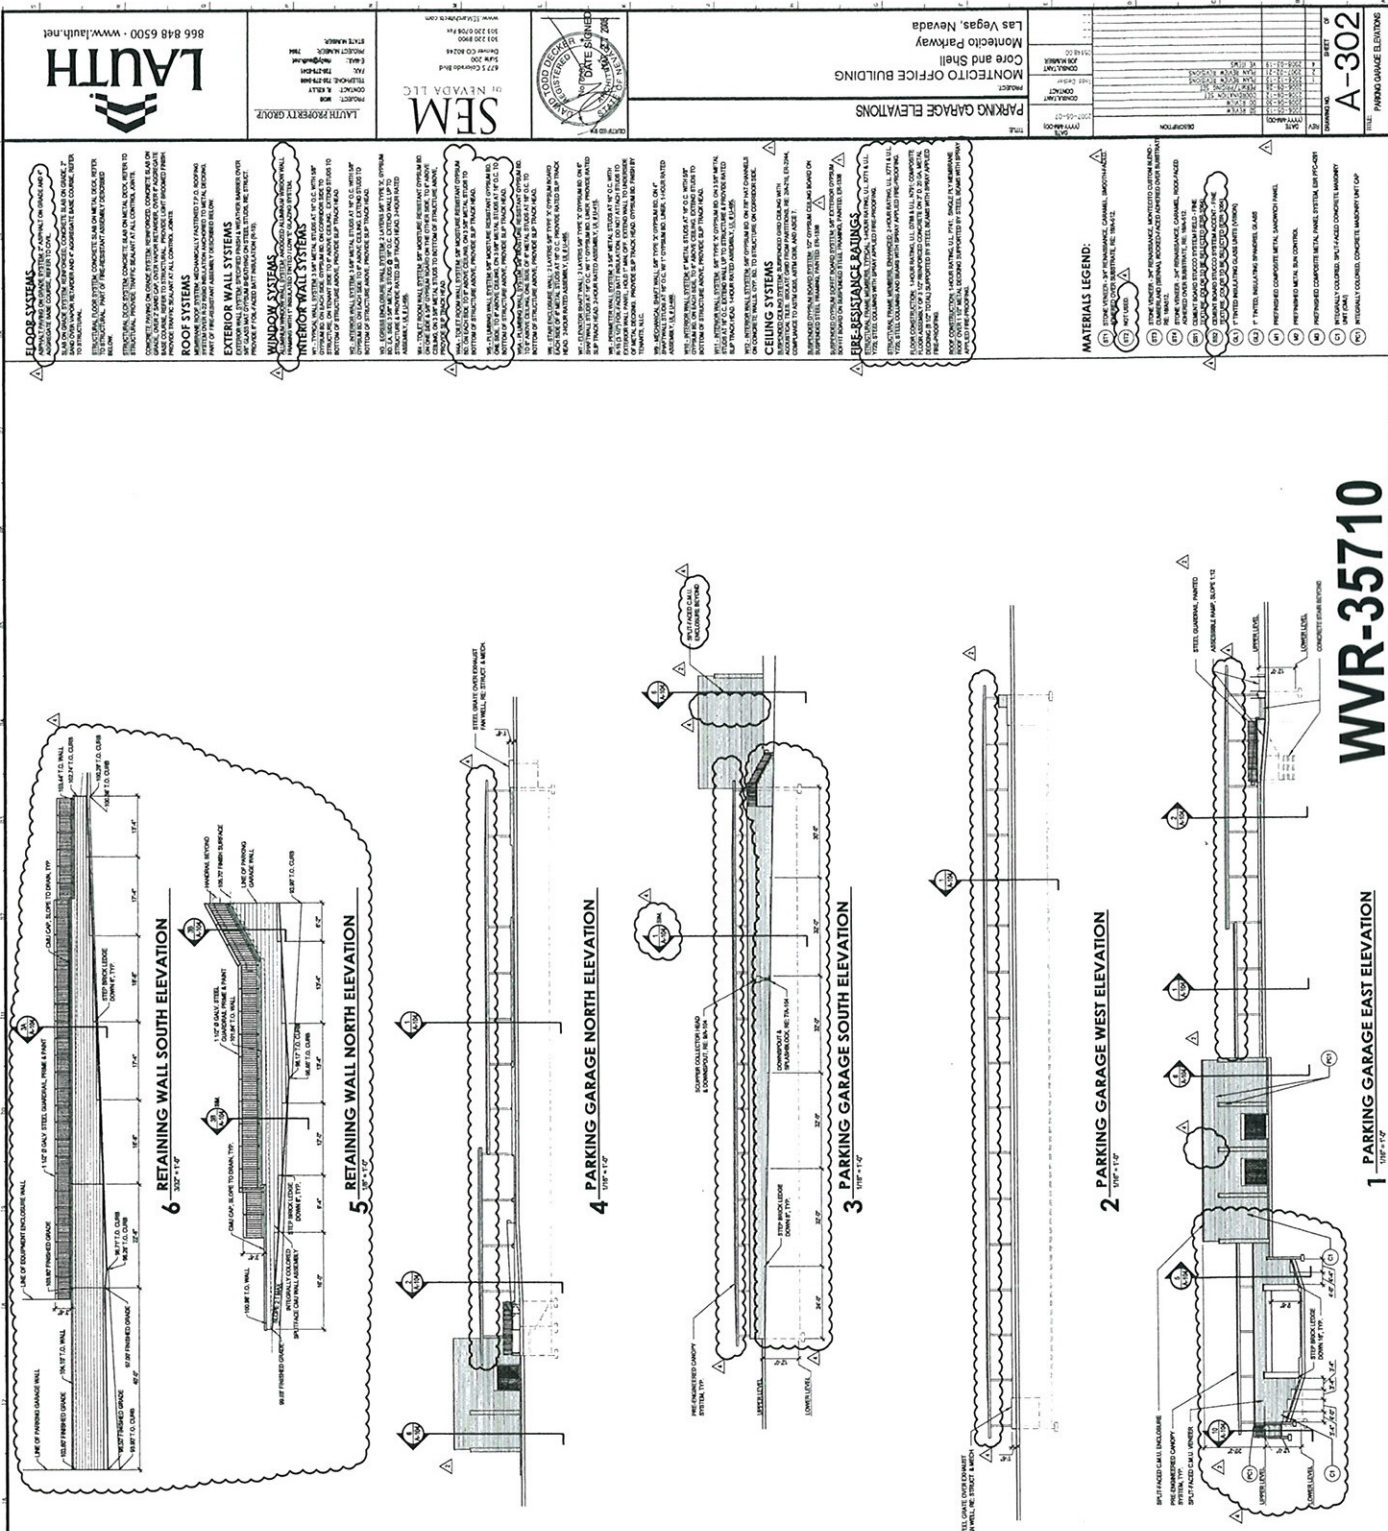

RECEIVED
AUG 21 2009
CITY OF LAS VEGAS
PLANNING & DEVELOPMENT

866 848 6500 - www.lauth.net




LAUTH PROPERTY GROUP
PROJECT: 808



Las Vegas, Nevada
Core and Shell
MONTECITO OFFICE BUILDING


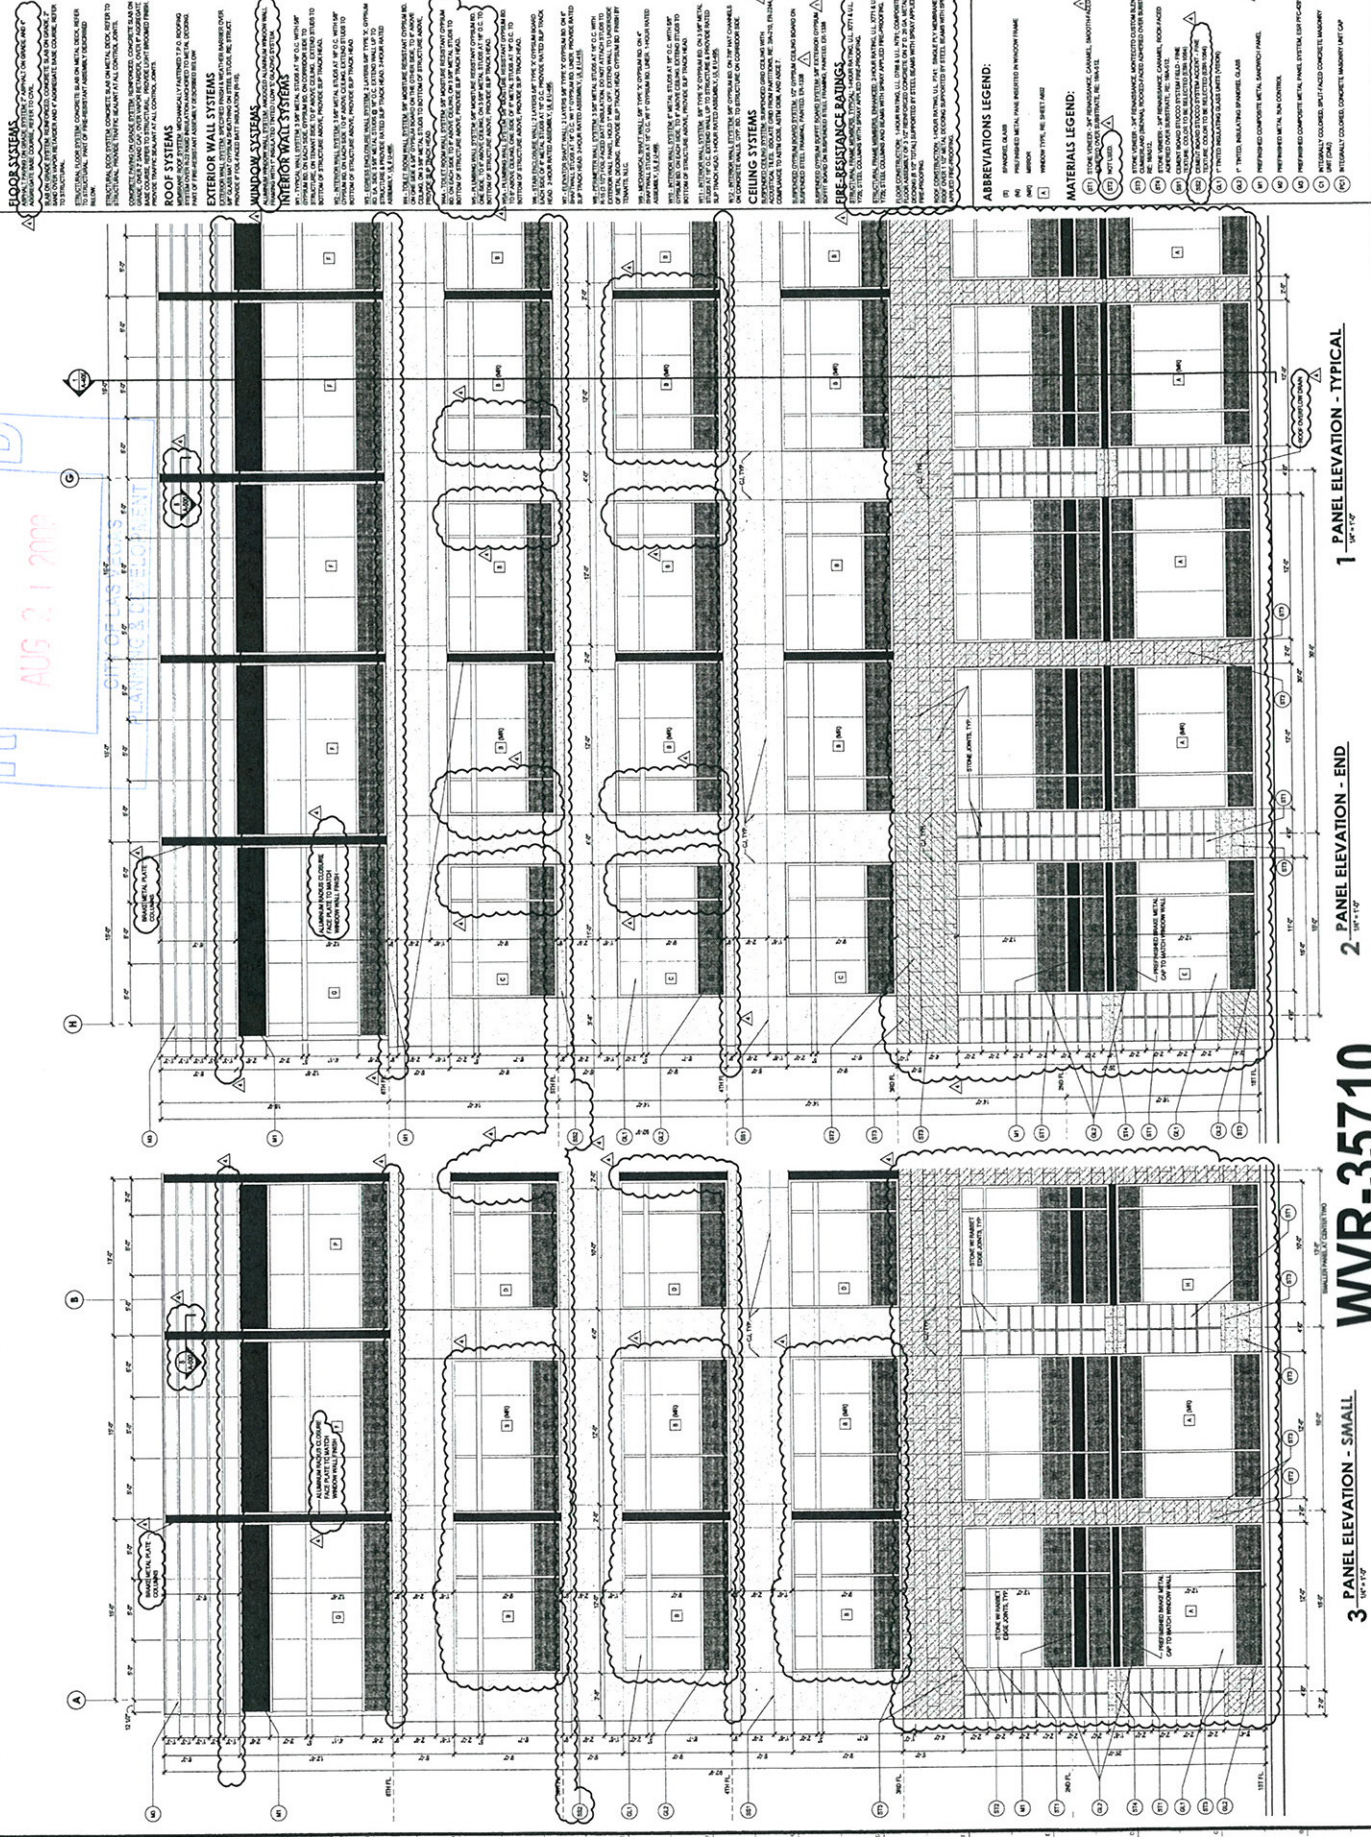

1 PANEL ELEVATION - TYPICAL
1/4\"/>

2 PANEL ELEVATION - END
1/4\"/>

3 PANEL ELEVATION - SMALL
1/4\"/>

WVR-35710
10/08/09 PC



WVR-35710
10/08/09 PC

TYPICAL WALL SECTION

WALL SECTION

WALL SECTION

- MAIN ENTRY WALL SECTION


WVR-35710
10/08/09 PC

RECEIVED


WIC 2-1000

CITY OF LA
PLANNING & DE-



WVR-35710
10/08/09 PC

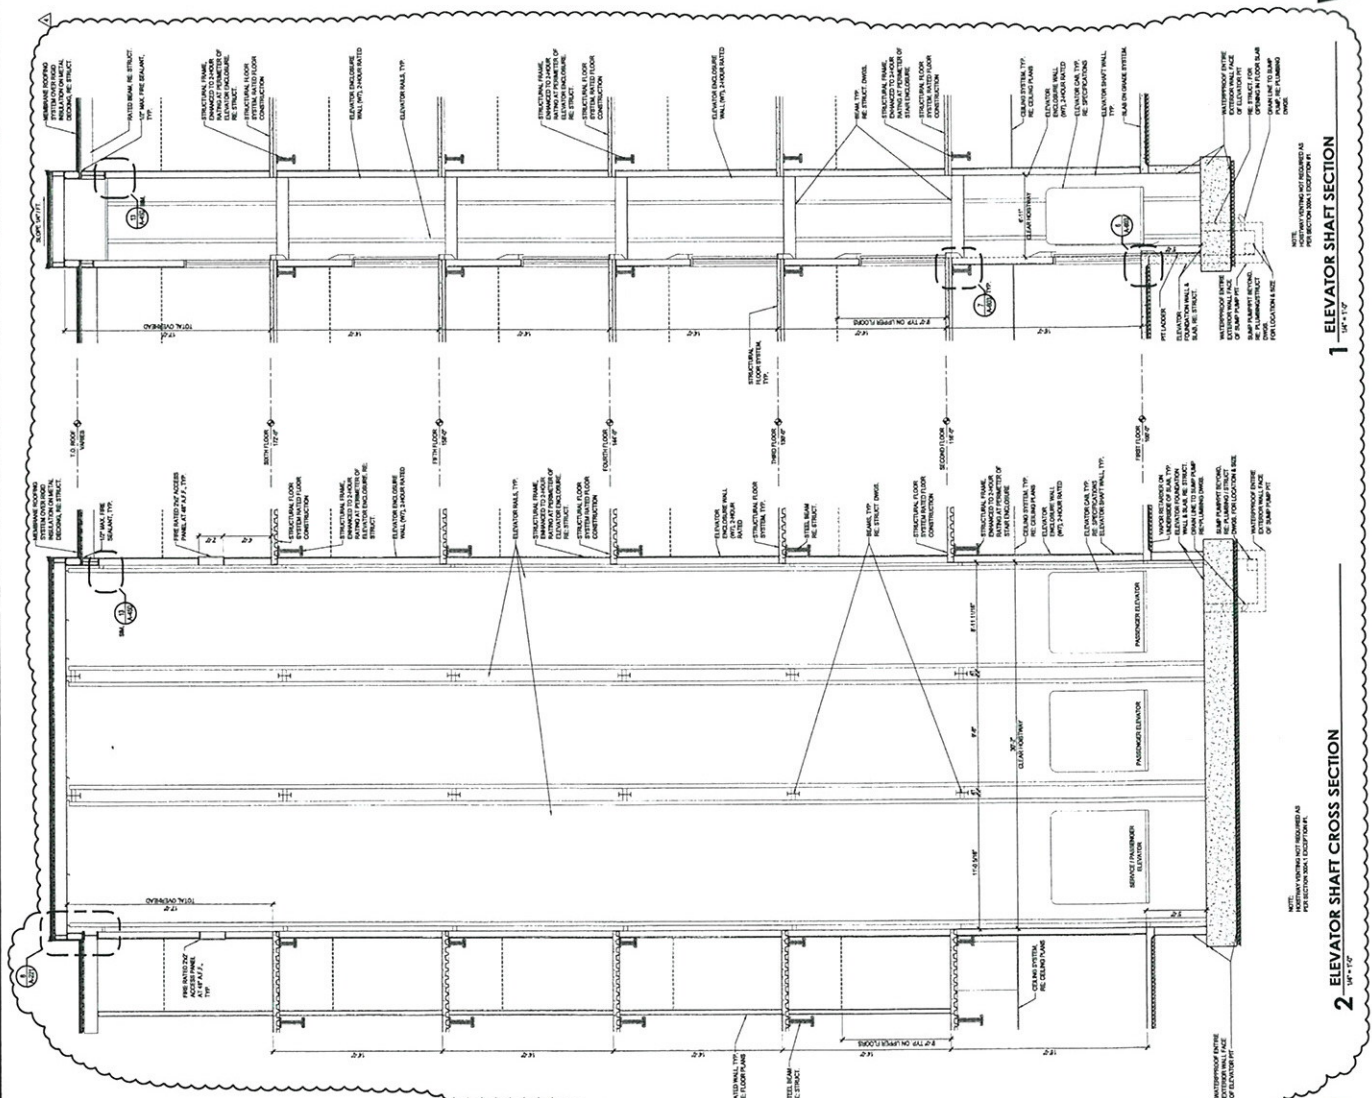

RECEIVED
AUG 21 2009
CITY OF LAS VEGAS
PLANNING & DEVELOPMENT

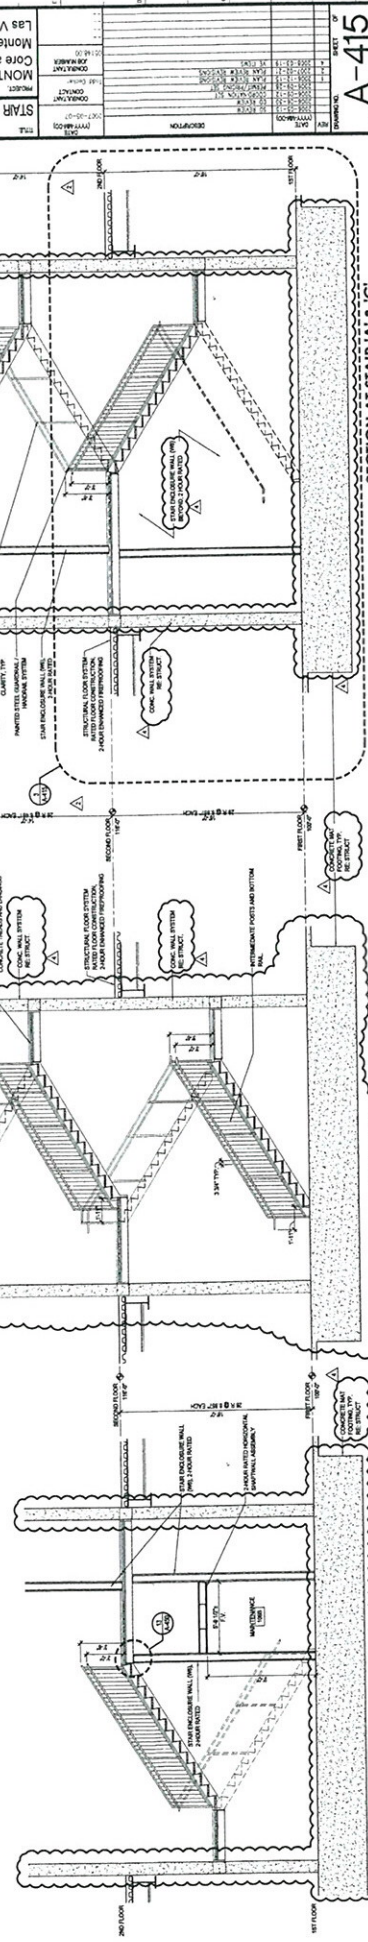

4 SECTION AT PASSAGEWAY

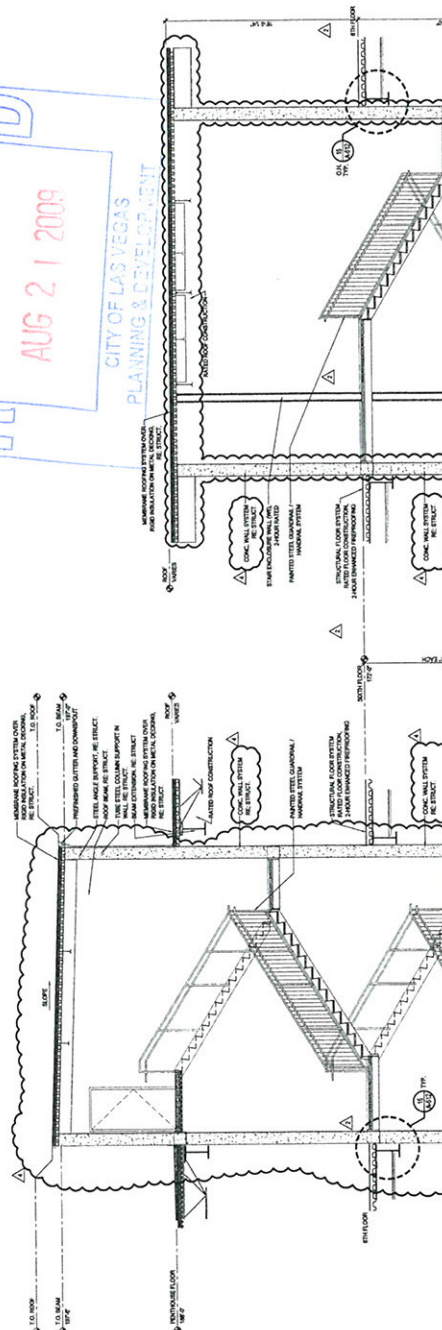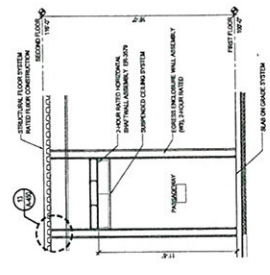

RECEIVED
AUG 21 2009
CITY OF LAS VEGAS
PLANNING & DEVELOPMENT


LAUTH
866.848.6500 • www.lauth.net

SEM
OF NEVADA LLC
417 E. 9000 S. SUITE 100
DANVILLE, NV 89019
CONTACT: K. KELLY
TEL: 702.796.1000
FAX: 702.796.1001
E-MAIL: kelly@semnv.com

STAR SECTIONS
Montecito Parkway
Core and Shell
Montecito Office Building
Las Vegas, Nevada


STAR SECTIONS
Montecito Parkway
Core and Shell
Montecito Office Building
Las Vegas, Nevada

WVR-35710
10/08/09 PC

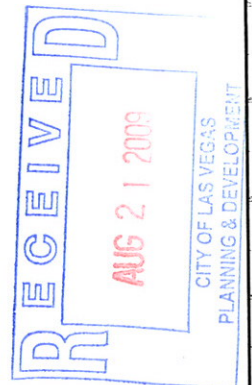


CITY OF LAS VEGAS
 PLANNING & DEVELOPMENT


16 SECTION AT TYPICAL WALL
 34'-0" x 1'-0"

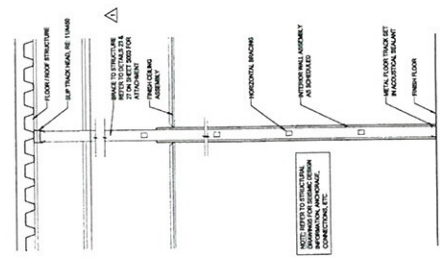


17 SECTION AT RATED WALL
 34'-0" x 1'-0"

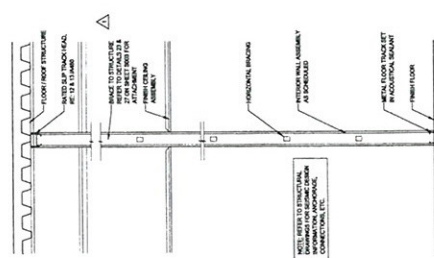


18 WALL TYPE W5A
 1'-0" x 1'-0"

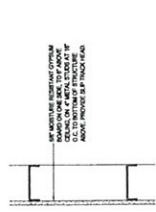


15 WALL TYPE W4A
 1'-0" x 1'-0"

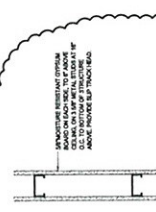


14 WALL TYPE W11
 1'-0" x 1'-0"

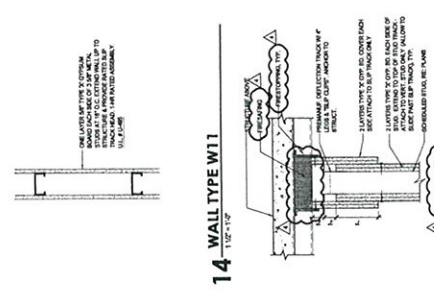


13 SLIP TRACK HEAD - 2-HOUR
 1'-0" x 1'-0"

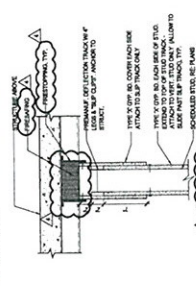


12 SLIP TRACK HEAD - 1-HOUR
 1'-0" x 1'-0"

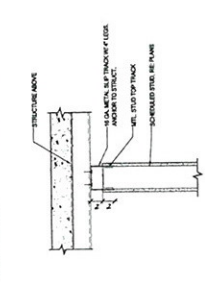


11 SLIP TRACK HEAD - TYPICAL
 1'-0" x 1'-0"

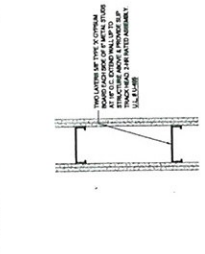


6 WALL TYPE W6
 1'-0" x 1'-0"

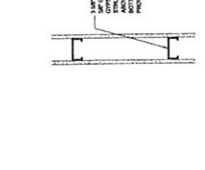


8 WALL TYPE W8
 1'-0" x 1'-0"

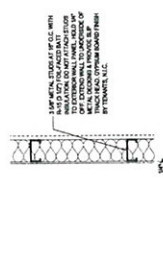


3 WALL TYPE W3
 1'-0" x 1'-0"

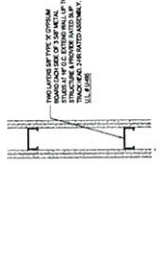


4 WALL TYPE W4
 1'-0" x 1'-0"

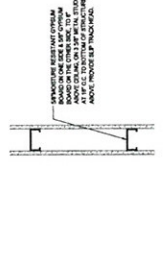


10 WALL TYPE W10
 1'-0" x 1'-0"

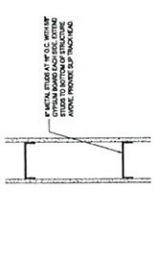

5 WALL TYPE W5
 1'-0" x 1'-0"

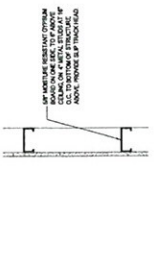

1 WALL TYPE W1
 1'-0" x 1'-0"

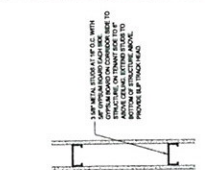


WALL TYPES
 Core and Shell
 Montecito Office Building
 Las Vegas, Nevada



SEM
 STATE ENGINEERING
 MONTICITO OFFICE BUILDING
 477 S. CLARK BLVD.
 LAS VEGAS, NV 89102
 702.735.1111
 WWW.STATEENGINEERING.COM

LAUTH PROPERTY GROUP
 866.848.5500
 WWW.LAUTH.NET



RECEIVED

AUG 21 2009

LAUTH
866.848.6500 • www.lauth.net

SEM
OF NIVADA LLC
LAUTH PROPERTY GROUP
PROJECT: 808
CONTRACT: 1.0000
DATE: 08/10/09
DRAWN BY: JLM
CHECKED BY: JLM
SCALE: 1/8" = 1'-0"



PLAN DETAILS
MONTICELLO OFFICE BUILDING
CORE AND SHELL
LAS VEGAS, NEVADA


PLAN DETAILS
MONTICELLO OFFICE BUILDING
CORE AND SHELL
LAS VEGAS, NEVADA



A-500
PLAN DETAILS





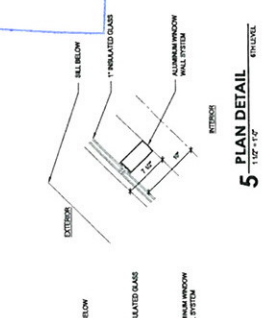



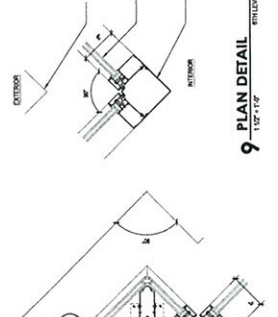



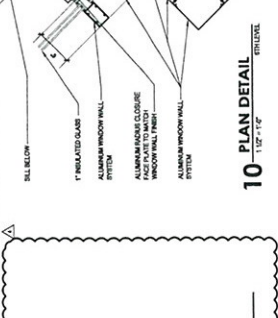



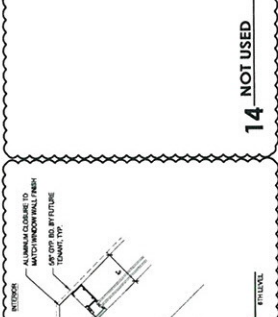



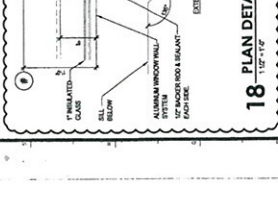



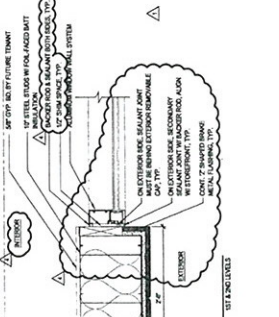



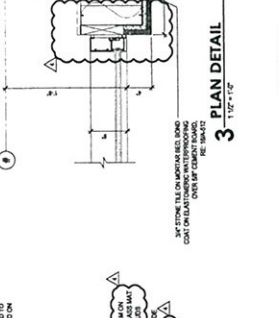



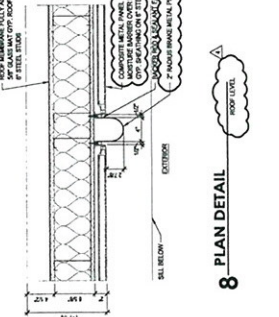





















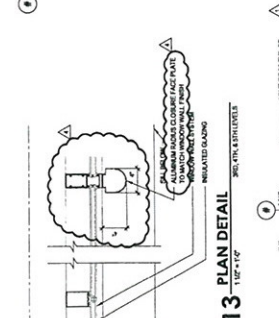


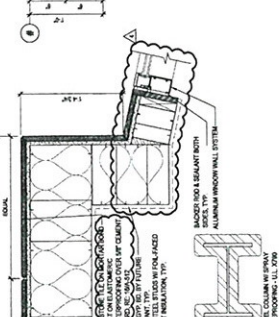



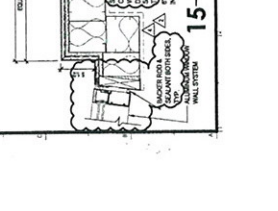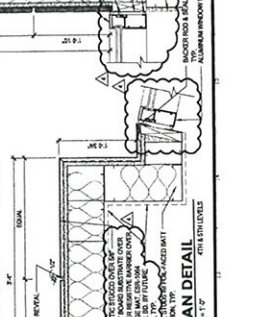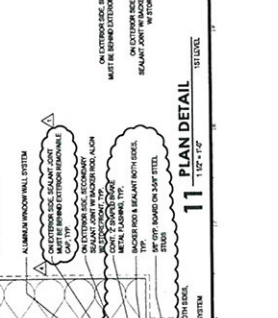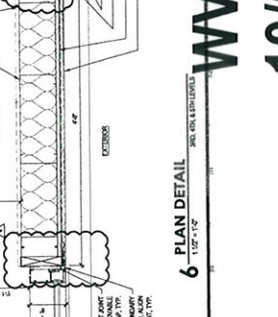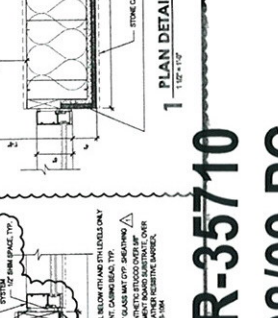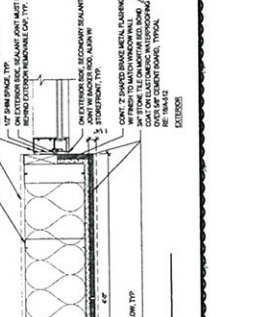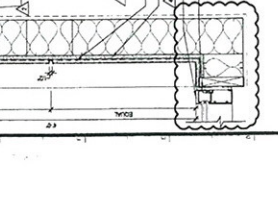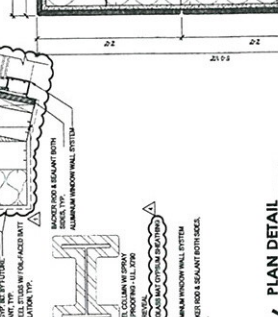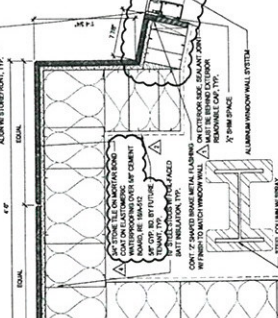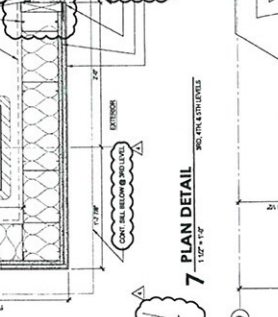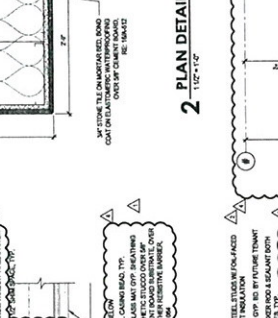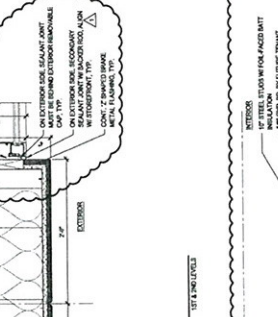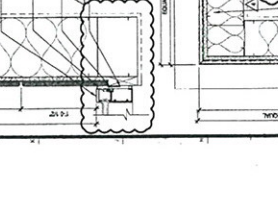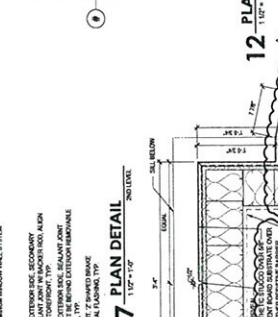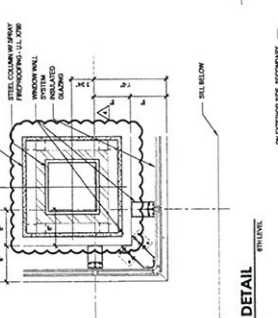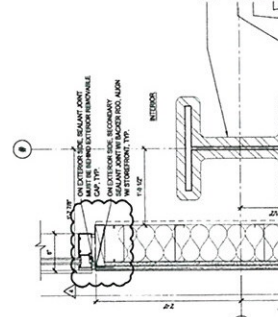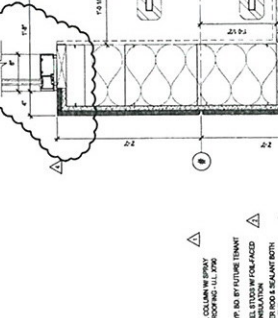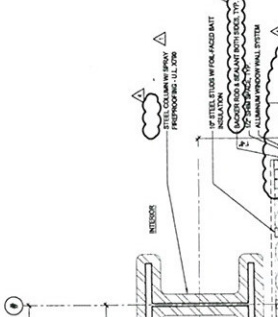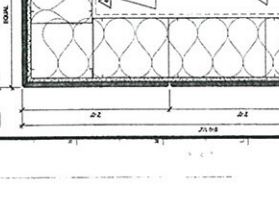

WVR-35710

10/08/09 PC

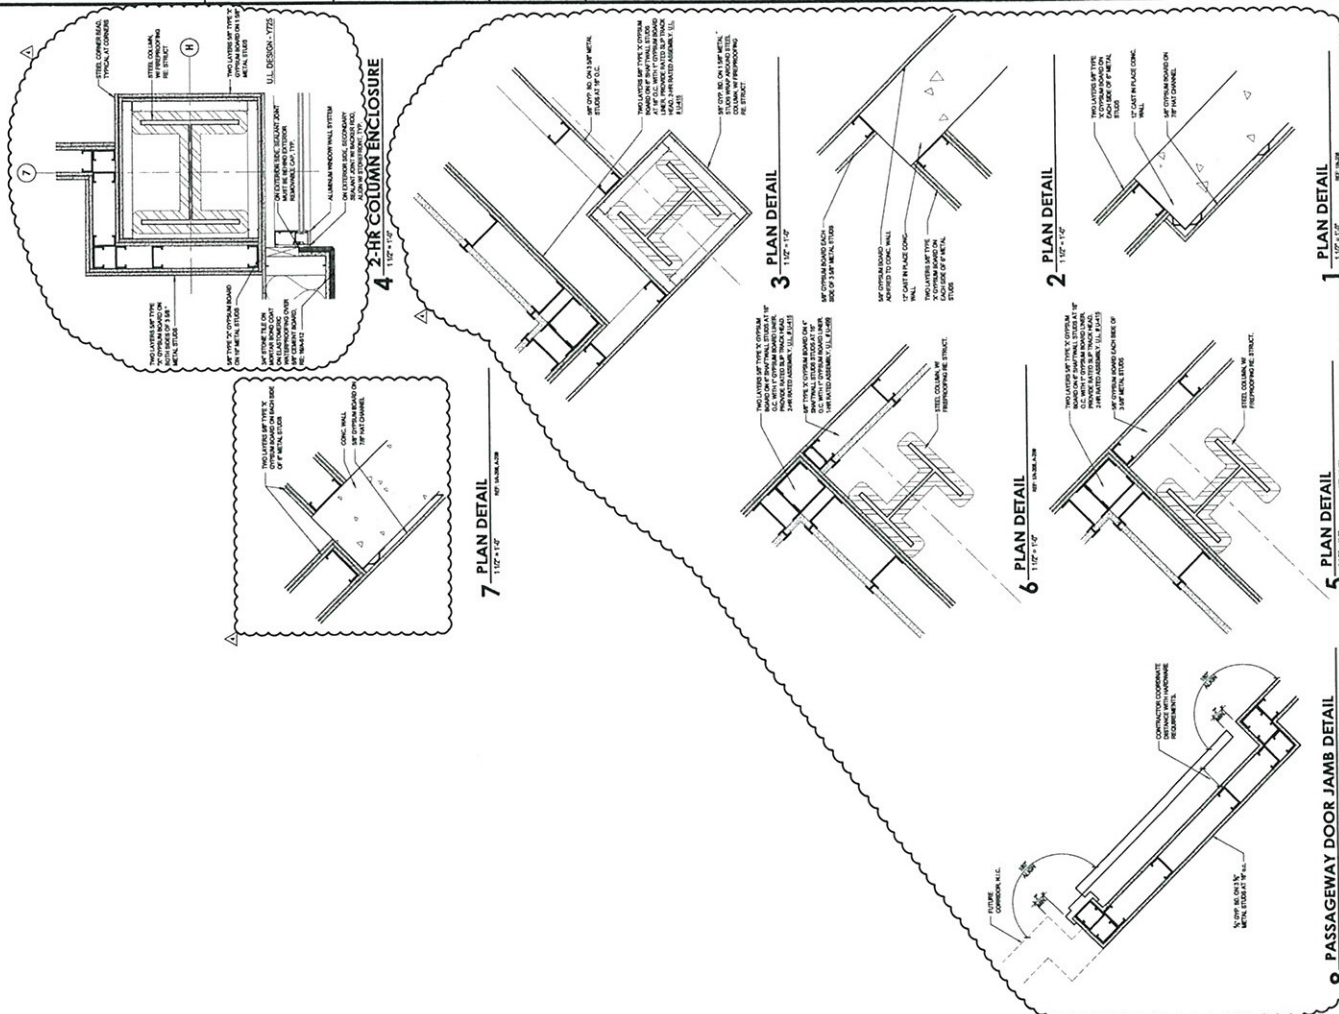

RECEIVED
AUG 21 2009
CITY OF LAS VEGAS
PLANNING & DEVELOPMENT
WVR-35710
10/08/09 PC

RECEIVED
AUG 21 2009
 CITY OF LAS VEGAS
 PLANNING & DEVELOPMENT

LAUTH
 866-848-6500 - www.lauth.net


SEM



SECTION DETAILS
 Core and Shell
 Montecito Parkway
 Las Vegas, Nevada

SECTION DETAILS
 Core and Shell
 Montecito Parkway
 Las Vegas, Nevada

SECTION DETAILS
 Core and Shell
 Montecito Parkway
 Las Vegas, Nevada

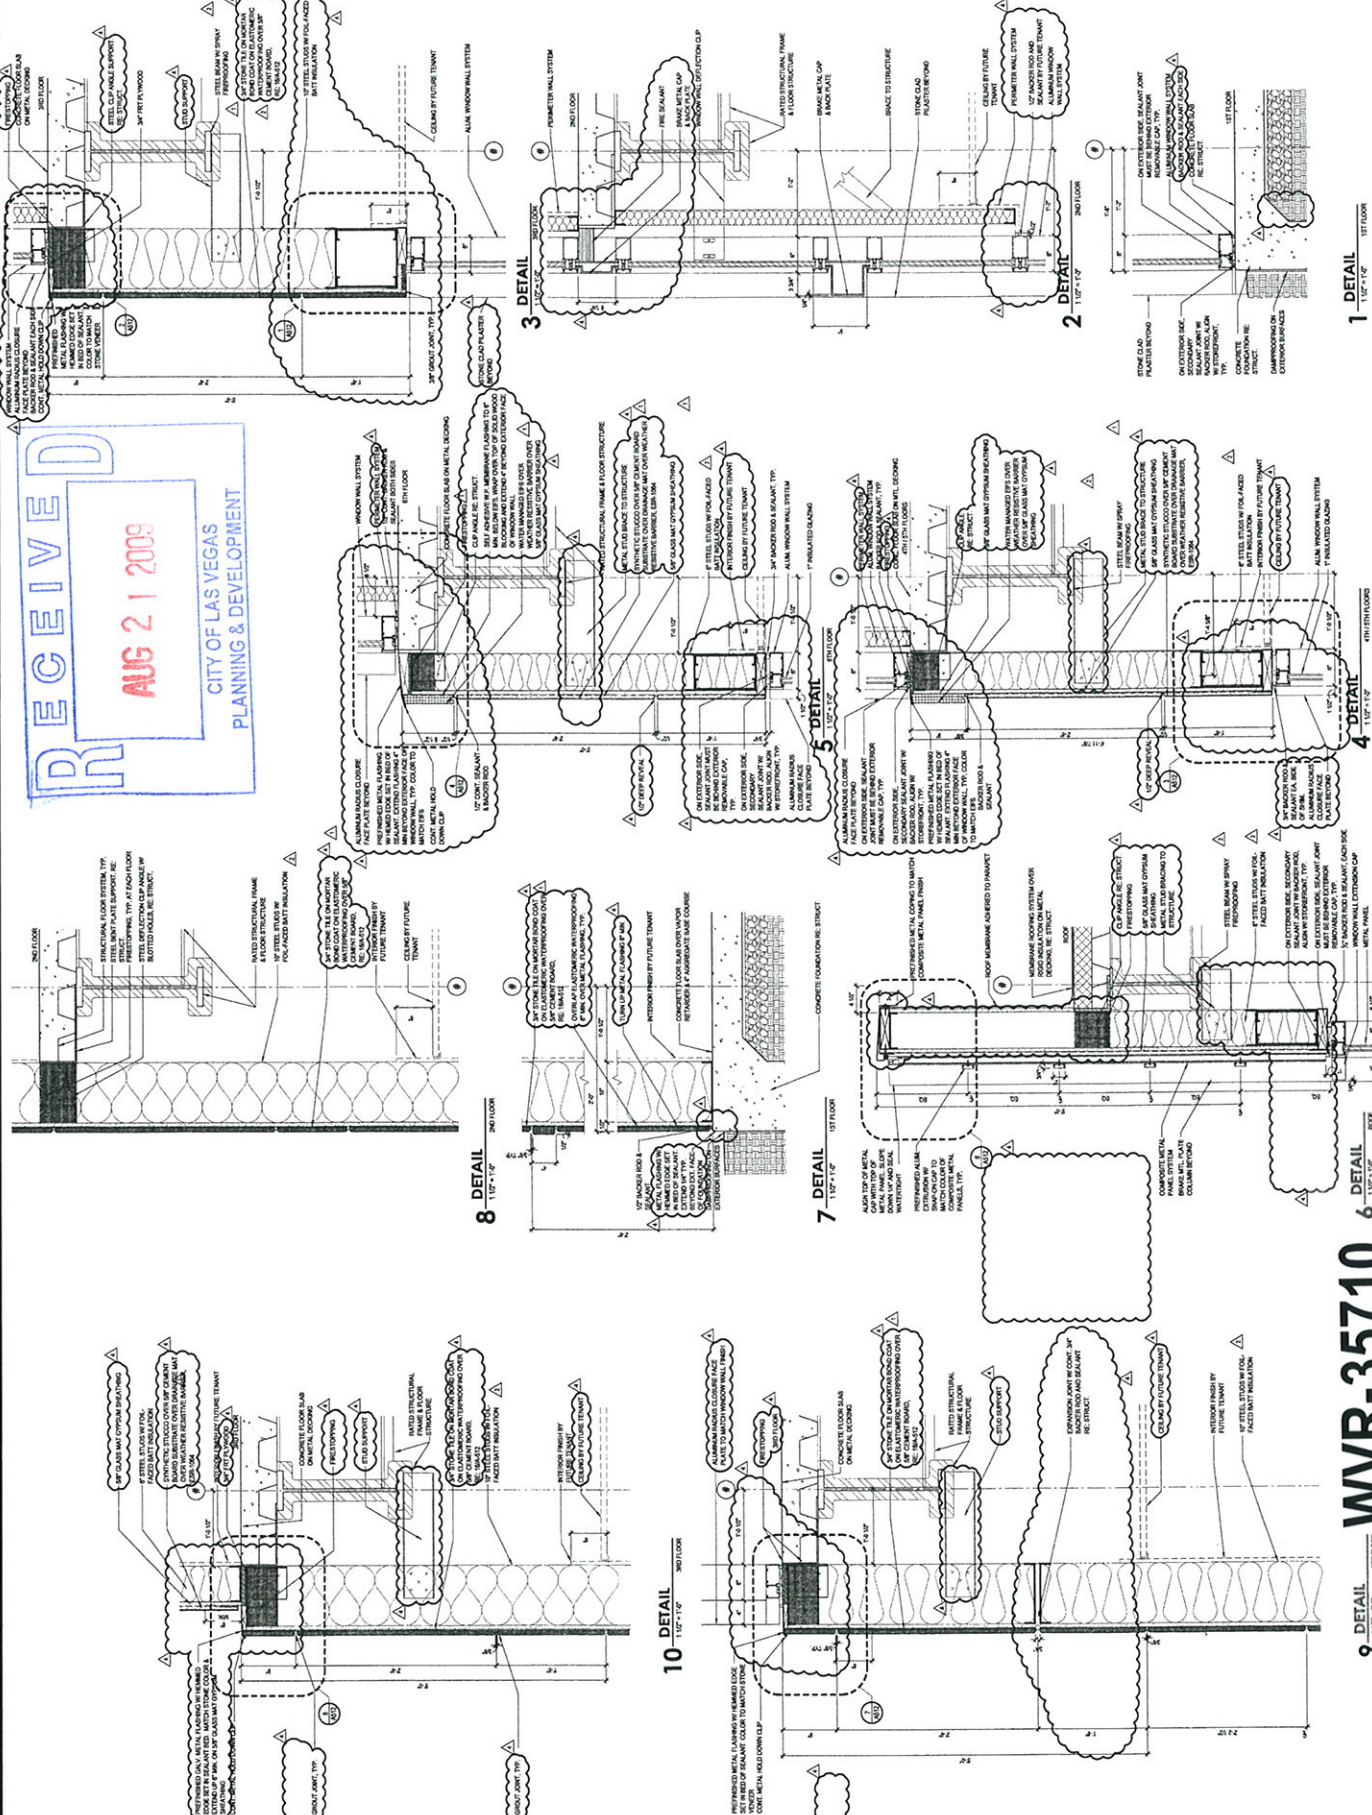

WVR-35710
10/08/09 PC

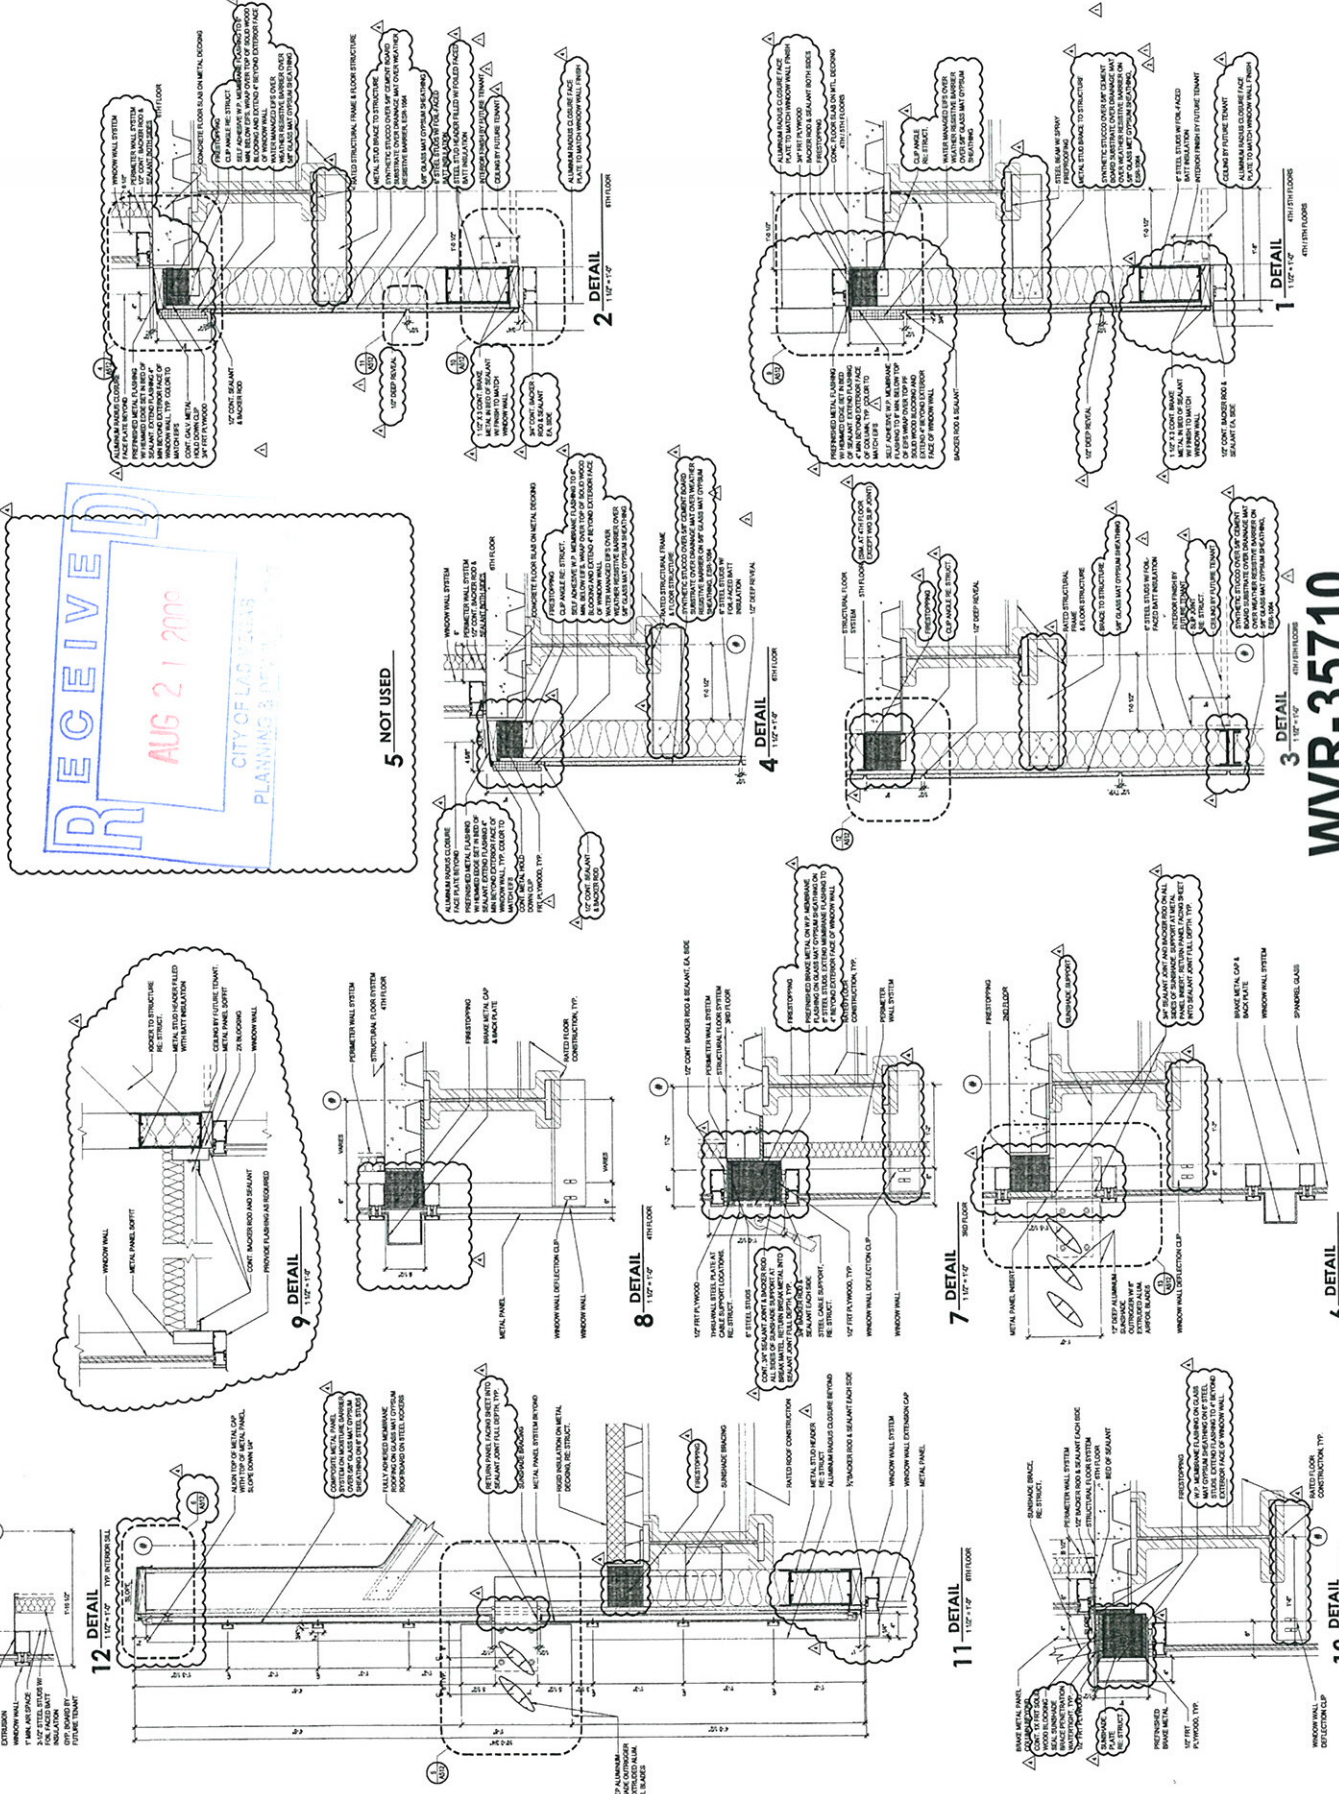


RECEIVED
AUG 21 2009
CITY OF LAS VEGAS
PLANNING & DEVELOPMENT
DESIGN REVIEW

LAUTH
866 848 6500 • www.lauth.net

SEM
LAS VEGAS, NEVADA
702 735 1100
702 735 1101
SECTION DETAILS
Las Vegas, Nevada
Montecito Parkway
Core and Shell
MONTICITO OFFICE BUILDING

A-512
SECTION DETAILS


















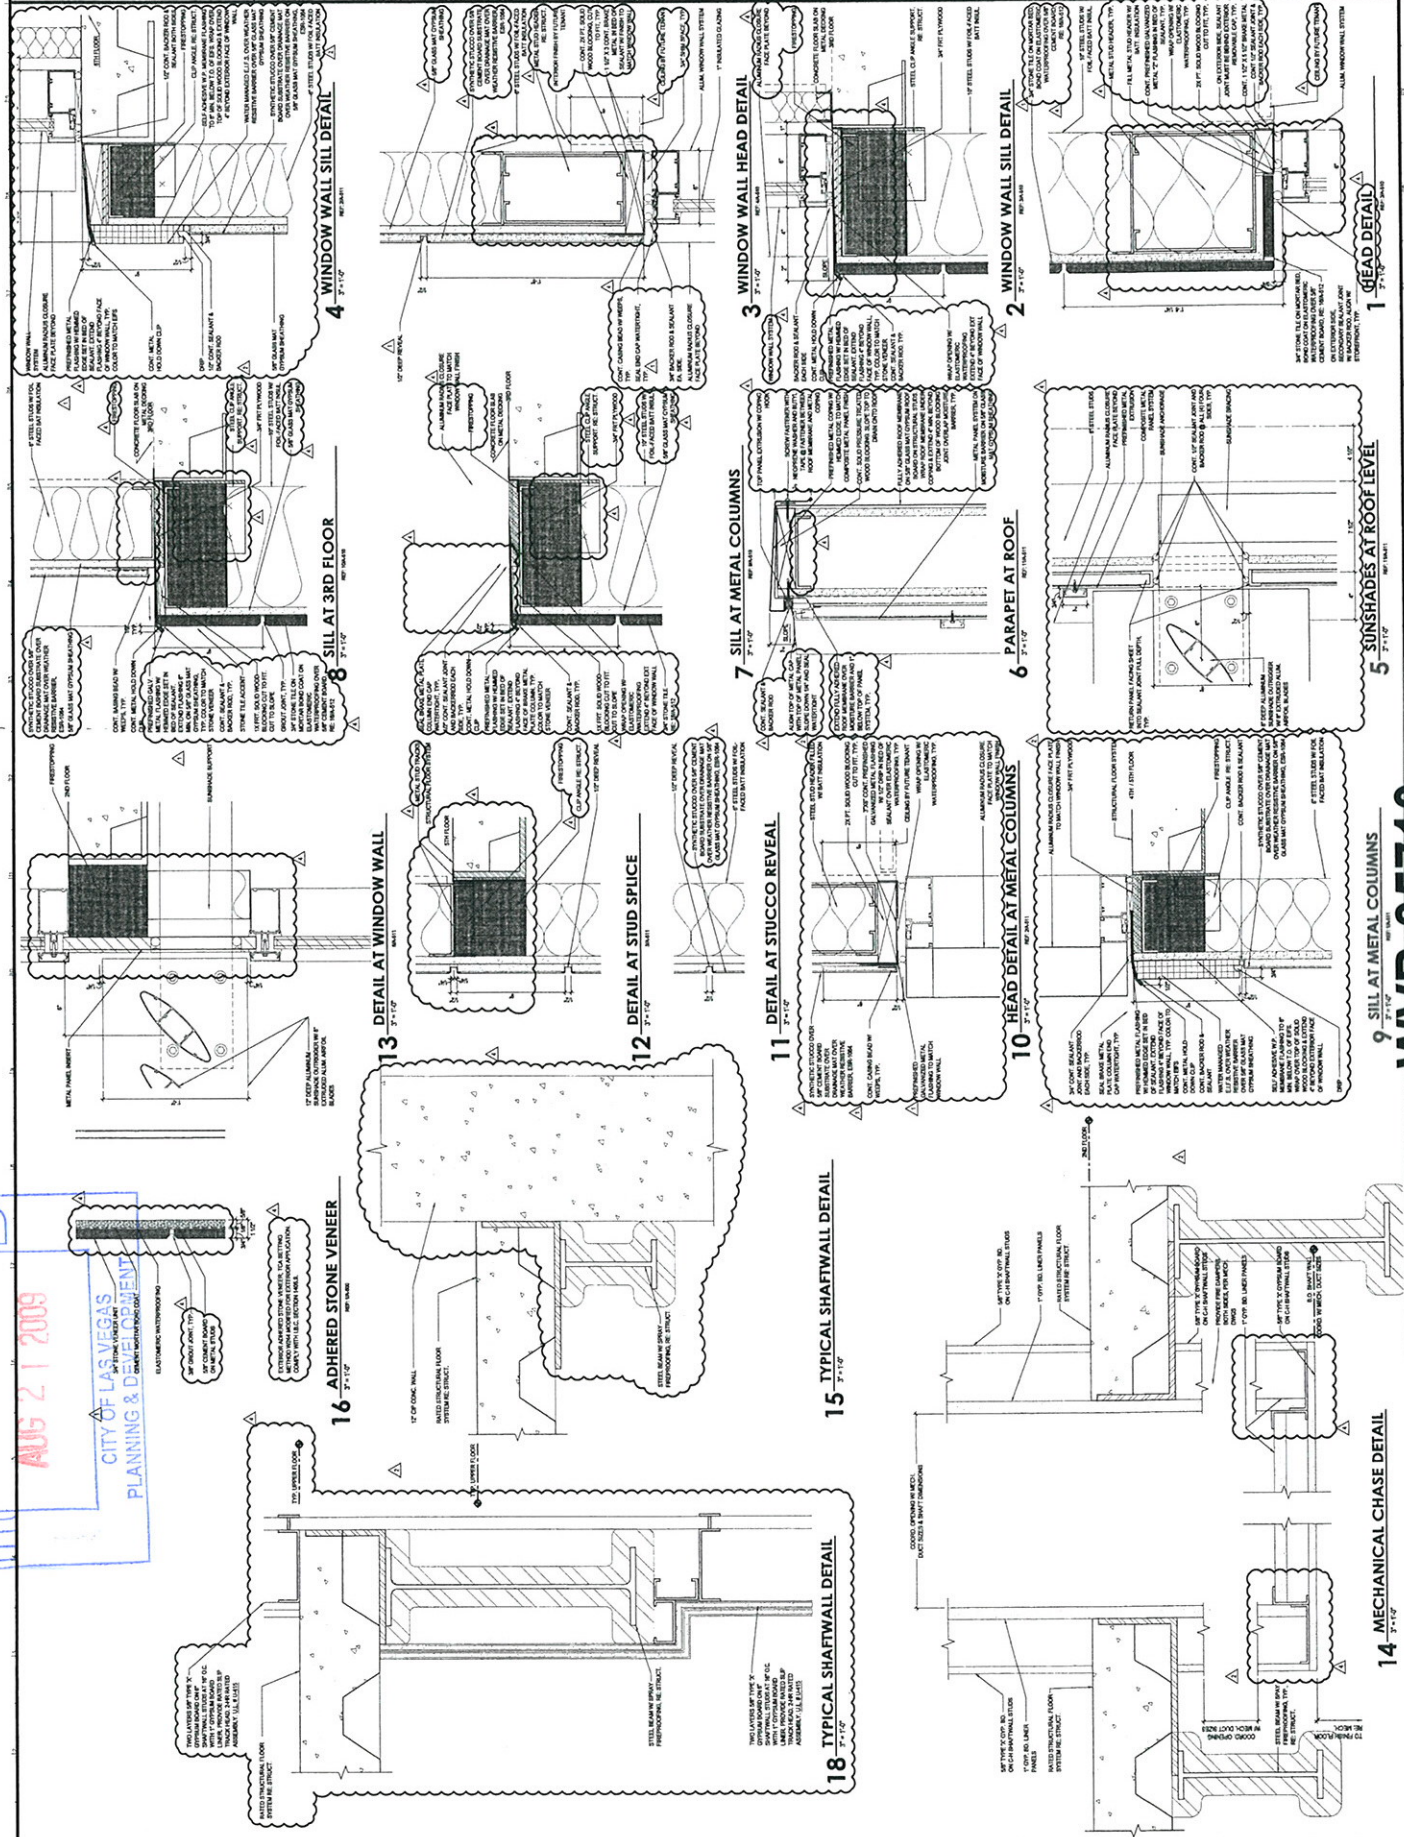







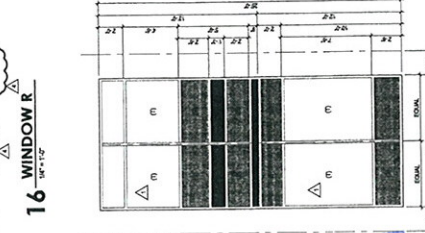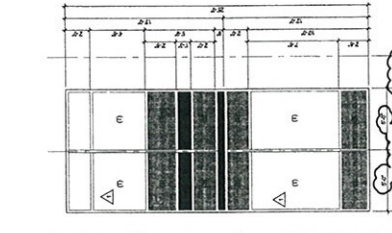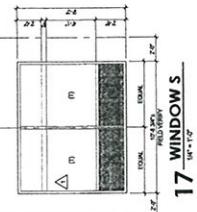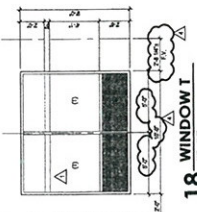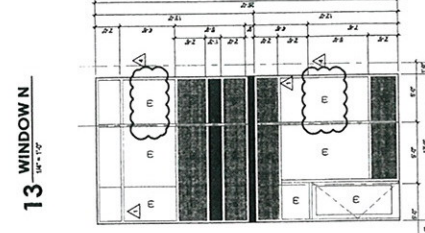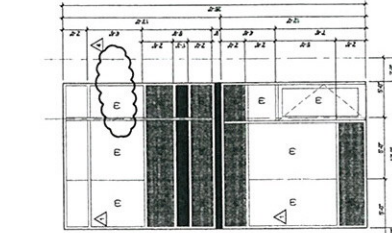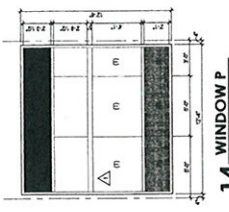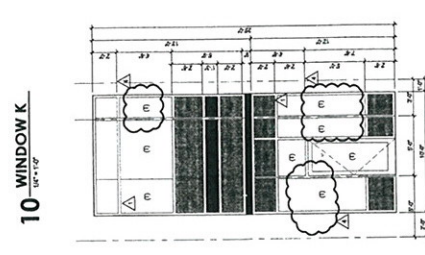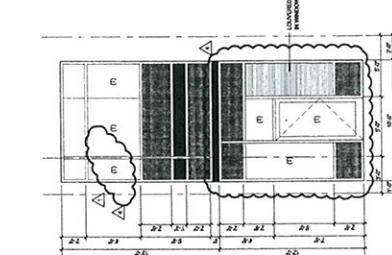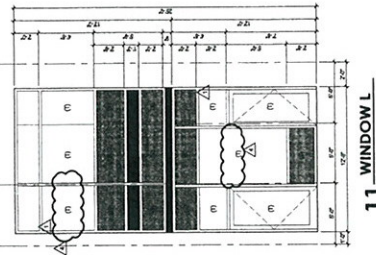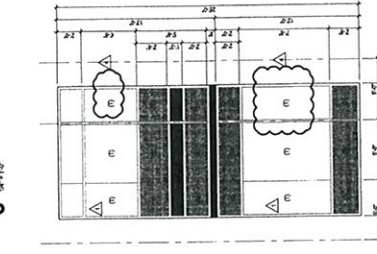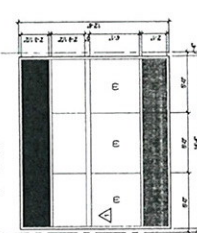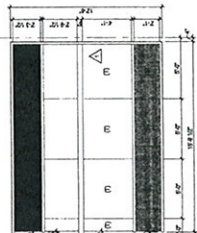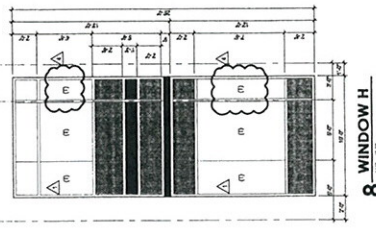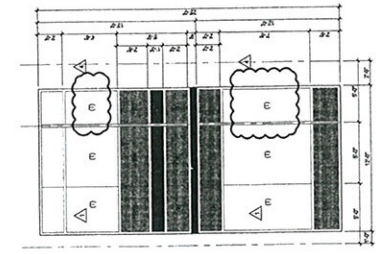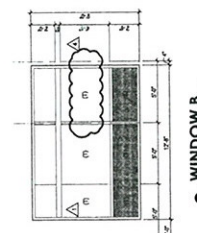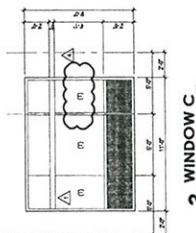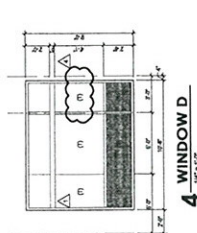


RECEIVED
AUG 21 2009
CITY OF LAS VEGAS
PLANNING & DEVELOPMENT

WVR-35710
10/08/09 PC

WVR-35710
10/08/09 PC

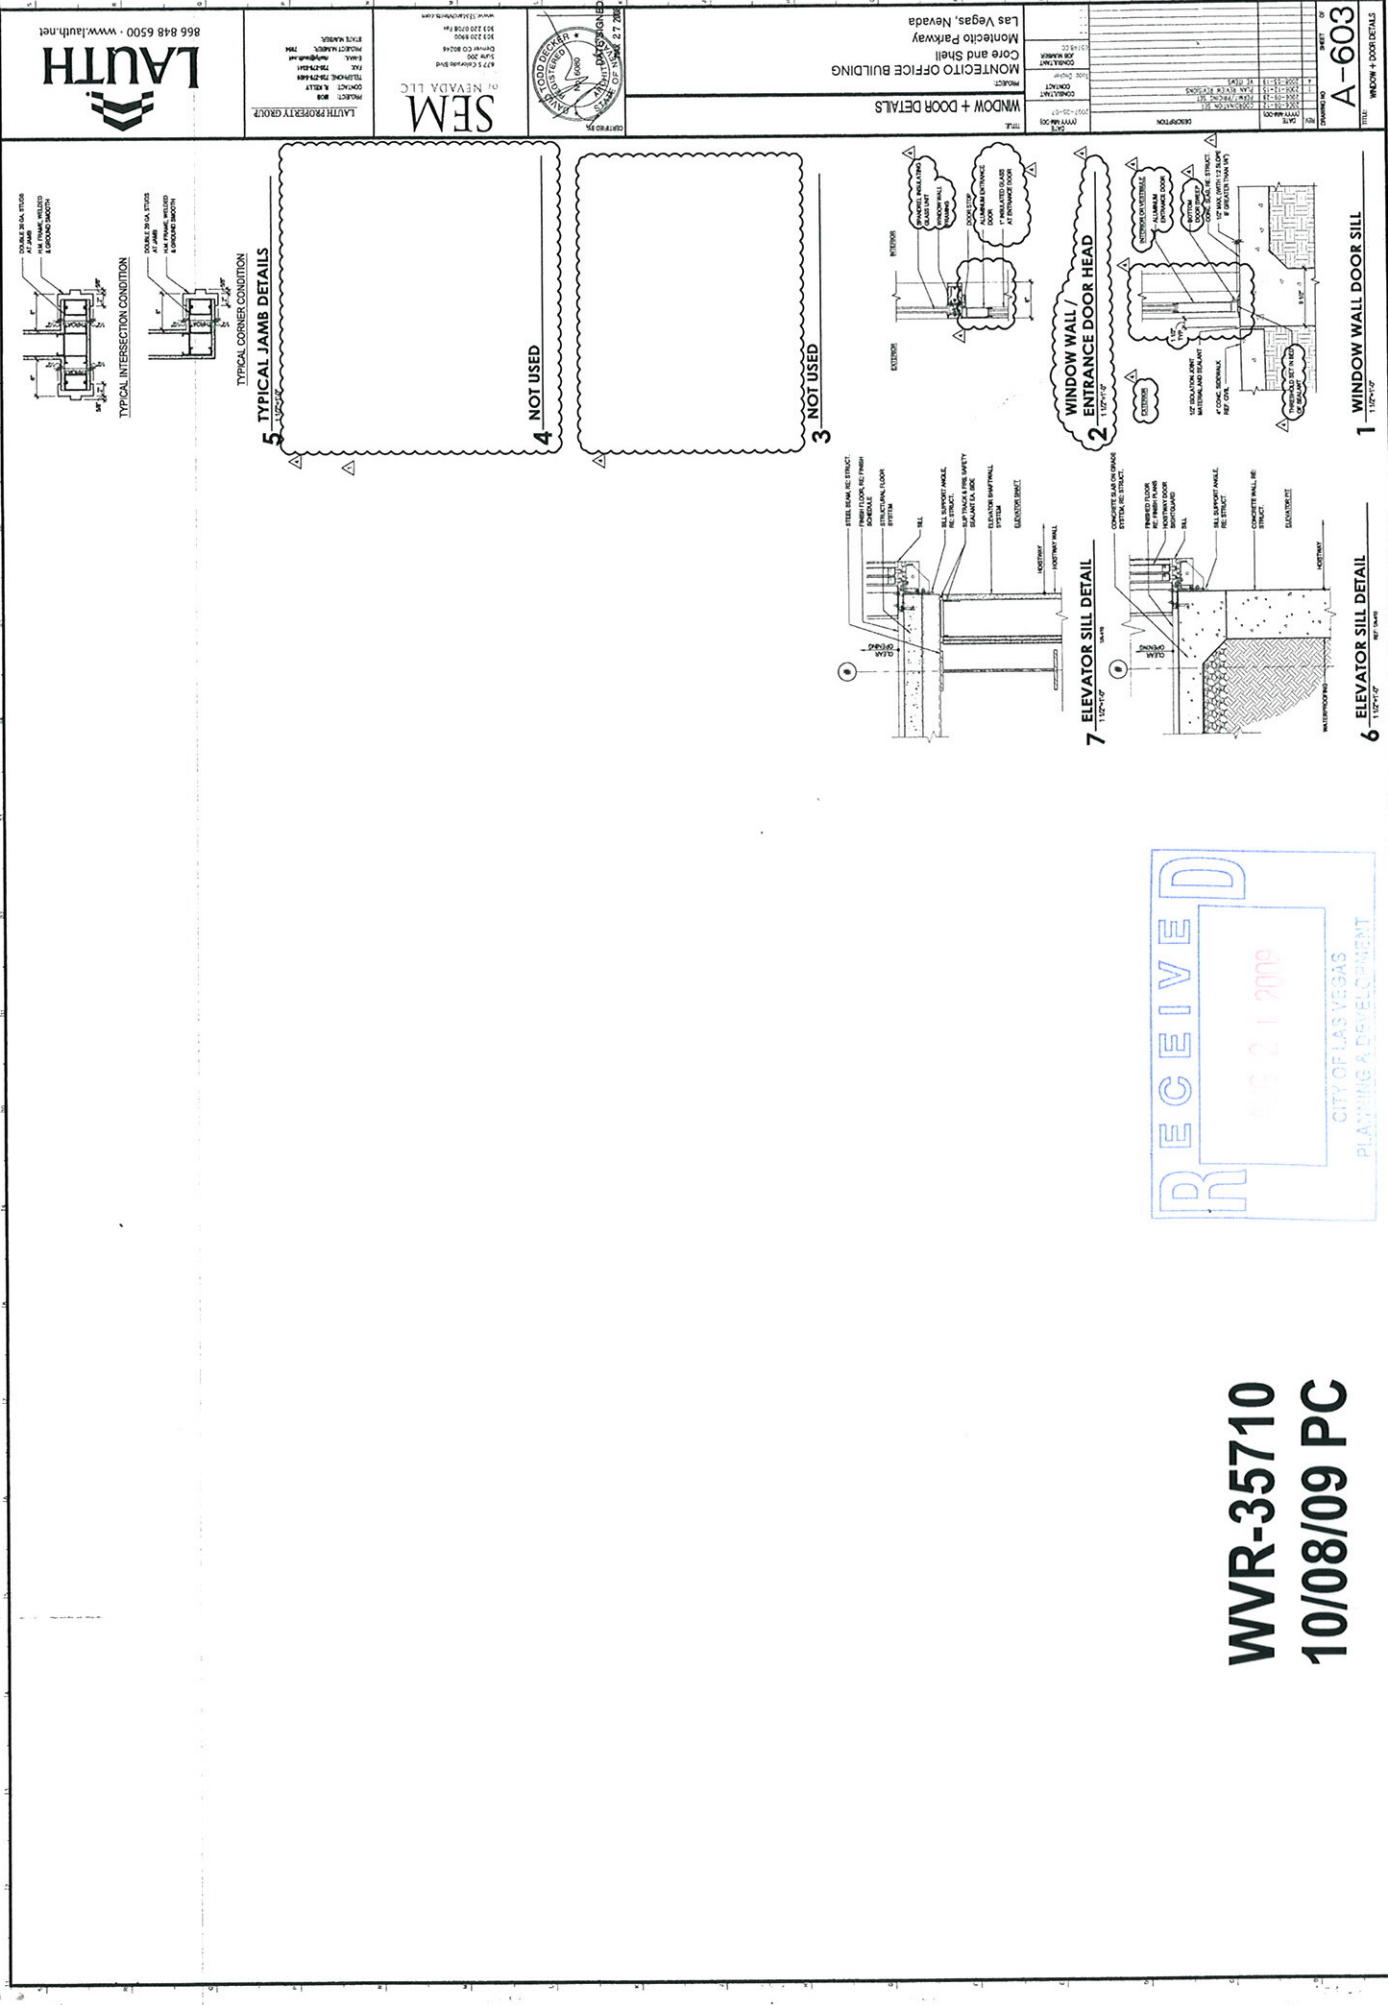


1 TYPICAL RESTROOM ACCESSORY PLAN

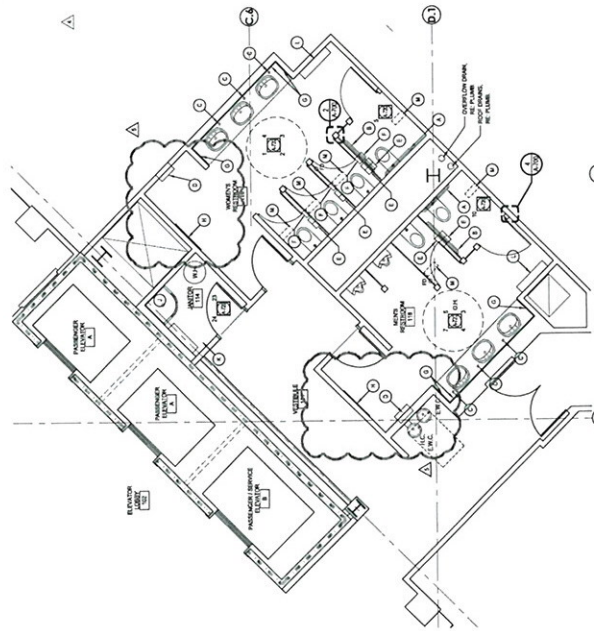


1 TYPICAL RESTROOM ACCESSORY PLAN


2 TOILET PARTITION COLUMN

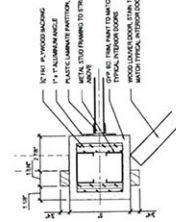


3 **TOILET PARTITION AT HEAD**
 $3'6" \times 1'40"$

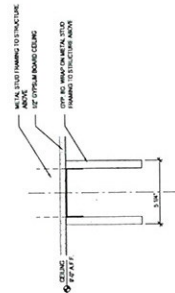

TOILET PARTITION COLUMN

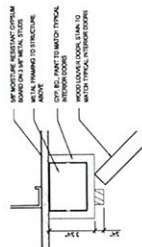


5 **TOILET PARTITION AT BASE**
 $3'' \times 1' 0''$

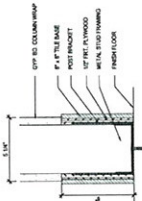

- [illegible]

TOILET PARTITION SECTION

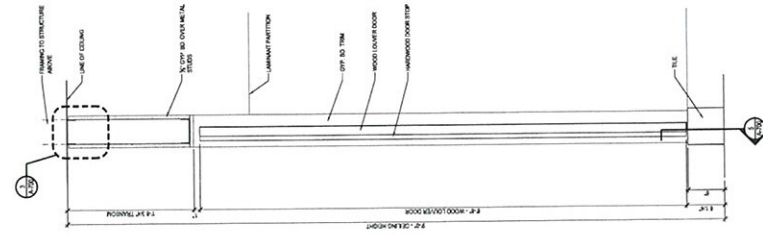

LAUTH
866 848 6500 • www.lauth.net

LAUTH PROPERTY GROUP
PROJECT BOX
CONTACT: M. KELLY
TELEPHONE: 726-7344M
FAX: 726-7344M
E-MAIL: mkelly@lauth.com
PROJECT NUMBER: 28M
ESTATE NUMBER:

SEW
P. N. D. A. I. C.


RESTROOM ACCESSORY PLAN

RE	CONSULTANT	DATE
CO	CONTACT	(YYYY-MM-DD)
M	WORK ORDER	001-00-01
M	CONSULTANT	
LA		


[illegible]

A-700


RECEIVED
AUG 21 2009
CITY OF LAS VEGAS
PLANNING & DEVELOPMENT

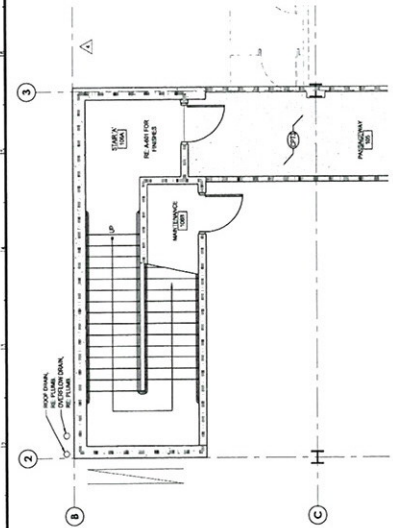

3 FLOOR FINISH PLAN - STAIR A (FIRST LEVEL)

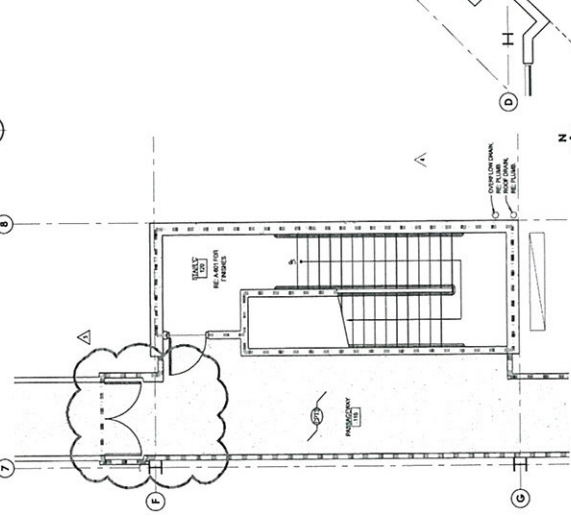

2 FLOOR FINISH PLAN - STAIR C (FIRST LEVEL)
1/4" = 1'-0"

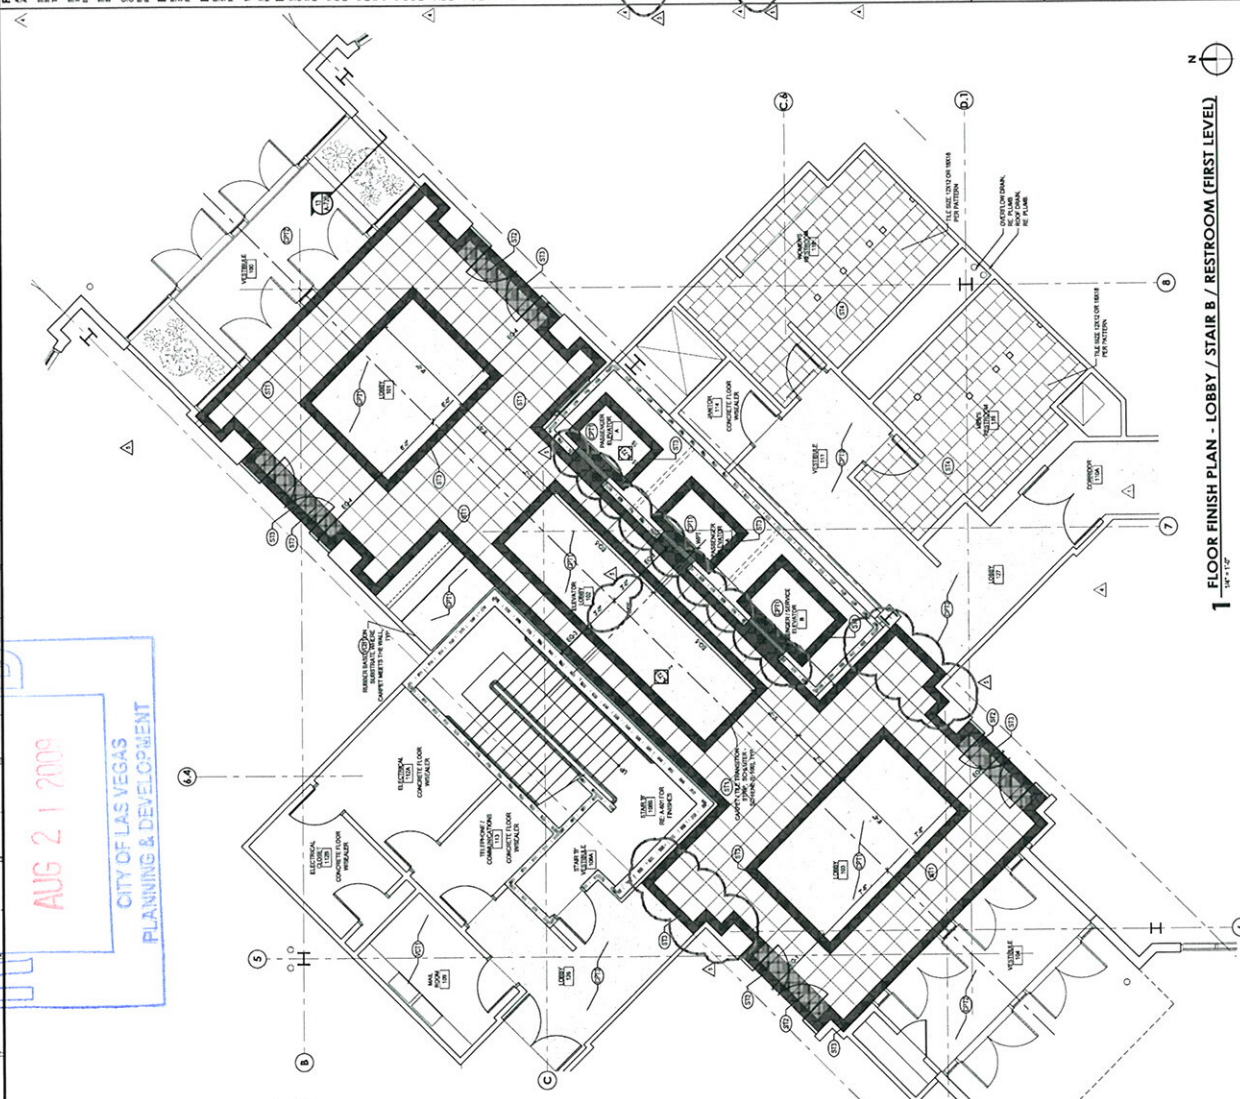[illegible]

1 FLOOR FINISH PLAN - LOBBY / STAIR B / RESTROOM (FIRST LEVEL)
1/8" = 1'-0"

WVR-35710
10/08/09 PC

[illegible]

GENERAL NOTES:

1. REFER TO SHEET A-01 FOR FISH LEGENDS AND MATERIALS.
2. PROVIDE FLOOR FINISH TRANSITIONS AT THE CENTERLINE OF LVA, UNLESS NOTED OTHERWISE.
3. PROVIDE STAINLESS STEEL TRANSITION STRIPS BETWEEN FLOOR FINISHES UNLESS NOTED OTHERWISE.
4. PROVIDE BLUNDER REDUCER BETWEEN FLOOR FINISHES AND UNPAVED SLABS, TYPICAL.
5. CENTER FLOORING PATTERNS WITHIN THE SPACE UNLESS NOTED OTHERWISE.

1

[illegible]

866 848 6500 • www.lauth.net


--	--

SEW

303 220 4800
303 220 0208 fax



[illegible]

FLOOR FINISH PLANS (FIRST LEVEL)

PROJECT
MONTICITO OFFICE BUILDING
Core and Shell
Monticito Parkway
Las Vegas, Nevada


[illegible]

DATE: 11-11-2000		SHEET: OF A-710 FLOOR FRESH PLANS TITLE:
BY: A	1	
CHECKED: A	1	
APPROVED: A	1	
DATE: 11-11-2000	1	

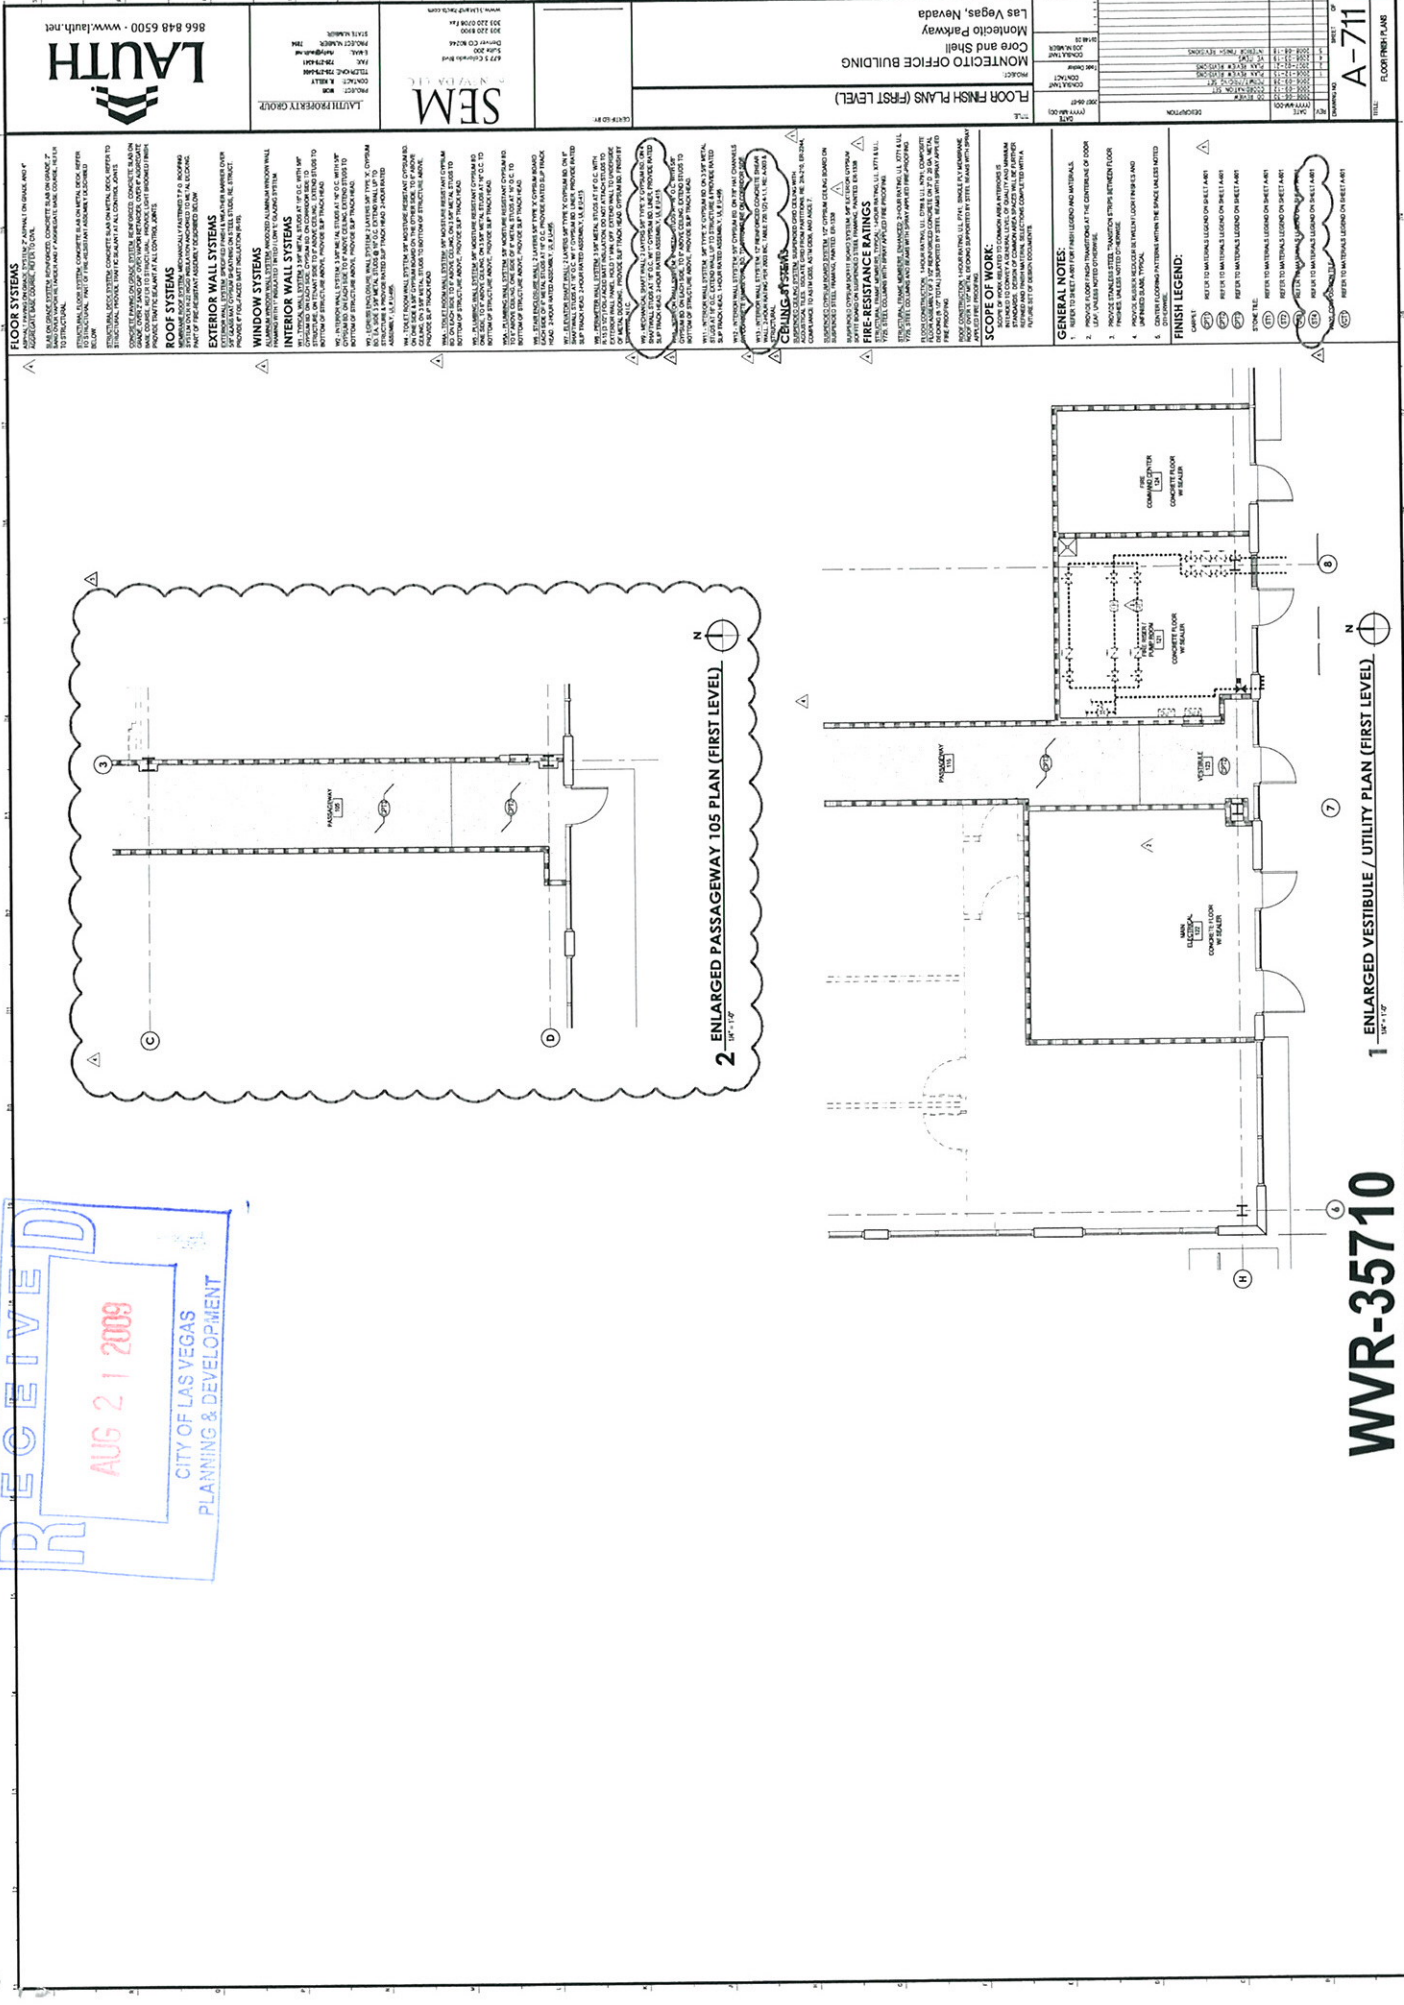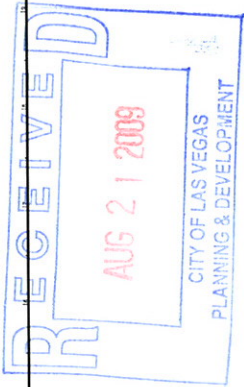


WVR-35710
10/08/09 PC


RECEIVED
AUG 21 2009
CITY OF LAS VEGAS
PLANNING & DEVELOPMENT

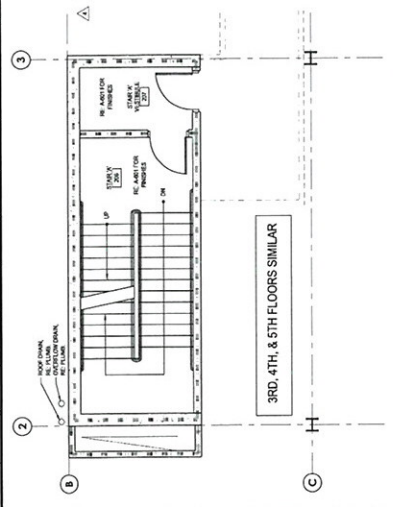

3 FLOOR FINISH PLAN - STAIR A (SECOND LEVEL)

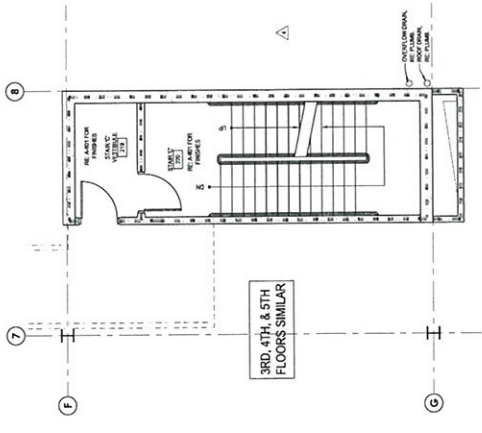

FLOOR FINISH PLAN - STAIR C (SECOND LEVEL)

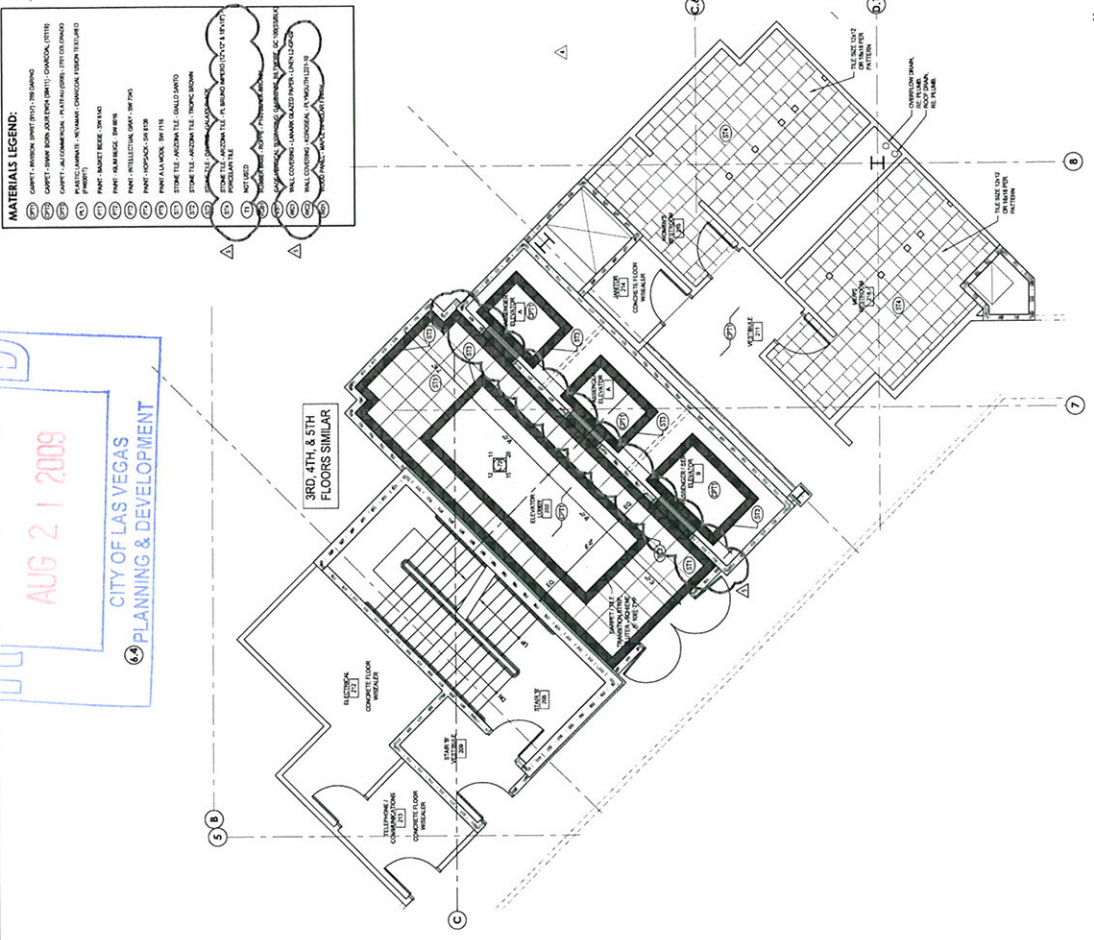

1 FLOOR FINISH PLAN - LOBBY / STAIR B / RESTROOM (SECOND LEVEL)

WVR-35710
10/08/09 PC

[illegible]

AUG 2 | 2009

CITY OF LAS VEGAS
PLANNING & DEVELOPMENT



WVR-35710
10/08/09 PC

FINISH LEGEND:

CARPET	

[illegible]

