


Submitted after final agenda

Revised by
Joey DeBlanco
11/24/09

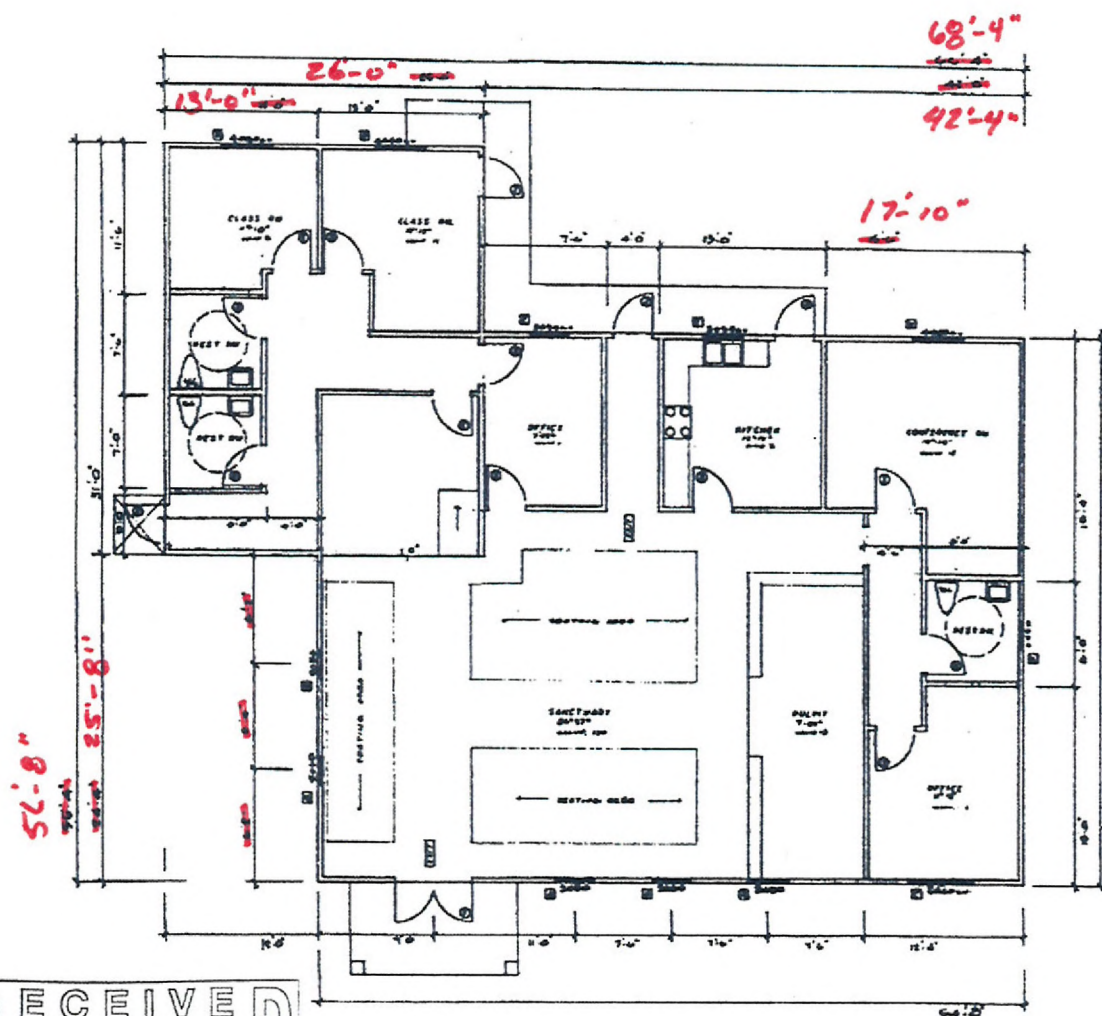



FLOOR PLAN 17-0-1-0


WCT - 101

RIVERS OF LIVING WATER MINISTRIES
1230 ADAMS AVE.
V, NEV. 89306

SDR-35931
10/22/09 PC

U4-15
A1

RECEIVED
SEP - 9 2009
CITY OF LAS VEGAS
PLANNING & DEVELOPMENT