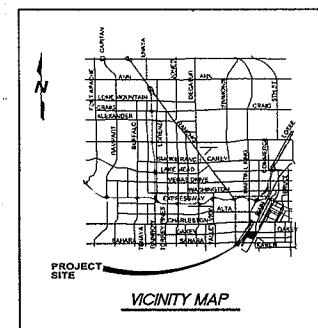
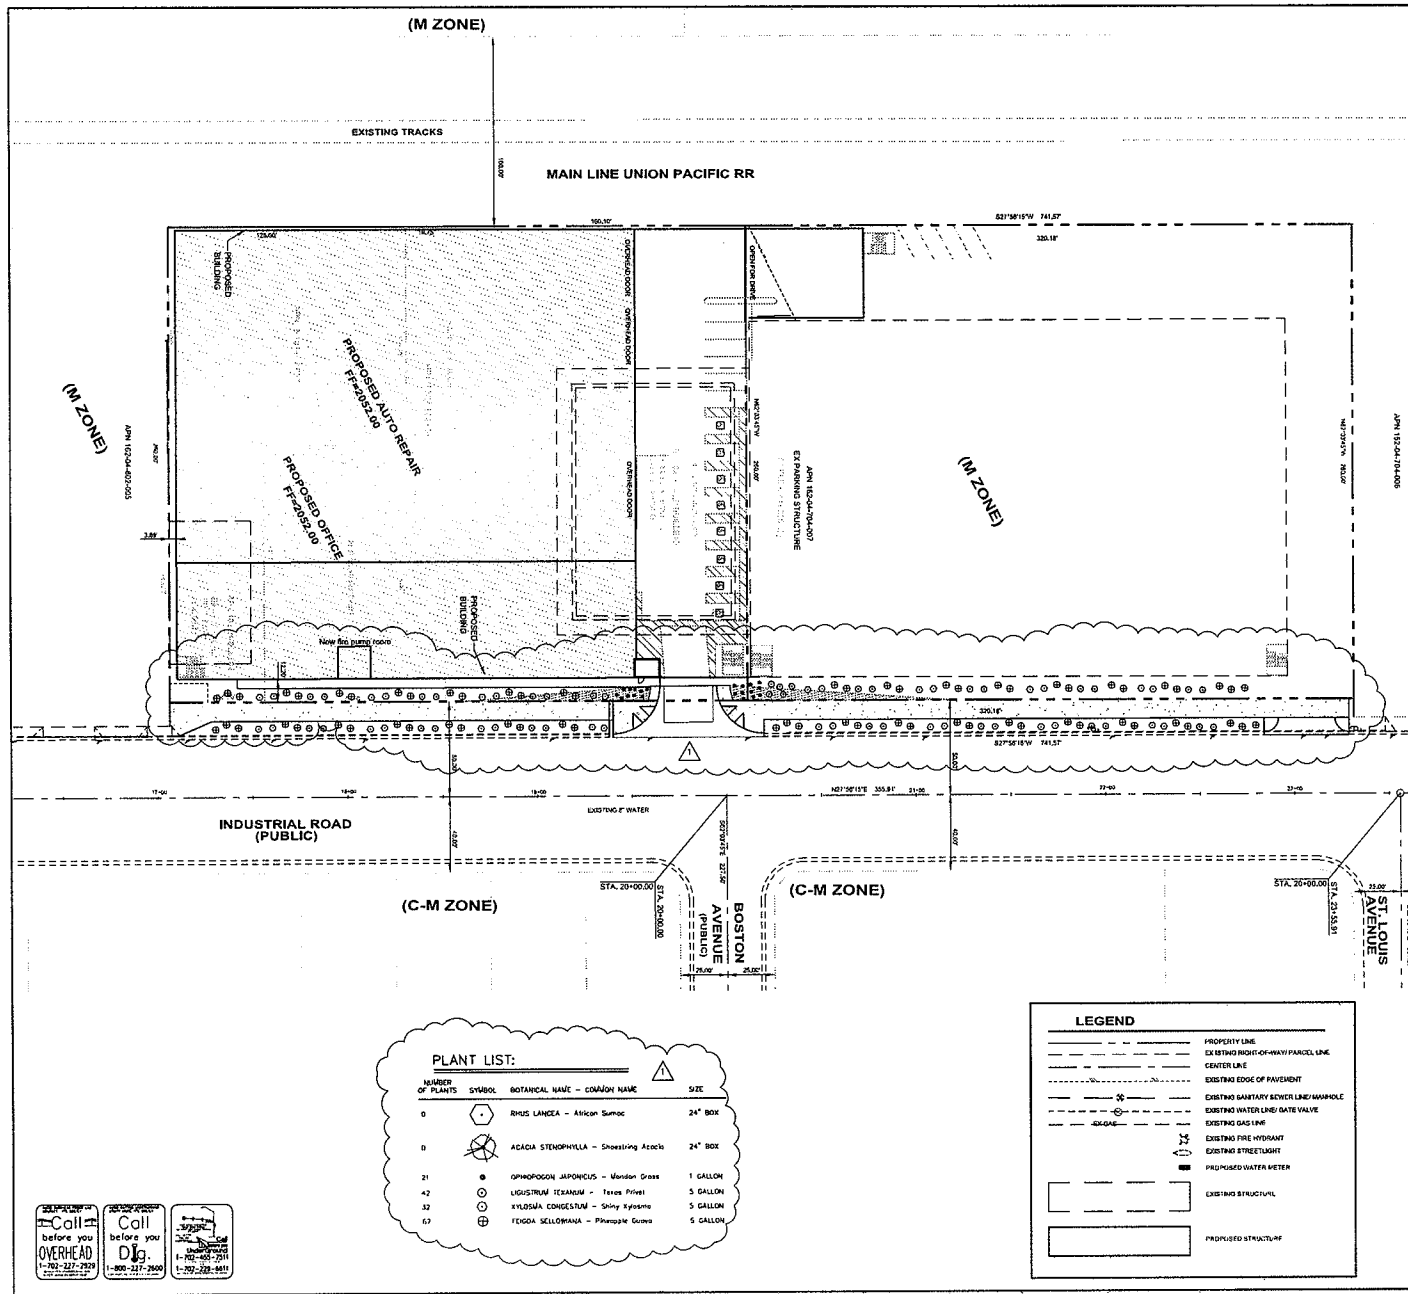


**RECEIVED**  
**OCT 16 2009**

CITY OF LAS VEGAS PLANNING & DEVELOPMENT DEPT. DATE

CITY OF LAS VEGAS TRAFFIC ENGINEERING SECTION DATE

CLV #19167

| DATE     | BY  | DATE | INT. | DATE | APP. | DATE | FILE |
|----------|-----|------|------|------|------|------|------|
| 01-24-06 | LLC |      |      |      |      |      |      |
| 01-24-06 | LLC |      |      |      |      |      |      |
**BELL REAL ESTATE, LLC**


**CONSULTING**

BELL TRANSPORTATION  
PARKING STRUCTURE  
APN #162-04-704-008, 162-04-802-001 THRU 004  
**SITE PLAN**  
LANDSCAPE PLAN

**PROFESSIONAL ENGINEER**  
LOUIS L. CHEN  
CHEN L. CHEN  
DT. 12/21/08  
CPL  
REG. NO. 15257  
03-04-09

ENGINEER'S SEAL

SCALE  
1" = 30'

SHEET NUMBER  
5 OF 5

**ROC-36423**  
**12-02-09 CC**