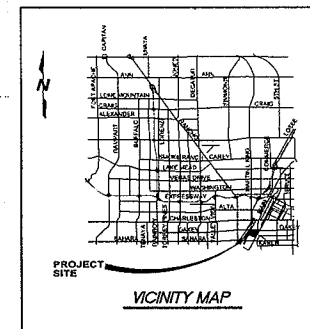
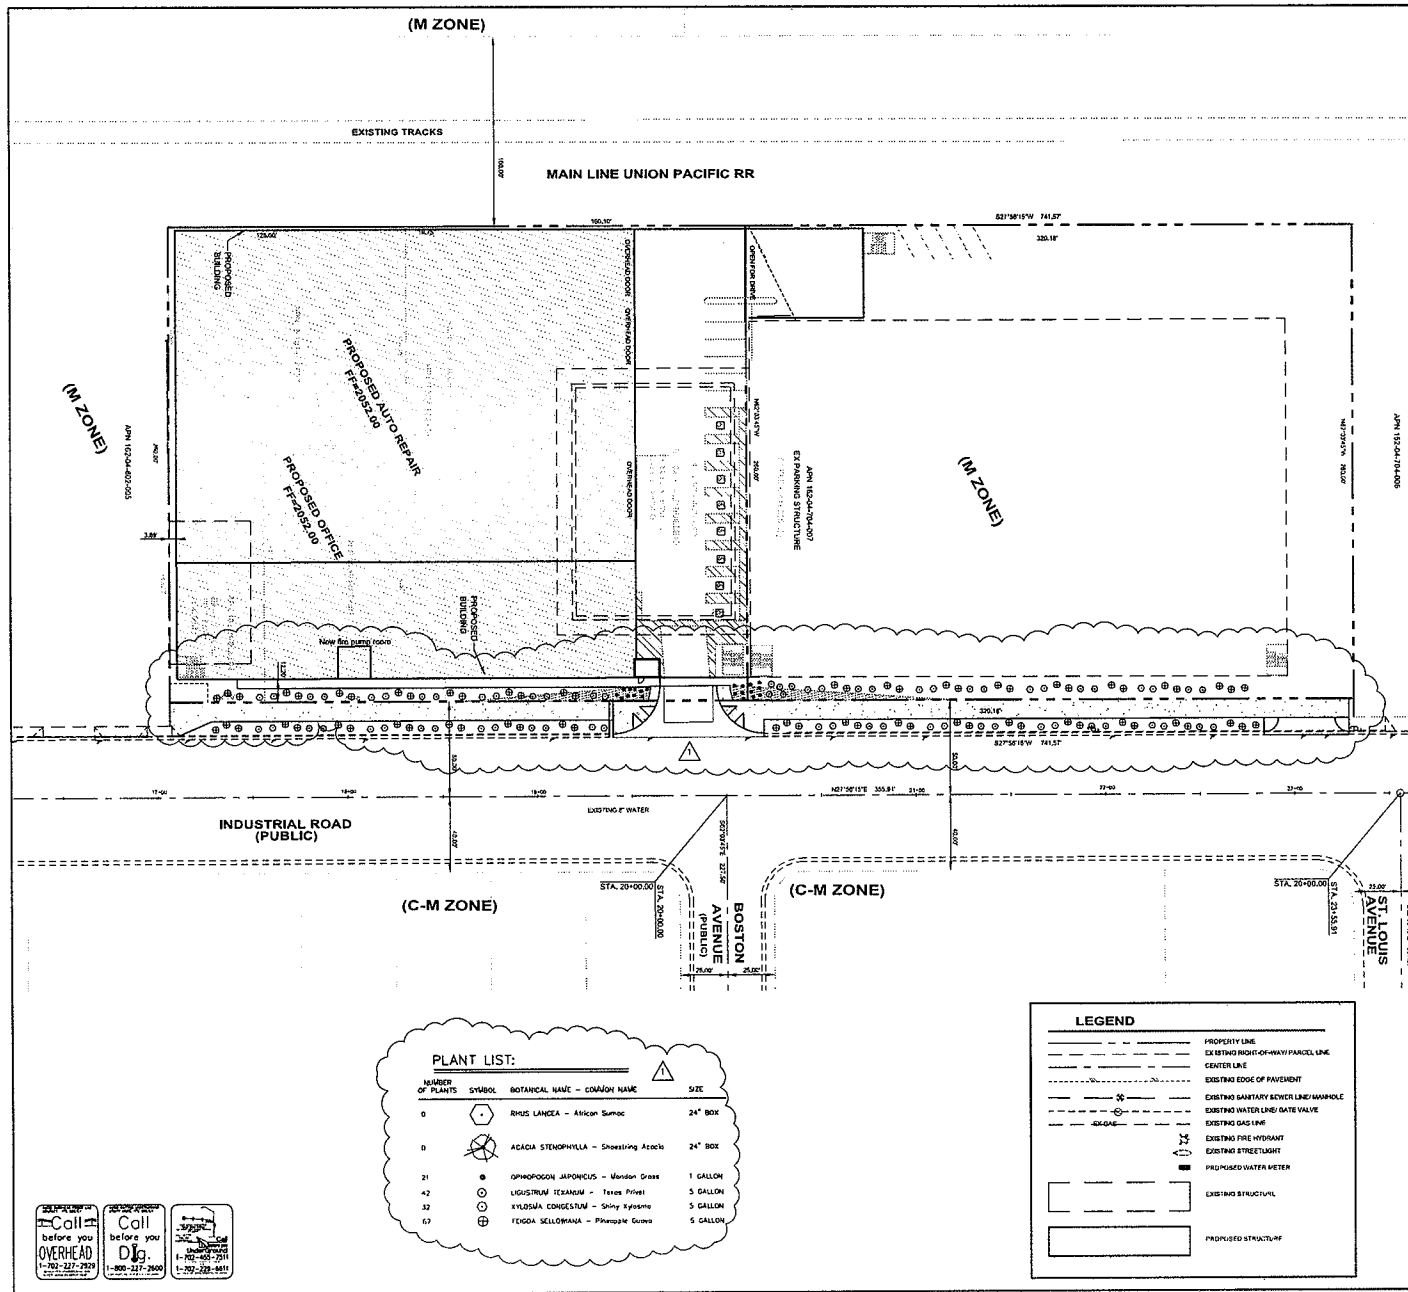


RECEIVED
OCT 16 2009

CITY OF LAS VEGAS PLANNING & DEVELOPMENT DEPT. DATE

CITY OF LAS VEGAS TRAFFIC ENGINEERING SECTION DATE

CLV #19167


DATE	BY	DATE	BY	DATE	BY

BELL REAL ESTATE, LLC

1000 S. GREEN VALLEY AVENUE SUITE 100
HENDERSON, NEVADA 89015
702.944.1111

CONSULTING

BELL TRANSPORTATION
PARKING STRUCTURE
APN #162-04-704-008, 162-04-802-001 THRU 004
SITE PLAN
LANDSCAPE PLAN

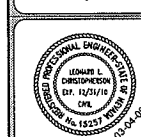

ENGINEER'S SEAL
SCALE
1" = 30'
SHEET NUMBER
5 OF 5

ROC-36423
12-02-09 CC