

# PLANNING & DEVELOPMENT DEPARTMENT

## APPLICATION / PETITION FORM

Application/Petition I Report Review  
 Project Address (Location) 928 Las Vegas Blvd  
 Project Name Gateway Motel Proposed Use off premise sign  
 Assessor's Parcel #(s) 139-34-410-165 Ward # 5  
 General Plan: existing GC proposed \_\_\_\_\_ Zoning: existing C-2 proposed \_\_\_\_\_  
 Commercial Square Footage \_\_\_\_\_ Floor Area Ratio \_\_\_\_\_  
 Gross Acres \_\_\_\_\_ Lots/Units \_\_\_\_\_ Density \_\_\_\_\_  
 Additional Information \_\_\_\_\_

PROPERTY OWNER Gateway Motel Contact David Jhewar  
 Address 1775 N Warm Springs Rd Phone: 801 521 1775 Fax: 801 521 9741  
 City Salt Lake City State UT Zip 84116  
 E-mail Address \_\_\_\_\_

APPLICANT Reagan National Advertising Contact Dewey Reagan  
 Address 1775 N Warm Springs Rd Phone: 801 521 1775 Fax: 801 521 9741  
 City Salt Lake City State UT Zip 84116  
 E-mail Address dewey@reaganusa.com

REPRESENTATIVE Reagan National Advertising Contact Dewey Reagan  
 Address 1775 N Warm Springs Rd Phone: 801 521 1775 Fax: 801 521 9741  
 City Salt Lake City State UT Zip 84116  
 E-mail Address \_\_\_\_\_

Property Owner Signature\* Dewey Reagan

\* An authorized agent may sign in lieu of the property owner for Final Maps, Tentative Maps, and Parcel Maps.

Print Name Dewey Reagan

Subscribed and sworn before me

This 23 day of September, 2009

Cheryl Jensen

Notary Public in and for said County and State

Revised 10/27/08



### FOR DEPARTMENT USE ONLY

|                 |                    |
|-----------------|--------------------|
| Case #          | <u>RQX-36373</u>   |
| Meeting Date:   | <u>12/17/09</u>    |
| Total Fee:      | <u>\$500</u>       |
| Date Received:* | <u>10/13/09</u>    |
| Received By:    | <u>[Signature]</u> |

\*The application will not be deemed complete until the submitted materials have been reviewed by the Planning and Development Department for consistency with applicable sections of the Zoning Ordinance.

f:\depot\Application Packet\Application Form.pdf

OCT 13 2009



## PLANNING & DEVELOPMENT DEPARTMENT

### STATEMENT OF FINANCIAL INTEREST

Case Number: **RQR-36373** APN: 139-34-410-165

Name of Property Owner: Gateway Motel Inc

Name of Applicant: Reagan National Advertising

Name of Representative: Dewey Reagan

To the best of your knowledge, does the Mayor or any member of the City Council or Planning Commission have any financial interest in this or any other property with the property owner, applicant, the property owner or applicant's general or limited partners, or an officer of their corporation or limited liability company?

☐ Yes

☒ No

If yes, please indicate the member of the City Council or Planning Commission who is involved and list the name(s) of the person or persons with whom the City Official holds an interest. Also list the Assessor's Parcel Number if the property in which the interest is held is different from the case parcel.

City Official: \_\_\_\_\_

Partner(s): \_\_\_\_\_

APN: \_\_\_\_\_

Signature of Property Owner: Dewey Reagan

Print Name: Dewey Reagan

Subscribed and sworn before me


This 23 day of September, 2009

Cheryl Jensen  
Notary Public in and for said County and State



**RECEIVED**  
**OCT 13 2009**



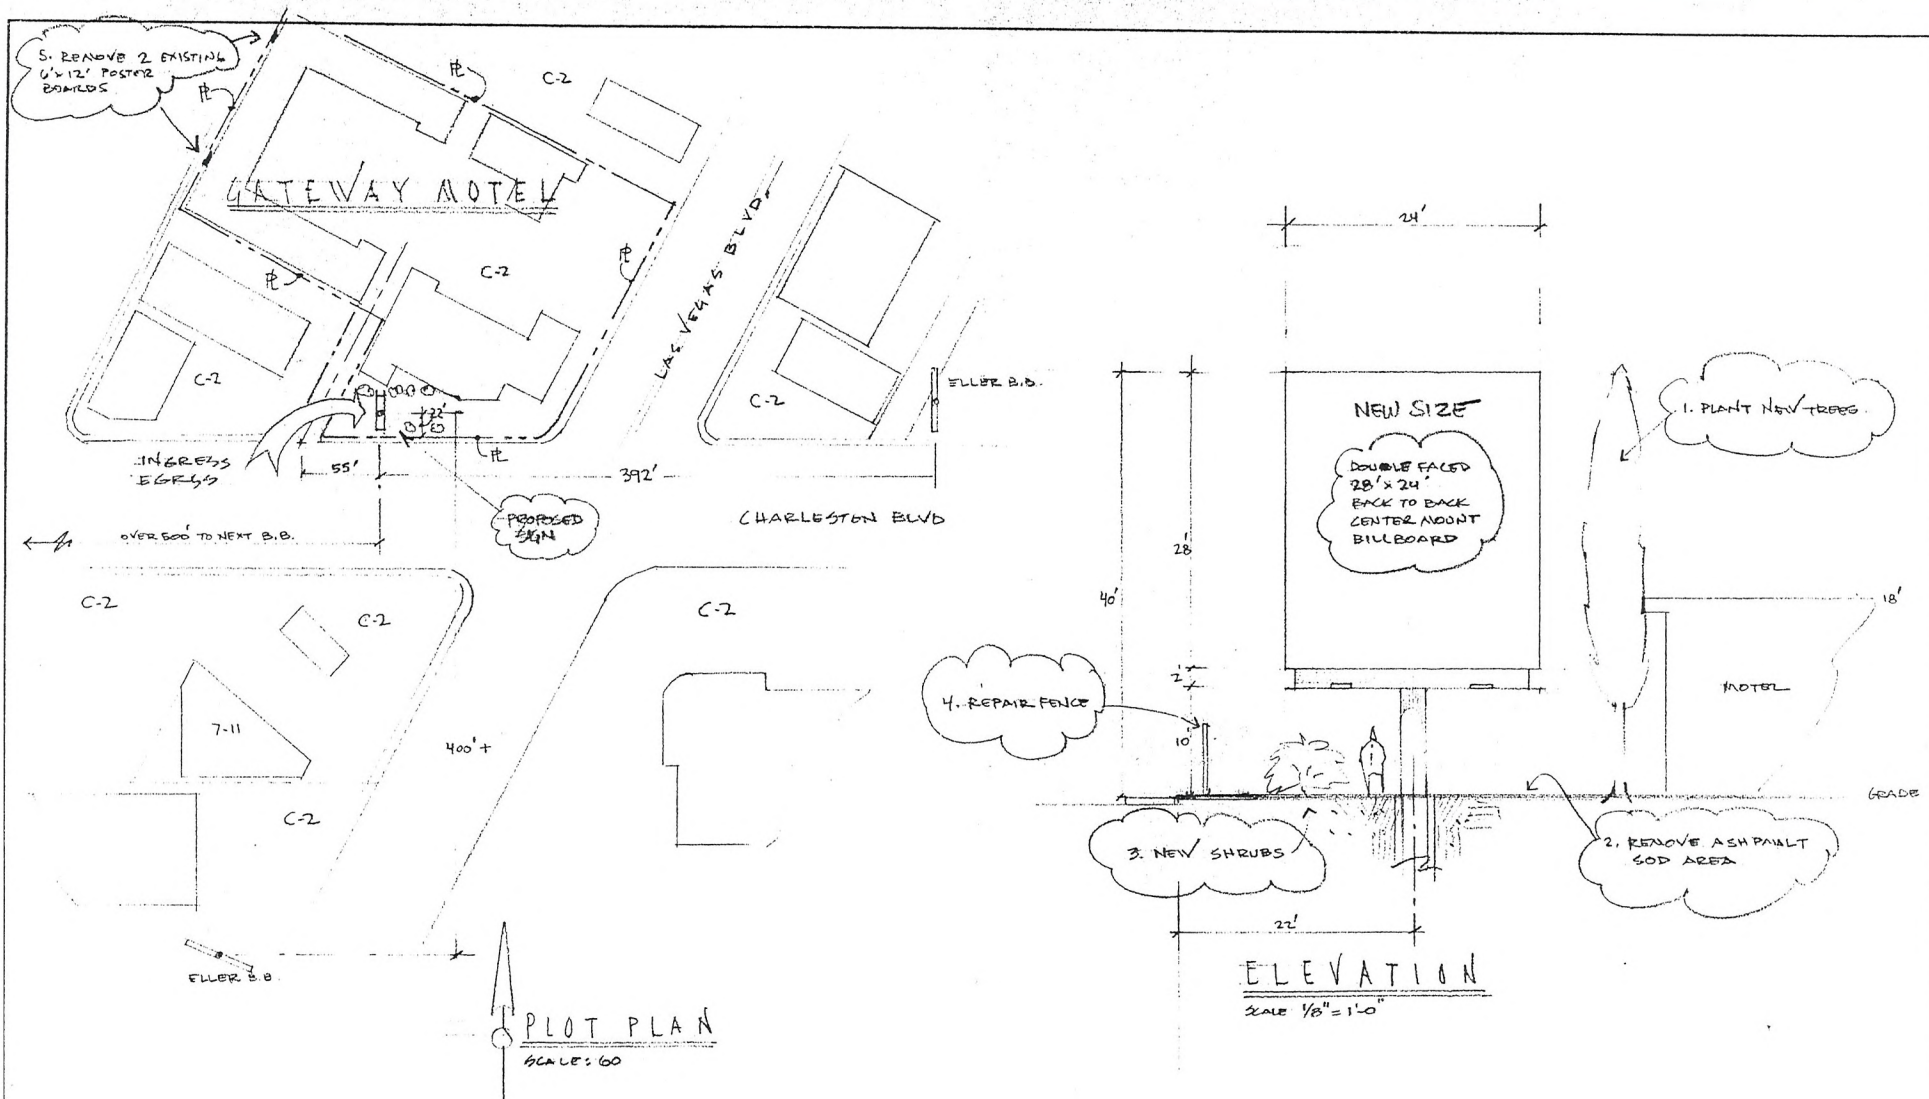

REAGAN NATIONAL ADVERTISING

7181 S. INDUSTRIAL LN NV 89118 • 702.361-3704

|              |               |
|--------------|---------------|
| OWNER:       | GATEWAY MOTEL |
| 728 LVES     | LV NV 89109   |
| SCALE: NOTED | APPROVED BY:  |
| DRAWN BY LCC |               |

RECEIVED RQR-36373

OCT 13 2009 12/17/09 PC