



PLANNING & DEVELOPMENT DEPARTMENT

APPLICATION / PETITION FORM

Application/Petition For: Liquor license
 Project Address (Location) 4800 E. Bonanza Rd #9 Las Vegas NV 89110
 Project Name _____ Proposed Use _____
 Assessor's Parcel #(s) 140-29-801-011 Ward # 3
 General Plan: existing SC proposed _____ Zoning: existing C-1 proposed _____
 Commercial Square Footage _____ Floor Area Ratio _____
 Gross Acres _____ Lots/Units _____ Density _____
 Additional Information _____

PROPERTY OWNER Bonanza Sunrise LLC Contact C/O Gotski Commercial Real Estate
 Address 4755 Dean Martin Dr Phone: 221-8226 Fax: 221-1256
 City Las Vegas State NV Zip 89103
 E-mail Address pamela@gatskicommercial.com

APPLICANT Maricarmen Soria/Flaguapac Contact _____
 Address 4800 E. Bonanza Rd #9 Phone: 581-1197 Fax: _____
 City Las Vegas State NV Zip 89110
 E-mail Address _____

REPRESENTATIVE _____ Contact _____
 Address _____ Phone: _____ Fax: _____
 City _____ State _____ Zip _____
 E-mail Address _____

Property Owner Signature* Robert L. Moore
 * As owner's Representative
 Print Name Robert L. Moore

Subscribed and sworn before me
 This 2 day of DECEMBER, 20 09


Jamie J. Wingard

Notary Public in and for said County and State

FOR DEPARTMENT USE ONLY

Case #	<u>Sup-36564</u>
Meeting Date:	<u>12/17/09</u>
Total Fee:	
Date Received:*	<u>12/07/09</u>
Received By:	

*The application will not be deemed complete until the submitted materials have been reviewed by the Planning and Development Department for consistency with applicable sections of the Zoning Ordinance.

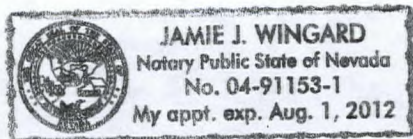

RECEIVED

DEC 04 2009



PLANNING & DEVELOPMENT DEPARTMENT

STATEMENT OF FINANCIAL INTEREST

Case Number: **SUP-36564** APN: 140-29-801-0111

Name of Property Owner: Bonanza Sunrise LLC c/o Gatski Commercial

Name of Applicant: Casa Tiaguepague

Name of Representative: _____

To the best of your knowledge, does the Mayor or any member of the City Council or Planning Commission have any financial interest in this or any other property with the property owner, applicant, the property owner or applicant's general or limited partners, or an officer of their corporation or limited liability company?

☐ Yes

☒ No

If yes, please indicate the member of the City Council or Planning Commission who is involved and list the name(s) of the person or persons with whom the City Official holds an interest. Also list the Assessor's Parcel Number if the property in which the interest is held is different from the case parcel.

City Official: _____

Partner(s): _____

APN: _____


Signature of Property Owner: _____

Print Name: Robert L. Moore, As OWNER'S Representative

Subscribed and sworn before me

This 2 day of DECEMBER, 2009


Jamie J. Wingard
Notary Public in and for said County and State

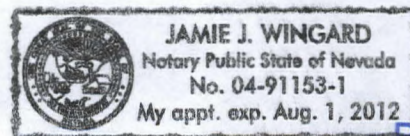

RECEIVED

DEC 04 2009

EXHIBIT "A" SITE PLAN

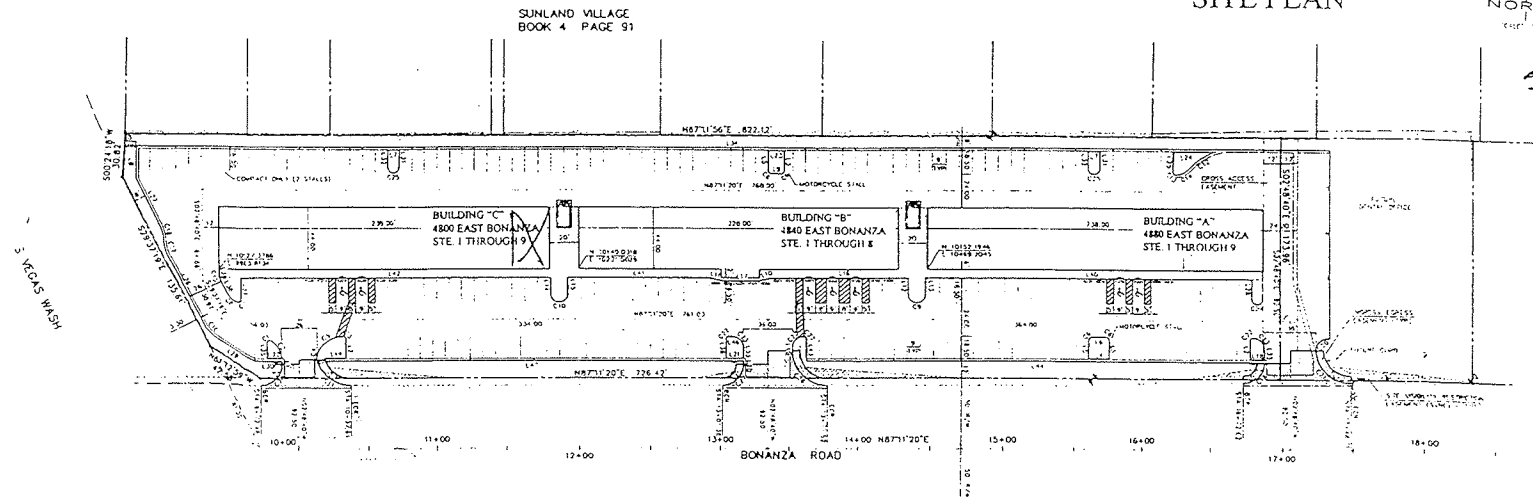

PROJECT SUMMARY

NET SITE AREA	3.14 ACRES
MAXIMUM BUILDING AREA	30,072
LAND TO BUILD RATIO	22%
PARKING REQUIRED	168
PARKING PROVIDED	228
ACCESSIBLE PARKING REQUIRED	7

PHYSICAL ADDRESS:

BUILDING "A"
4880 EAST BONANZA
STE. 1 THROUGH 9

BUILDING "B"
4840 EAST BONANZA
STE. 1 THROUGH 8


BUILDING "C"
4800 EAST BONANZA
STE. 1 THROUGH 9

SEAGULL PARK
BONANZA EAST PLAZA
LAS VEGAS, NEVADA
A COMMERCIAL PROJECT BY:
SEAGULL PARK LLC,
A NEVADA LIMITED LIABILITY COMPANY.

EXHIBIT A
SITE PLAN FOR BUSINESS RETAIL CENTER

RECEIVED

NOV 03 2009
SUP-36564
12/17/09 PC

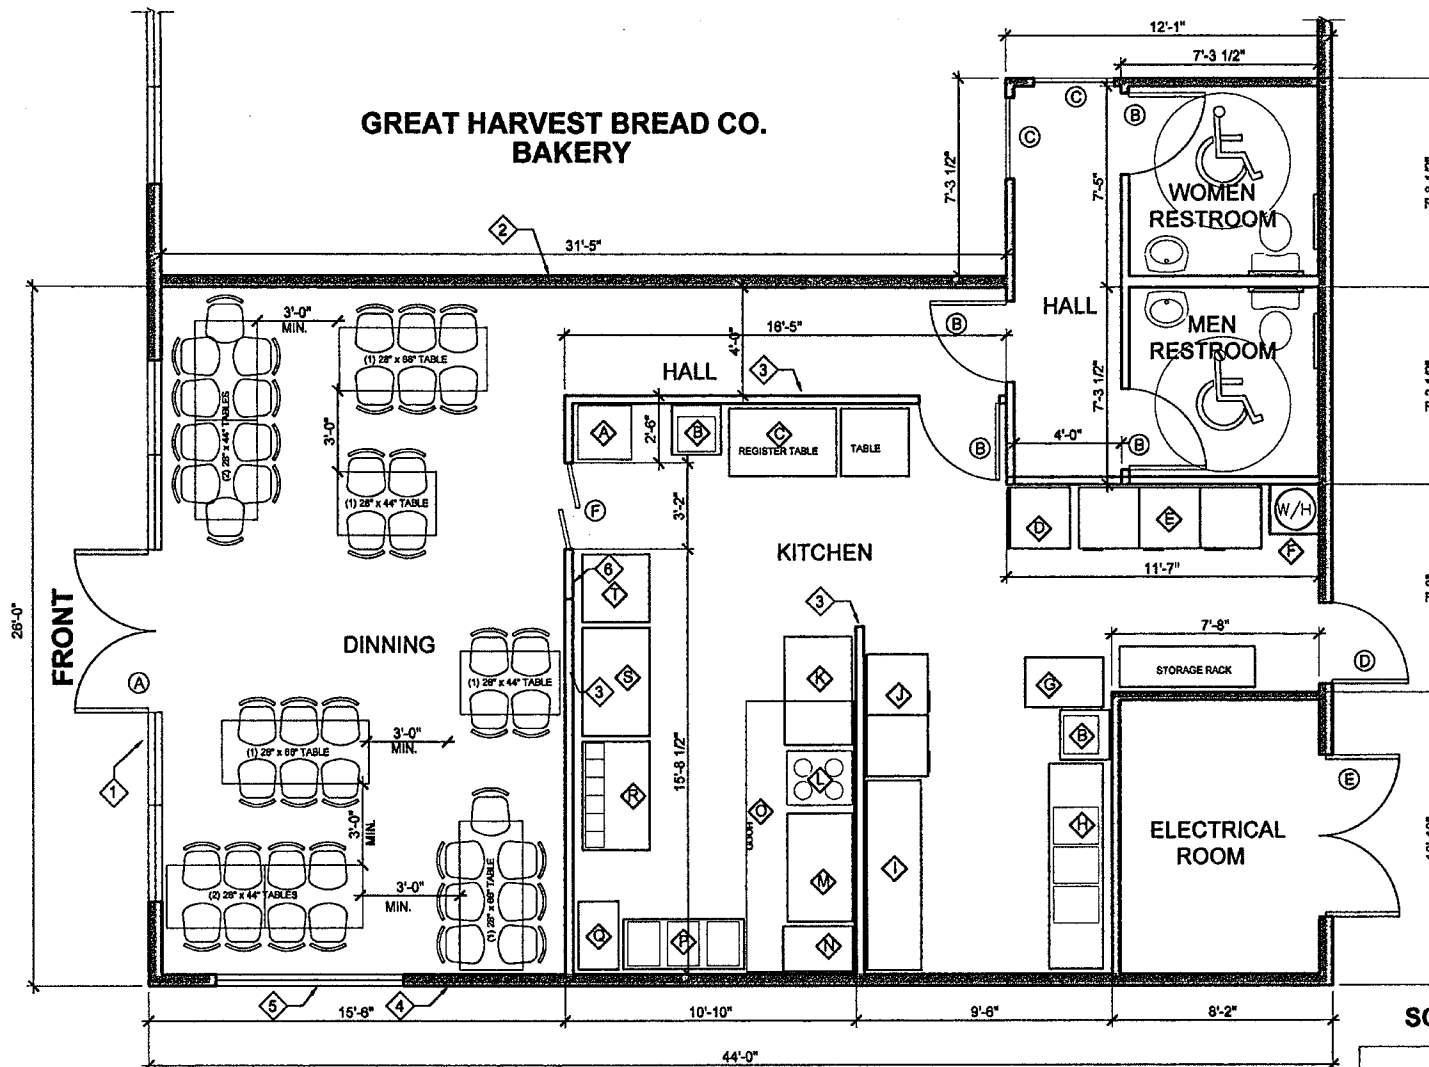

LETTER	EQUIPMENT
(A)	FOUNTAIN SODA DISPENSER
(B)	HAND SINK
(C)	REGISTER TABLE
(D)	1 GLASS DOOR COOLER
(E)	3 DOOR FREEZER
(F)	WATER HEATER
(G)	ICE MACHINE
(H)	THREE COMPARTMENTS SINK
(I)	FOOD PREPARATION TABLE
(J)	2 DOOR FREEZER
(K)	WORK TABLE
(L)	BURNER
(M)	GRILL
(N)	FRYER
(O)	HOOD (ABOVE)
(P)	FOOD WARMER
(Q)	FOOD TABLE
(R)	SANDWICH/CABINET TABLE
(S)	SANDWICH/CABINET TABLE
(T)	PLATES/ UTENSIL TABLE
(U)	CUSTOMERS SERVICE TABLE

RECEIVED
DEC 22 2009

FLOOR PLAN
SCALE: 1/4" = 1'-0"

SUP-36564
01-20-10 CC

REMARKS:
DATE BY:
#

SHEET TITLE:
FLOOR PLAN

PROJECT: TLAQUEPAQUE
PROJECT ADDRESS: 4800 E BONANZA RD. STE. 9 LAS VEGAS, NV 89119
TENANT: MARICARMEN SORIA, CELL: 702-581-1197

DATE: NOV-09
SCALE: 1/4" = 1'-0"

A1.0