



PLANNING & DEVELOPMENT DEPARTMENT

APPLICATION / PETITION FORM

Application/Petition For: _____

Project Address (Location) 3325 W. Sahara

Project Name _____ Proposed Use _____

Assessor's Parcel #(s) 162-08-103-001 Ward # _____

General Plan: existing _____ proposed _____ Zoning: existing _____ proposed _____

Commercial Square Footage _____ Floor Area Ratio _____

Gross Acres .37 Lots/Units _____ Density _____

Additional Information _____

PROPERTY OWNER Jack and Maxine Cason Family Trust Contact Jack Cason
 Address 2200 S. Highland Dr. Phone: 382-5866 Fax: 898-4308
 City LV State NV Zip 89102
 E-mail Address kopperadccim.net

APPLICANT Jasen Rensbeck Contact _____
 Address 726 Casino Ctr #210 Phone: 505-0569 Fax: 434-3332
 City LV State NV Zip 89101
 E-mail Address vegasbail@earthlink.net

REPRESENTATIVE _____ Contact _____
 Address _____ Phone: _____ Fax: _____
 City _____ State _____ Zip _____
 E-mail Address _____

Property Owner Signature* Jack Cason

*An authorized agent may sign in lieu of the property owner for Final Maps, Tentative Maps, and Parcel Maps.


Print Name Jack Cason

Subscribed and sworn before me

This 28TH day of October, 2009

Carol J. Shivers

Notary Public in and for said County and State

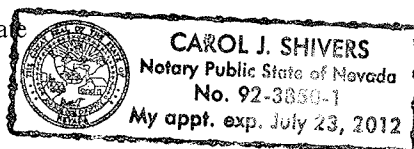

FOR DEPARTMENT USE ONLY

Case # SUP-36588
 Meeting Date: 12/17/09
 Total Fee: 1080.00
 Date Accepted: 11/4/09
 Accepted By: M REX

*The application will not be deemed complete until the submitted materials have been reviewed by the Planning and Development for consistency with applicable sections for the Zoning Ordinance.

f:\depot\Application Packet\Application Form.doc



PLANNING & DEVELOPMENT DEPARTMENT

STATEMENT OF FINANCIAL INTEREST

Case Number: **SUP-36588** APN: 142-08-103-001

Name of Property Owner: Jack and Maxine Cason Family Trust

Name of Applicant: Jasen Heisbeck

Name of Representative: _____

To the best of your knowledge, does the Mayor or any member of the City Council or Planning Commission have any financial interest in this or any other property with the property owner, applicant, the property owner or applicant's general or limited partners, or an officer of their corporation or limited liability company?

_____ Yes

_____ ☒ No

If yes, please indicate the member of the City Council or Planning Commission who is involved and list the name(s) of the person or persons with whom the City Official holds an interest. Also list the Assessor's Parcel Number if the property in which the interest is held is different from the case parcel.

City Official: _____

Partner(s): _____

APN: _____


Signature of Property Owner: Jade Cason

Print Name: Jack Cason

Subscribed and sworn before me

This 28TH day of October, 2009

Carol J. Shivers
Notary Public in and for said County and State

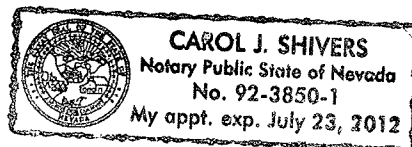


RECEIVED
NOV 04 2009

PROJECT INFORMATION

SCALE: 1/8" = 1'-0"
 PROPERTY ADDRESS: 3325 W. SAHARA AVENUE
 LAS VEGAS, NV 89102
 PROPERTY APN: 162-08-103-001
 ZONING: C-1
 PROPOSED USE: B&B FOOD SERVICE
 LOT SIZE: 14,080 SF
 BUILDING AREA: 3,288 SF

PARKING ANALYSIS

SCALE: 1/8" = 1'-0"
 PARKING REQUIRED: 1,300 SF = 11 SPACES
 PARKING PROVIDED: 10 SPACES
 (INCLUDING 1 ACCESSIBLE)

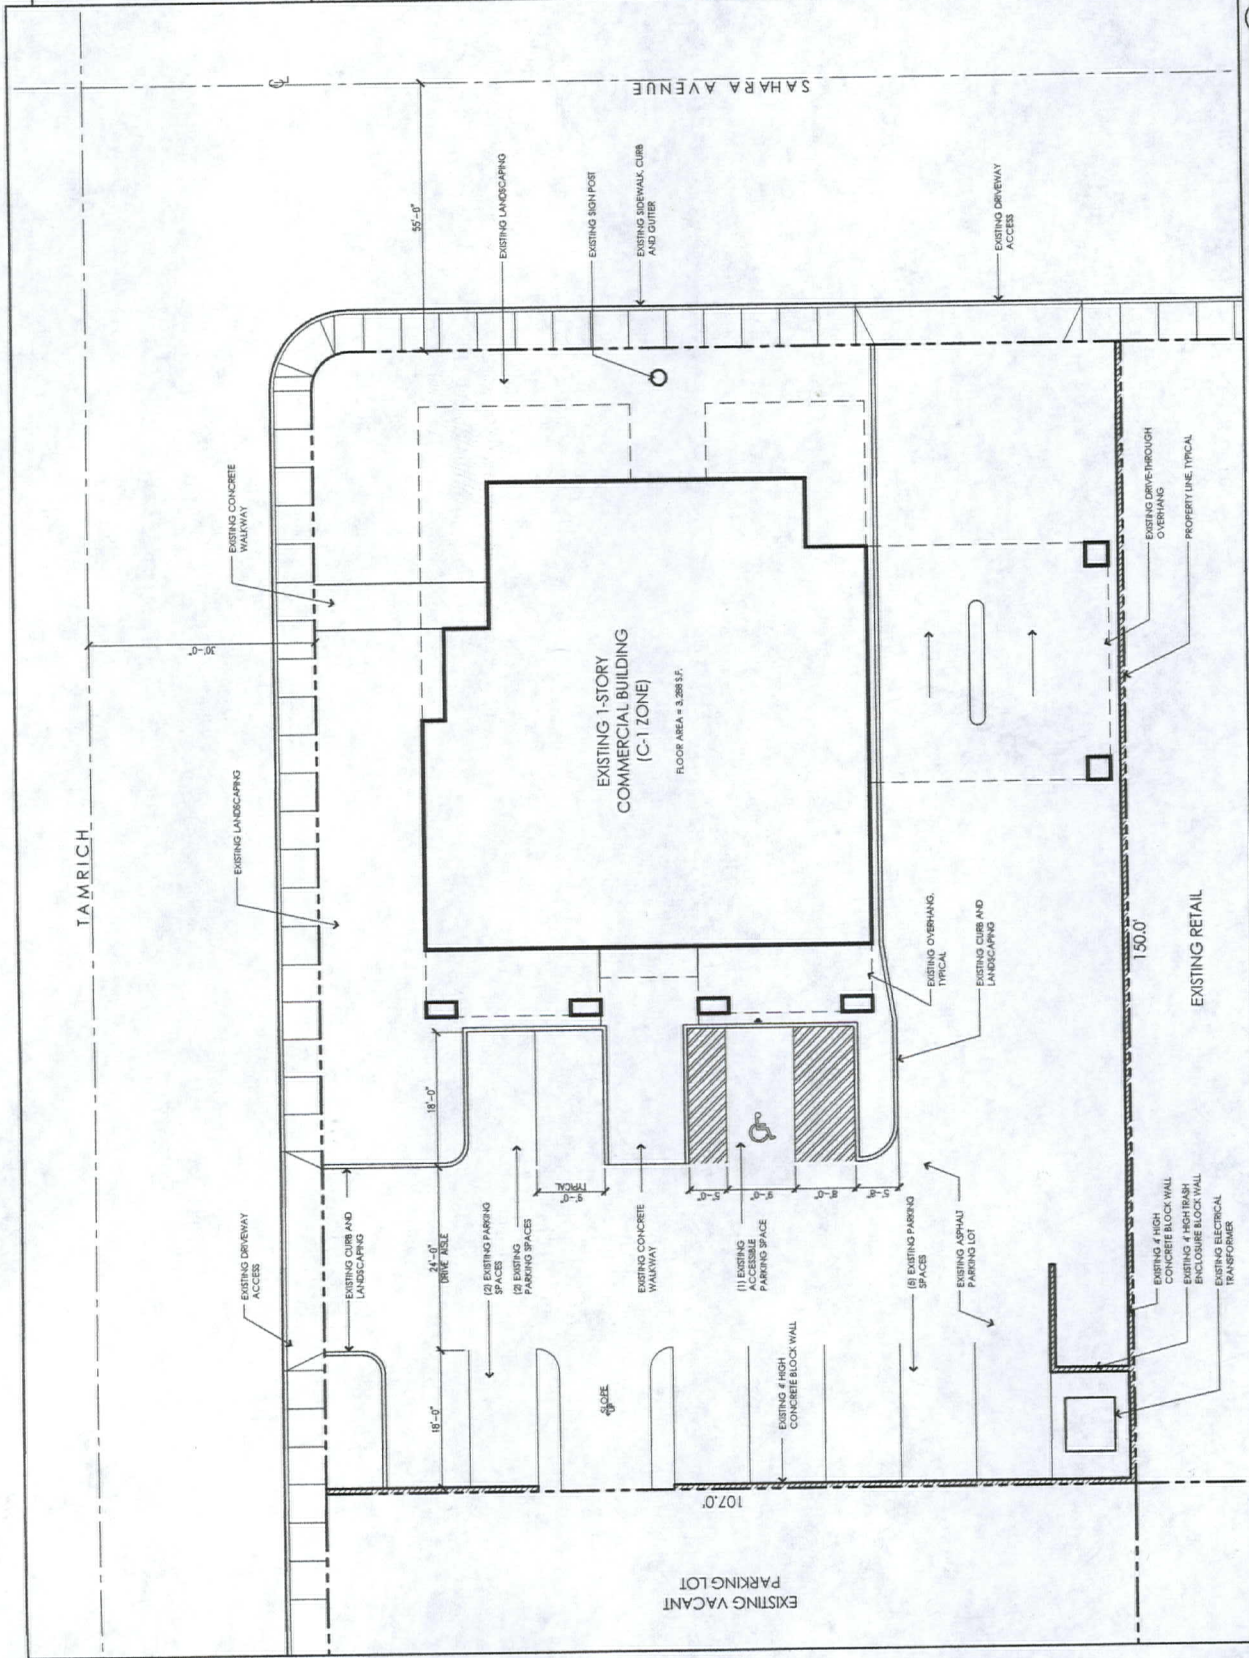


SUP-36588

REVISED

12/17/09 PC

SITE PLAN
 SCALE: 1/8" = 1'-0"

PROJECT: VEGAS BALL
 3325 W. SAHARA AVENUE
 LAS VEGAS, NEVADA 89102

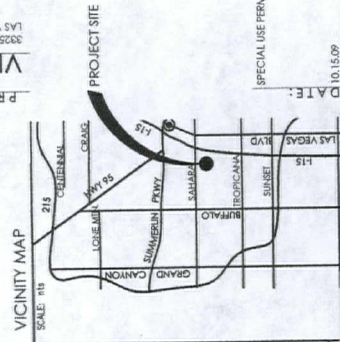

DATE: 10.15.09
 SPECIAL USE PERMIT


NOV 1 2 2009

PROJECT INFORMATION

SCALE: n/a
 PROPERTY ADDRESS: 3325 W. SAHARA AVENUE
 LAS VEGAS, NV 89102
 PROPERTY APN: 162-06-103-001
 ZONING: C-1
 PROPOSED USE: RAIL BOND SERVICE
 LOT SIZE: 14,650 SF
 BUILDING AREA: 3,268 S.F.


PARKING ANALYSIS

SCALE: 1/8" = 1'-0"
 PARKING REQUIRED: 1,300 S.F. = 11 SPACES
 PARKING PROVIDED: 11 SPACES
 (INCLUDING 1 ACCESSIBLE)

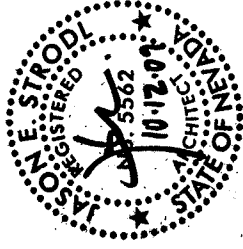

PROJECT: VEGAS BALL
 3325 W. SAHARA AVENUE
 LAS VEGAS, NEVADA 89102

VICINITY MAP

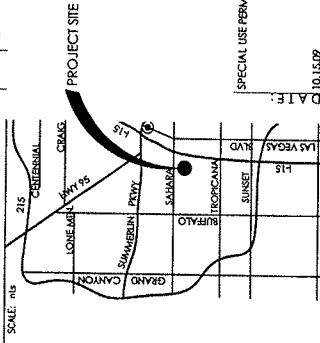


DATE: 10.13.09
 SPECIAL USE PERMIT

RECEIVED

NOV 04 2009
 SUP-36588
 12/17/09 PC

TAMRICH

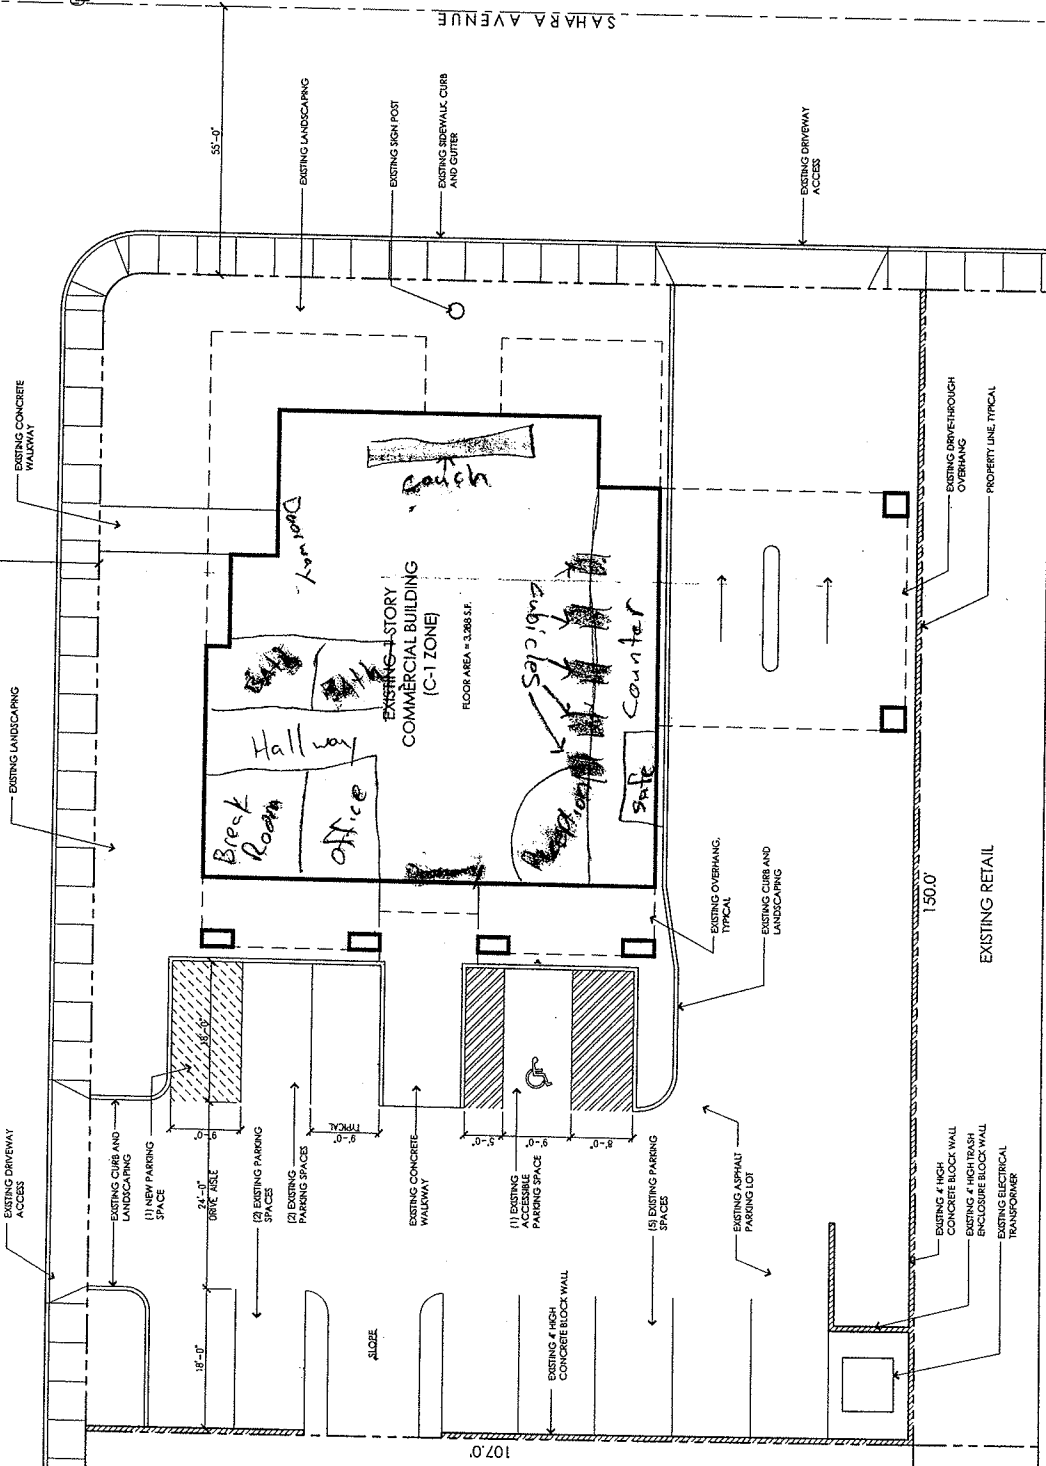

SITE PLAN

SCALE: 1/8" = 1'-0"