



PLANNING & DEVELOPMENT DEPARTMENT

STATEMENT OF FINANCIAL INTEREST

Case Number: **SUP-36961** APN: 163-06-816-015

Name of Property Owner: Winner Properties, LLC

Name of Applicant: Same

Name of Representative: Dwayne R. Eshenbaugh

To the best of your knowledge, does the Mayor or any member of the City Council or Planning Commission have any financial interest in this or any other property with the property owner, applicant, the property owner or applicant's general or limited partners, or an officer of their corporation or limited liability company?

☐ Yes

☒ No

If yes, please indicate the member of the City Council or Planning Commission who is involved and list the name(s) of the person or persons with whom the City Official holds an interest. Also list the Assessor's Parcel Number if the property in which the interest is held is different from the case parcel.

City Official: _____

Partner(s): _____


APN: _____

Signature of Property Owner: _____

Print Name: Antonio Accornero

Subscribed and sworn before me

This 26th day of January, 2010
Rhonda F. Digenaro
Notary Public in and for said County and State

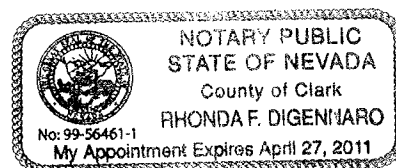

PLANNING & DEVELOPMENT DEPARTMENT

APPLICATION / PETITION FORM

Application/Petition For: Winner Properties, LLC.
 Project Address (Location) 9500 West Sahara Ave.
 Project Name Siena Italian Expansion Proposed Use Deli/ Market Addition
 Assessor's Parcel #(s) 163-06-816-015 Ward # _____
 General Plan: existing _____ proposed _____ Zoning: existing _____ proposed _____
 Commercial Square Footage _____ Floor Area Ratio _____
 Gross Acres _____ Lots/Units _____ Density _____
 Additional Information _____

PROPERTY OWNER Winner Properties, LLC Contact Joy Bustamante
 Address 9601 Orient Express Ct Phone: (213) 760-9377 Fax: _____
 City Las Vegas State NV Zip 89145
 E-mail Address _____

APPLICANT Same Contact _____
 Address _____ Phone: _____ Fax: _____
 City _____ State _____ Zip _____
 E-mail Address _____

REPRESENTATIVE Dwayne R. Eshenbaugh Contact _____
 Address 3225 Via Seranova Phone: (702) 522-9292 Fax: _____
 City Henderson State NV Zip 89044
 E-mail Address dwayne@drearchitecture.com

Property Owner Signature* _____

* An authorized agent may sign in lieu of the property owner for Final Maps, Tentative Maps, and Parcel Maps.


Print Name Antonio Accornero

Subscribed and sworn before me

This 26th day of January, 20 10.

Rhonda F. Digenaro

Notary Public in and for said County and State

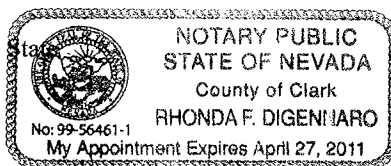

Revised 10/27/08

FOR DEPARTMENT USE ONLY

Case #	<u>SUP-36961</u>
Meeting Date:	<u>2/25/10</u>
Total Fee:	<u>1,280.00</u>
Date Received:*	<u>1/28/10</u>
Received By:	<u>[Signature]</u>

*The application will not be deemed complete until the submitted materials have been reviewed by the Planning and Development Department for consistency with applicable sections of the Zoning Ordinance.

F:\depot\Application Packet\Application Form.pdf

MASTERPLAN PARKING DATA

APN NO. 163-06-816-015

PROPERTY SIZE: 1.06 ACRES (46,174 SQUARE FEET)

EXISTING FLOOR AREA: 6,648 SF + 1,108 (PATIO) = 7,756 SF
F.A.R. (FLOOR AREA RATIO): 7.756 S.F./46,174 S.F. = 0.17%

PROPOSED FLOOR AREA: 608 SF (DINING) + 1,428 (DELI) - 293 SF (PATIO) = 2,343 SF
COMBINED TOTAL F.A.R.: 7.756 + 2.328 = 46,174 S.F. = 21%

DENSITY: N/A

PARKING ANALYSIS (TITLE 19 ZONING CODE, SECTION 19.04)

One space for each 50 S.F. of public seating and waiting area, including outdoor areas for seating and waiting, plus one space for each 200 s.f. of the total remaining gross floor area, with a minimum of 10 spaces required.

REQUIRED PARKING (ALL SPACES ARE 9'-0" X 19'-0"):

NEW WEST DINING: 608 SF (50' x 13 SPACES)

NEW EAST DELI: 1,428 SF (200' x 8 SPACES)

NEW PATIO: 293 SF (50' x 6 SPACES)

TOTAL PARKING REQUIRED FOR NEW ADDITION: 27 SPACES

EXISTING 2005 VARIANCE: 2,404 SPACES

EXISTING PARKING: 2,440 SPACES


PROPOSED NEW PARKING: 27 SPACES

REQUIRED NEW VARIANCE: 2,467 SPACES

PROJECT SITE

VILLAGE SQUARE SITE PLAN

SCALE: 1"=150'-0"

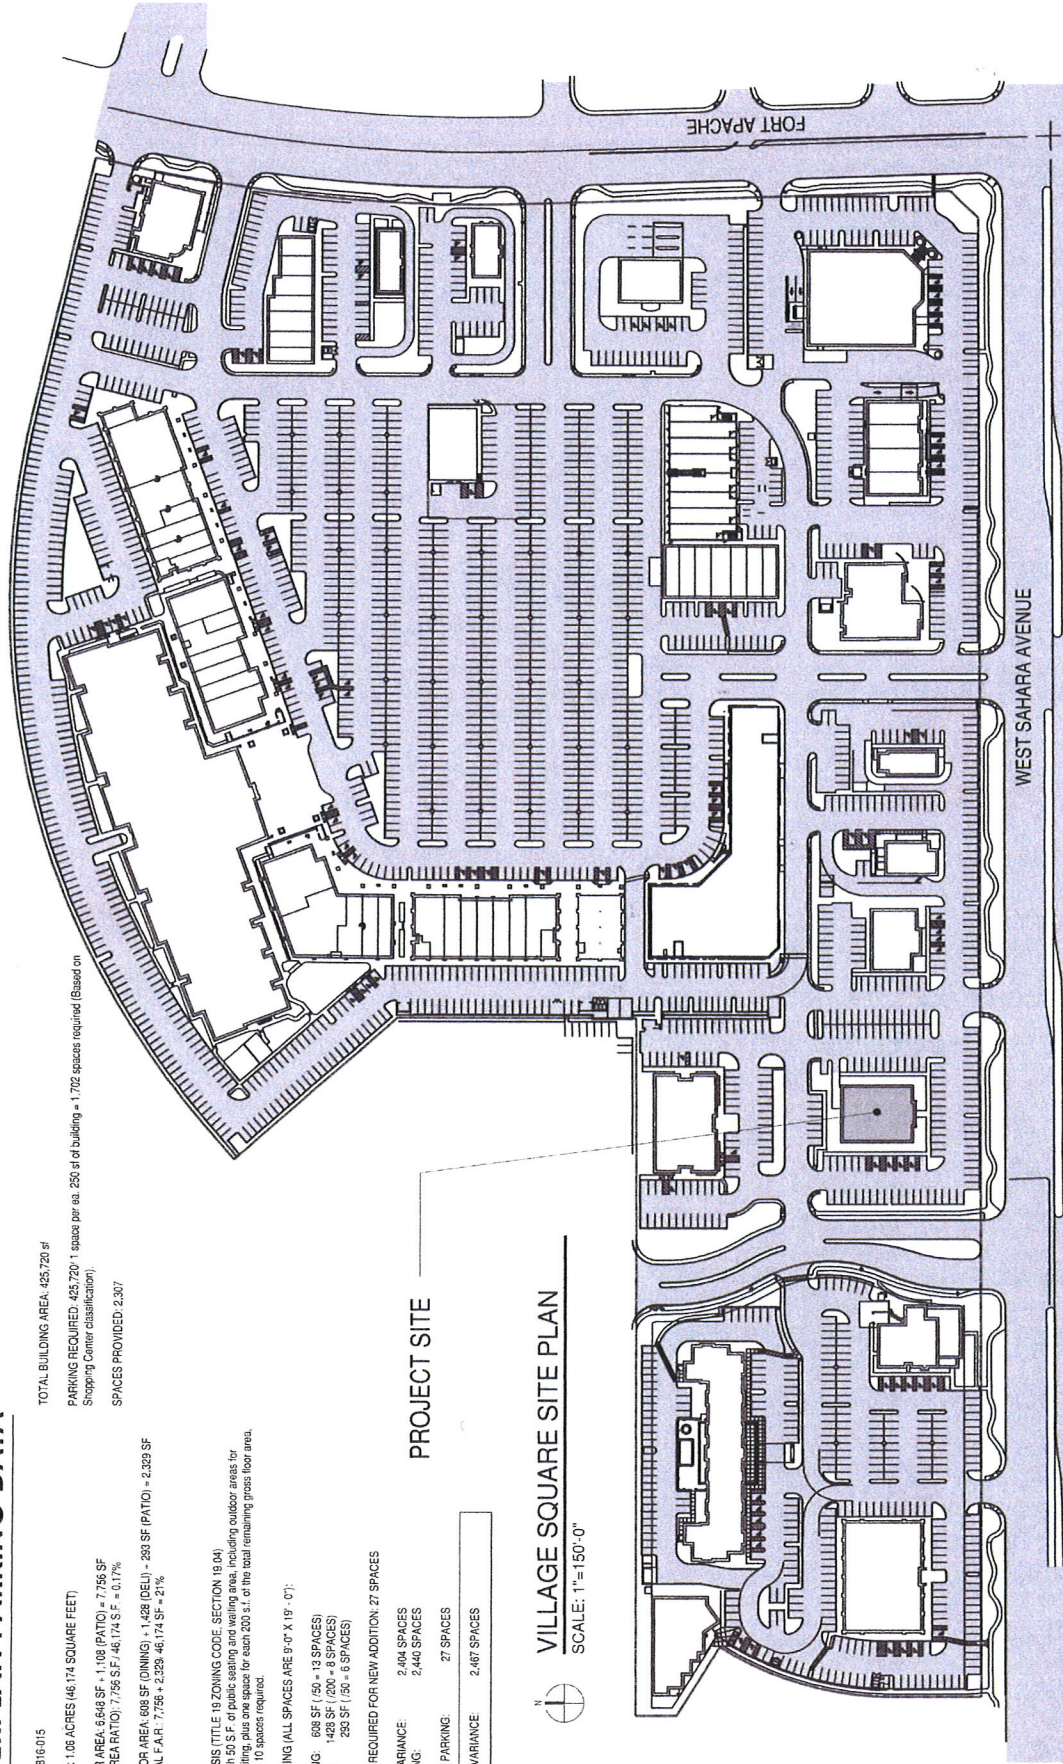



SPACES PROVIDED: 2,307

DWAYNE R. ESHENBAUGH, AIA, NCARB, LEED AP
Principal Architect

architecture | interiors | planning
CONNECT | CREATE | CULTIVATE
3225 Via Seranova | Henderson, Nevada 89044
702.522.9292 O | 702.332.7975 C

SUP-36961

02/25/10 PC

VILLAGE SQUARE
OVERALL SITE PLAN

DRAWN BY: SIENNA DELI
REVIEWED BY: 9500 West Sahara Avenue
DATE ISSUED: 1/28/2010
PROJECT NO: 02-01014


1"=150'-0"
SCALE
A1.01
NO

JAN 28 2010

RECEIVED
JAN 28 2010

PROPOSED DINING AREA
638 SF

PROPOSED REVISED PLAN

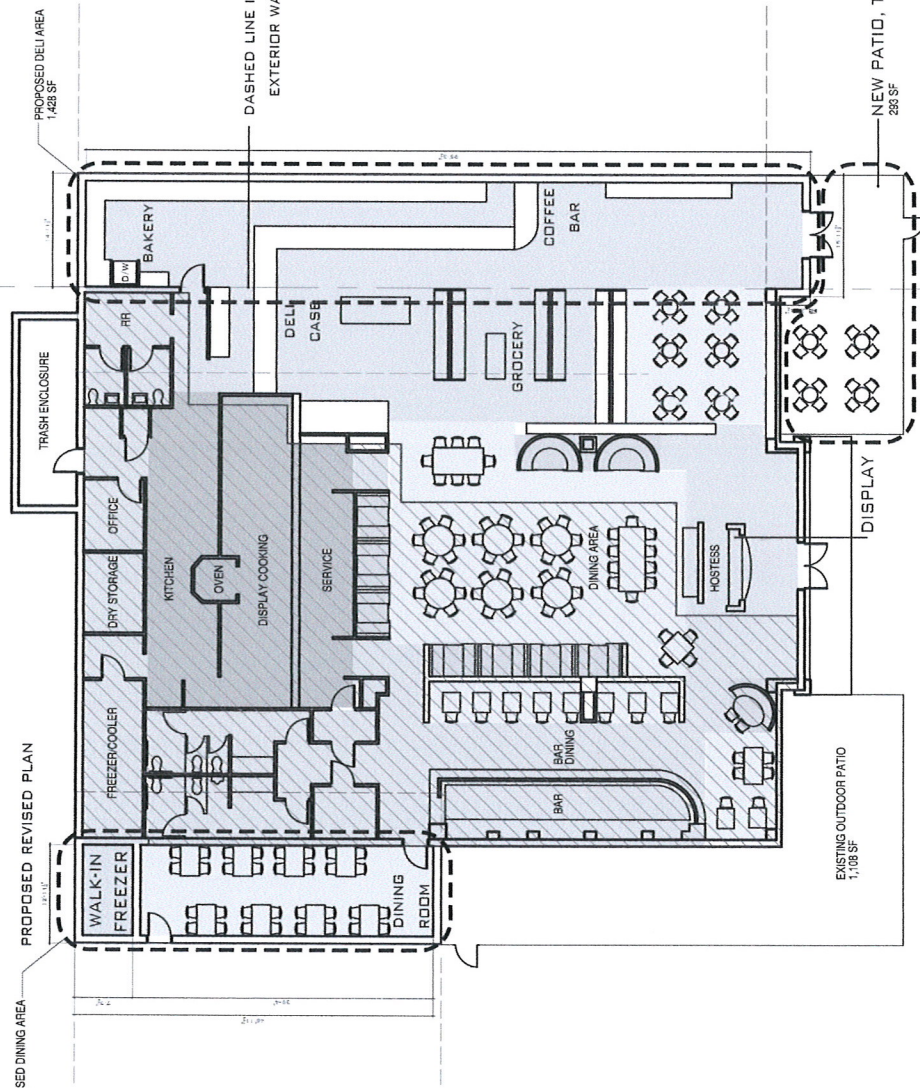

FLOOR PLAN DATA

USE AND OCCUPANCY CLASSIFICATION PER 2006 IBC SECTION 302
GROUP A-2: ASSEMBLY USES INTENDED FOR FOOD AND/OR
DRINK CONSUMPTION INCLUDING BUT NOT LIMITED TO:

- BANQUET HALLS
- NIGHT CLUBS
- RESTAURANTS
- TAVERNS AND BARS

TOTAL SQUARE FOOTAGE OF EXISTING AND PROPOSED = 6,648 +
1,108 (EXISTING PATIO) + 608 (NEW DINING) + 1,428 (NEW DELI) + 293
(NEW PATIO) = 10,085 SF

MAXIMUM ALLOWABLE FLOOR AREA ALLOWANCES PER OCCUPANT
(2006 IBC - TABLE 1004.1.1)

BUSINESS AREAS (100 GSF Floor Area Per Occupant)
4281 GSF/100 = 43 OCCUPANTS

ASSEMBLY WITHOUT FIXED SEATS (15 Net SF - Unconcentrated
2188 NSF/15 = 146 OCCUPANTS

COMMERCIAL KITCHEN (200 GSF Floor Area Per Occupant)
1071 GSF/200 = 6 OCCUPANTS

FIXED BOOTH (PER SECTION 1004.7 - 1 Occupant per 24")
1032" TOTAL SEAT LENGTH/ 24" = 43 OCCUPANTS

TOTAL OCCUPANTS: 238

MAXIMUM DINING CAPACITY: 189 OCCUPANTS
ACTUAL DINING: 183 OCCUPANTS

LEGEND

- BUSINESS AREAS
- ASSEMBLY AREAS (WITHOUT FIXED SEATS)
- COMMERCIAL KITCHEN
- FIXED BOOTH

FLOOR PLAN
SCALE: 1/16"=1'-0"



DWAYNE R. ESHENBAUGH, AIA, NCARB, LEED AP
Principal Architect

architecture | interiors | planning
CONNECT | CREATE | CULTIVATE
3225 Via Seranova | Henderson, Nevada 89044
702.522.9292 O | 702.332.7975 C

SUP-36961
02/25/10 PC

FLOOR PLAN			
DRAWN BY	3FN	SCALE	1/16" = 1'-0"
REVIEWED BY	DRE		
DATE ISSUED	1/28/2010		
PROJECT NO.	00000100		
SIENNA DELI			A3.01
9500 W. Sahara Avenue			
Las Vegas, Nevada 89115			

RECEIVED
JAN 28 2010