



PLANNING & DEVELOPMENT DEPARTMENT

STATEMENT OF FINANCIAL INTEREST

Case Number: **SUP-37383** APN: 163-04-406-004

Name of Property Owner: GWHC Nevada LLC

Name of Applicant: Cash 1

Name of Representative: Cash 1

To the best of your knowledge, does the Mayor or any member of the City Council or Planning Commission have any financial interest in this or any other property with the property owner, applicant, the property owner or applicant's general or limited partners, or an officer of their corporation or limited liability company?

☐ Yes


☒ No

If yes, please indicate the member of the City Council or Planning Commission who is involved and list the name(s) of the person or persons with whom the City Official holds an interest. Also list the Assessor's Parcel Number if the property in which the interest is held is different from the case parcel.

City Official: _____

Partner(s): _____


APN: _____

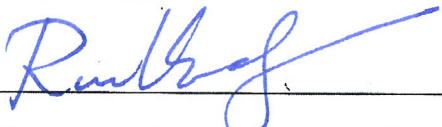
Signature of Property Owner: 

Print Name: ROBINSON LEUNG

Subscribed and sworn before me

This 3rd day of MARCH, 2010

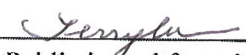
Notary Public in and for said County and State

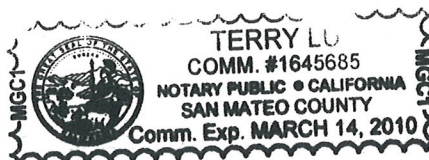

PLANNING & DEVELOPMENT DEPARTMENT

APPLICATION / PETITION FORM

Application/Petition For: SUP for an Auto Title Loan
 Project Address (Location) 8450 W. Sahara
 Project Name Cash 1 Proposed Use Auto Title Loan
 Assessor's Parcel #(s) 163-04-406-004 Ward # 2
 General Plan: existing NC proposed NC Zoning: existing C-1 proposed C-1
 Commercial Square Footage _____ Floor Area Ratio _____
 Gross Acres _____ Lots/Units _____ Density _____
 Additional Information New owners rec'd BL for auto title loan, found out there was no SUP

PROPERTY OWNER GWHC Nevada LLC Contact c/o MDL Group
 Address 3065 S. Jones Phone: (702) 388-1800 Fax: _____
 City Las Vegas State NV Zip 89146
 E-mail Address _____

APPLICANT Cash1 Contact Yesenia Rivera ☒
 Address 8450 W. Sahara #114 Phone: (702) 234-9555 Fax: _____
 City Las Vegas State NV Zip 89117 ☒
 E-mail Address yesenia@cash1loans.com

REPRESENTATIVE Cash1 Contact Yesenia Rivera ☒
 Address 8450 W. Sahara #114 Phone: (702) 234-9555 Fax: _____
 City Las Vegas State NV Zip 89117 ☒
 E-mail Address yesenia@cash1loans.com

Property Owner Signature* *Robinson Leung*

* An authorized agent may sign in lieu of the property owner for Final Maps, Tentative Maps, and Parcel Maps.

Print Name ROBINSON LEUNG


Subscribed and sworn before me

This 3rd day of MARCH, 20 10.

Terry Lu

Notary Public in and for said County and State

Revised 10/27/08

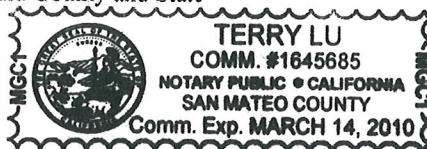

FOR DEPARTMENT USE ONLY

Case #
Meeting Date:
Total Fee:
Date Received:*
Received By:

*The application will not be deemed complete until the submitted materials have been reviewed by the Planning and Development Department for consistency with applicable sections of the Zoning Ordinance.


f:\depot\Application Packet\Application Form.pdf

GENERAL NOTE:

1. DETAILS 1, 2 & 3 ARE ALTERNATE TO ROOF OVERFLOW DRAINAGE AS SHOWN IN DETAIL 8/A-1.
2. SEE DETAIL 8/A-1 FOR GENERAL WALL NOTES & CONDITIONS (GALLER).

KEY NOTES:

1. ROOF DRAIN (CONCRETE POND) SCALE: 1/4" = 1'-0"
6. GALT
7. FLASH FLOR
8. CONC. WALK
9. ROOF DRAIN LEADER TO DOWNSPOUT AT EDGE OF CONC. WALK

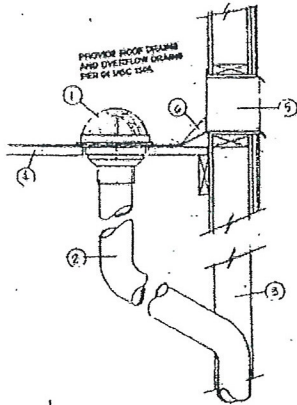

DET. 1

SCALE 1/4" = 1'-0"

DET. 2

DET. 3


CONSTRUCTION DATA

OCCUPANCY (MIXED) — GROUP B & GROUP M
 CONSTRUCTION TYPE — Y-M WITH AUTOMATIC FIRE EXTINGUISHING SPRINKLERS
 ALLOWABLE AREA — 8,000 S.F. & 2 SIDES @ 2-1/2" X 20" = 50 X OR 12,000 S.F. & 3 (AUTOMATIC SPRINKLER SYSTEM) = 36,000 S.F. ALLOWABLE AREA
 BUILDING AREA PROVIDED = 29,250 S.F.
 NO SEPARATION REQUIRED FOR MIXED OCCUPANCY GROUP B AND GROUP M AS PER TABLE J-8, 1994 U.S.C.

SITE DATA

ZONING — C-1
 LOT AREA — 60,160 S.F. NET
 BUILDING AREA — 29,250 S.F.
 LOT COVERAGE — 36%
 PARKING PROVIDED — 29,250 S.F. @ 295 S.F./CAR = 99 PARKING SPACES



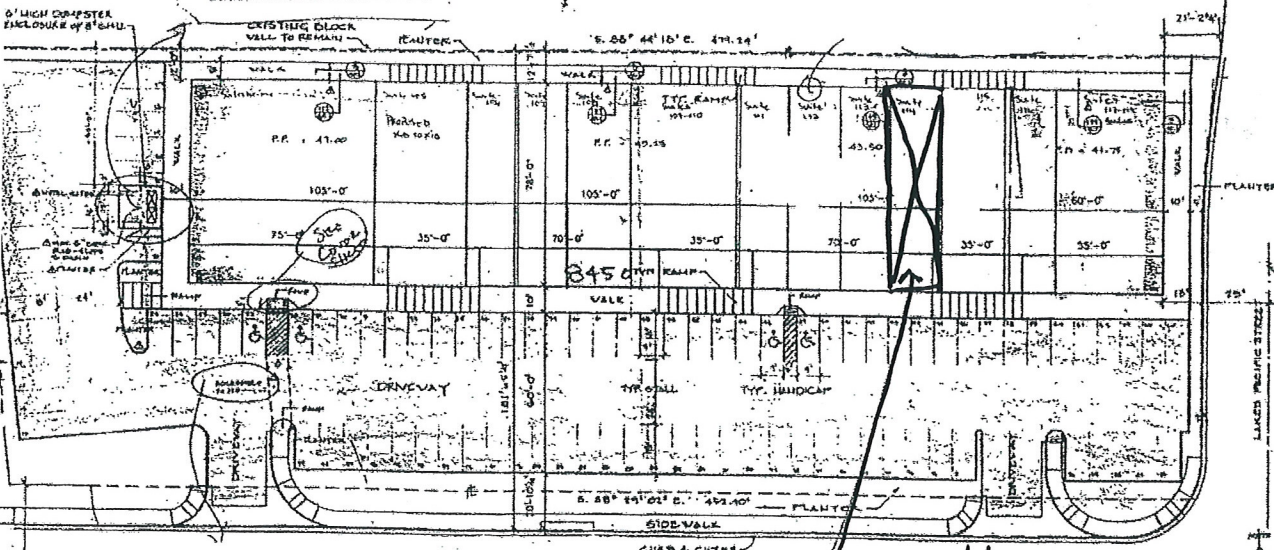

along W. Sahara Ave. #114

subject property

SITE PLAN



ROBERT B. BALL,
 ARCHITECT
 2700 NORTH 3RD STREET, S.C. 2010
 LAS VEGAS, NEVADA 89102
 PH. (702) 398-4045

PACIFIC LAKES
 BUSINESS CENTER
 LAS VEGAS, NEVADA


SITE PLAN
 1" = 20'-0"

JOB NUMBER
 1594
 DRAWING DATE
 10/10/98
 REVISIONS
 10/17/98
 11/15/98
 1/15/99

SHEET NUMBER
 SP-1

RECEIVED
 FEB 09 2010

SUP-37383
 03/25/10 PC

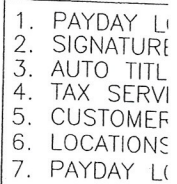

SUP-37383
03/25/10 PC

FEB 09 2010