PLANNING & DEVELOPMENT DEPARTMENT

STATEMENT OF FINANCIAL INTEREST

Case Number: **SDR-37363** APN: 162-06-502-003

Name of Property Owner: LIED FOUNDATION TRUST

Name of Applicant: LIED FOUNDATION TRUST

Name of Representative: BARRY W. BECKER

To the best of your knowledge, does the Mayor or any member of the City Council or Planning Commission have any financial interest in this or any other property with the property owner, applicant, the property owner or applicant's general or limited partners, or an officer of their corporation or limited liability company?

_____ Yes __X__ No

If yes, please indicate the member of the City Council or Planning Commission who is involved and list the name(s) of the person or persons with whom the City Official holds an interest. Also list the Assessor's Parcel Number if the property in which the interest is held is different from the case parcel.

City Official: _____

Partner(s): _____ _____

APN: _____

RECEIVED
FEB 08 2010

Signature of Property Owner: Christina M. Hixson

Print Name: LIED FOUNDATION TRUST
CHRISTINA M. HIXSON, TRUSTEE

Subscribed and sworn before me

This 2ND day of FEBRUARY, 2010

Dennis H. Smith
Notary Public in and for said County and State

DENNIS H. SMITH
NOTARY PUBLIC
STATE OF NEVADA
My Commission Exp. June 22, 2012
Commission No: 92-3295-1

PLANNING & DEVELOPMENT
DEVELOPMENT SERVICES CENTER

PLANNING & DEVELOPMENT DEPARTMENT

APPLICATION / PETITION FORM

Application/Petition For: Review of Landscape & Modification request

Project Address (Location) 3889 W. CHARLESTON BLVD, LAS VEGAS, NV
for 3901 W. CHARLESTON BLVD.

Project Name _____ **Proposed Use** _____

Assessor's Parcel #(s) 162-06-502-003 **Ward #** _____

General Plan: existing _____ proposed _____ **Zoning:** existing _____ proposed _____

Commercial Square Footage _____ **Floor Area Ratio** _____

Gross Acres 2.81 **Lots/Units** _____ **Density** _____

Additional Information _____

PROPERTY OWNER LIED FOUNDATION TRUST **Contact** CHRISTINA M. HIXSON
Address 3907 WEST CHARLESTON BLVD **Phone:** 878-1559 **Fax:** 878-6469
City LAS VEGAS **State** NV **Zip** 89102
E-mail Address N/A

APPLICANT LIED FOUNDATION TRUST **Contact** CHRISTINA M. HIXSON
Address 3907 WEST CHARLESTON BLVD **Phone:** 878-1559 **Fax:** 878-6469
City LAS VEGAS **State** NV **Zip** 89102
E-mail Address N/A

REPRESENTATIVE BARRY W. BECKER **Contact** BARRY W. BECKER
Address 50 So. JONES BLVD **Phone:** 870-0212 EXT 6530 **Fax:** 870-4976
City LAS VEGAS **State** NV **Zip** 89108
E-mail Address _____

Property Owner Signature* Christina M. Hixson

*An authorized agent may sign in lieu of the property owner for Final Maps, Tentative Maps, and Parcel Maps.

Print Name LIED FOUNDATION TRUST, CHRISTINA M. HIXSON TRUSTEE

Subscribed and sworn before me

This 2ND day of FEBRUARY, 2010.

Dennis H. Smith
Notary Public in and for said County and State

DENNIS H. SMITH
NOTARY PUBLIC
STATE OF NEVADA
My Commission Exp. June 22, 2012
Commission No: 92-3295-1

RECEIVED
FEB 08 2010

FOR DEPARTMENT USE ONLY

Case #	SDR-37363
Meeting Date:	03/25/10
Total Fee:	$1030.00
Date Received:*	02/08/10
Received By:	Jonathan B.

*The application will not be deemed complete until the submitted materials have been reviewed by the Planning and Development Department for consistency with applicable sections of the Zoning Ordinance.

W.O.#:	0000
DATE:	1/05/2010
BY:	JRA
SCALE:	30'
SHEET	1 OF

PRELIMINARY LANDSCAPE PLAN
FOR
CHARLESTON/VALLEY VIEW

RECEIVED
MAR 04 2010

SDR-37363
REVISED
03/25/10 PC

INDEX OF DRAWINGS

ARCHITECTURAL:

1.1 SITE PLAN, INDEX, GEN'L NOTES
2.1 FLOOR PLAN
2.2 FOUNDATION PLAN
2.3 EXT. ELEVATION
2.4 EXT. ELEV. DOOR SCHED. DETS.
2.5 REFLECTED CLG. PLAN
3.1 ROOF FRAMING, AIR COND'G.
4.1 BUILDING SECT., INT. ELEVS.
5.1 CONST. DETS.
6.1 PLUMBING PLAN
7.1 ELECT. PLAN & FIXTURES
7.2 ELECT. SYMBOLS & SCHEDULES
8.1 SPECIFICATIONS

GENERAL NOTES & SITE PLAN NOTES

1. ALL CONSTRUCTION TO BE EQUAL TO OR EXCEED MINIMUM REQUIREMENTS OF CURRENT EDITIONS OF UNIFORM BUILDING CODE, UNIFORM PLUMBING CODE, NATIONAL ELECTRICAL CODE, & LOCAL AGENCIES.
2. ALL MATTERS RELATING TO THE USE OR INTERPRETATION OF THESE VARIOUS DRAWINGS, THE ARCHITECT'S WRITTEN APPROVAL OR STATEMENT SHALL BE CONSIDERED FINAL.
3. CONTRACTOR TO PROVIDE COMPLETE, OPERABLE, AUTOMATIC WATERING SYSTEM TO ALL PLANTS AND PLANTED AREAS. SYSTEM TO BE OF SUFFICIENT SIZE & CAPACITY TO SUPPLY NORMAL PLANT GROWTH IN ALL PLANTED AREAS AS SHOWN ON SHT. 1.1.
4. ALL RADII @ PLANTERS TO BE 3'-0 U.O.N.
5. 2" A.C. TO BE ROLLED OVER 6" PEA GRAVEL OVER CLEAN COMPACT BASE OF TYPE I OR BETTER.
6. PROVIDE NEW SEAL COAT AND STRIPING OVER EXISTING ASPHALT CONC. PAVING.
7. TYP. 8'-6"x20' STALLS W/4" PAINT STRIPES.
8. CONT. 6" CONC. BUMPER CURB.
9. 6" CONC. PLANTER CURB
10. EXISTING CURB CUT TO REMAIN
11. DIRECTION ARROW PAINTED ON A.C. (UNLESS LARGER SIZE AS INDICATED BY PLAN)
12. PYLON SIGN BY SIGN CO.
13. 4'-0 & 4' CONC. WALK
14. EXISTING LIGHT TO BE RELOCATED
15. NEW LIGHTING TO MATCH EXISTING

LANDSCAPE NOTES: ALSO SEE (5) ABOVE

1. PFITZER JUNIPERS, 5 GAL. @ 6'-0 O.C.
   MULTI-COLORED TRAILING GAZANIA GROUND COVER FROM FLATS @ 6"-8" O.C.

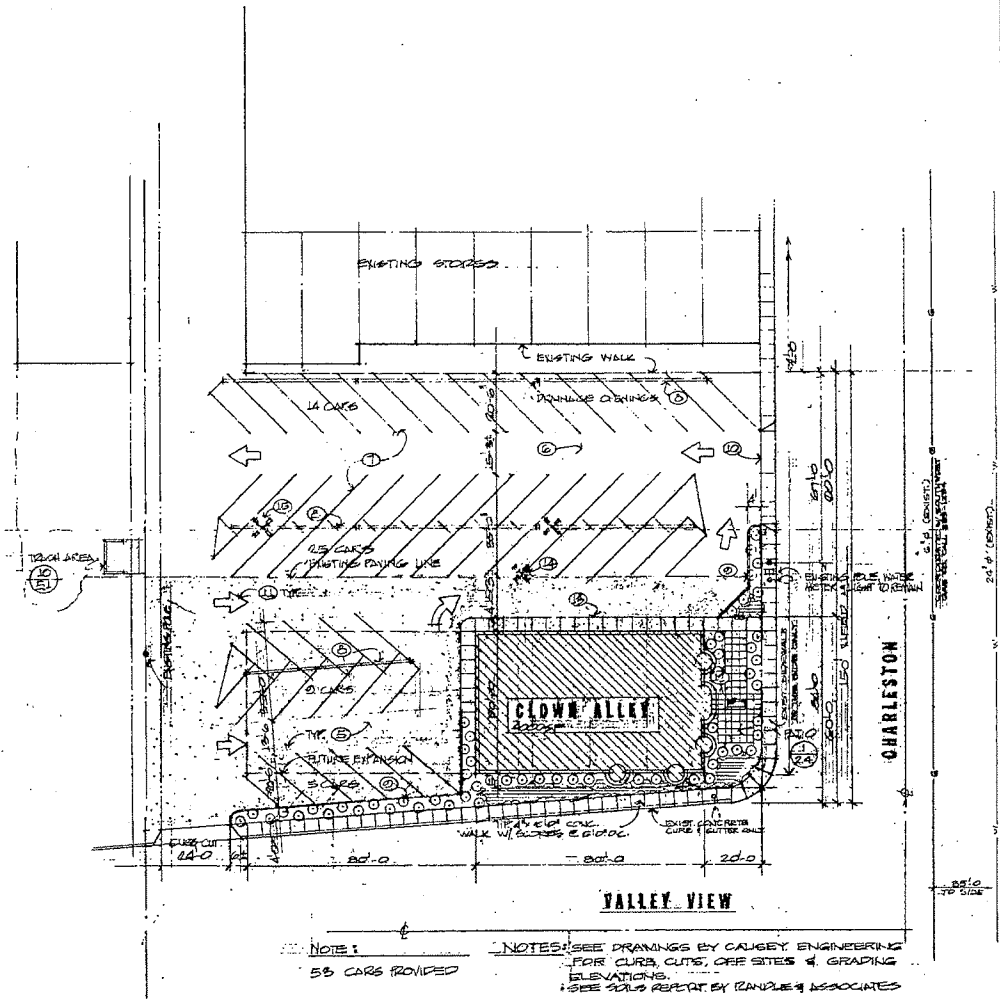

NOTE:

NOTES: SEE DRAWINGS BY CAUSEY ENGINEERING FOR CURB CUTS, OFF SITES & GRADING ELEVATIONS.
SEE SOILS REPORT BY RANDLE & ASSOCIATES
SEE JOB SITE FOR CLEANING

SITE PLAN
SC 1"=20'-0
10/15/78

SEE STRUCTURAL CALCS BY I.L.D. BRZANSKI, P.E.

APPROVED LANDSCAPING PLAN
Department of Community Planning & Development

GARY G. WILSON
REGISTERED
No. 546
STATE OF NEVADA

FEB 9 1979

SDR-37363
REVISED
03/25/10 PC

THIS DWG. IS AN INSTR. OF SVC. REPRODUCTION & PUBLICATION RESERVED TO ARCH. & HIS CLIENT. ALL RIGHTS RESERVED ©

GARY GUY WILSON, A.I.A.
ARCHITECT - PLANNER - INTERIOR
3365 SOUTH RAINBOW BLVD.
LAS VEGAS, NEVADA 89102
(702) 876-1643

PROJECT: COMMERCIAL BLDG.
LOT: VALLEY VIEW & CHARLESTON
LAS VEGAS, NEVADA

PROJECT NO. 7811
DATE 10/15/78
SCALE
APPD. BY
SHEET NO. K1

A.P. 3901 W. Charleston

INDEX OF DRAWINGS

ARCHITECTURAL:

1.1 SITE PLAN, INDEX GEN'L NOTES
2.1 FLOOR PLAN
2.2 FOUNDATION PLAN
2.3 EXT. ELEVATION
2.4 EXT. ELEV. DOOR SCHED DETS.
2.5 REFLECTED CLG. PLAN

3.1 ROOF FRAMING, AIR COND'G.

4.1 BUILDING SECT., INT. ELEVS.
5.1 CONST. DETS.
6.1 PLUMBING PLAN.

7.1 ELECT. PLAN & FIXTURES
7.2 ELECT. SYMBOLS & SCHEDULES
8.1 SPECIFICATIONS

GENERAL NOTES:

1. ALL CONSTRUCTION TO BE EQUAL TO OR EXCEED MINIMUM REQUIREMENTS OF CURRENT EDITIONS OF UNIFORM BUILDING CODE, UNIFORM PLUMBING CODE, NATIONAL ELECTRICAL CODE, & LOCAL AGENCIES.
2. ALL MATTERS RELATING TO THE USE OR INTERPRETATION OF THESE VARIOUS DRAWINGS, THE ARCHITECTS WRITTEN APPROVAL OR STATEMENT SHALL BE CONSIDERED FINAL.
3. CONTRACTOR TO PROVIDE COMPLETE, OPERABLE AUTOMATIC WATERING SYSTEM TO ALL PLANTS INCL. PLANTED AREAS. SYSTEM TO BE OF SUFFICIENT SIZE & CAPACITY TO SUSTAIN NORMAL PLANT GROWTH IN ALL PLANTED AREAS AS SHOWN ON SHT. 1.1.
4. ALL RADII @ PLANTERS TO BE 2'-0 U.O.N.
5. 2" A.C. TO BE ROLLED OVER 6" PEA GRAVEL OVER CLEAN COMPACT BASE OF TYPE I OR BETTER.

PROJECT DATA:

1. BLOCK:
2. PRESENT ZONING:
3. PARKING REQ'D:
4. PARKING PROVIDED: 54 CARS
5. HGHT:
6. SETBACKS REQ'D: ZERO
7. 100 FT. = 4,000 S.F.
8. U.B.C. DATA: 1976 EDITION

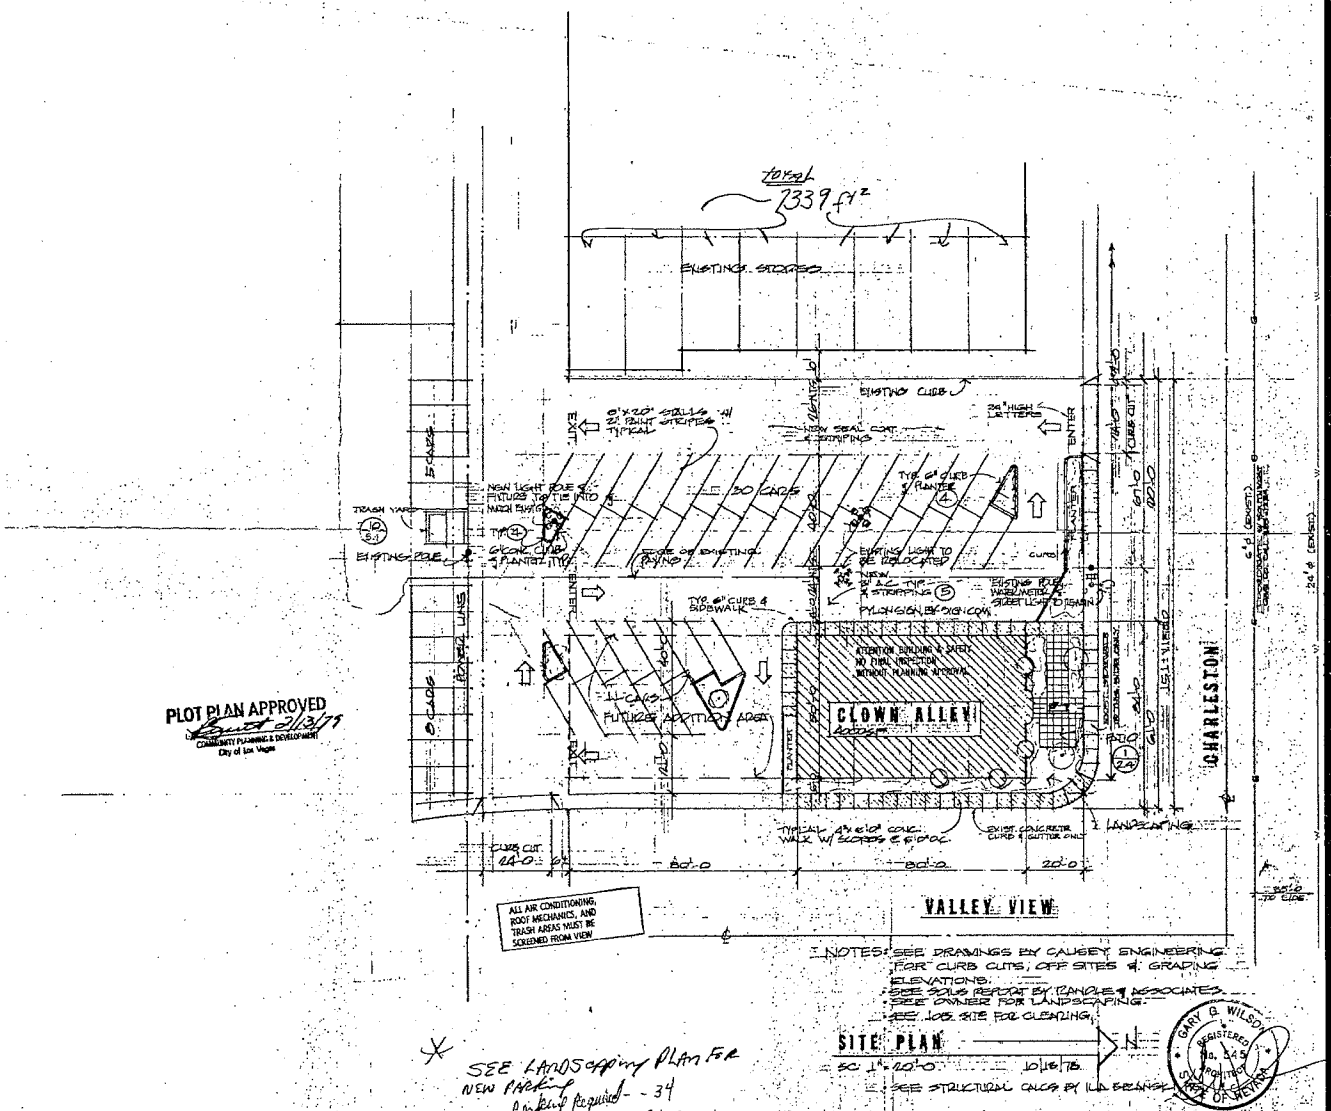

PLOT PLAN APPROVED
Date 3/3/78
COMMUNITY PLANNING & DEVELOPMENT
City of Las Vegas

NOTES:
1. SEE DRAWINGS BY CAUSEY ENGINEERING FOR CURB CUTS, OFF SITES & GRADING ELEVATIONS.
2. SEE SOILS REPORT BY RANDLE & ASSOCIATES.
3. SEE OWNER FOR LANDSCAPING.
4. SEE 105 SITE FOR CLEARING.

SITE PLAN
SC 1"=20'-0" 10/16/78

SEE STRUCTURAL CALCS BY I.L.D. BRENNER


* SEE LANDSCAPING PLAN FOR NEW PARKING
Parking Required - 34
Parking Furnished - 38

SDR-37363
REVISED
03/25/10 PC