


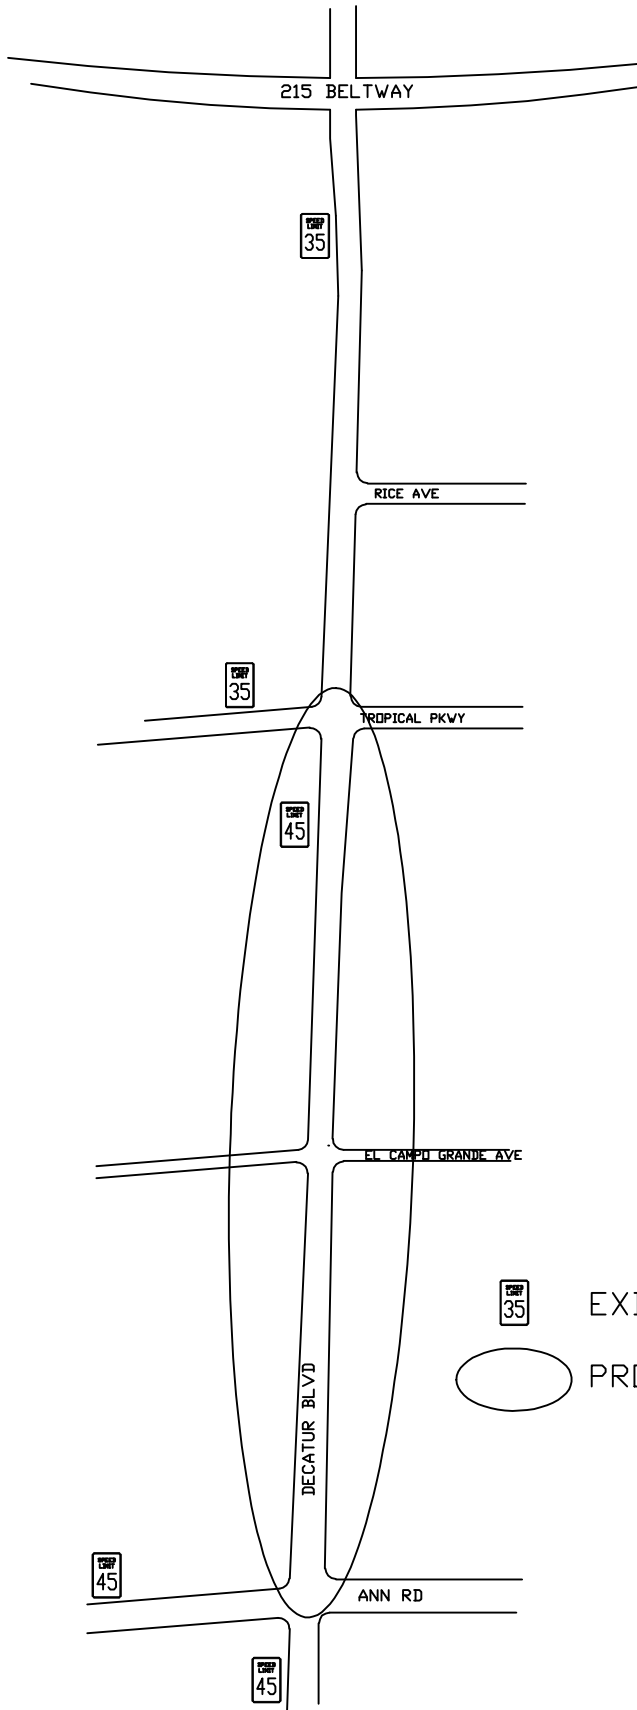

EXISTING SPEED LIMIT SIGNS



PROPOSED SPEED LIMIT CHANGE