


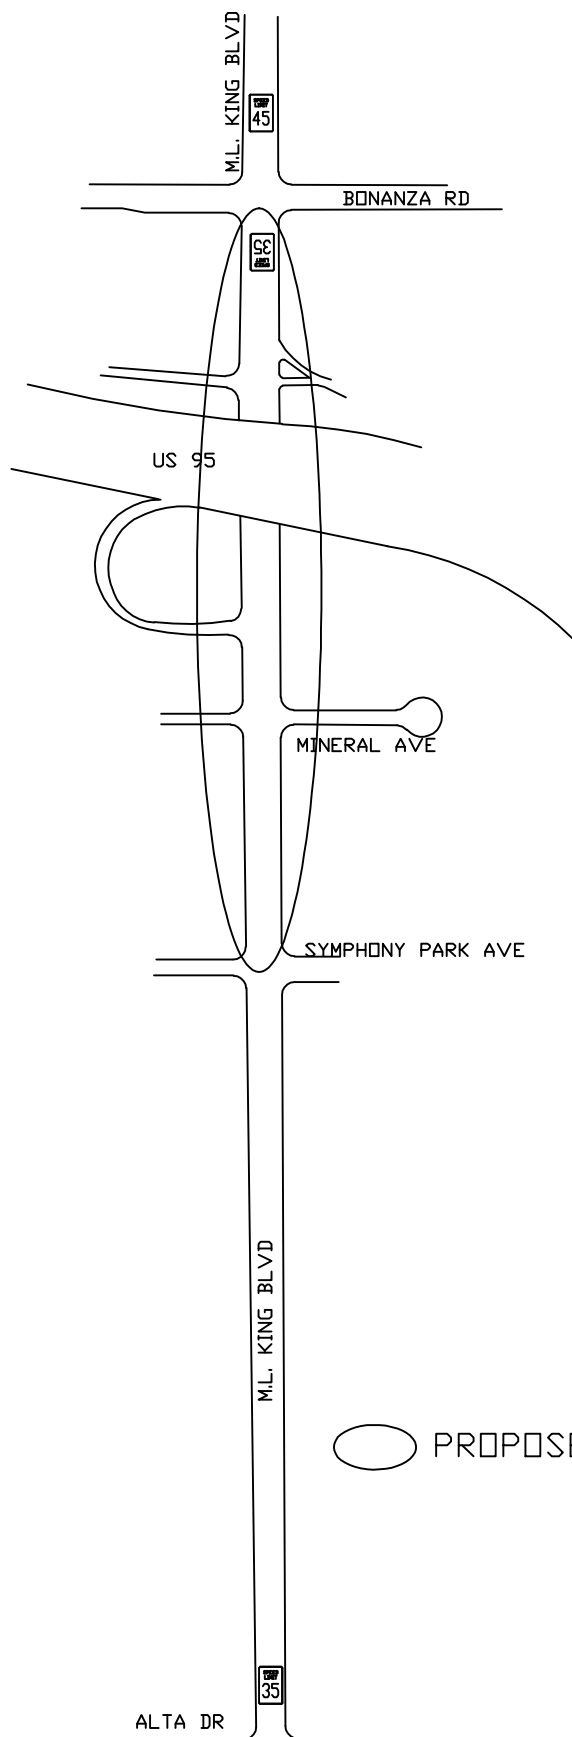

○ PROPOSED AREA FOR SPEED CHANGE