


PROPOSED SPEED LIMIT CHANGE



EXISTING SPEED LIMIT SIGNS

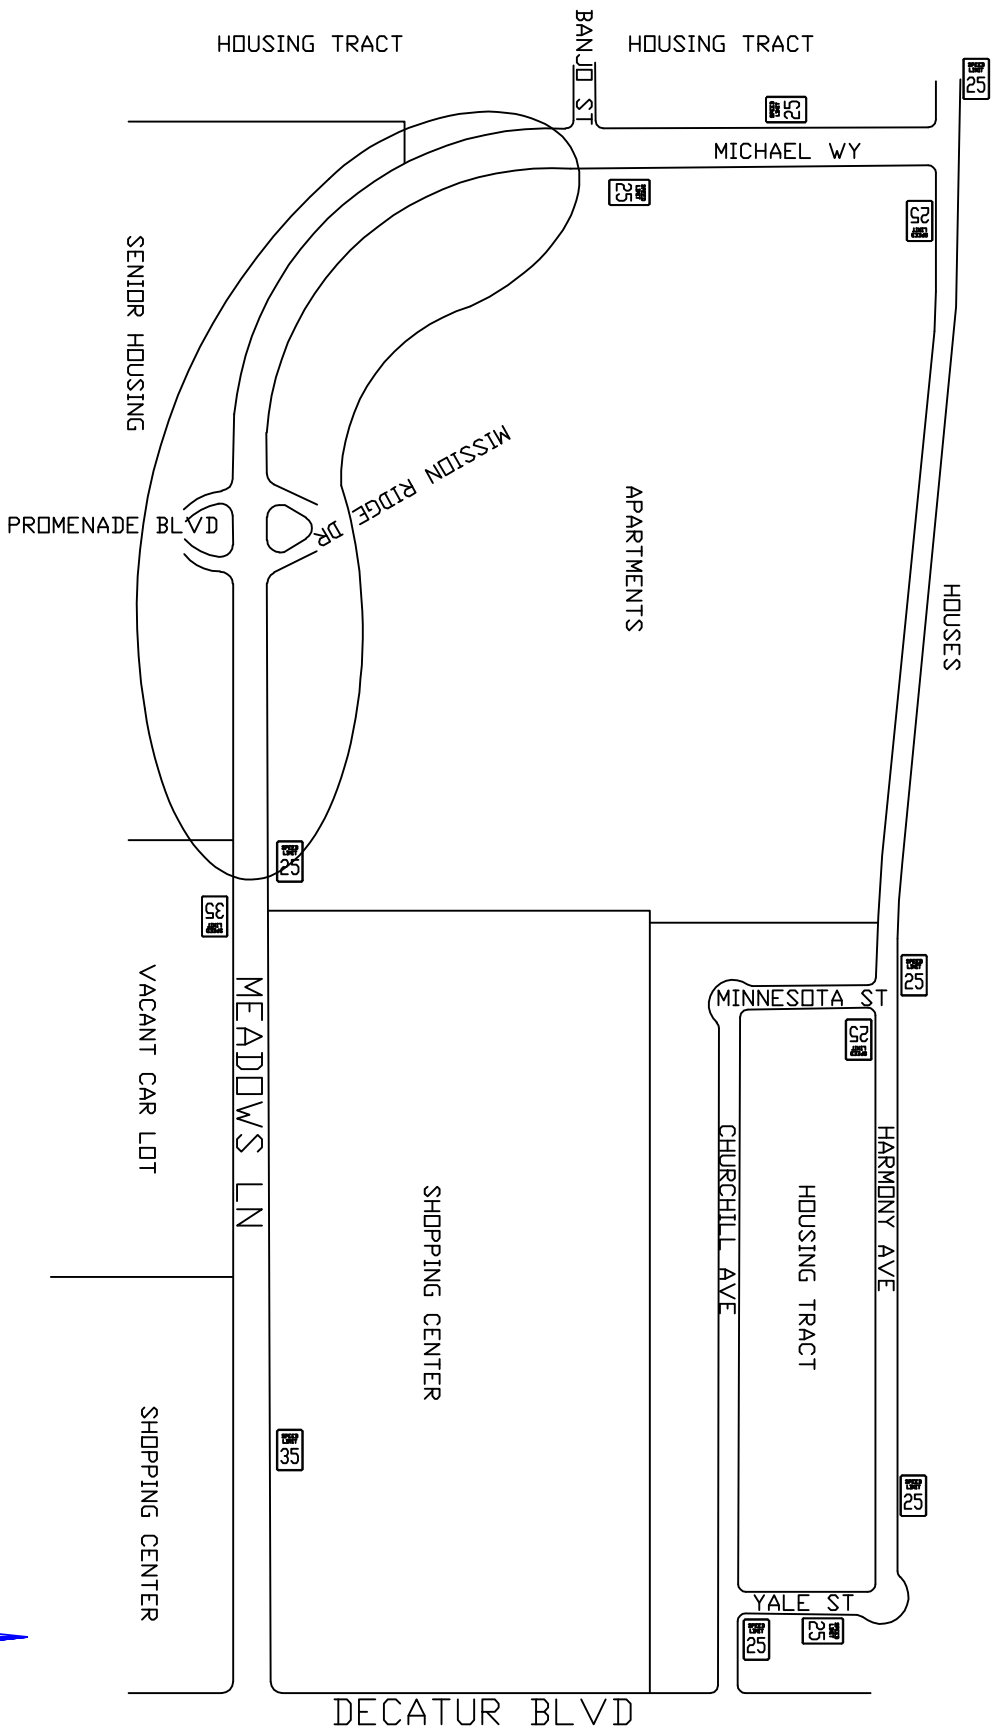