


**NOTE: THE FOLLOWING DOCUMENTATION
WAS SUBMITTED FOR THE RECORD BEFORE
OR AT THE PLANNING COMMISSION HEARING
ON THIS ITEM WHICH IS NOW APPEARING
BEFORE THE CITY COUNCIL**

PROJECT DATA:

ASSESSORS PARCEL NUMBER(S)	135-34-344-0006 135-34-344-0007 135-34-344-0008 135-34-346-0005
ACTION REFERENCE NUMBER(S)	-
GOVERNING JURISDICTION	CITY OF LAS VEGAS
DEVELOPMENT	GENERAL COMMERCIAL DISTRICT (C-4)
EXISTING LAND USE / ZONE	GENERAL COMMERCIAL DISTRICT (C-4)
ZONING OVERLAP AT DISTRICT(S)	N/A
LAND USE PLAN	DONTON CENTENNIAL GATEWAY DISTRICT
SITE AREA	3.94 ACRES / 171,888.50 SF
BUILDING AREA	8,704.50 SF
EXISTING BASEMENT	35,004.50 SF
EXISTING 1ST FLOOR	40,451.50 SF
2ND FLOOR	42,735.50 SF


VICINITY MAP

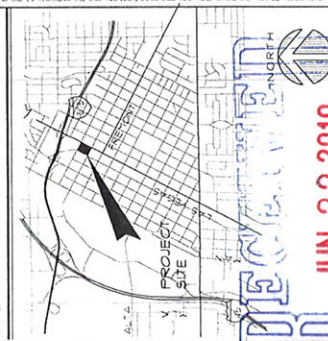

JUN 22 2010

SD B-37946

REVISED

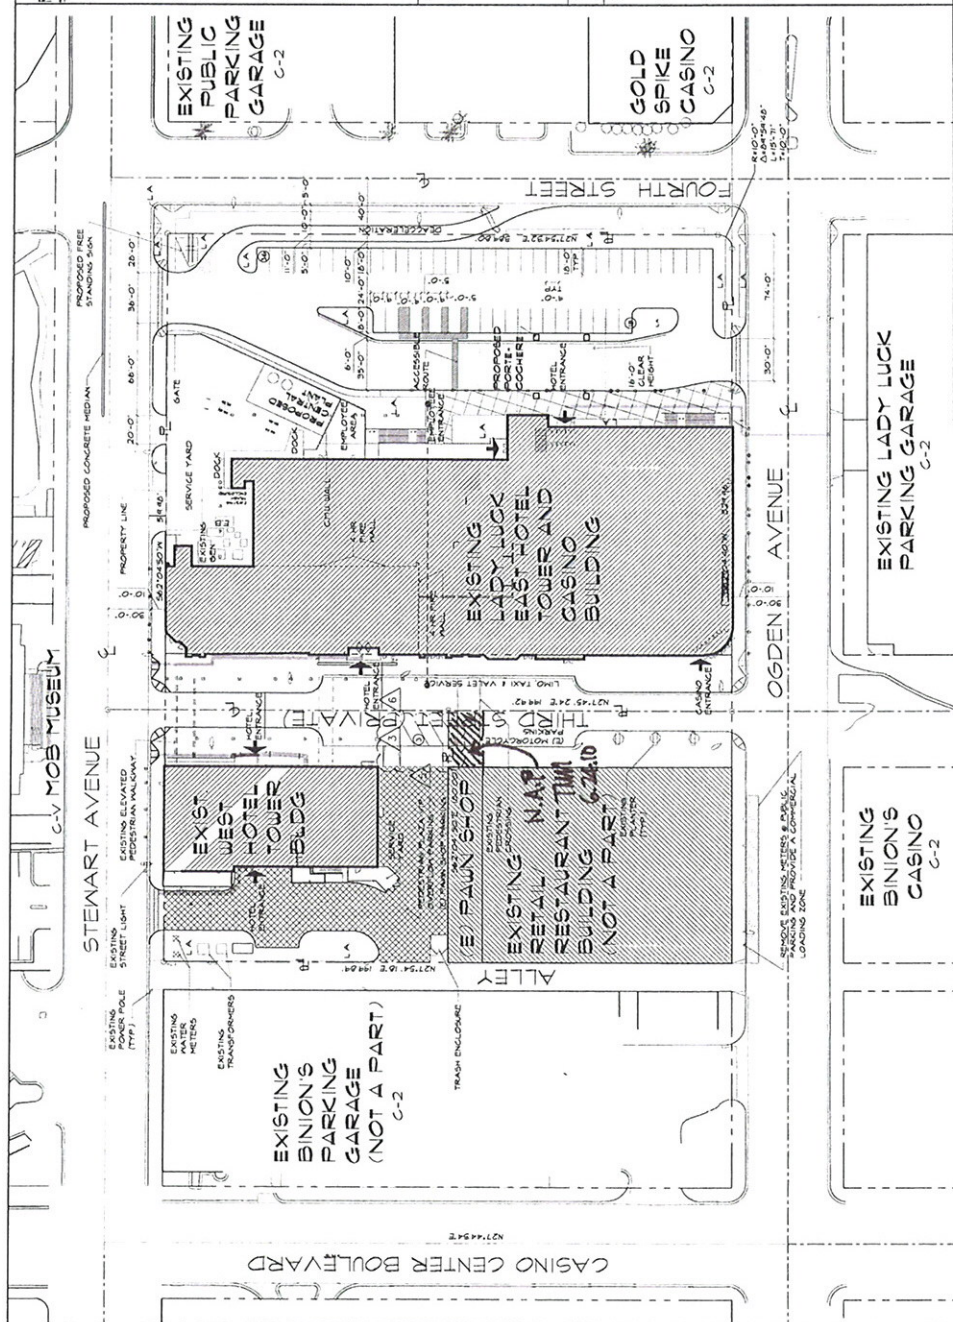

CONCEPTUAL ARCHITECTURAL SITE PLAN

 $0^{\circ} - 40^{\circ} - 0^{\circ}$

DZEW

CONTINUOUS ACCESSIBLE ROUTE 5% MAX RUNNING
SLOPE 2% MAX CROSS SLOPE W/ 1/2" MAX CHANGE
IN ELEVATIONS

Submitted after final agenda

Date _____ Item # _____

Item 71

Submitted after final agenda

Date 6/24/10 Item 21

drawn by :	KSCG/MS/MT
checked by :	MSG
project no :	
spec no :	
revision :	
	A 3-4-2010
	A 5-12-2010
	A 6-8-2010
	A 6-9-2010
	A 6-10-2010
	A 6-16-2010
sheet no:	AL1.01/2
oil	sheet

RECEIVED
JUN 22 2010
SDR-37946

