



PLANNING & DEVELOPMENT DEPARTMENT

STATEMENT OF FINANCIAL INTEREST

Case Number: **SUP-38137** APN: **162-06813005**
 Name of Property Owner: **Thrifty Payless, INC.**
 Name of Applicant: **Futura, INC.**
 Name of Representative: _____

To the best of your knowledge, does the Mayor or any member of the City Council or Planning Commission have any financial interest in this or any other property with the property owner, applicant, the property owner or applicant's general or limited partners, or an officer of their corporation or limited liability company?

☐ Yes

☒ No

If yes, please indicate the member of the City Council or Planning Commission who is involved and list the name(s) of the person or persons with whom the City Official holds an interest. Also list the Assessor's Parcel Number if the property in which the interest is held is different from the case parcel.

City Official: _____

Partner(s): _____

APN: _____

Signature of Property Owner: **By:** _____

Print Name: _____

L. Lawrence Gelman
Vice President

Subscribed and sworn before me

This **14th** day of **April**, 20 **10**

Notary Public in and for said County and State

RECEIVED

APR 28 2010



PLANNING & DEVELOPMENT DEPARTMENT

APPLICATION / PETITION FORM

Application/Petition For: FUTURA, INC
Project Address (Location) 3882 WEST SAHARA AVE
Project Name FUTURA ENVIA Proposed Use CHECK CASHING
Assessor's Parcel #(s) 162-06813005 Ward #
General Plan: existing proposed Zoning: existing proposed
Commercial Square Footage Floor Area Ratio
Gross Acres Lots/Units Density
Additional Information

PROPERTY OWNER THRIFTY PAYLESS, INC. Contact I. LAWRENCE GELMAN
Address P.O. Box 3165 Phone: 717-975-5717 Fax: 717-975-5952
City HARRISBURG State PA Zip 17105
E-mail Address

APPLICANT FUTURA ENVIA Contact MRS. ROSAURA OIRTEGA
Address 3882 WEST SAHARA AVE Phone: (971) 235-4884 Fax: (503) 693-4600
City LAS VEGAS State NV Zip 89102
E-mail Address roirtega@futuraenvia.com

REPRESENTATIVE Contact
Address Phone: Fax:
City State Zip
E-mail Address

Property Owner Signature* By: [Signature]

* An authorized agent may sign in lieu of the property owner for Final Maps, Tentative Maps, and Parcel Maps.

Print Name I. Lawrence Gelman

Vice President

Subscribed and sworn before me

This 14th day of April, 20 10

Notary Public in and for said County and State

COMMONWEALTH OF PENNSYLVANIA
Notarial Seal
Melissa H. Twardzik, Notary Public
East Pennsboro Twp., Cumberland County
My Commission Expires July 14, 2010
Member, Pennsylvania Association of Notaries

Revised 10/27/08


FOR DEPARTMENT USE ONLY

Case #	<u>SOP-38137</u>
Meeting Date:	<u>6/24/10</u>
Total Fee:	<u>1030.00</u>
Date Received:	<u>4/28</u>
Received By:	<u>MREX</u>

*The application will not be deemed complete until the submitted materials have been reviewed by the Planning and Development Department for consistency with applicable sections of the Zoning Ordinance.


F:\depot\Application Packet\Application Form.pdf

Call
before you
Dig
1-800-221-2800

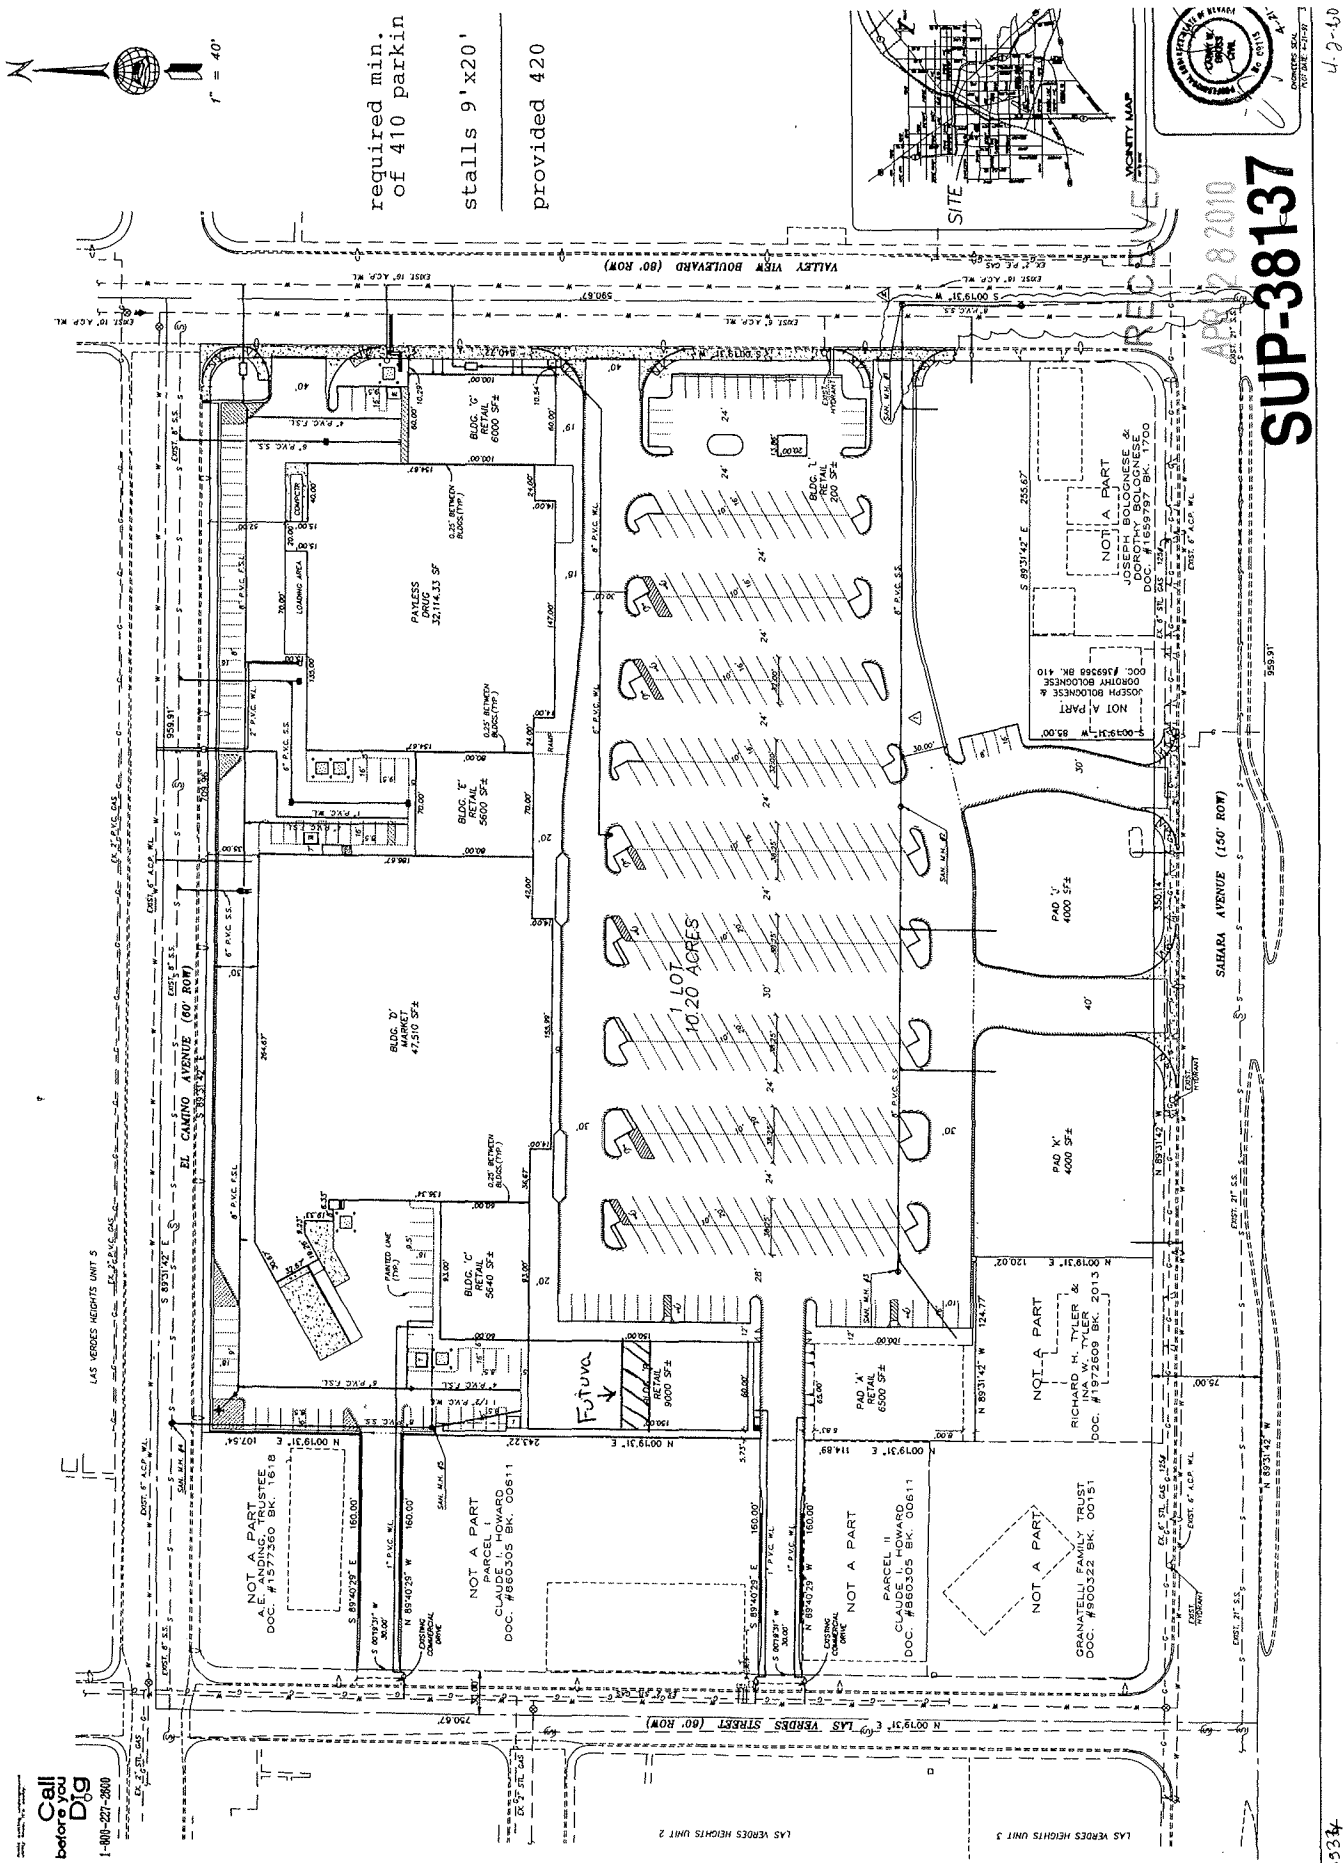


SUP-38137

APR 28 2010

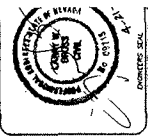

23534

4-2-40

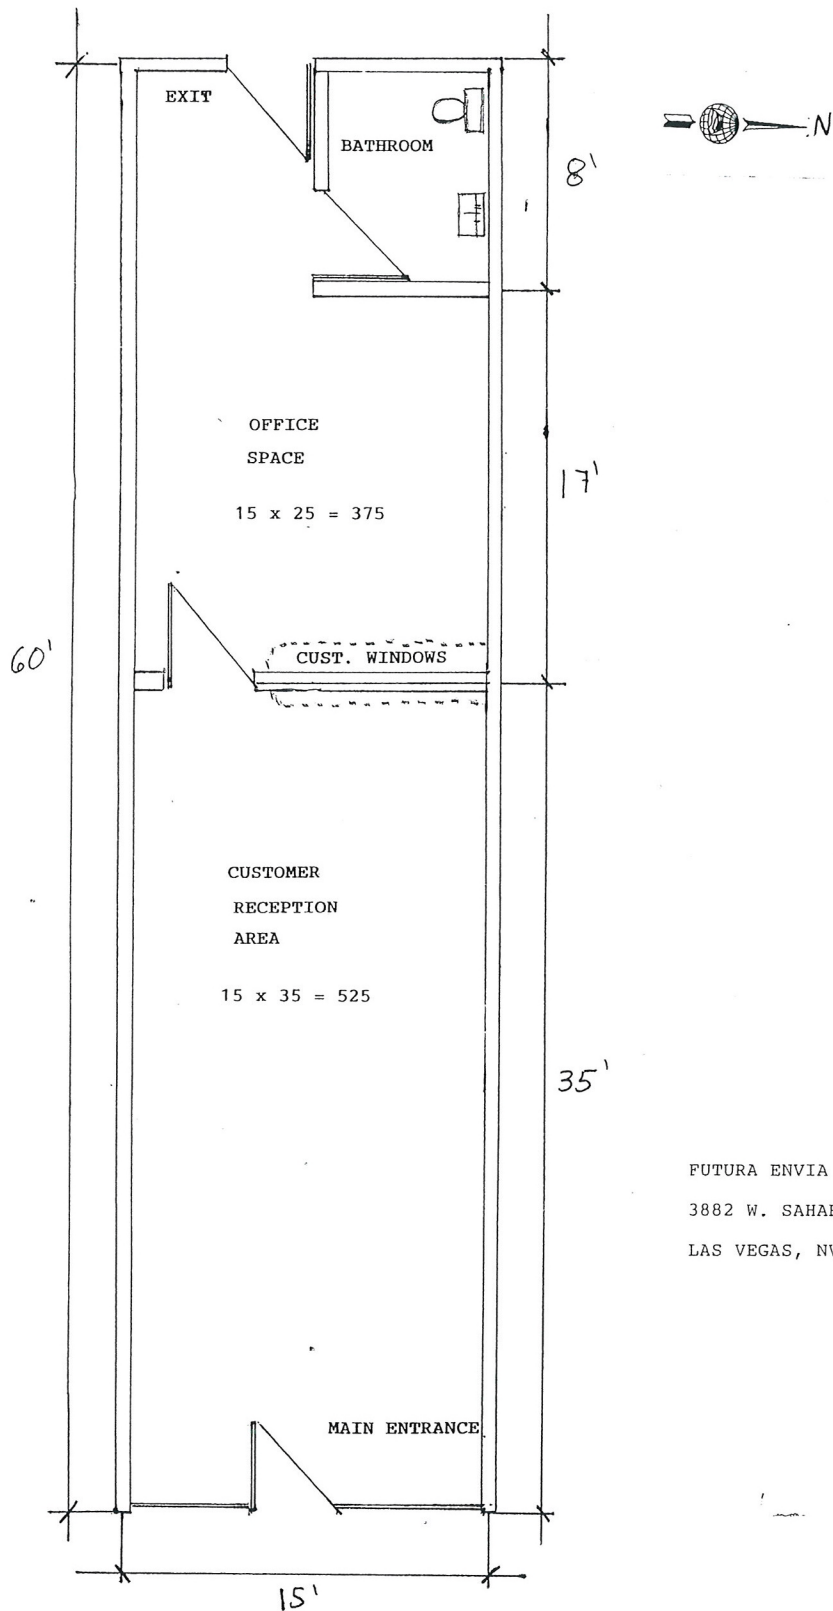

FUTURA ENVIA
3882 W. SAHARA AVE.
LAS VEGAS, NV 89102

RECEIVED

SUP-38137

APR 28 2010