

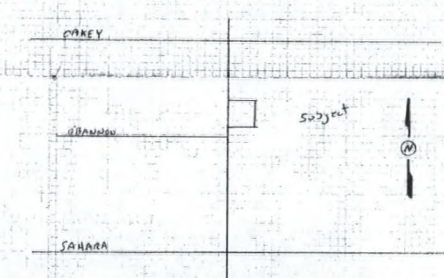


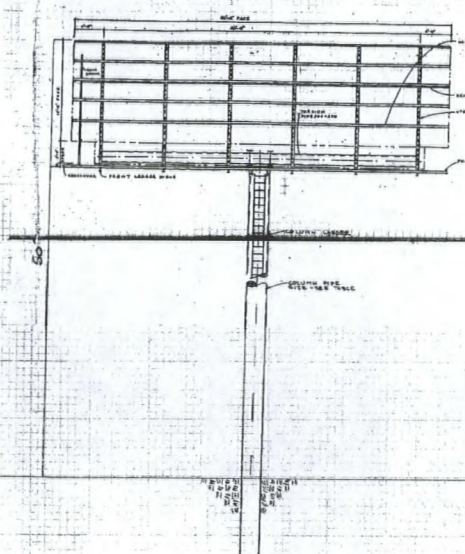

STATEMENT OF FINANCIAL INTEREST

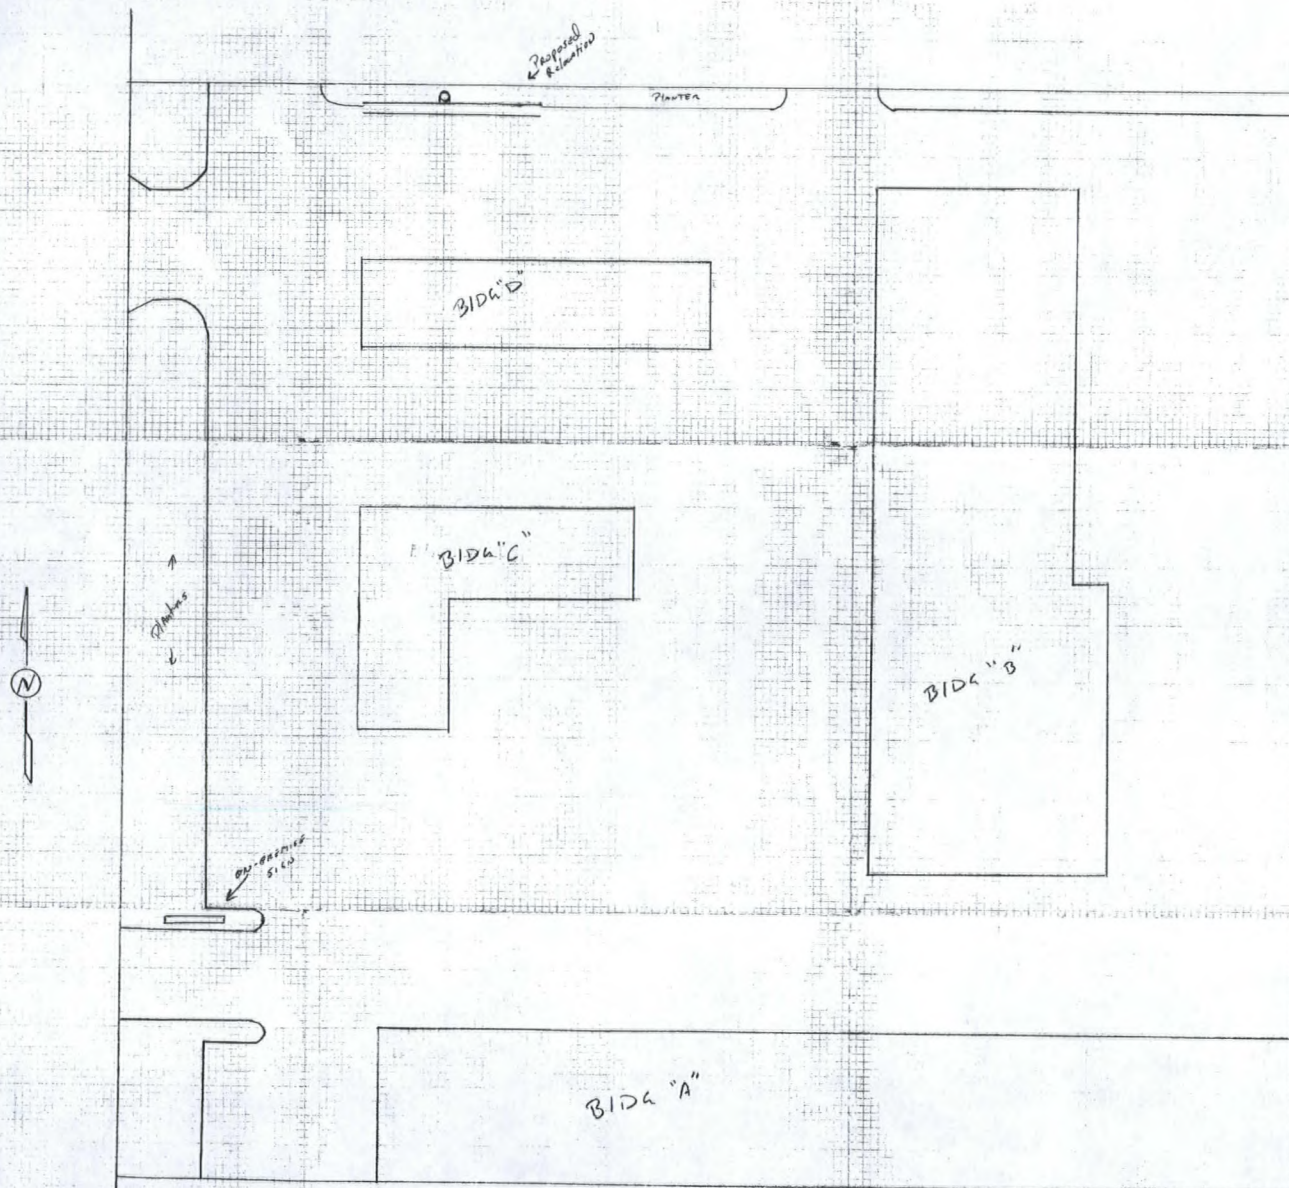

ch DONREY ch	
SCALE: 1" = 10'	DRAWING NUMBER: 1

RQR-32951
04/23/09 PC

FEB 20 2009