



PLANNING & DEVELOPMENT DEPARTMENT

STATEMENT OF FINANCIAL INTEREST

Case Number: **RQR-33798** APN: 138 03 602 015
Name of Property Owner: Mini-Markas, Inc.
Name of Applicant: Clear Channel Outdoor
Name of Representative: Rod Carter

To the best of your knowledge, does the Mayor or any member of the City Council or Planning Commission have any financial interest in this or any other property with the property owner, applicant, the property owner or applicant's general or limited partners, or an officer of their corporation or limited liability company?

☒ Yes ☐ No

If yes, please indicate the member of the City Council or Planning Commission who is involved and list the name(s) of the person or persons with whom the City Official holds an interest. Also list the Assessor's Parcel Number if the property in which the interest is held is different from the case parcel.

City Official: Ric Torres dell
Partner(s): Chetrik Development
APN: 162-03-410-007

Signature of Property Owner: Will King, Pres.
Print Name: Will King

Subscribed and sworn before me



This 3rd day of April, 2009

[Signature]
Notary Public in and for said County and State




ORAN GRAGSON HIGHWAY

CRAIG ROAD

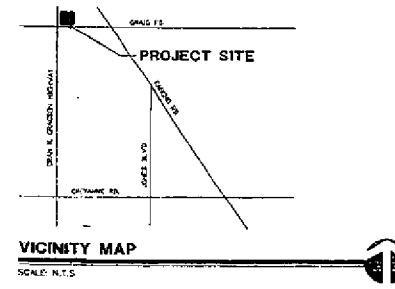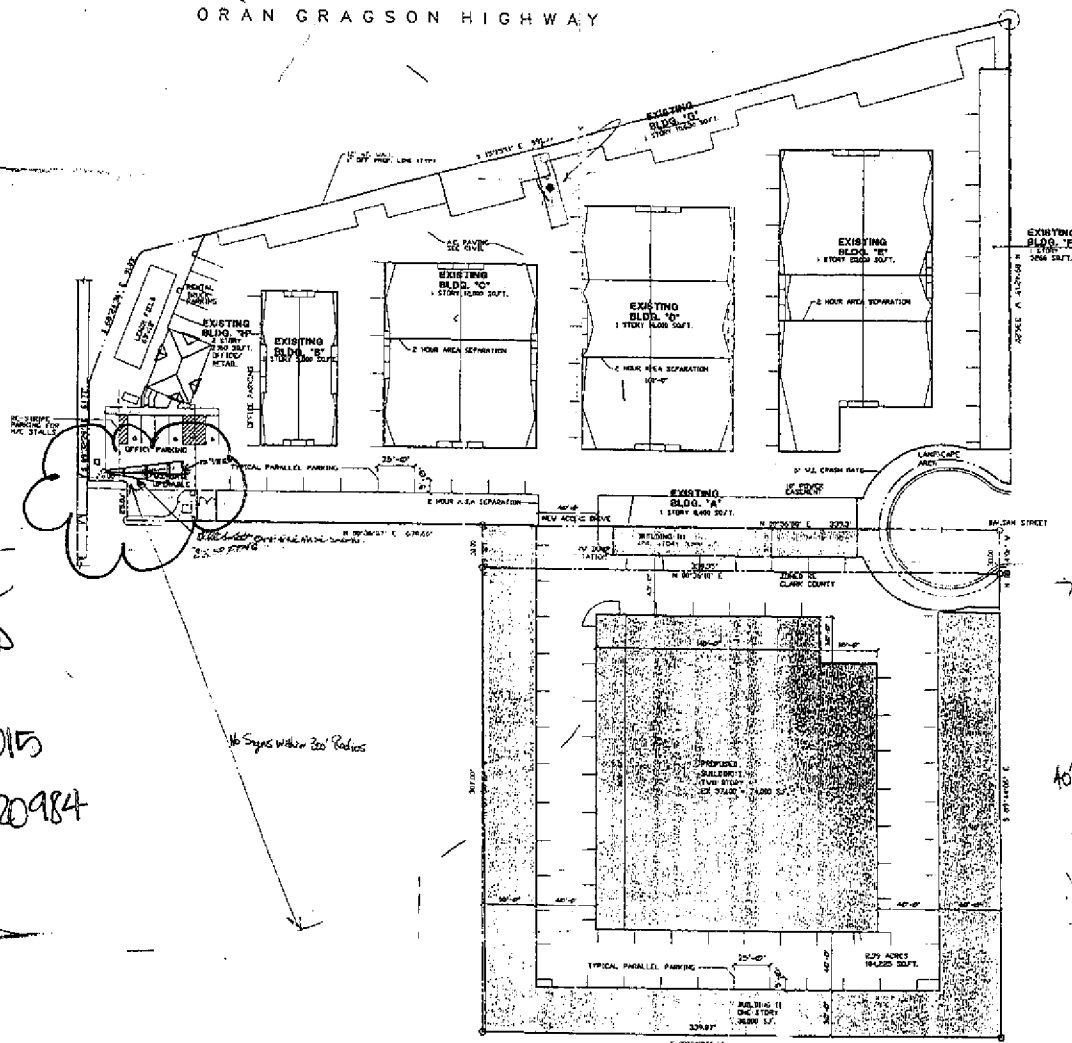

Mini Master Inc
6900 W. Craig Rd
CI
138-03-602-015
Permit # 97-020984

SITE / ROOF PLAN
SCALE: 1"=40'-0"

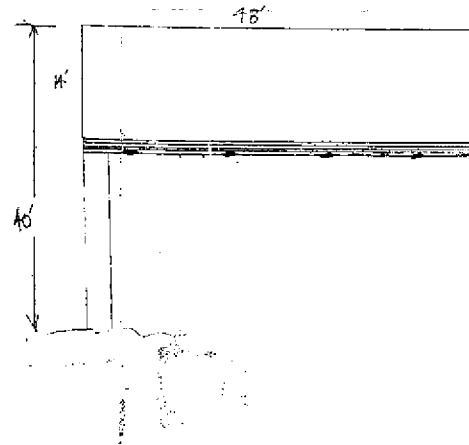


U-298-94
12/27/94 B2A
Swisher & Hall
AIA, LIMITED
Architecture and Planning
1765 S. Rainbow Blvd. Ste. 100 Las Vegas, NV 89106 (702) 368-8888

sheet title
SITE PLAN
KEMP MINI STORAGE
job title
job no.
date:
drawn by:
checked by:



sheet no.
A1.0
of of

RQR-33798
05/28/09 PC

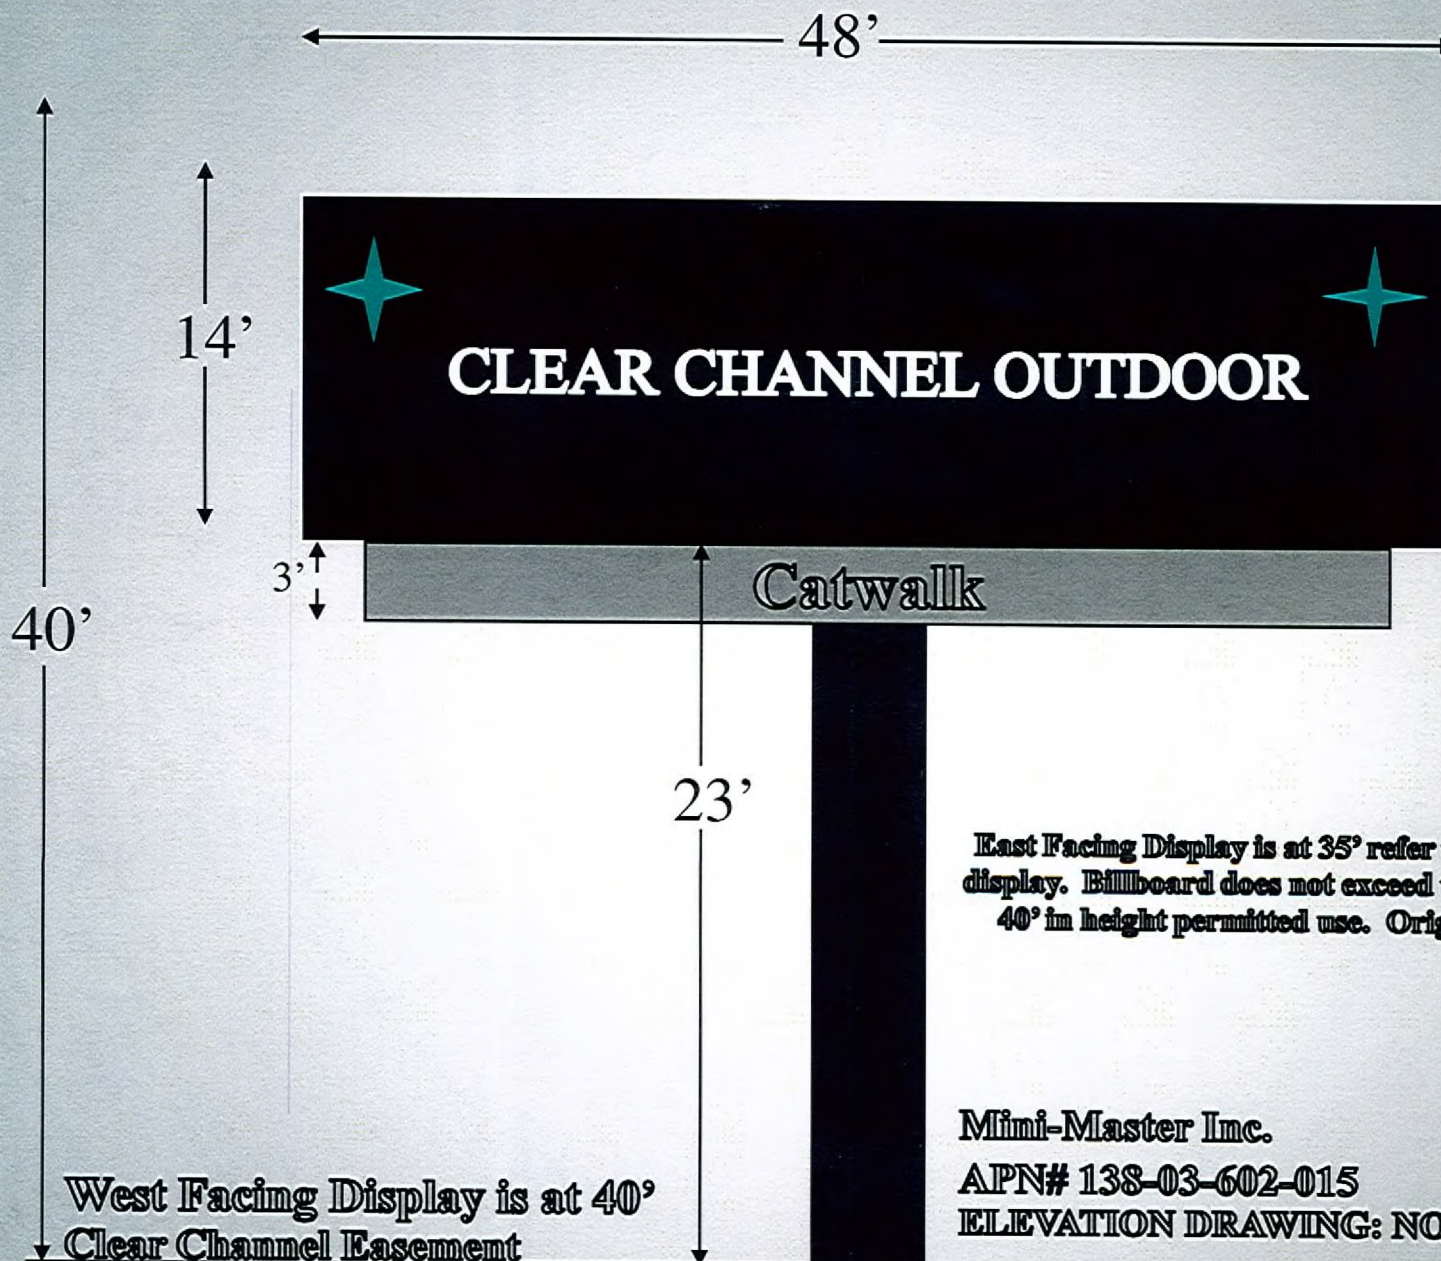

RQR-33798
05/28/09 PC