


ALL FIRE HOSE SHALL BE KEPT IN STRICT ACCORDANCE WITH THE CITY OF LAS VEGAS DEPARTMENT "HYDRANT REGISTRATION", "HYDRANT INSTALLATION SPECIFICATIONS" AND PRECEDENT 41-11-1.	A FIRM TEST MUST BE PERFORMED BY THE FIRE DEPARTMENT PRIOR TO OCCUPANCY FOR VERIFICATION OF REQUIRED ON-SITE WATER SUPPLY.
AUTORIZED HYDRANTS FOR THIS PROJECT ARE:	ALL ON-SITE FIRE WATER MATERIALS MUST BE UL LISTED AND APPROVED.
1. NEAREST HYDRANT	ALL HYDRANT SPACING
2. HYDRANT 41-13 (SEE DRAWING)	PERSONAL - 500 FEET MINIMUM, AND FEET MINIMUMS
3. GLOW HOSE AND DISCHARGER	COMMERCIAL - HYDRANT 41-13/41-17 - 500 FEET MINIMUM, AND FEET MINIMUMS
ON ANY WORK ON EXISTING INSTALLATION, ACCESSIBLE FIRE HYDRANTS MUST BE INSTALLED BEFORE COMMENSIBLE CONSTRUCTION COMMENCED AND THIS HYDRANT SHALL BE IN GOOD WORKING ORDER WITH AN ADEQUATE WATER SUPPLY.	NO FIRE HYDRANT SHALL BE LOCATED WITHIN THE REQUIRED RADIUS OF A CURVE OR CIRCULAR OR WITHIN 20 FEET OF THE PERIMETER OF THE RADII OF THE CURVE OR CIRCULAR
CONTRACTOR SHALL PLACE A BLUE REFLECTIVE MARKER AT CENTRAL OF STREET INDICATED TO HYDRANT 41-13 FOLLOWED BY SIGNAGE 41-11 TO IDENTIFY FIRE HYDRANT LOCATIONS.	NO FIRE HYDRANT SHALL BE LOCATED WITHIN 6 FEET OF ANY CURVE RETURN, CEMENT CURB OR OTHER OBSTACLE
CALL THE LAS VEGAS RAISED PUMP DEPARTMENT AT 41-11-11 FOR UNDERGROUND INSPECTION. THE HYDRANT 41-13 VERIFICATION OF ALL FIRE HYDRANTS AND FIRE LINES BEFORE COVERING.	NO HOT WORK SHALL BE PERFORMED ON OR NEAR A HYDRANT OR ON A BRIDGE OR BENCH
PAINTING OF THE CURBS AND HYDRANTS AND ANY WORK NECESSARY FOR PROTECTION OF THE HYDRANT SHALL BE COMPLETED PRIOR TO THE HYDRANT BEING COMPLETED BEFORE APPROVAL BY THE CITY OF LAS VEGAS FIRE DEPARTMENT.	THE TURNING RADIUS FOR ANY FIRE APPARATUS ACCESS ROAD AND/OR FIRE LANE, OR CURVE OR CIRCULAR, MUST BE NOT LESS THAN 30 FEET OUTSIDE RADII AND 22 FEET INSIDE RADII
PERMIT IS REQUIRED FROM THE FIRE DEPARTMENT FOR ON-SITE WATER LINE AND FIRE HYDRANT.	A FIRE APPARATUS ROAD SHALL BE REQUIRED WHERE ANY PORTION OF AN EXISTING ROAD OR FIRST DRIVE IS LOCATED WITHIN THE TURNING RADIUS OF A CURVE OR CIRCULAR
PERMIT FOR UNDERGROUND PUMPING WORK SHALL BE OBTAINED FROM THE FIRE DEPARTMENT FOR UNDERGROUND PUMPING WORK.	DEPARTMENT SAMPLE AREAS (SEE EXCEPTIONS IN UVC 41-11 SECTION 10.21.2)
ALL DEAD END FIRE APPARATUS ACCESS ROAD SHALL BE TURNED LATERAL ON THE	



[illegible]

 FIRE HYDRANT W/ 4" G.V.
 WATER LINE
 SEWER LINE
 SEWER LATERAL
 GATE VALVE
 SEWER MANHOLE
 1 1/2" PVC CONDUIT (ST. LT.)
 250W RPS LAMPPOLE W/ 11 GA. POLE
 100W RPS LAMPPOLE W/ 11 GA. POLE
 3" x 1/2" CLC PIPE BOX W/ WEIR
 COVERED MANHOLE SPACES

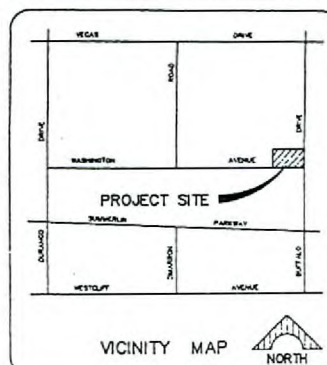

8. ALL STREET LIGHT INSTALLATIONS SHALL CONFORM TO THE STANDARD DETAILS AND SPECIFICATIONS OF THE CITY OF LAS VEGAS, AND SHALL ALSO CONFORM TO THE UNIFORM STANDARD SPECIFICATIONS FOR PUBLIC WORKS CONSTRUCTION OF CITY-WIDE IMPROVEMENTS, CLARK COUNTY AREA, LATEST EDITION, UNLESS

8" PVC WITH 6" DATE VALVE & 6" PVC LVL	3 EA
PVC WATER	ABC LF
DATE VALVE WITH VALVE BOX & COVER	1 EA
1/2" x 1/2" B	1 EA
1/2" WATER SERVICE LATERAL	1 EA
WATER SERVICE LATERAL	1 EA
1" BOPB	4 EA
CURB SF	200 SF
1/2" x 1/2" (PVC)	6 EA

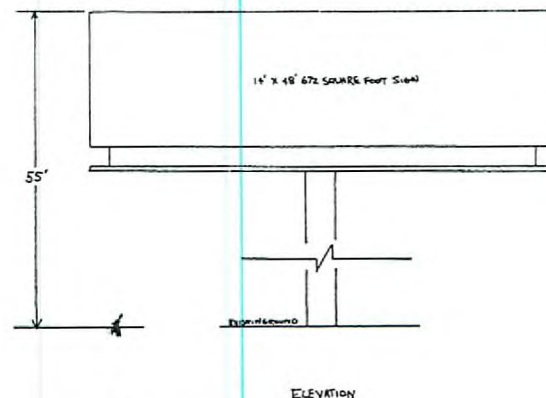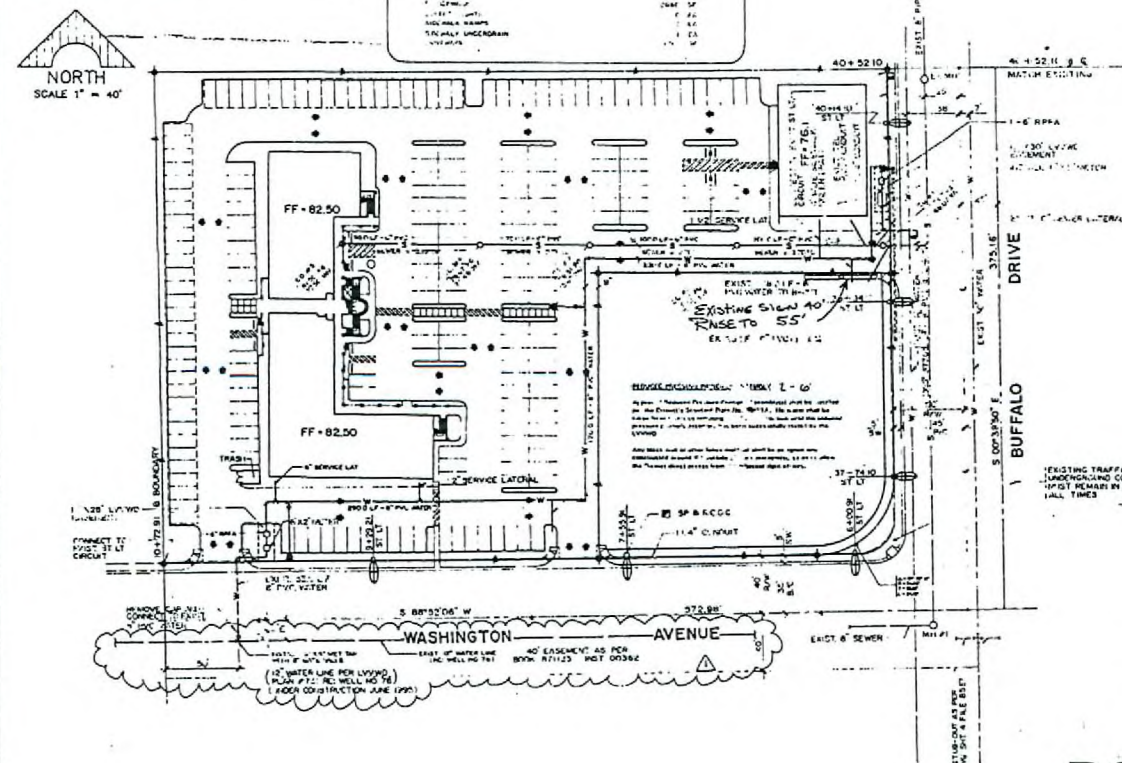

STAFF

V-0043-96(1)
7-12-01 PC

RQR-33738
05/14/09 PC

Job

L-4077-98

APPROVED
V-1-98
9/14/98
CITY OF PLANNING DIVISION
OFFICE OF THE CITY CLERK

REV.	DATE	DESCRIPTION

DoLUNA, INC.
ENGINEERING • PLANNING • SURVEYING
7310 SMOKE JACKET ROAD, SUITE 1, LAS VEGAS, NEVADA 89106 (702) 255-8242

2
CONTENTS
ROCK SPRINGS VISTA DEV. CO.
ROCK SPRINGS VISTA COMMERCIAL
UTILITY PLAN

SHEET
1
OF 2 SHEET

107-V2354

107-V2354