




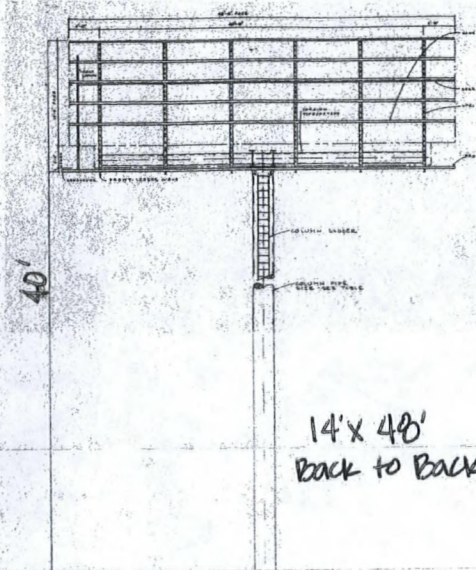

Back to Back

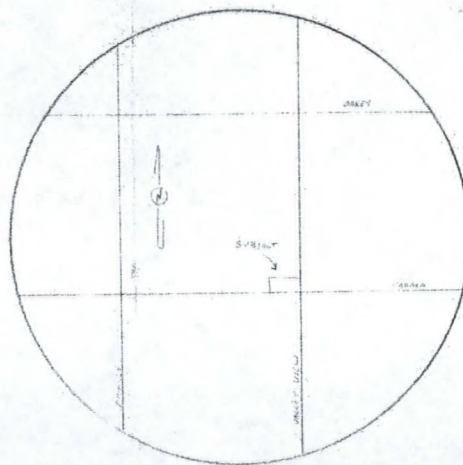

VALLEY VIEW

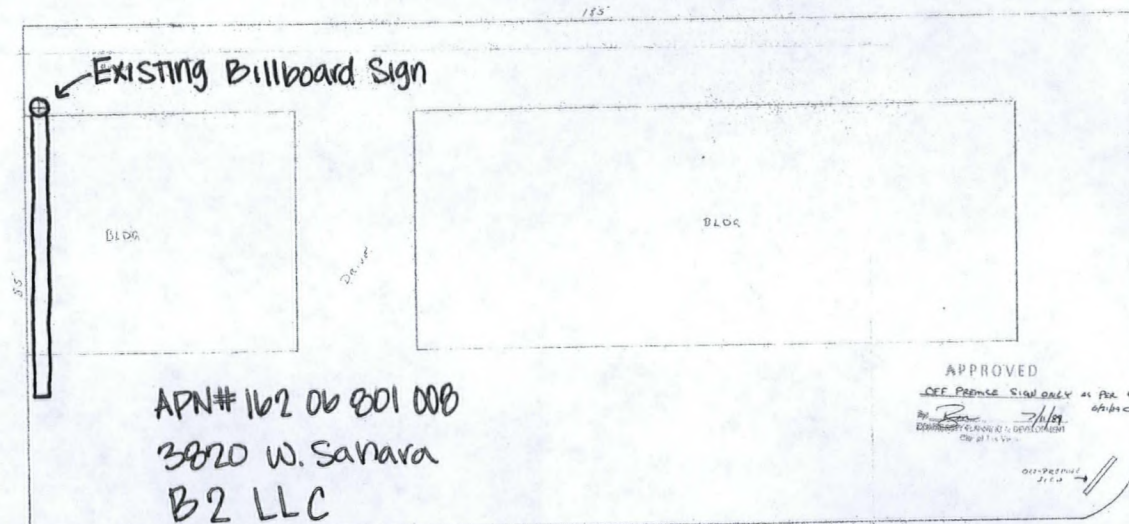

APN# 162 06 801 008
3820 W. Sahara
B2 LLC

APPROVED
OFF PRIME SIGN ONLY as per V-16-89
By *[Signature]* 7/1/19

OUTSTANDING

SAHARA AVE

RQR-33797
05/28/09 PC

donREY

SCALE: 1" = 10'	DRAWING NUMBER: 1	Joseph Salome
DATE: 2-6-18	1211 West Bonanza Road Drawn By Michael Petran Phone 382-5030	