



PLANNING & DEVELOPMENT DEPARTMENT

STATEMENT OF FINANCIAL INTEREST

Case Number: **SUP-34267** APN: 138-12-801-002

Name of Property Owner: Les Quock and Stanley Quock

Name of Applicant: Wayne H Higdon

Name of Representative: _____

To the best of your knowledge, does the Mayor or any member of the City Council or Planning Commission have any financial interest in this or any other property with the property owner, applicant, the property owner or applicant's general or limited partners, or an officer of their corporation or limited liability company?

☐ Yes


☒ No

If yes, please indicate the member of the City Council or Planning Commission who is involved and list the name(s) of the person or persons with whom the City Official holds an interest. Also list the Assessor's Parcel Number if the property in which the interest is held is different from the case parcel.

City Official: _____

Partner(s): _____

APN: _____

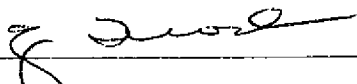Signature of Property Owner: 

Print Name: Stanley Quock

Subscribed and sworn before me


This _____ day of _____ 20____

Notary Public in and for said County and State

State of California

County of Sonoma

Subscribed and sworn to (or affirmed) before me on this 17th
day of April, 2009, by Stanley Quock,
proved to me on the basis of satisfactory evidence to be the
person(s) who appeared before me.

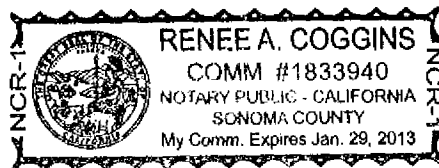

(Seal)

Signature Renee A Coggins

SUP-34267
06/11/09 PC

[illegible]

D. W. STRAIT
Architecture & Planning
AIA

Rancho Auto Mall Office Warehouse
Rancho Drive @Michael Way

Row #	Description	Date
1	Black Lot Pay-in for Civil 12/27/89 PSS	
2	Added Trees at South Side 1/13/90 PSS	




Site Plan

Date	1/15/00
Job No.	0908
Scale	
Drawn	RSS
Designed	RSS
Checked	DWS

Sheer

SUP-34267
06/11/09 PC

APR 23 2009

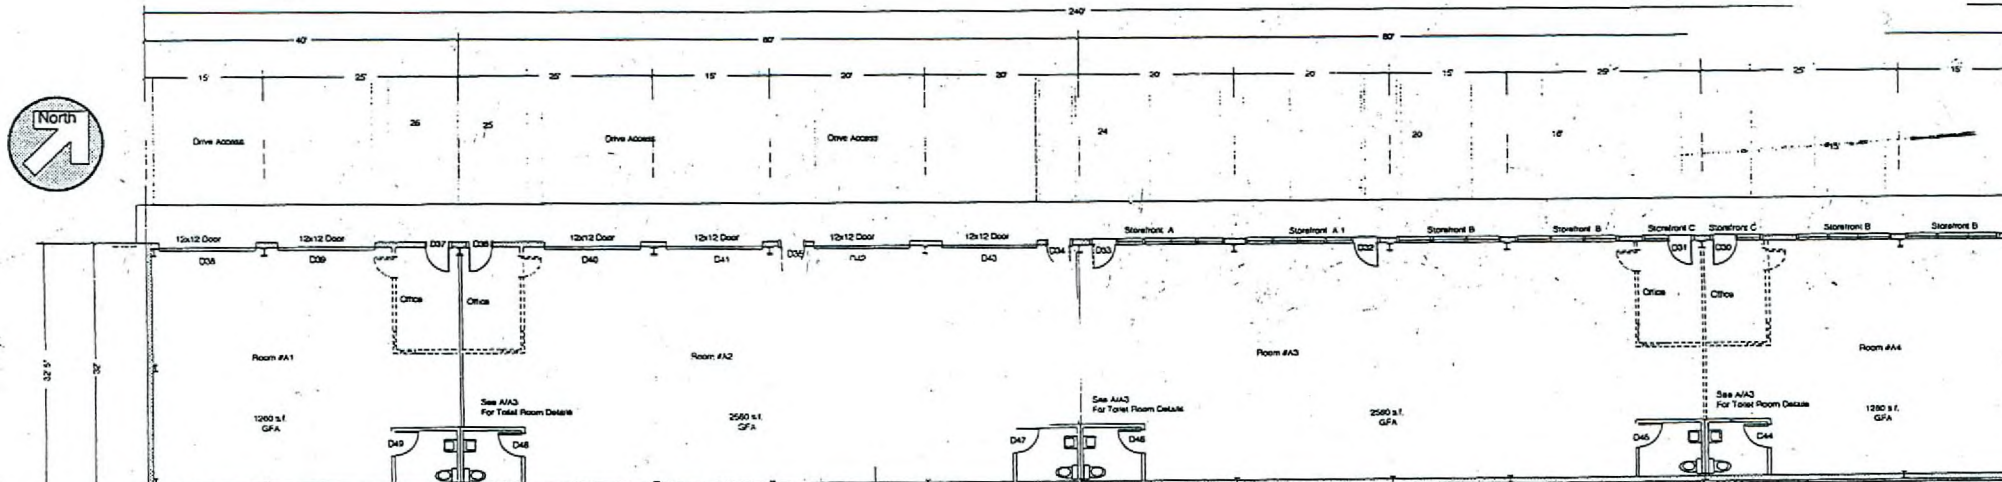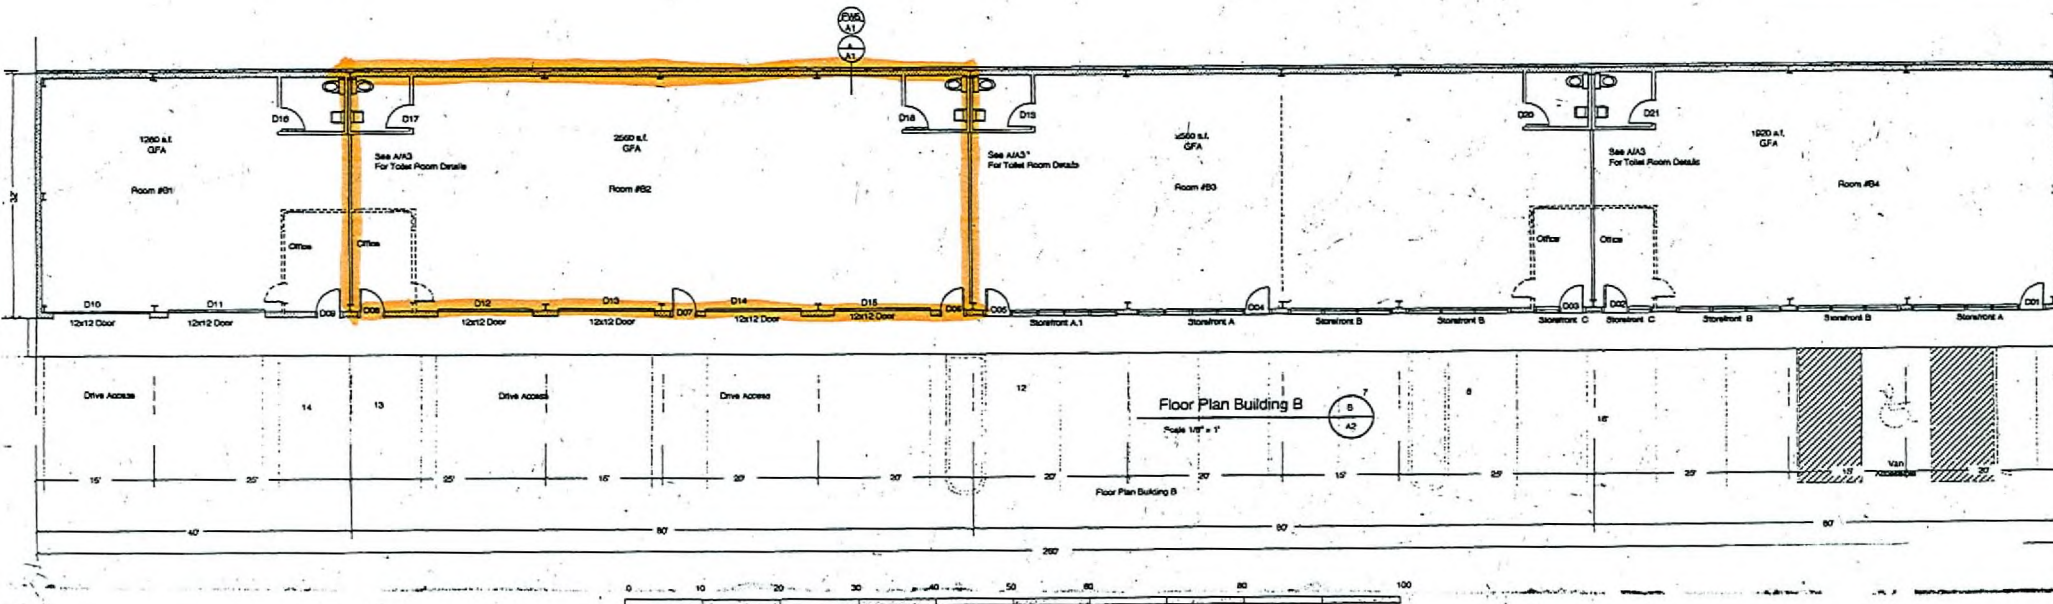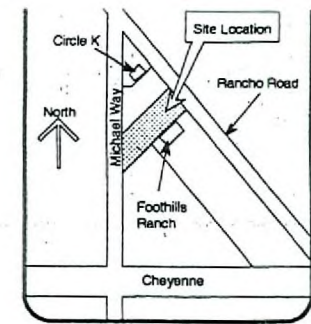

Door Schedule

Door Number	Door Size	Action	Type	Description	Frame	Lock	Finish	Door
001	30 1/2" x 80"	R.H.	A	Heavy Galvalume Alum. Storeroom	Keyed Dead Bolt	Anodized Bronze	Hydraulic Head Mounted	
002	30 1/2" x 80"	L.H.	A	Heavy Galvalume Alum. Storeroom	Keyed Dead Bolt	Anodized Bronze	Hydraulic Head Mounted	
003	30 1/2" x 80"	R.H.	A	Heavy Galvalume Alum. Storeroom	Keyed Dead Bolt	Anodized Bronze	Hydraulic Head Mounted	
004	30 1/2" x 80"	L.H.	A	Heavy Galvalume Alum. Storeroom	Keyed Dead Bolt	Anodized Bronze	Hydraulic Head Mounted	


