



PLANNING & DEVELOPMENT DEPARTMENT

STATEMENT OF FINANCIAL INTEREST

Case Number. **RQR-34329** APN: 162-08-410-018
Trans-Aero Land & Development Company and Shoshone Cattle
Name of Property Owner: and Land Development Co.
Name of Applicant: Clear Channel Outdoor
Name of Representative: Rod Carter

To the best of your knowledge, does the Mayor or any member of the City Council or Planning Commission have any financial interest in this or any other property with the property owner, applicant, the property owner or applicant's general or limited partners, or an officer of their corporation or limited liability company?

 Yes


 X No

If yes, please indicate the member of the City Council or Planning Commission who is involved and list the name(s) of the person or persons with whom the City Official holds an interest. Also list the Assessor's Parcel Number if the property in which the interest is held is different from the case parcel.

City Official: N/A

Partner(s): N/A

APN: N/A

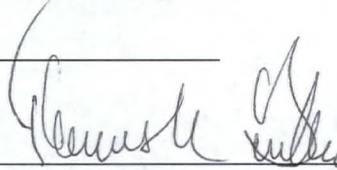
Signature of Property Owner: 

Print Name: Thomas R. Buckley, Manager

Subscribed and sworn before me

This 12th day of May, 2009

Marjorie Ann Mitchell
Notary Public in and for said County and State

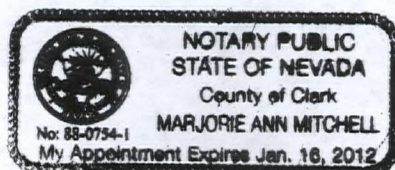









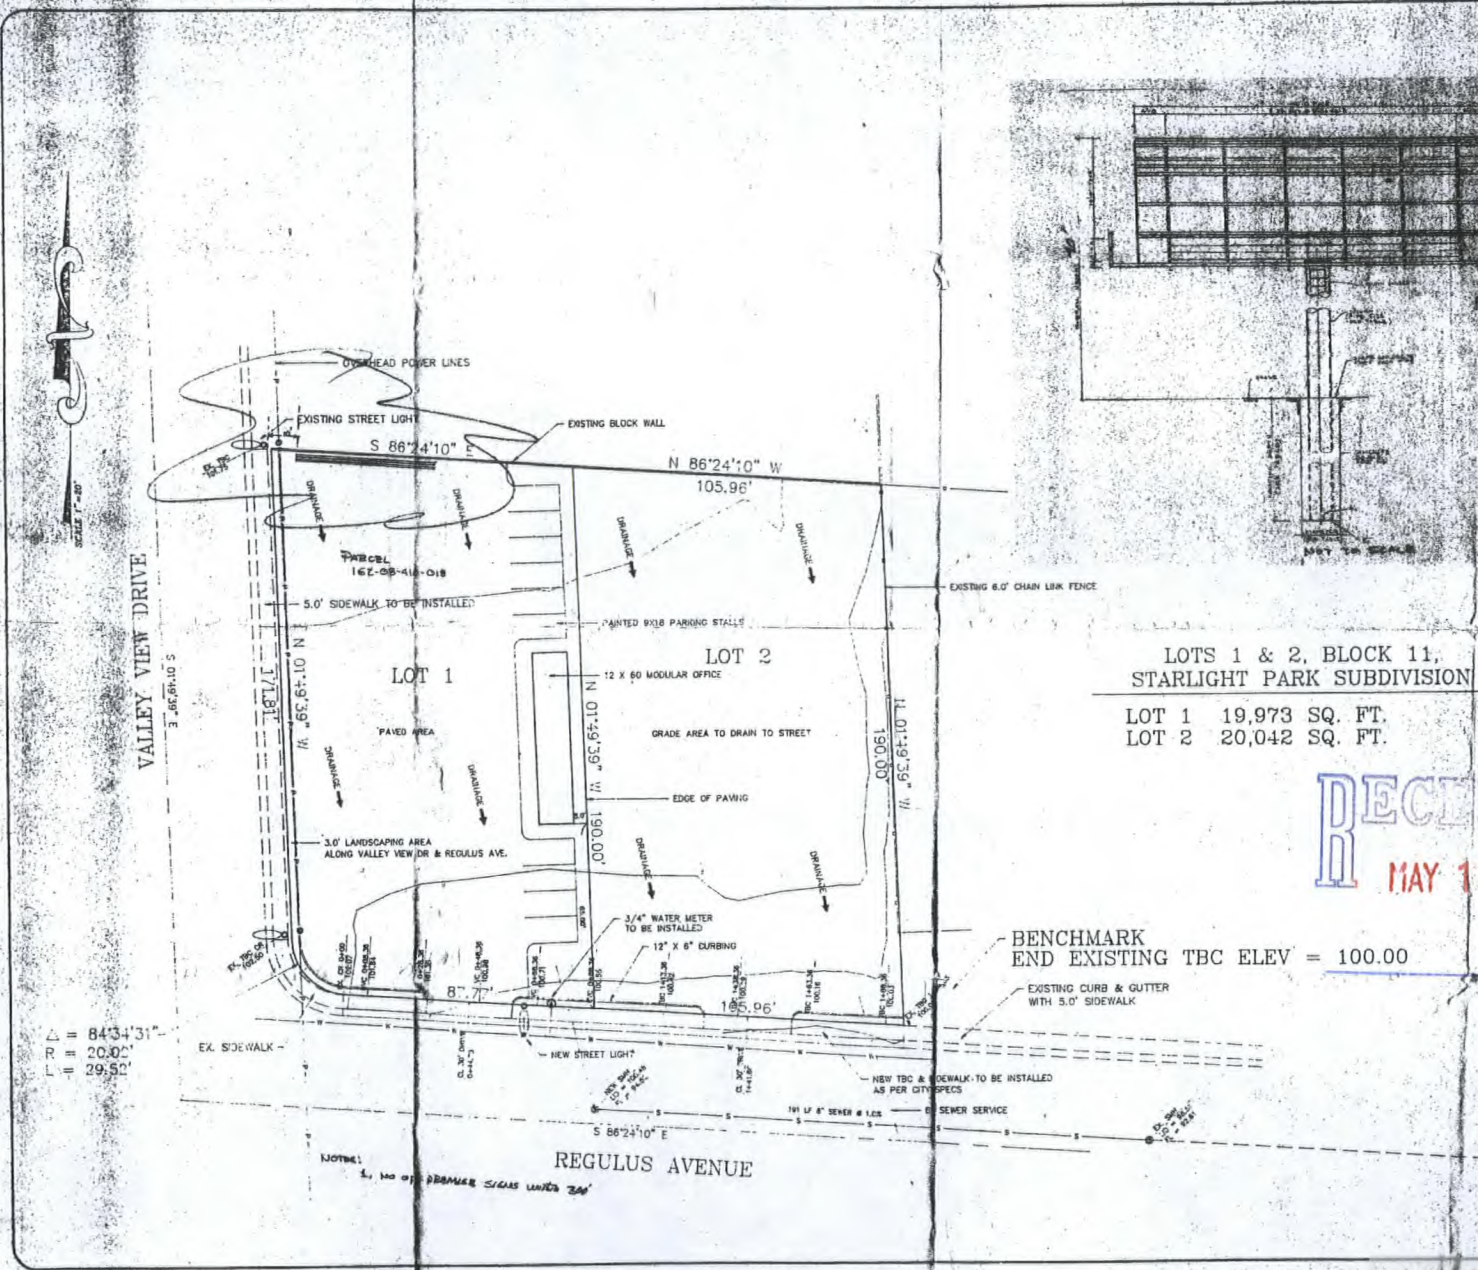

RQR-34329
06/25/09 PC