

PLANNING & DEVELOPMENT DEPARTMENT

STATEMENT OF FINANCIAL INTEREST

Case Number: **SUP-34765** APN: 126-24-517-001

Name of Property Owner: **Providence Village, LLC**

Name of Applicant: **House of Vino LLC**

To the best of your knowledge, does the Mayor or any member of the City Council, Planning Commission, or a Hearings Officer have any financial interest in this or any other property with the property owner, applicant, the property owner or applicant's general or limited partners, or an officer of their corporation or limited liability company?

 Yes X No

If yes, please indicate the member of the City Council, Planning Commission or Hearings Officer who is involved and list the name(s) of the person or persons with whom the City Official holds an interest. Also list the Assessor's Parcel Number if the property in which the interest is held is different from the case parcel.

City Official: _____

Partner(s): _____


APN: _____

Signature of Property Owner/Authorized Agent:

Subscribed and sworn before me



This 20 day of May, 2009

Notary Public in and for said County and State

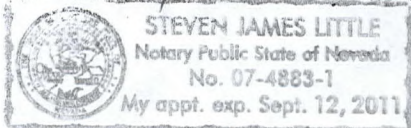

RECEIVED

JUN 05 2009

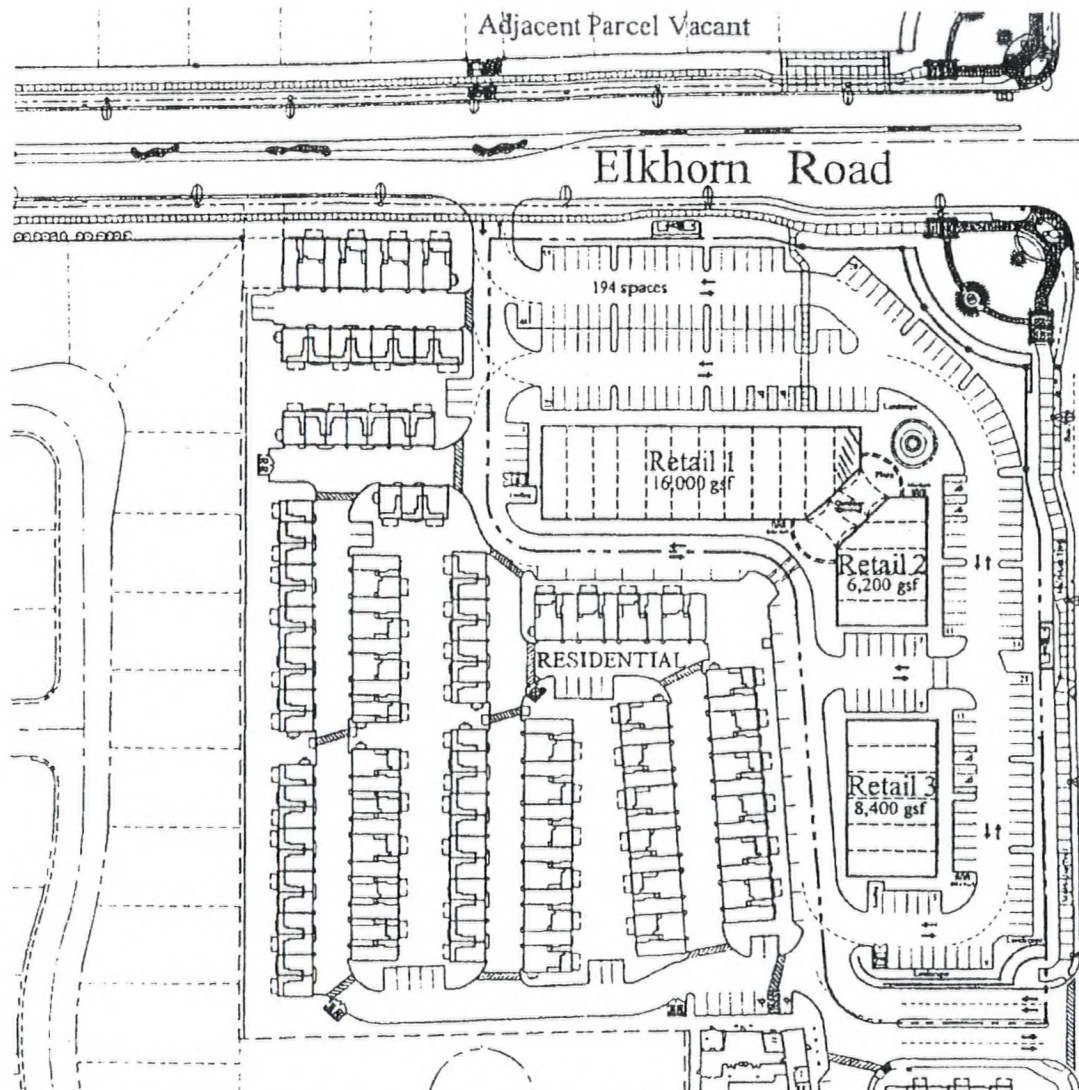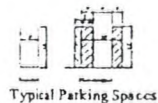

SITE INFORMATION

ZONING: PD Assessor Parcel No.: 126-24-510-003

COMMERCIAL AREA:

Parcel: 2 (Approximate, to be Verified)
Net Area 150,300 sf 3.450 acres

Retail:
Retail - 1 16,000 gsf
Retail - 2 6,200 gsf
Retail - 3 8,400 gsf

Total Retail Area 30,600 gsf

FAR (150,300 sf) 0.204

PARKING REQUIREMENTS

General Retail over 25,000 sf
1 per 130 sf 21,300 sf / 130 sf = 90

Restaurants (1,100 sf)
1/200 of parking = 1/200 of vehicle spaces = 1/200 of nonresidential building
3,300 sf = 4,400/200 = 2200 sf = 105

Total Required 195


Provided: 194

Total Provided: 194

Parking Ratio: 6.3 per 1000 1 per 158

H/C Required: Per CLV Table 19- 6

Provided: 6

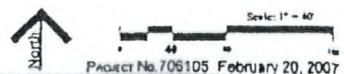

© December 2007, P&L Properties, Inc. All Rights Reserved.

GREEN STREET
PROPERTIES

RECEIVED
JUN 25 2009

Commercial Site Plan - B-1


PROVIDENCE MIXED-USE
Las Vegas, Nevada

SUP-34765
REVISED
07/23/09 PC

Pedman
DESIGN GROUP
ARCHITECTURE • PLANNING • INTERIORS


EXHIBIT "A"

SITE PLAN

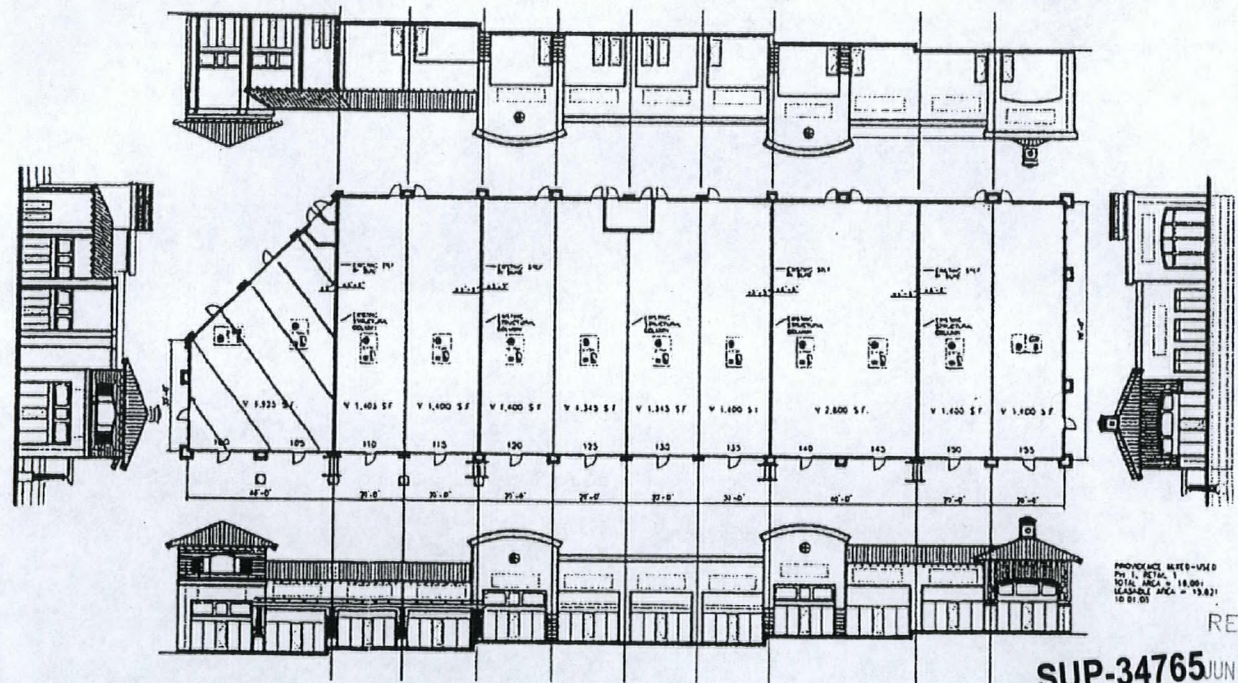

RECEIVED

SUP-34765 JUN 05 2009
07/23/09 PC

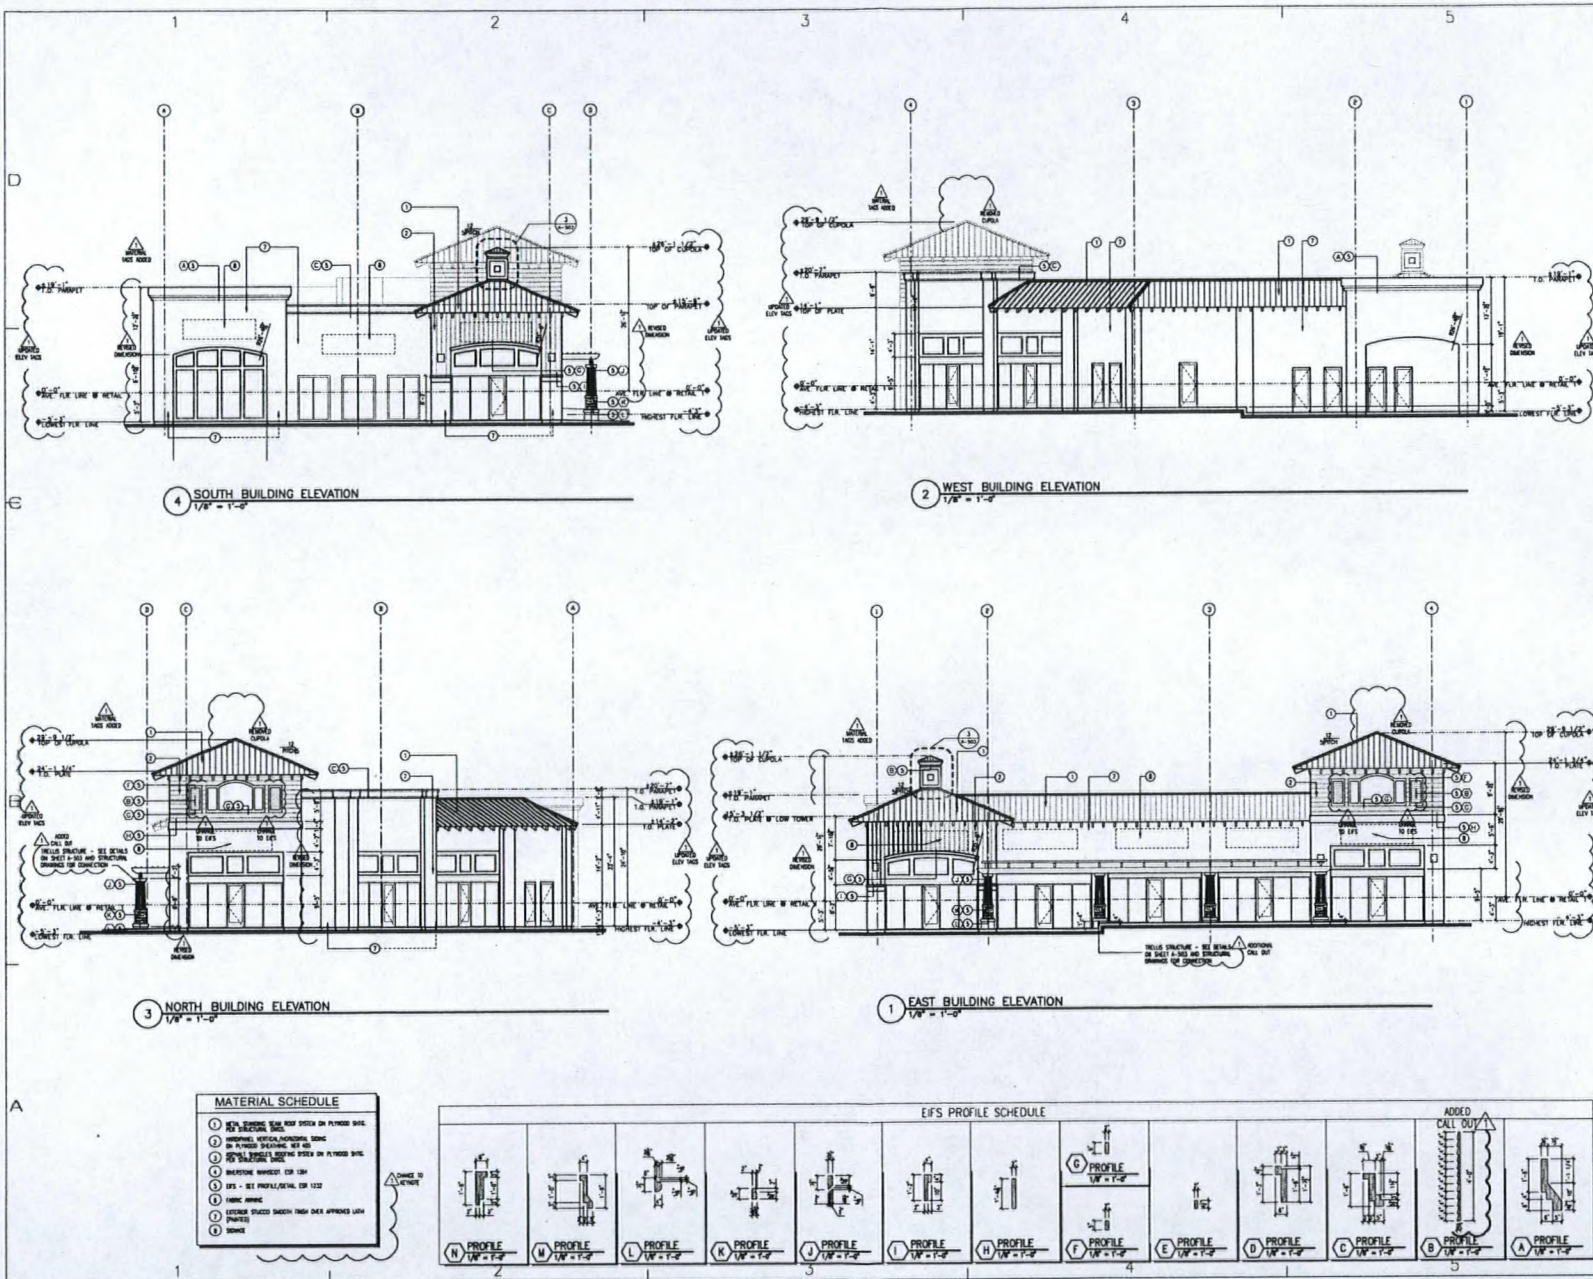

707036
PROVIDENCE MIXED-USE
Perlman
PA Las Vegas, LLC
A Perlman Design Group Company
2230 CORPORATE CIRCLE
SUITE 200
HENDERSON, NEVADA 89074
702 996 8900 702 972 3222 fax



THIS DOCUMENT IS THE PROPERTY OF PERLMAN DESIGN GROUP, INC. AND IS NOT TO BE REPRODUCED OR TRANSMITTED IN ANY FORM OR BY ANY MEANS, ELECTRONIC OR MECHANICAL, WITHOUT THE WRITTEN PERMISSION OF PERLMAN DESIGN GROUP, INC. ANY UNAUTHORIZED REPRODUCTION OR TRANSMISSION OF THIS DOCUMENT IS PROHIBITED AND WILL BE SUBJECT TO LEGAL ACTION.


Revision	By	Date	Description
1	PA1	12/17/07	FINAL CHECK SUBMITTAL
2	PA1	12/17/07	FINAL CHECK SUBMITTAL
Providence Mixed-Use
Retail 1, 2 & 3
Las Vegas, Nevada 89178
GREENSTREET PROPERTIES

SUP-34765
07/23/09 PC

Drawn/Checked By: pnd/sev/p-1
Date: 12/17/07
Project Number: 707036
Sheet Number: RETAIL 2 BUILDING ELEVATIONS
JUN 05 2009
A-202

RECEIVED

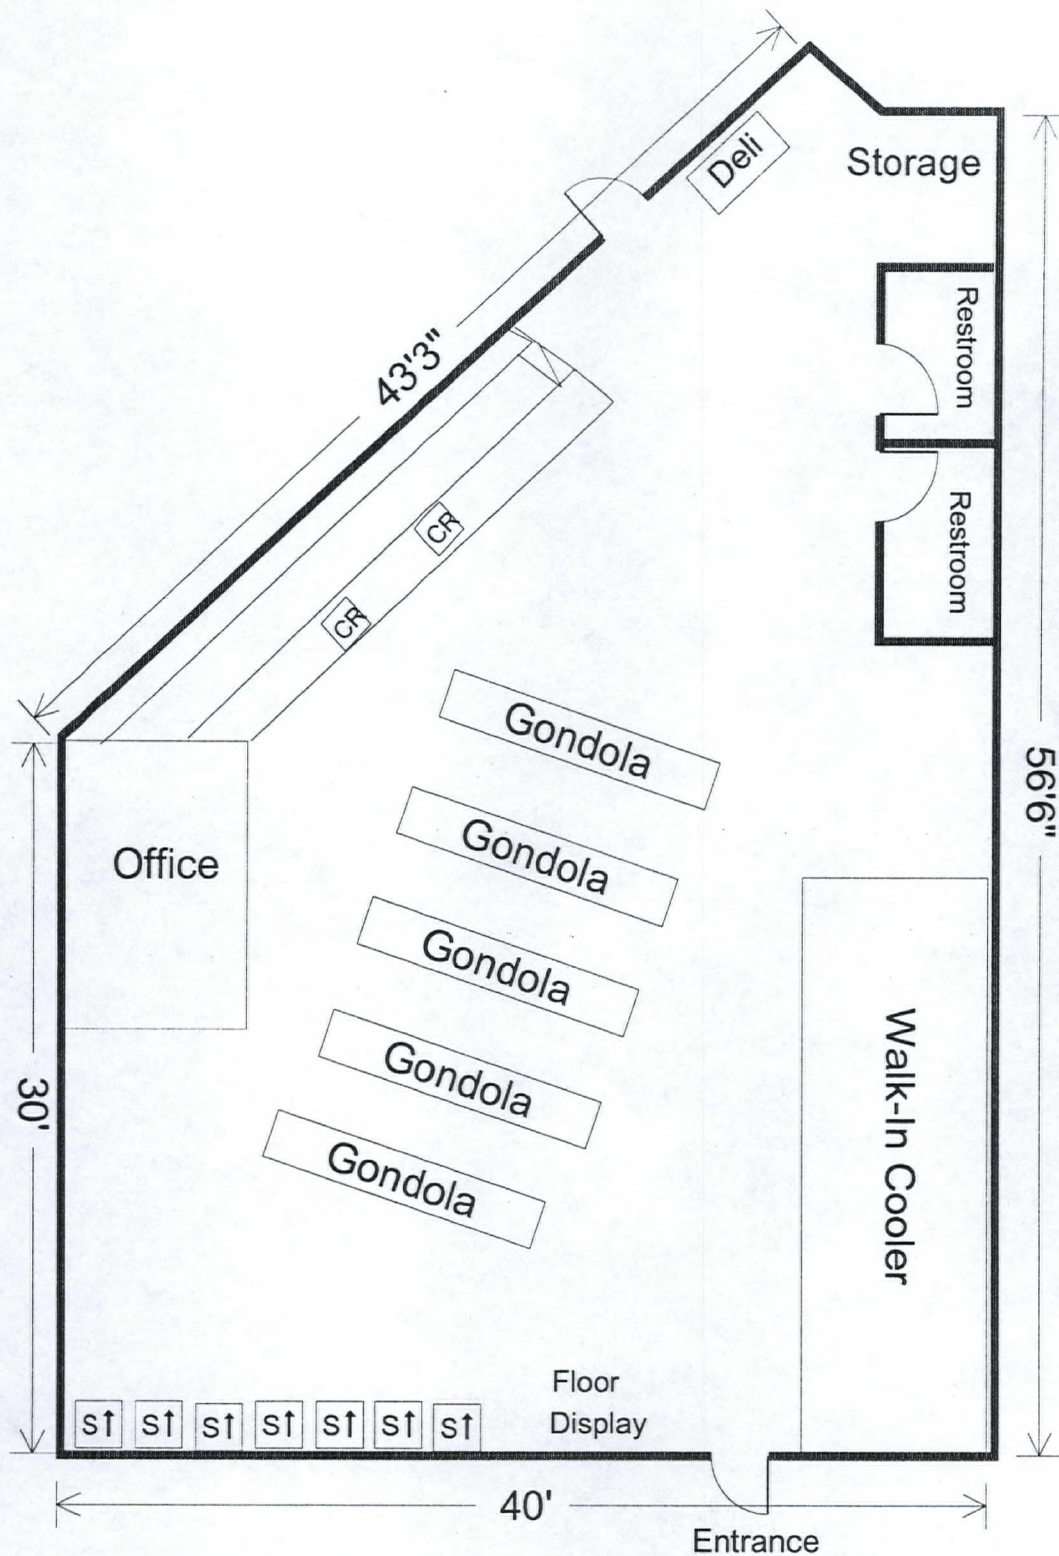

House of Vino
7181 N. Hualapai, Suite 100
Las Vegas, NV 89147

Proposed - Not yet built out

Total Sq. Ft: 1,925
48 Sq. ft of Walk-in Cooler
dedicated to Beer & Wine

125 Sq. ft of Liquor on shelves
behind counter/registers

Total Sq.Ft for Beer/Wine/Liquor: 173

RECEIVED

SUP-34765
07/23/09 PC

JUN 05 2009