



PLANNING & DEVELOPMENT DEPARTMENT

STATEMENT OF FINANCIAL INTEREST

Case Number: SUP-34598 APN: 162-09-102-002

Name of Property Owner: 2701 WESTWOOD LLC, ROBERT BRANDO

Name of Applicant: DR. KIT WEATHERS

Name of Representative: LAW OFFICES OF JAY BROWN

To the best of your knowledge, does the Mayor or any member of the City Council or Planning Commission have any financial interest in this or any other property with the property owner, applicant, the property owner or applicant's general or limited partners, or an officer of their corporation or limited liability company?

☐ Yes

☒ No

If yes, please indicate the member of the City Council or Planning Commission who is involved and list the name(s) of the person or persons with whom the City Official holds an interest. Also list the Assessor's Parcel Number if the property in which the interest is held is different from the case parcel.

City Official: _____

Partner(s): _____


APN: _____


Signature of Property Owner: 


Print Name: Robert Brandy

Subscribed and sworn before me

This 26th day of May, 20 09

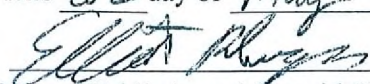
Notary Public in and for said County and State

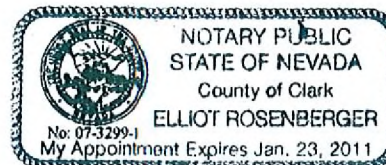

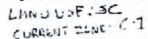

LANDUSE DESIGNATION: COMMERCIAL
CURRENT ZONE: INDUSTRIAL "M"

EXISTING HOTEL

EXISTING PARKING

LAND USE DESIGNATION
L.P.

CURRENT ZONE: M-INDU

EXISTING
CREEP
PRINTING.

CURRENT USE: WAREHOUSE

PRESIDIO DRIVE

SYMBOL LIST

- [illegible]

PROPERTY INFORMATION

APN: 162-09-102-002

LAND USE DESIGNATION, COMM

CURRENT TONE: INDUSTRIAL

CURRENT USE:
OFFICE & WAREHOUSE

CURRENT LAND USE: COMMERCIAL
PROPOSED LAND USE: INDUSTRIAL
CURRENT ZONE: M
PROPOSED ZONE: M

PARKING ANALYSIS
REQUIRED.

REQUIRED. 20 SPACES

2 SPACE / 20 RESIDENTS

FOR CUSTODIAL INSTITUTIONS

1 SPACE/300 SOFT = 17 SPACES


FOR EXISTING 2ND STORY
OFFICE

1 SPACE / 250 SOFT = 4 SPACES

FOR PET BOARDING

PROVIDED : = 32 SPACES

☆ NO TREES TO BE REMOVED FROM NORTHERN BOUNDARY

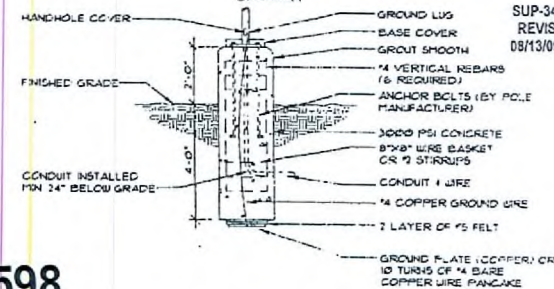

SUP-34598
REVISED
08/13/09 PC

RECEIVED
JUL 22 1966

RECEIVED
JUL 22 2009

LAND USE DESIGNATION: INDUSTRIAL "LIGHT"
CURRENT ZONING INDUSTRIAL M"
USE ADULT

SUP-34598
REVISED
08/13/09 PC

TYPICAL POLE BASE

RECEIVED

revisions


GENERAL PLAN AMENDMENT

162-09-102-002

FROM C TO LI

date	
proj.no.	
drwn.by	
chkd.by	

E-1

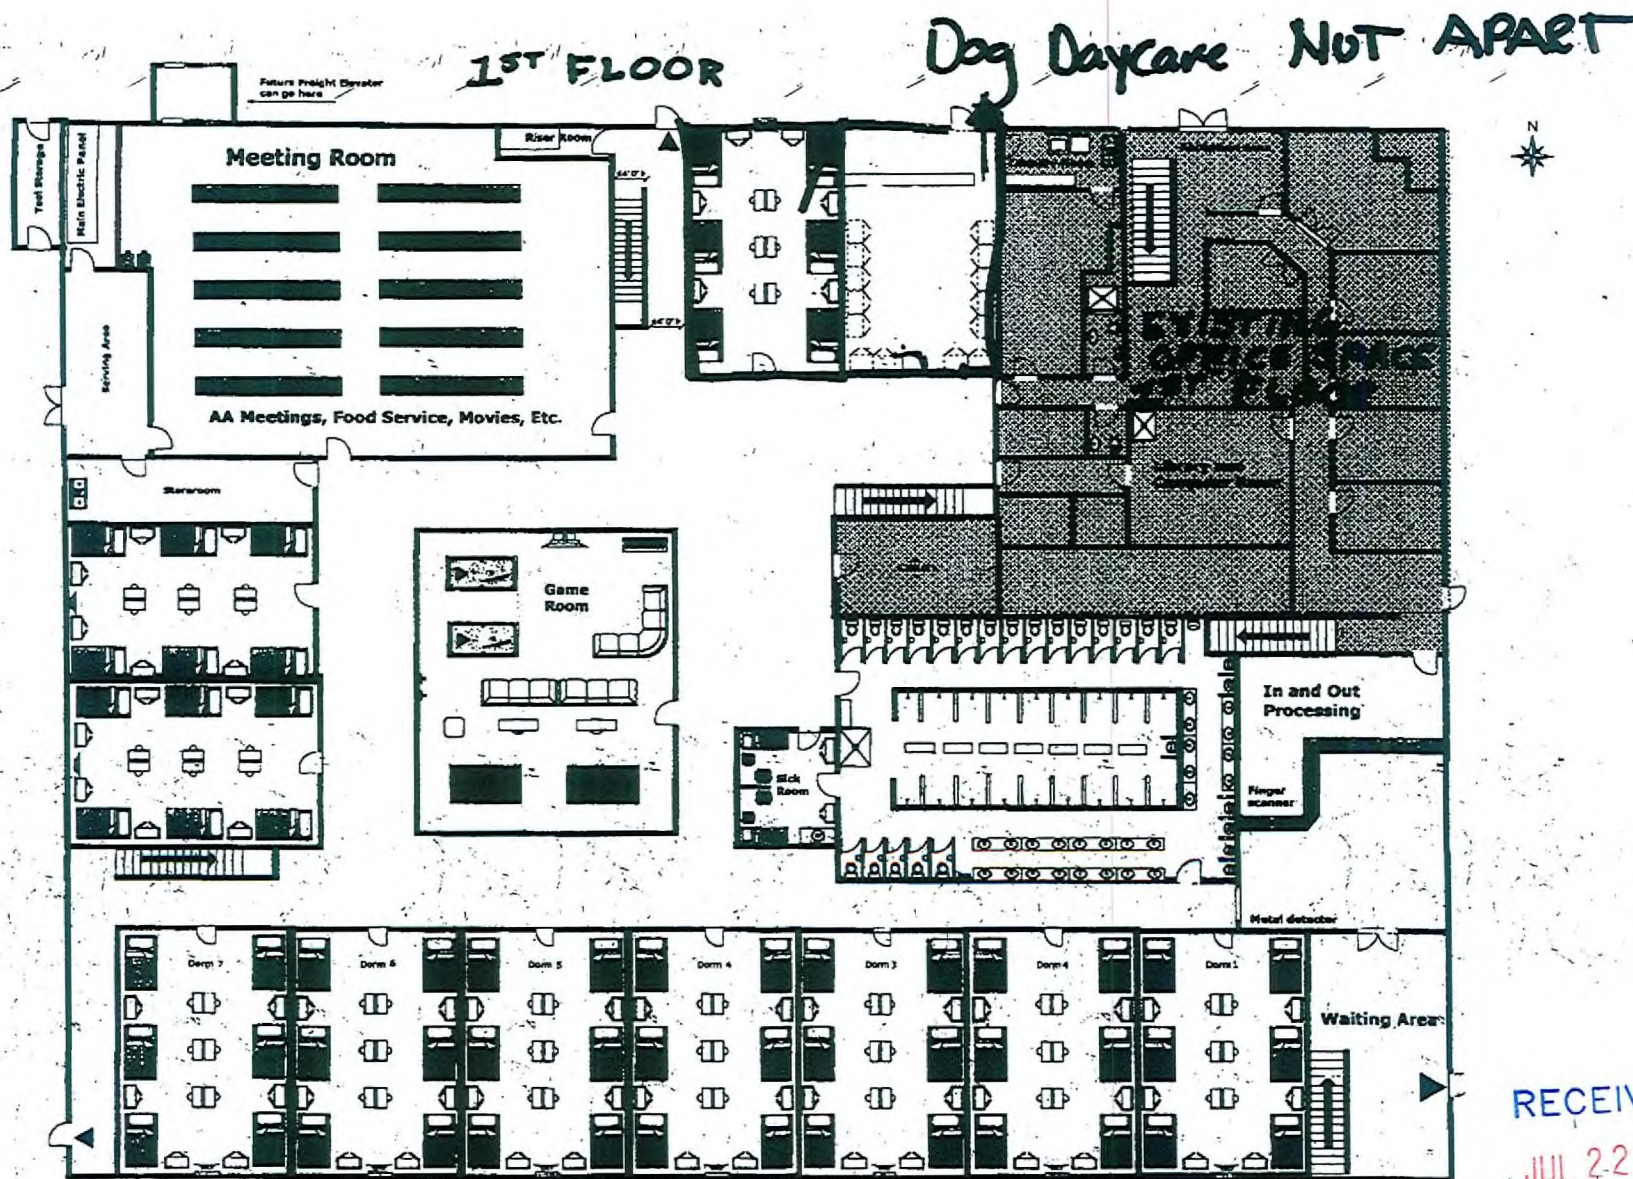

2701 Westwood Drive - First Floor - Ten 30' x 20' Dorms - 12 people per dorm
Golden Passages - 702-341-0987

SUP-34598

REVISED

08/13/09 PC

RECEIVED

JUL 22 2009