



PLANNING & DEVELOPMENT DEPARTMENT

STATEMENT OF FINANCIAL INTEREST

Case Number: **SDR-33880** APN: 139-35-211-041

Name of Property Owner: TIE INC.

Name of Applicant: CBS Outdoor

Name of Representative: Ryan Arnold

To the best of your knowledge, does the Mayor or any member of the City Council or Planning Commission have any financial interest in this or any other property with the property owner, applicant, the property owner or applicant's general or limited partners, or an officer of their corporation or limited liability company?

☐ Yes

☒ No

If yes, please indicate the member of the City Council or Planning Commission who is involved and list the name(s) of the person or persons with whom the City Official holds an interest. Also list the Assessor's Parcel Number if the property in which the interest is held is different from the case parcel.

City Official: _____

Partner(s): _____

APN: _____

Signature of Property Owner: Albert Lewis

Print Name: ALBERT LEWIS

Subscribed and sworn before me

This 18th day of March, 2009

Regine C Skancke
Notary Public in and for said County and State



ZONING

C-1 LIMITED COMMERCIAL

GENERAL NOTES

2. NOT WITHIN 100 FOOT OF AN ON-PREMISE SIGN ON ADJOINING PROPERTY.
4. NO PARKING SPACES WILL BE TAKEN FOR THIS LOCATION.

CBS


795-3325

OWNER:

TIE, INC.

SITE LOCATION:

333 N. 11TH STREET

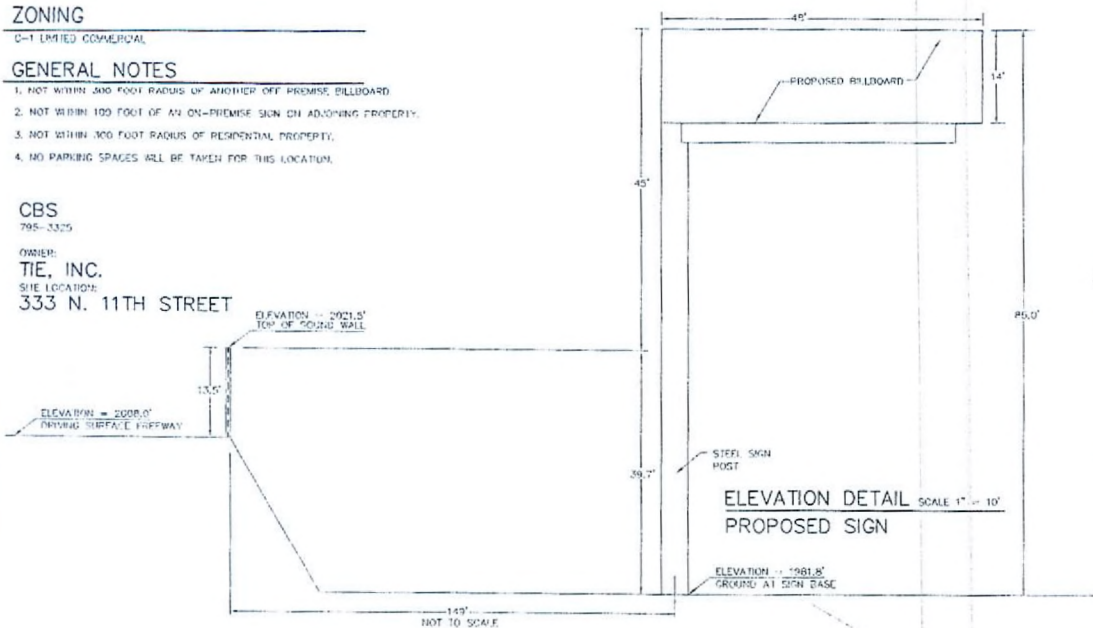


LEGEND




--- STREET CENTERLINE
--- PROPERTY LINE
--- CHAIN LINK FENCE



VICINITY MAP NO SCALE

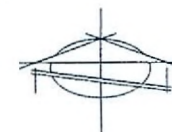

SCALE 1" = 20'

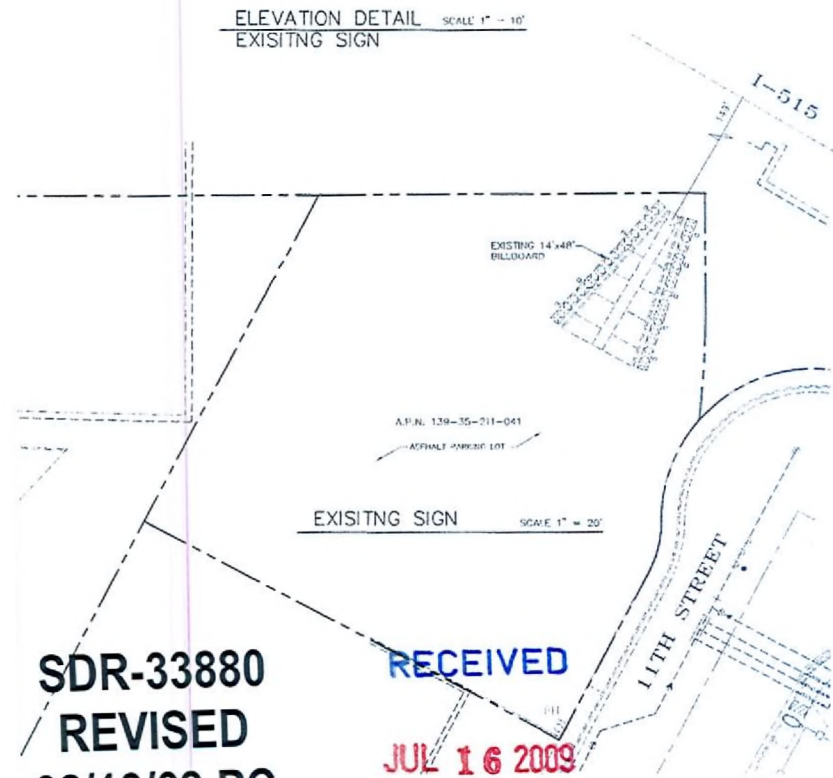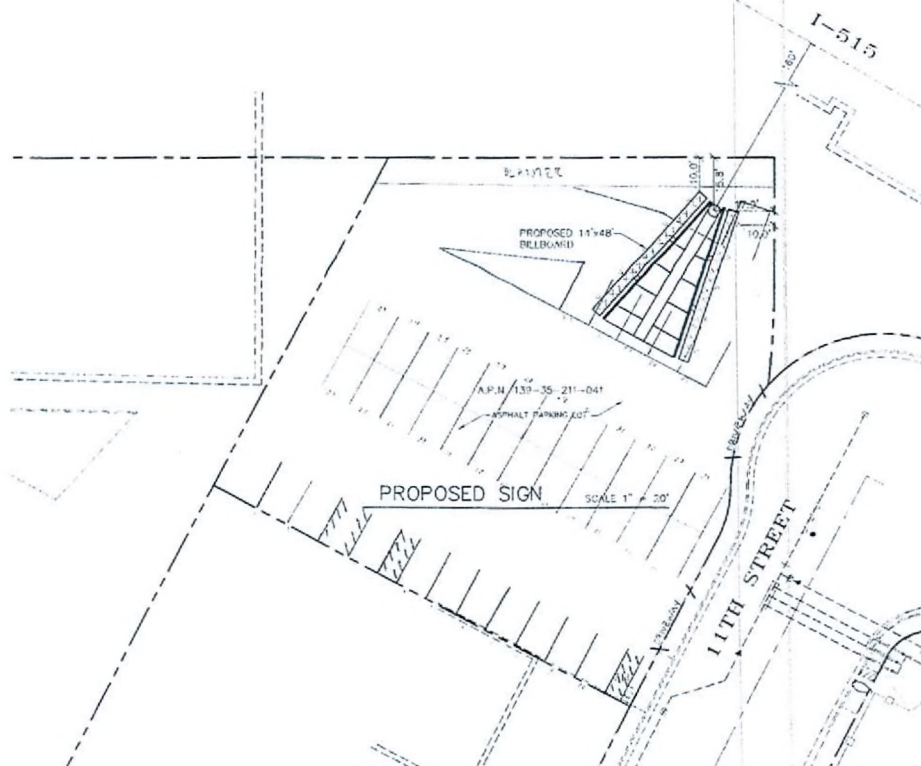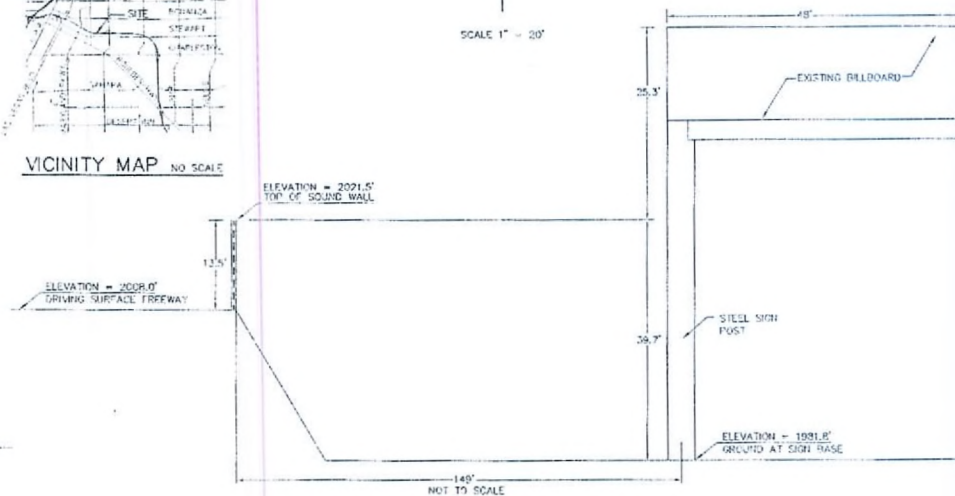

**SDR-33880
REVISED
08/13/09 PC**

**RECEIVED
JUL 16 2009**