


SAHARA AVE

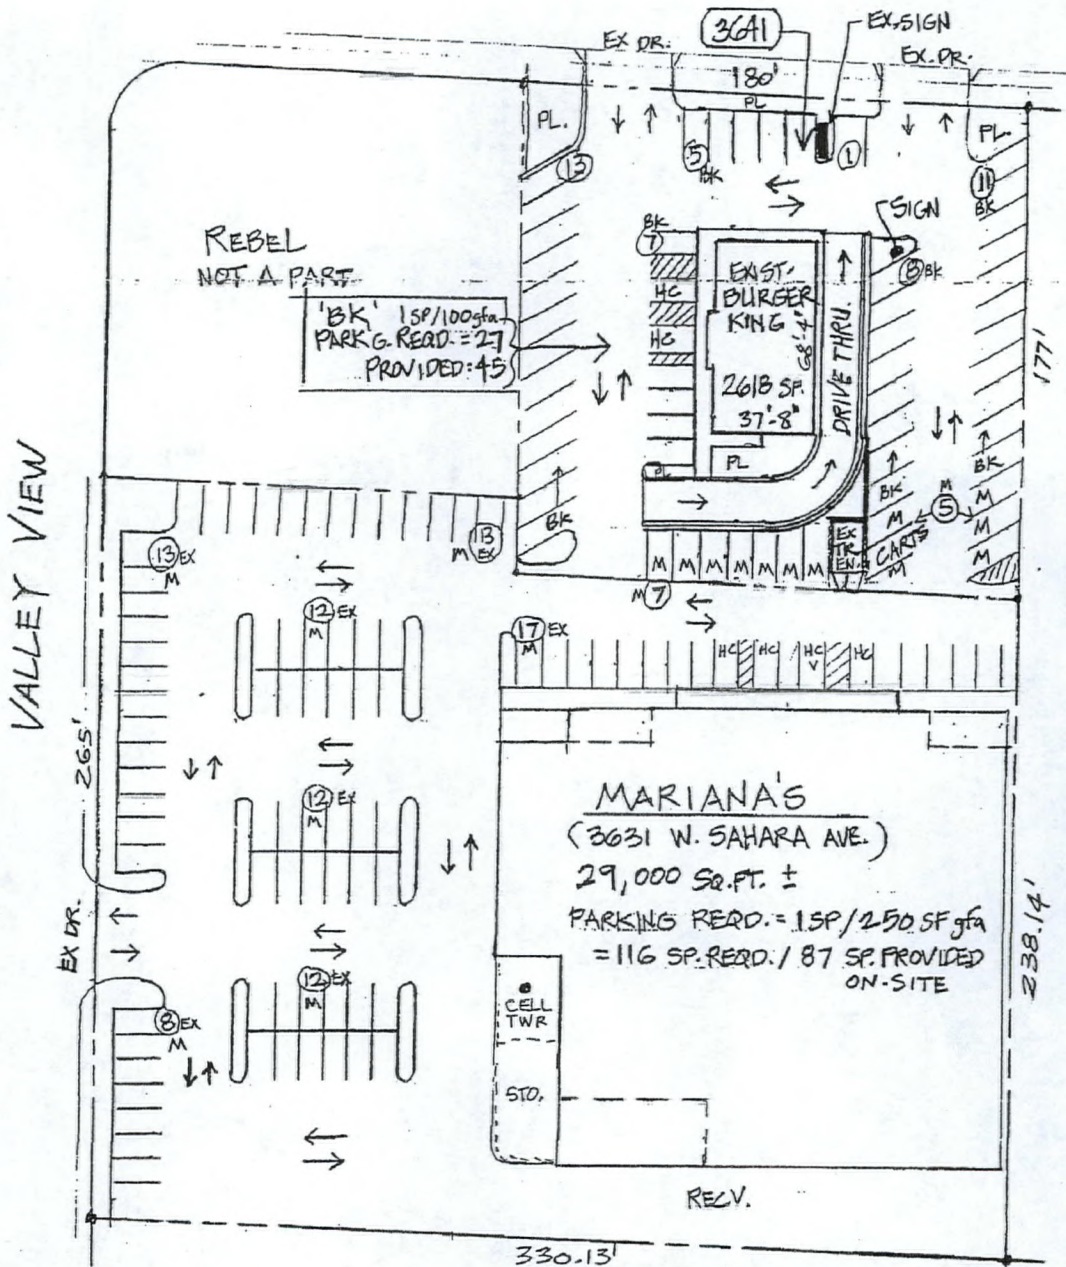

RECEIVED
JUL 13 2009

MARIANA'S
PARKING - ONSITE: 87 SP.
(EX. BK) OFFSITE: 12 SP.
TOTAL PARKING: 99 SP.

PROPOSED MASTER SITE PLAN


4/22/08 © ASF/GDC

SCALE: 1" = 50'

3631 & 3641 W. SAHARA AVE.



SUP-35176
08/27/09 PC

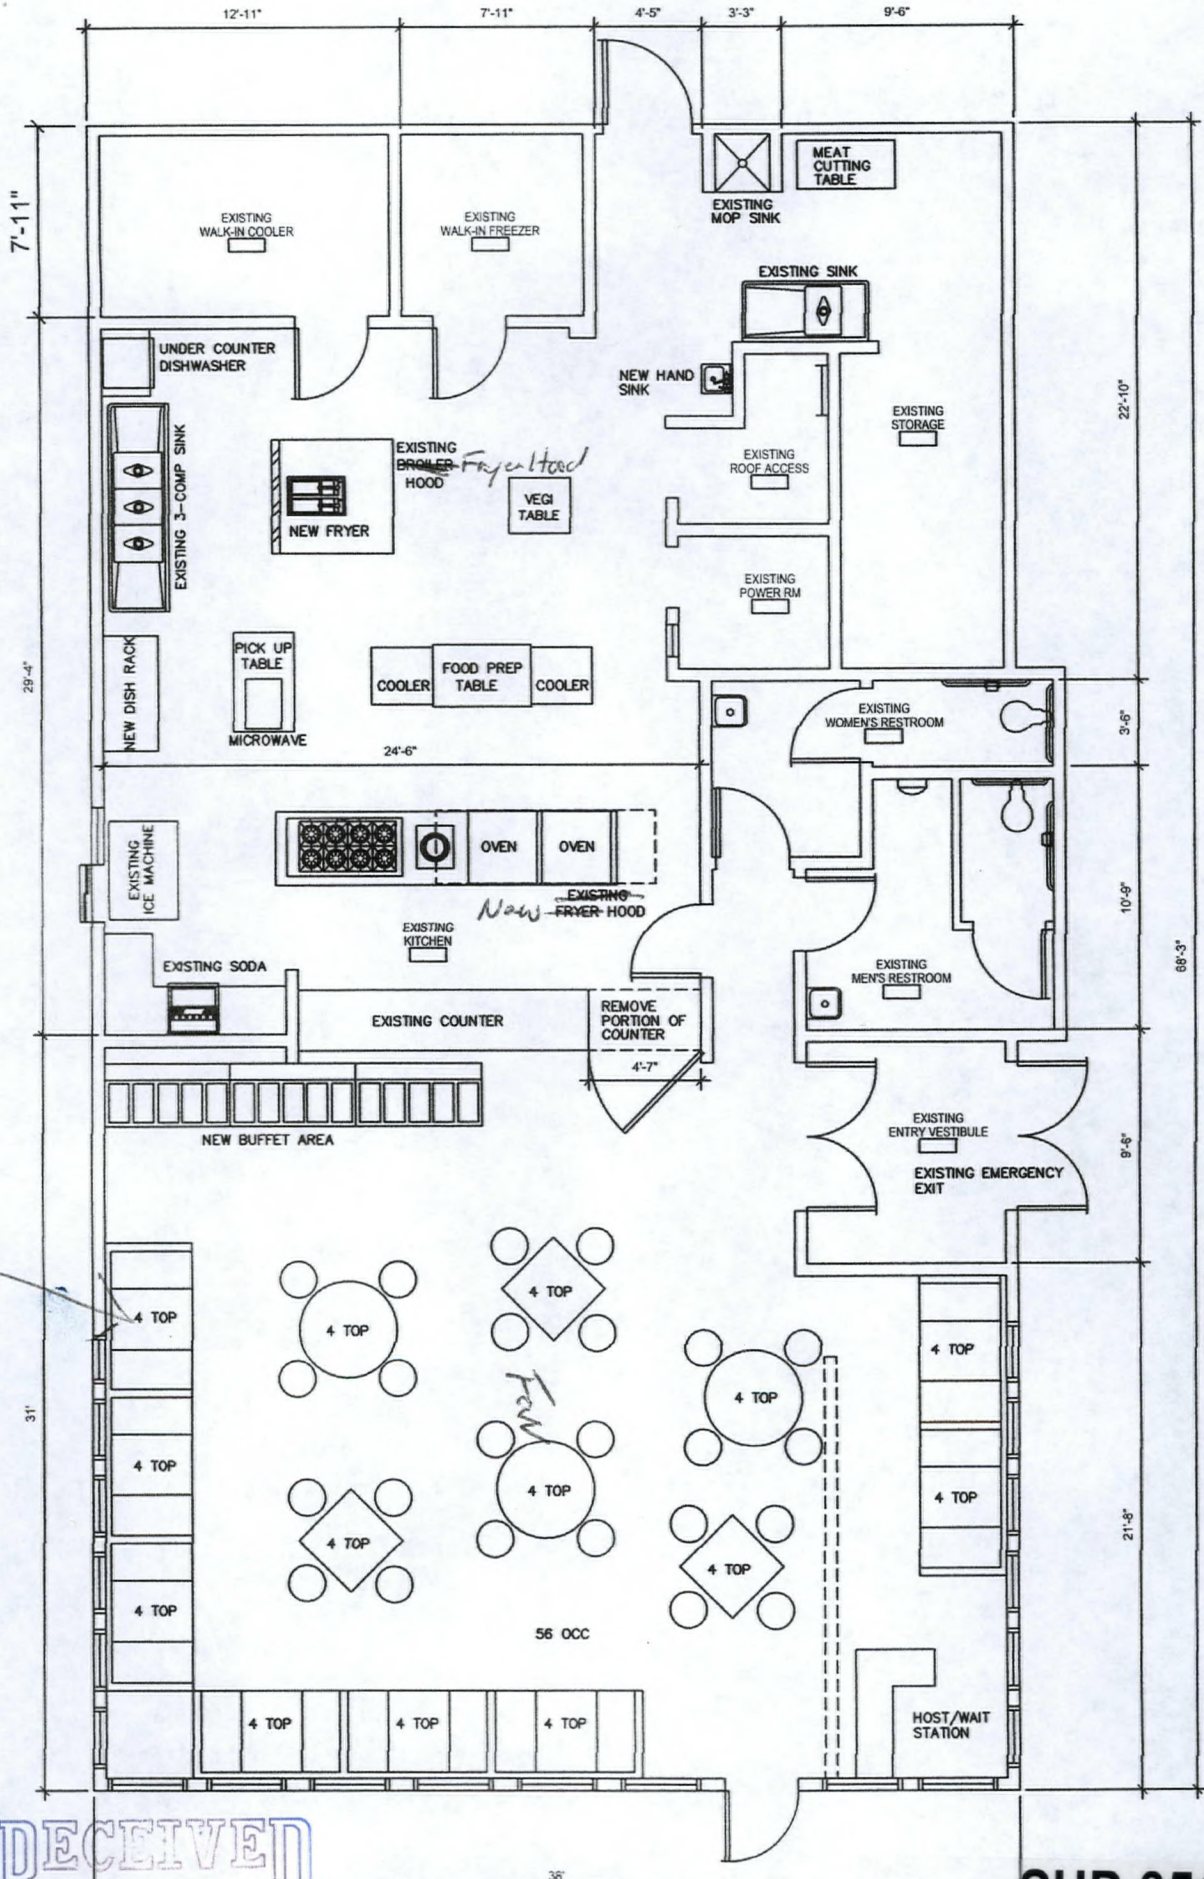

RECEIVED
JUL 13 2009

1,238.25 S.F. = KITCHEN = 6.19 OCCUPANTS
288.68 S.F. = RESTROOMS/VESTIBULE = 1 OCCUPANT
FIXED SEATING = RESTAURANT = 56 OCCUPANTS
63 TOTAL OCCUPANT LOAD

SUP-35176
08/27/09 PC