



PLANNING & DEVELOPMENT DEPARTMENT

STATEMENT OF FINANCIAL INTEREST

Case Number, **RQR-35268** ^{139 27410 005} APN: 13933511004, 13933511007, 13933610 014
Name of Property Owner: World Market Center
Name of Applicant: Clean Channel Outdoor
Name of Representative: Red Carter

To the best of your knowledge, does the Mayor or any member of the City Council or Planning Commission have any financial interest in this or any other property with the property owner, applicant, the property owner or applicant's general or limited partners, or an officer of their corporation or limited liability company?

_____ Yes

X No

If yes, please indicate the member of the City Council or Planning Commission who is involved and list the name(s) of the person or persons with whom the City Official holds an interest. Also list the Assessor's Parcel Number if the property in which the interest is held is different from the case parcel.

City Official: _____

Partner(s): _____

APN: _____

Signature of Property Owner: _____

Print Name: Jack Kasham

Subscribed and sworn before me

This 20 day of July, 2009

Jessica Green
Notary Public in and for said County and State




LEGEND

- STREET CENTERLINE
- ORIGINAL PROPERTY LINE
- NEW PROPERTY LINE (LOT LINE)
- NDOT PERMANENT EASEMENT LINE
- NDOT PERMANENT EASEMENT AREA
- ACCESS ROADWAY

CURVE TABLE				
CURVE	LENGTH	RADIUS	TANGENT	DELTA
C1	10.15	245.50	7.57	03°34'31"
C2	384.98	875.00	148.62	17°22'00"
C3	288.90	659.00	148.46	20°28'00"
C4	19.36	775.00	9.70	01°28'01"
C5	306.10	775.00	156.50	22°42'29"
C6	228.24	775.00	166.62	24°18'00"
C7	88.54	785.00	34.79	05°08'00"
C8	45.39	120.00	22.97	21°34'24"

LINE TABLE		
LINE	LENGTH	BEARING
L1	5.31	N50°22'00"E
L2	7.64	S01°17'49"E
L3	16.18	S01°17'49"E
L4	5.90	S15°22'00"E

LICENSE EXHIBIT B
dated July 28, 1999

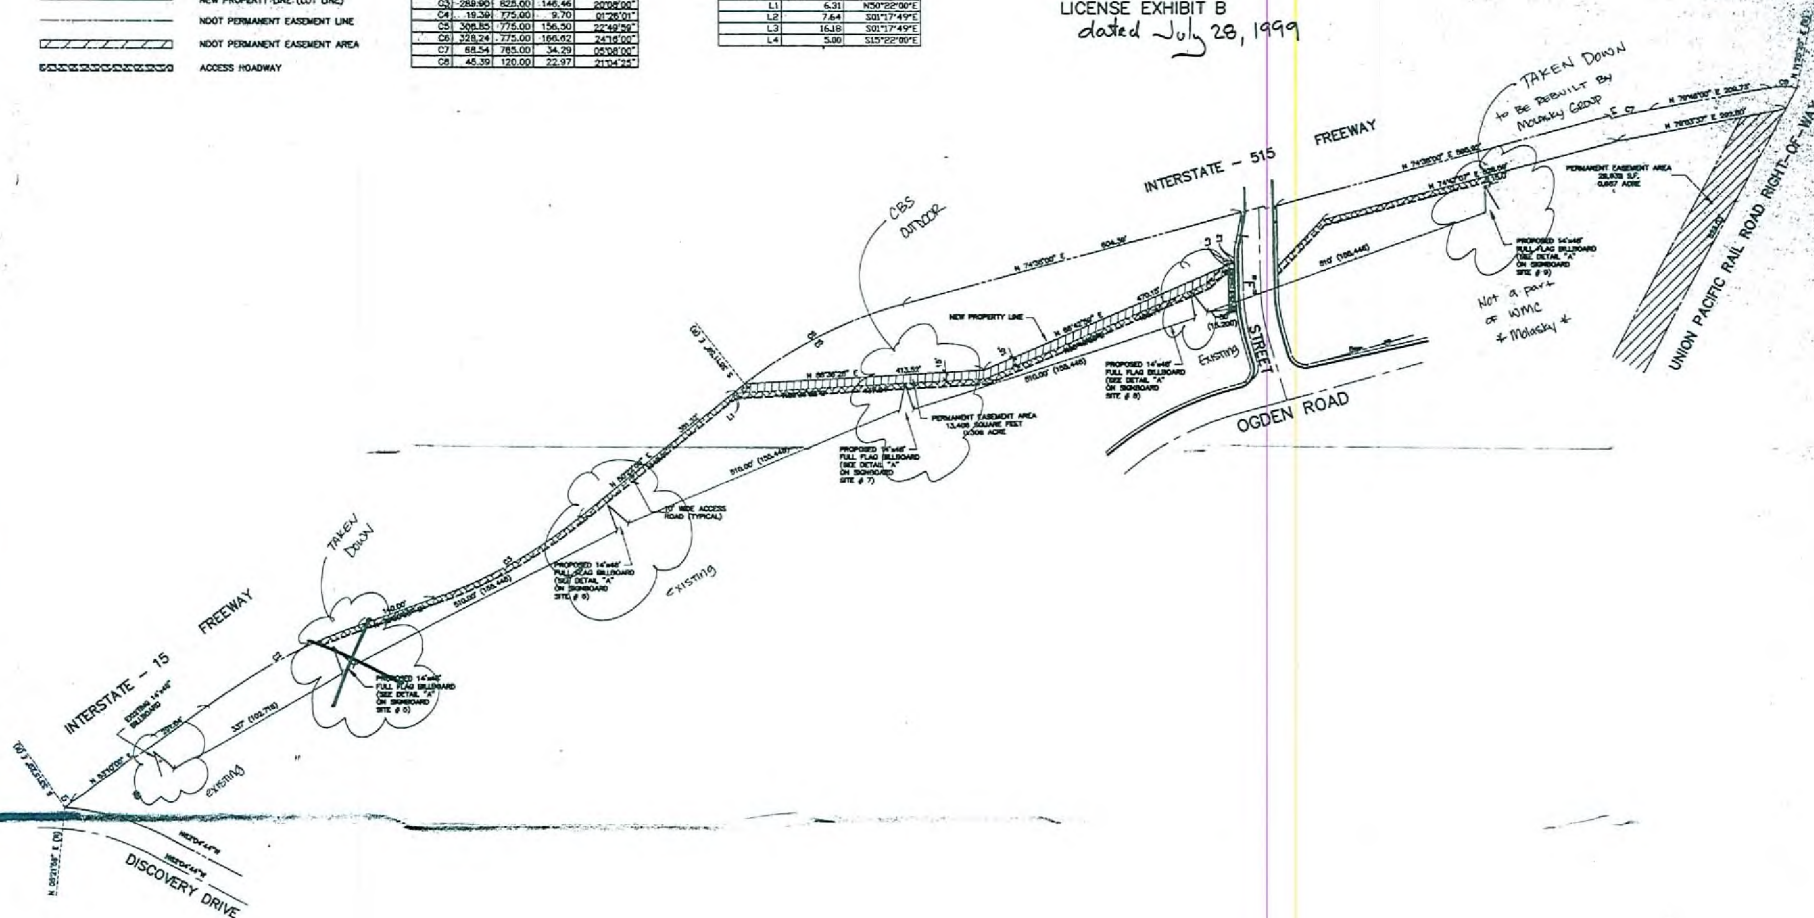

RECEIVED

JUL 20 2009

RQR-35268
09/10/09 PC

DOUGLAS MEDIA CORPORATION

BAUGHMAN & TURNER, INC.

BILLBOARD ACCESS MAP

IN





CURVE DATA			
CURVE	LENGTH	RADIUS (TANGENT)	DELTA
C1	70.35	450.00	35.26
C2	159.52	350.00	69.52
C3	11.28	300.00	5.69
C4	181.80	350.00	92.70
C5	157.04	35.18	103.91
C6	84.45	30.12	33.52
C7	83.35	30.12	30.84
C8	1272.29	6675.00	638.08

LICENSE EXHIBIT B
dated July 28, 1999

LEGEND

- STREET CENTERLINE
- ORIGINAL PROPERTY LINE
- NEW PROPERTY LINE (LOT LINE)
- PERMANENT EASEMENT LINE
- PERMANENT EASEMENT AREA
- ACCESS ROADWAY

SCALE 1" = 40'

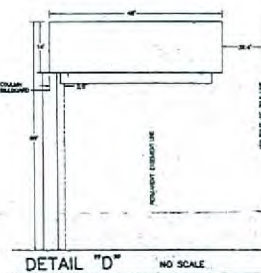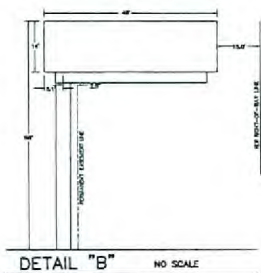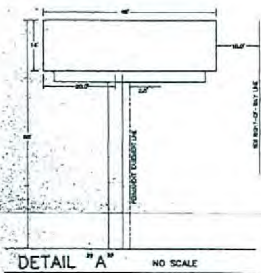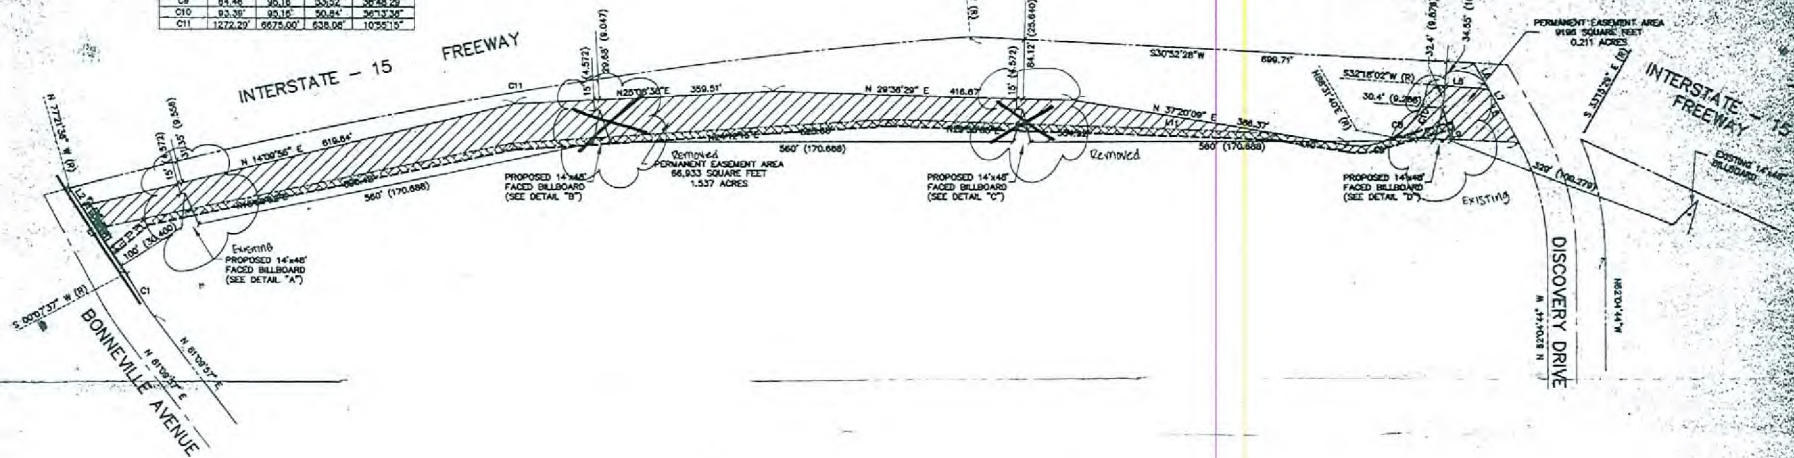

RECEIVED
JUL 20 2009

RQR-35268
09/10/09 PC