



PLANNING & DEVELOPMENT DEPARTMENT

STATEMENT OF FINANCIAL INTEREST

Case Number: **WVR-35710** APN: 125-20-810-002
Name of Property Owner: Montecito Partners LLC
Name of Applicant: Montecito Partners LLC
Name of Representative: Martin Harris Construction

To the best of your knowledge, does the Mayor or any member of the City Council or Planning Commission have any financial interest in this or any other property with the property owner, applicant, the property owner or applicant's general or limited partners, or an officer of their corporation or limited liability company?

☐ Yes

☒ No

If yes, please indicate the member of the City Council or Planning Commission who is involved and list the name(s) of the person or persons with whom the City Official holds an interest. Also list the Assessor's Parcel Number if the property in which the interest is held is different from the case parcel.

City Official: _____

Partner(s): _____

APN: _____

Signature of Property Owner: _____

Print Name: Michael S. Curless

Subscribed and sworn before me


This 31st day of March, 2009

[Signature]
Notary Public in and for said County and State



Sarah E. Kuester
#553566
Hamilton County
My Commission Expires on:
September 11, 2014

ATCH LINE - SEE SHEET C2-2

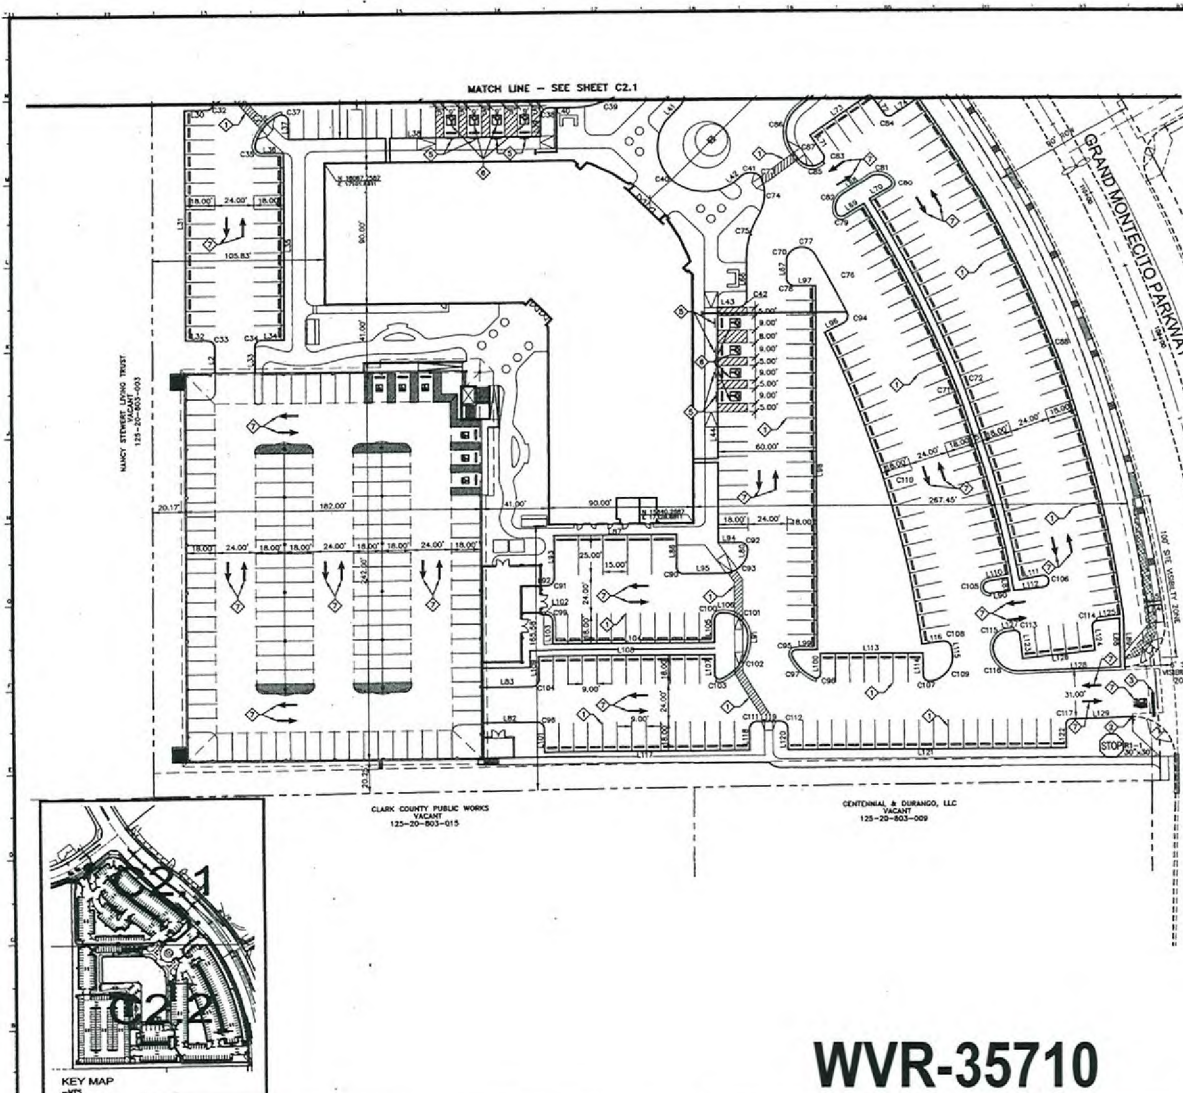


BASIS OF BEARING
NORTH 89°55'17" EAST, BEING THE BEARING OF THE WEST LINE OF THE SOUTHEAST QUARTER (SE 1/4) OF THE SOUTHEAST QUARTER (SE 1/4) OF SECTION 20, TOWNSHIP 18 SOUTH, RANGE 90 EAST, N.M.S., AS SHOWN BY BOOK 113, PAGE 38 OF PLATS ON FILE AT THE CLARK COUNTY, NEVADA RECORDER'S OFFICE.

BENCHMARK
CITY OF LAS VEGAS VERTICAL CONTROL POINT "0090 2186", BEING A BRICK PLATE IN TOP OF HEADWALL ON THE WEST SIDE OF U.S. 95 & MP 88.75, ELEVATION: 2481.63 (FEET)
TBM-4077 (METERS)
CITY OF LAS VEGAS VERTICAL CONTROL V-2002 BASED ON NORTH AMERICAN VERTICAL DATUM OF 1988 (NAD 83).

CONSTRUCTION NOTES

- INSTALL 4" WIDE WHITE PAINTED STRIPE.
- CONTRACTOR TO PROVIDE SIGN AND ALL NECESSARY EQUIPMENT TO PERMANENTLY INSTALL SIGN ASSEMBLY PER CURRENT MUTCD GUIDELINES.
- INSTALL 24" WIDE WHITE STOP BAR.
- NOT USED.
- INSTALL "HANDICAP PARKING" SIGN R7-8.
- INSTALL HANDICAP PARKING PAVEMENT SYMBOL.
- INSTALL COLD POLYMER PAVEMENT LEGEND, WHITE PER CALSDOT DMS. NO. 246 (ON CONTACT PAVEMENT MARKING FILM W/ ADHESIVE APPLICATION).

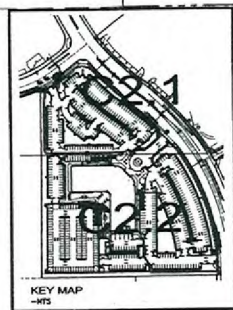

WVR-35710
10/08/09 PC

SAFETY ALERT
Call Before You Dig
1-800-485-4111

Call before you Dig
Underground
1-702-435-7511
1-702-225-5611

317-848-0500 • lauth@auth.com

LAUTH PROPERTY GROUP




RECORDING AGENCY
CLARK COUNTY
215-447-1100

CLARK COUNTY PUBLIC WORKS
VACANT
125-20-803-015

CENTENNIAL & DURANGO, LLC
VACANT
125-20-803-009

MONTECITO POINT Core and Shell
6005 Grand Montecito Parkway
Las Vegas, Nevada 89149

C2.2
10/14/839

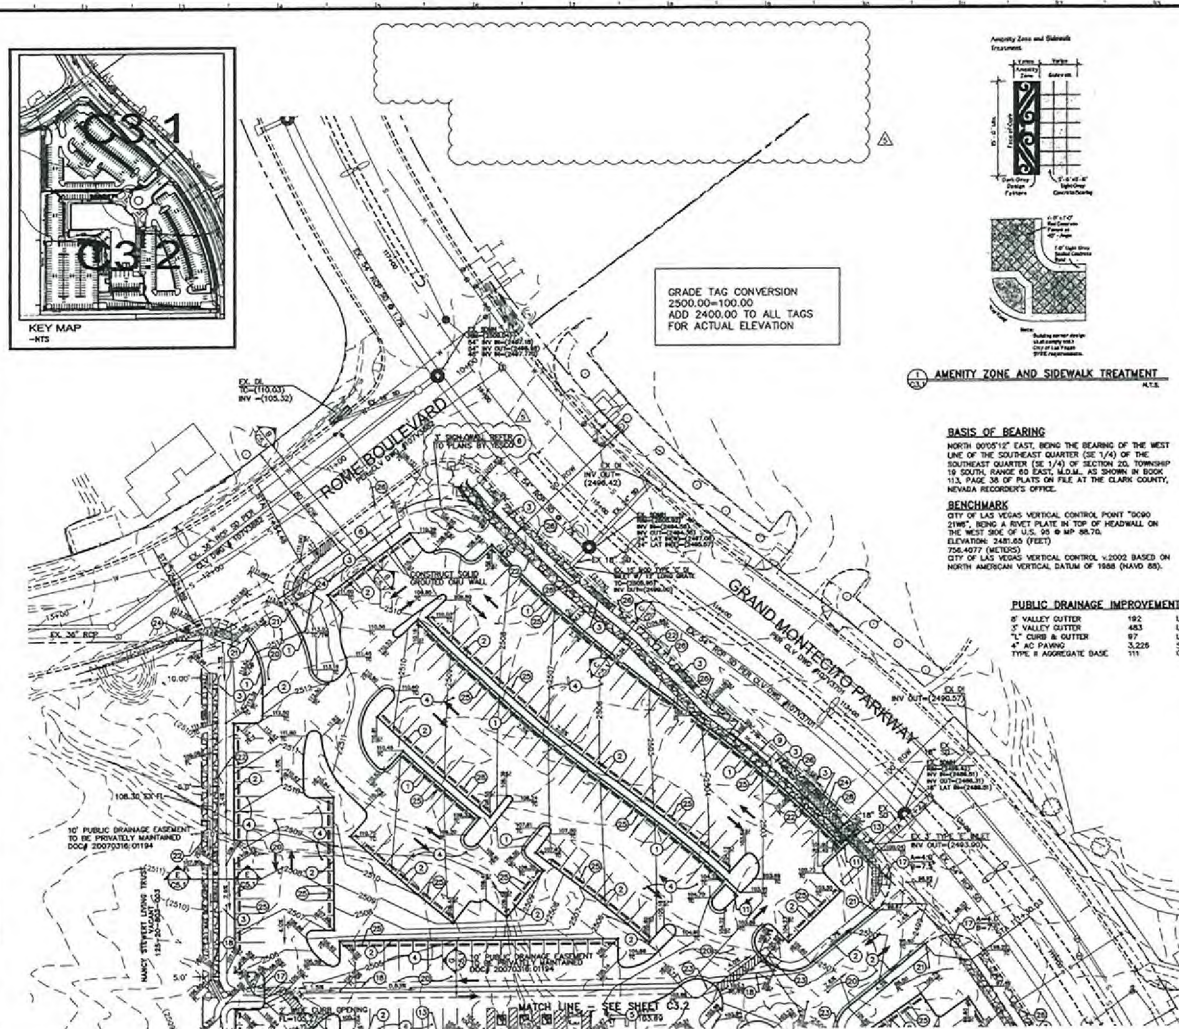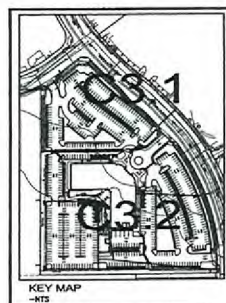

VICINITY MAP

CONSTRUCTION NOTES

- CONSTRUCT "L" TYPE CURB AND GUTTER PER CCAUSD DWG. NO. 215.
- CONSTRUCT "A" TYPE CURB PER CCAUSD DWG. NO. 216.
- CONSTRUCT CONCRETE SIDEWALK PER CCAUSD DWG. NO. 234. COORDINATE FINISHES WITH TOWN CENTER DEVELOPMENT STANDARDS PER DETAIL.
- INSTALL A MINIMUM OF 2" AC PAVEMENT OVER 4" TYPE 8 AGGREGATE BASE IN PARKING AREAS PER THE DETAIL REPORT AND DETAIL.
- INSTALL CURB-O-LET MODEL TCD 414 CURB DRAIN.
- CONSTRUCT RETAINING WALL PER SOUTHERN NEVADA BUILDING OFFICIALS REGIONAL STANDARDS DWG. NO. 8-101, REFER TO ARCHITECTURAL PLANS FOR DETAILS AND FINISH.
- INSTALL 48" TYPE 1 STORM DRAIN MANHOLE PER CCAUSD NO. 403.
- CONNECT TO BACK OF EXISTING DROP INLET PER DETAIL.
- CONSTRUCT BUS STOP PAD WITH EXCLUSIVE RIGHT TURN LANE PER CCAUSD DWG. NO. 244L.
- ROOF DRAIN STUB, REFER TO PLUMBING PLANS FOR CONTINUATION.
- CONSTRUCT 2" CONCRETE CHANNEL PER DETAIL.
- INSTALL 80" TYPE 1 STORM DRAIN MANHOLE PER CCAUSD DWG. NO. 403.
- INSTALL SIDEWALK UNDERDRAIN PER CCAUSD DWG. NO. 238. INSTALL SHEET FLOOR PLATE THROUGH LANDSCAPE AREA.
- INSTALL 24"x24" JOHNSON PRECAST DROP INLET WITH 18"x18" GRATE PER DETAIL.
- CONSTRUCT 6" CURB.
- CONSTRUCT 6" VALLEY GUTTER PER DETAIL.
- CONSTRUCT SIDEWALK RAMP (CASE 3) PER CCAUSD DWG. NO. 235.
- CONSTRUCT 3" VALLEY GUTTER PER DETAIL.
- INSTALL 48" MODEL 502 TRENCH DRAIN SYSTEM PER MANUFACTURER'S INSTRUCTIONS. SEE PLUMBING PLANS FOR COORDINATION.
- INSTALL A MINIMUM OF 4" AC PAVEMENT OVER 4" TYPE 8 AGGREGATE BASE IN TRUCK TRAFFIC AREAS PER THE DETAIL REPORT AND DETAIL.
- MATCH EXISTING.
- INSTALL 12" THICK 600-4" RIP RAP OVER 8" TYPE 8 AGGREGATE BASE OVER MEAN FIBRIC 140 N OR EQUIVALENT PER DETAIL.
- CONSTRUCT SIDEWALK RAMP PER PLAN.
- REFER TO SHEETS C01 & C02 FOR SITE VISIBILITY RESTRICTION EASEMENTS.
- INSTALL PRECAST BUMPER BLOCK PER CCAUSD NO. 238.
- INSTALL TREE GRATE FOR TOWN CENTER DEVELOPMENT STANDARDS FIGURE 23, REFER TO LANDSCAPE PLANS.
- CONSTRUCT KEYSTONE RETAINING WALL PER MANUFACTURER'S RECOMMENDATIONS, MAX HEIGHT=18".
- CONSTRUCT RETAINING WALL, MAX HEIGHT=7.5'. REFER TO STRUCTURALS.

FLOOD ZONE

THIS SITE IS LOCATED WITHIN ZONE X, AREAS DETERMINED TO BE OUTSIDE OF THE 63% ANNUAL CHANCE FLOODPLAIN (100-YEAR) ZONE PER THE FEDERAL EMERGENCY MANAGEMENT AGENCY (FEMA) FLOOD INSURANCE MAP, COMMUNITY PANEL 32000301743 E DATED SEPTEMBER 27, 2002.

NOTES

I CERTIFY THAT THIS GRADING PLAN IS IN CONFORMANCE WITH THE APPROVED DRAINAGE STUDY NO. 4066 FOR THIS PROJECT.

Richard A. Moles, P.E. 10351
DATE


SAFETY ALERT
Call before you dig
1-800-227-4111

Call before you dig
1-702-459-7311
1-702-223-6811


Call before you dig
1-702-459-7311
1-702-223-6811

LAUTH

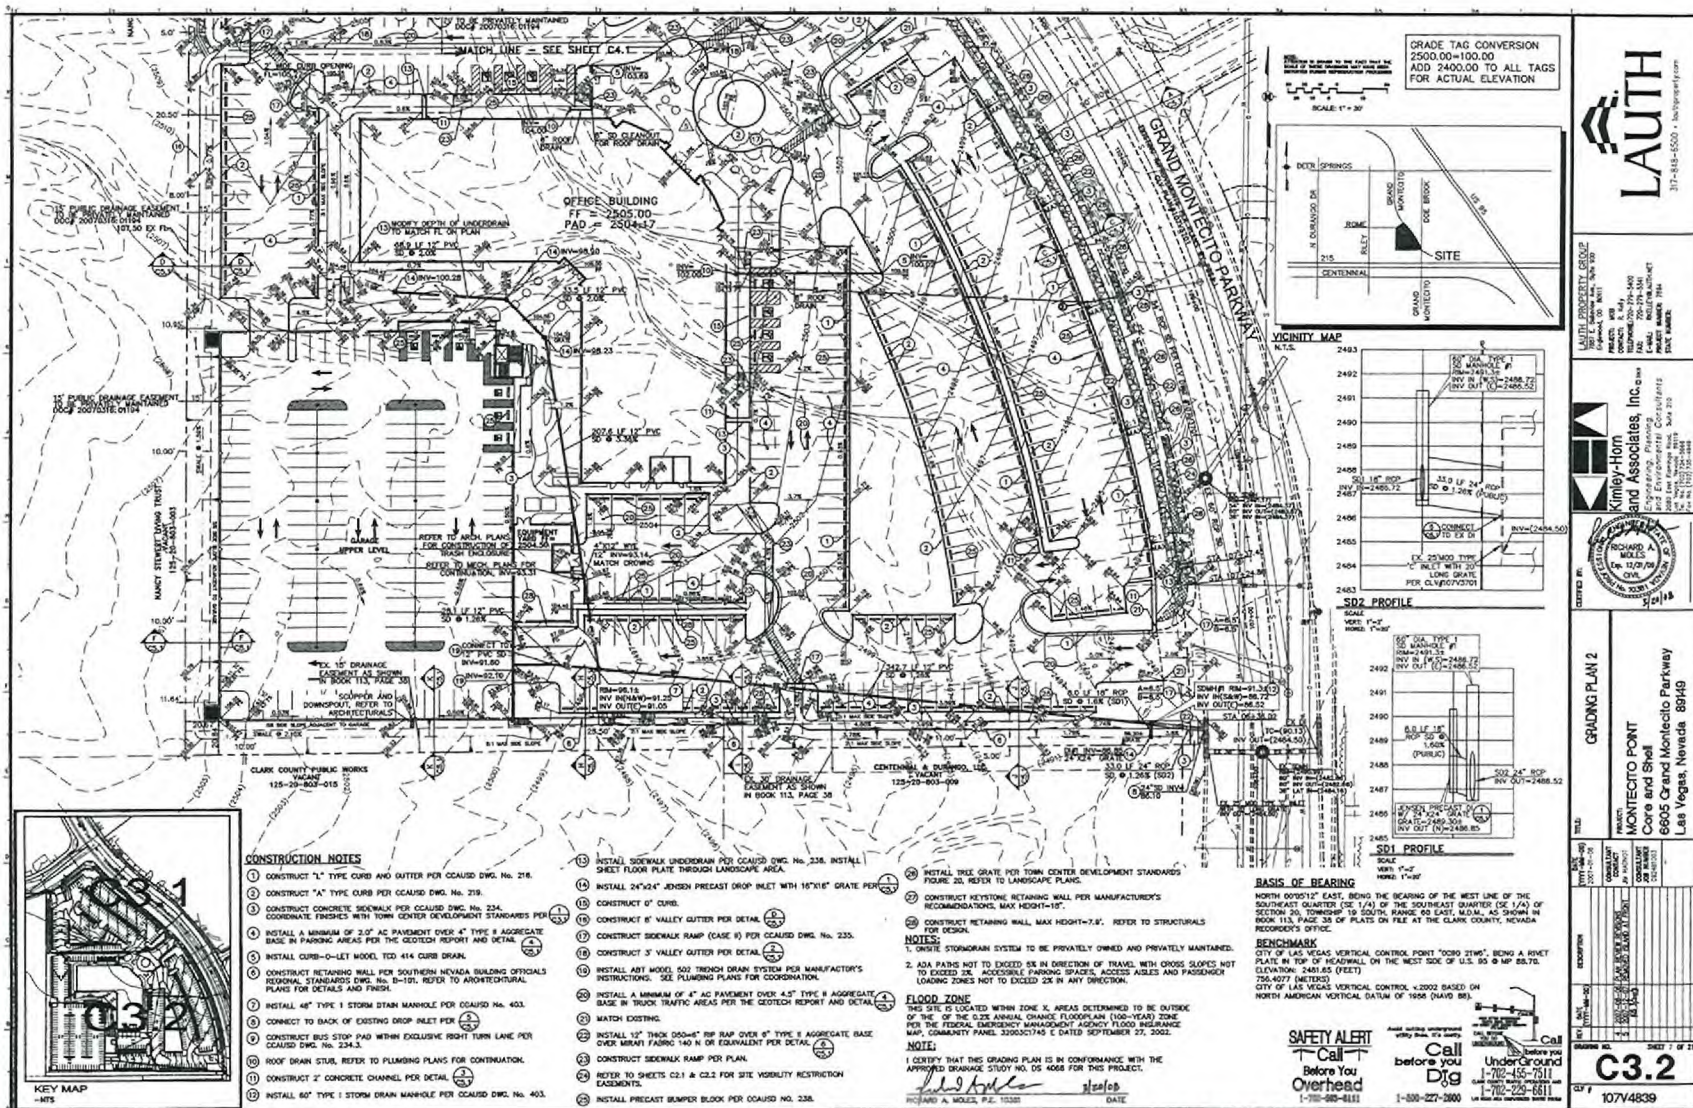

WVR-35710
10/08/09 PC

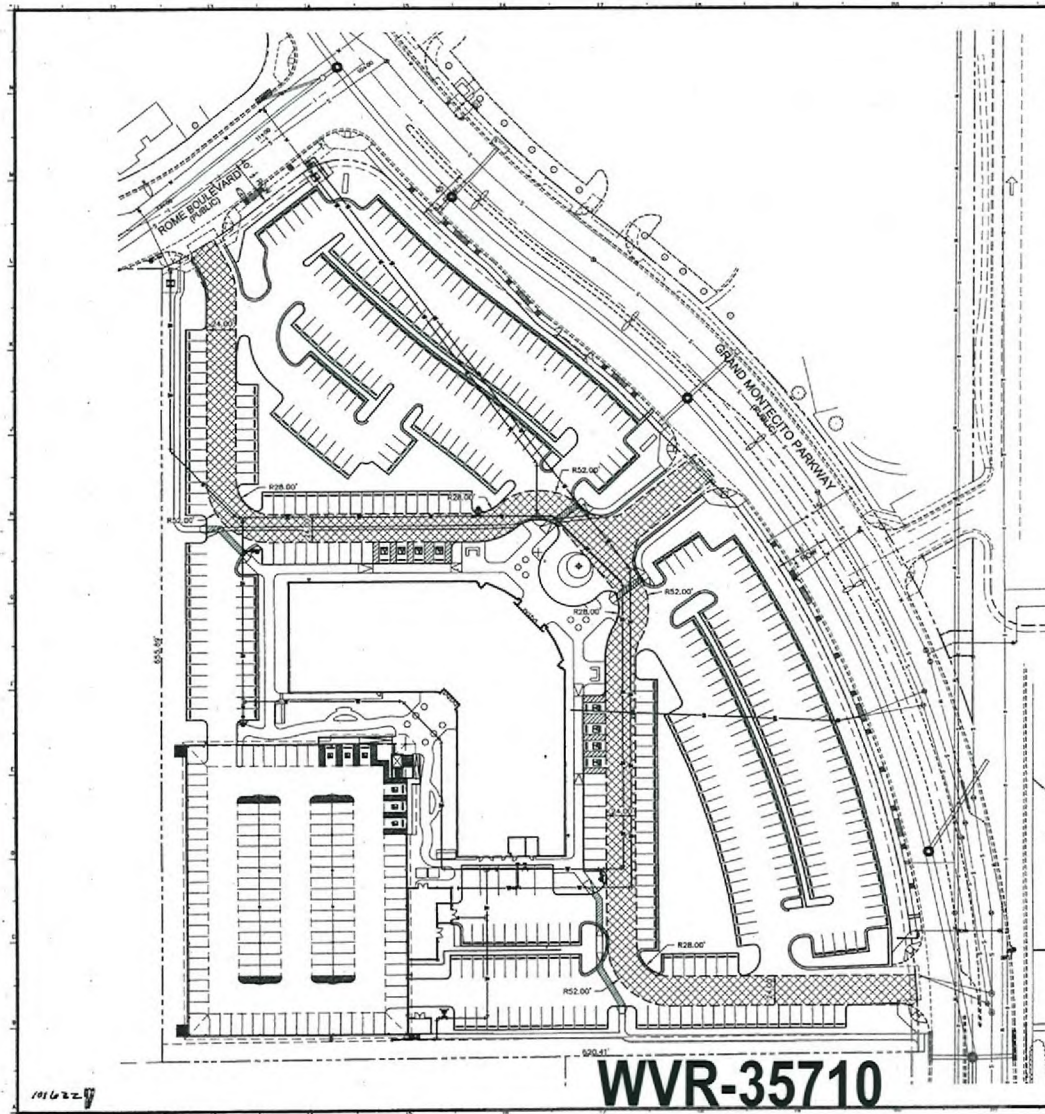

QUANTITIES

2" WATER METER	2 EA
15" WATER METER	1 EA
2" SERVICE SADDLE	1 EA
15" SERVICE SADDLE	1 EA
10" O.D.A.	2 EA
8" PVC C-100 W.	21 LF
18" R.F. REDUCER	2 EA
8" 22.50/0.00W	1 EA



AREA MAP

N.T.S.



BASIS OF BEARING
NORTH 09°00'07" EAST, BEING THE BEARING OF THE WEST LINE OF THE SOUTHEAST QUARTER (SE 1/4) OF THE SOUTHEAST QUARTER (SE 1/4) OF SECTION 28, TOWNSHIP 19 SOUTH, RANGE 10 EAST, W.D.M., AS SHOWN IN BOOK 113, PAGE 38 OF PLATS ON FILE AT THE CLARK COUNTY, NEVADA RECORDER'S OFFICE.

BENCHMARK
CITY OF LAS VEGAS VERTICAL CONTROL POINT "0680 2140", BEING A REVIET PLATE IN TOP OF HEADWALL ON THE WEST SIDE OF U.S. 95 @ WP 85.70, ELEVATION: 3481.65 (FEET) 756.4077 (METERS)
CITY OF LAS VEGAS VERTICAL CONTROL - 2002 BASED ON NORTH AMERICAN VERTICAL DATUM OF 1985 (NAVD 83)

LEGEND
FIRE ACCESS ROUTE
FIRE HYDRANT

FIRE FLOW DATA CALCULATIONS

FIRE FLOW REQUIREMENT IS 3,372 GALLONS PER MINUTE AT 20 PSI RESIDUAL PRESSURE
BASED ON:
SQUARE FOOTAGE (TOTAL): 182,410 SQUARE FEET
LARGEST AREA BETWEEN 4 HR AREA SEPARATION WALLS: 182,410 SQUARE FEET
AREA OF THREE LARGEST SUCCESSIVE FLOORS: 33,200 SQUARE FEET
BUILDING HEIGHT: 34.8 FEET
NUMBER OF STORIES: 8 FLOORS
TYPE OF CONSTRUCTION: I-A
OCCUPANCY: 0
FULL AUTOMATIC FIRE SPRINKLER SYSTEM: YES ☒ NO ☐
REVIEWED BY: [Signature] DATE: 2/10/07
CLARK COUNTY FIRE DEPT.

APPROVED FOR CONSTRUCTION
[Signature] 2/10/07
Las Vegas Urban Water Utility
PLANSHEET 112803

SAFETY ALERT
Call Before You Dig
1-800-455-7511
1-800-227-3886

Call Before You Dig
Under Ground
1-800-455-7511
1-800-227-3886

LAUTH
317-644-6500 • lauth@lauth.com

LAUTH PROPERTY GROUP


RECEIVED
2/10/07
CLARK COUNTY FIRE DEPT.

FIRE ACCESS PLAN
PROJECT: MONTECITO POINT
Core and Shell
6605 Grand Montecito Parkway
Las Vegas, Nevada 89149

DATE 2/10/07
SCALE 1" = 40'
DATE 2/10/07
SCALE 1" = 40'
WVR-35710

10/08/09 PC

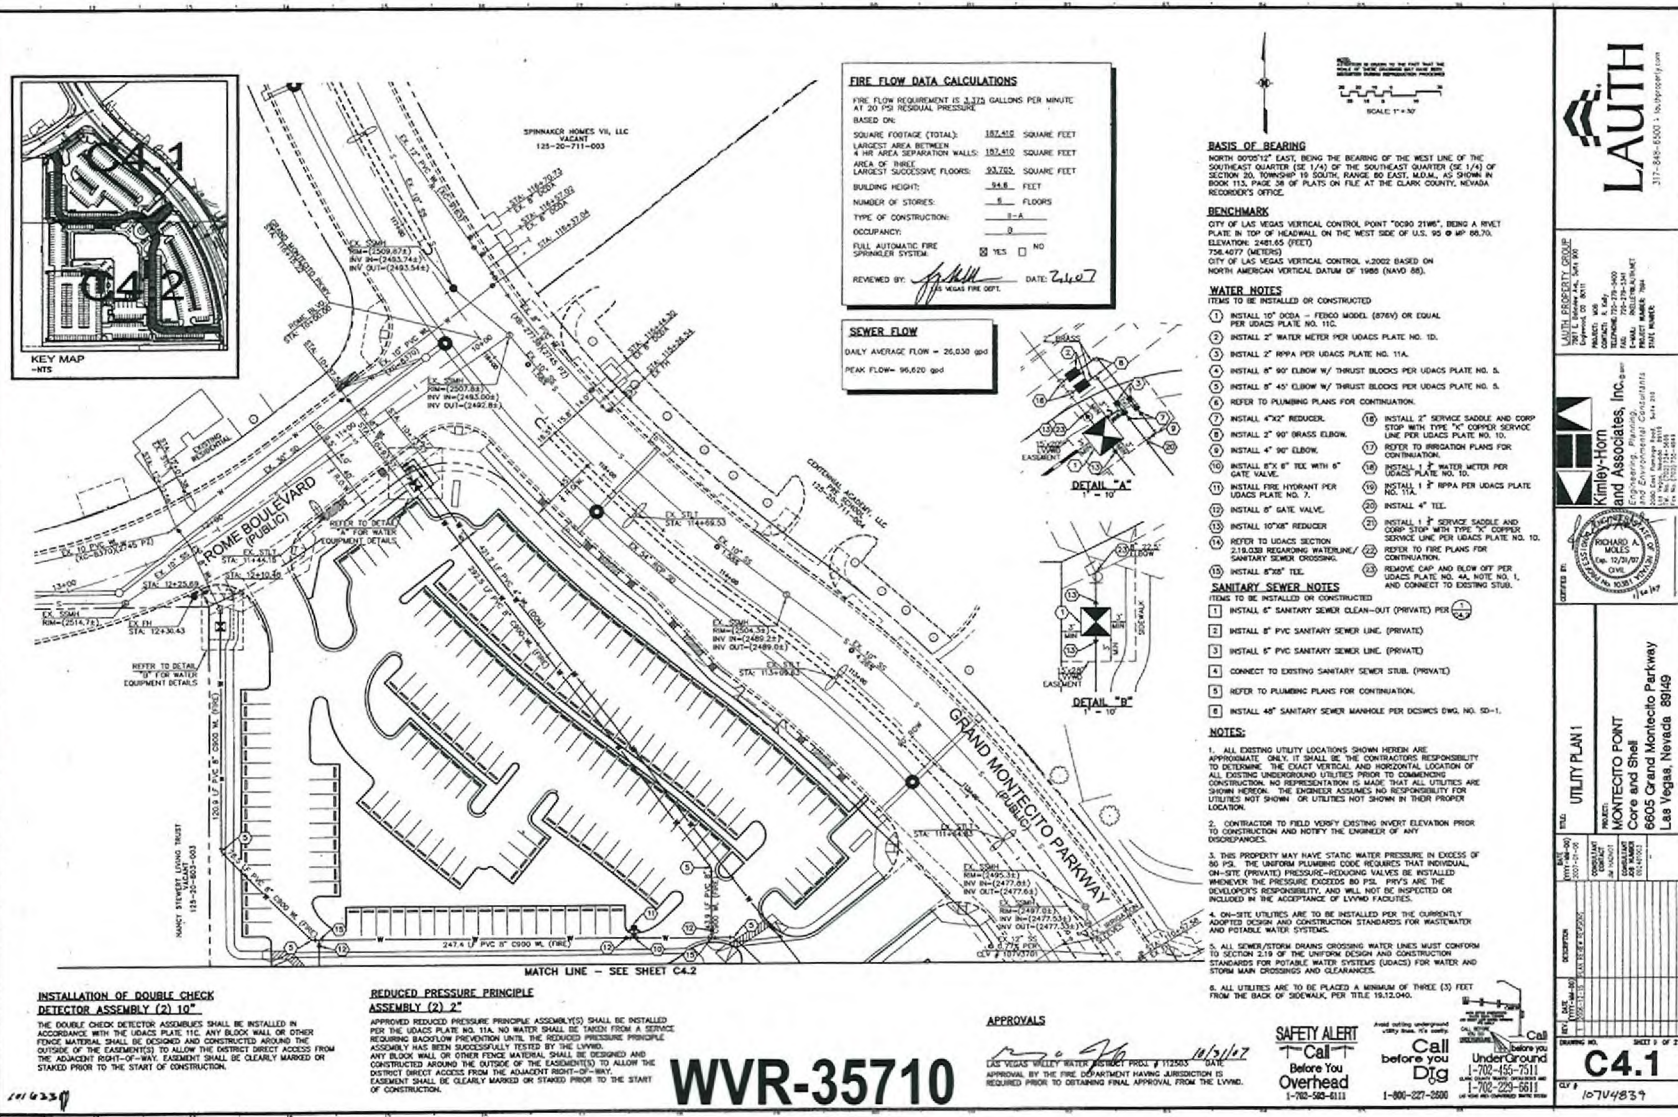

WVR-35710
10/08/09 PC

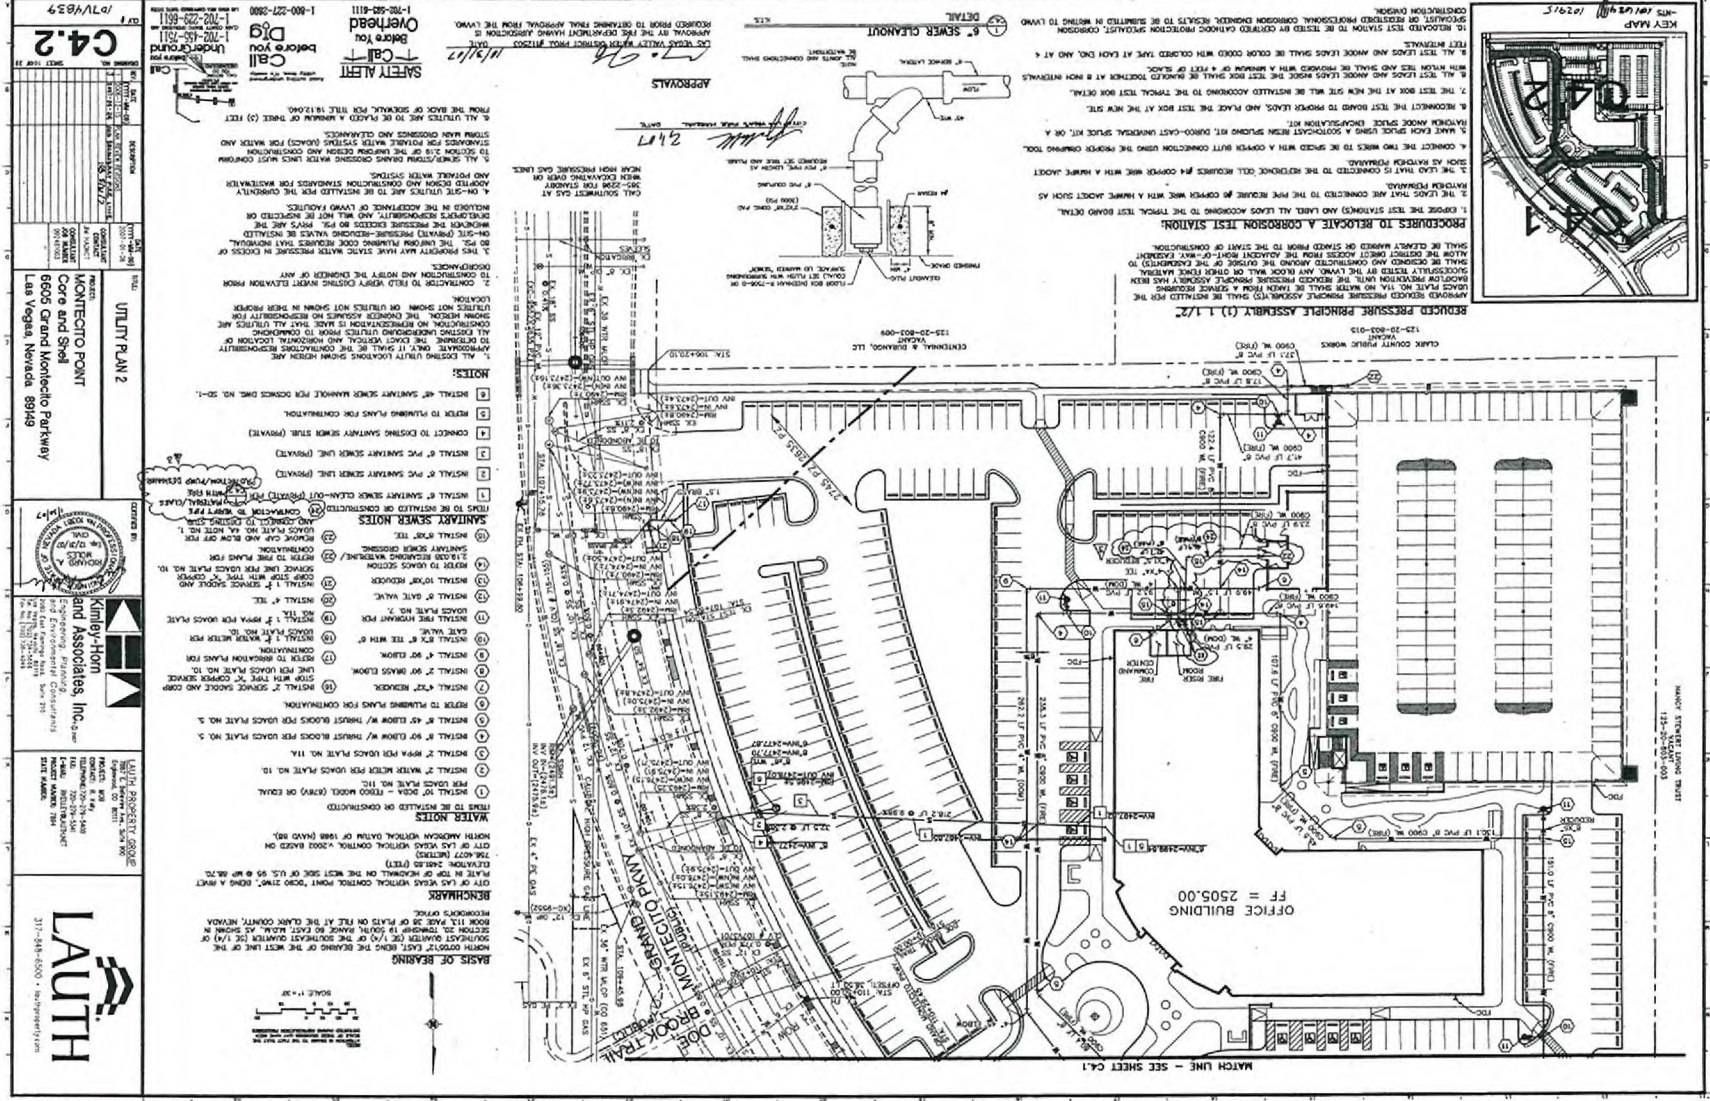

KEY MAP
10/08/09
10/08/09

PROCEDURES TO RELOCATE A CORROSION TEST STATION:
1. EXPOSE THE TEST STATION AND LABEL ALL LEADS ACCORDING TO THE TYPICAL TEST STATION DETAIL.
125-20-003-013
CLARK COUNTY PUBLIC WORKS
125-20-003-013

NOTES:
UTILITY PLAN 2
MONTECITO POINT
Core and Shell
6600 Grand Montecito Parkway
Las Vegas Nevada 89149

LAUTH
317-446-6500 • lasauth.com

RECEIVED
AUG 21 2009
CITY OF LAS VEGAS
PLANNING & DEVELOPMENT

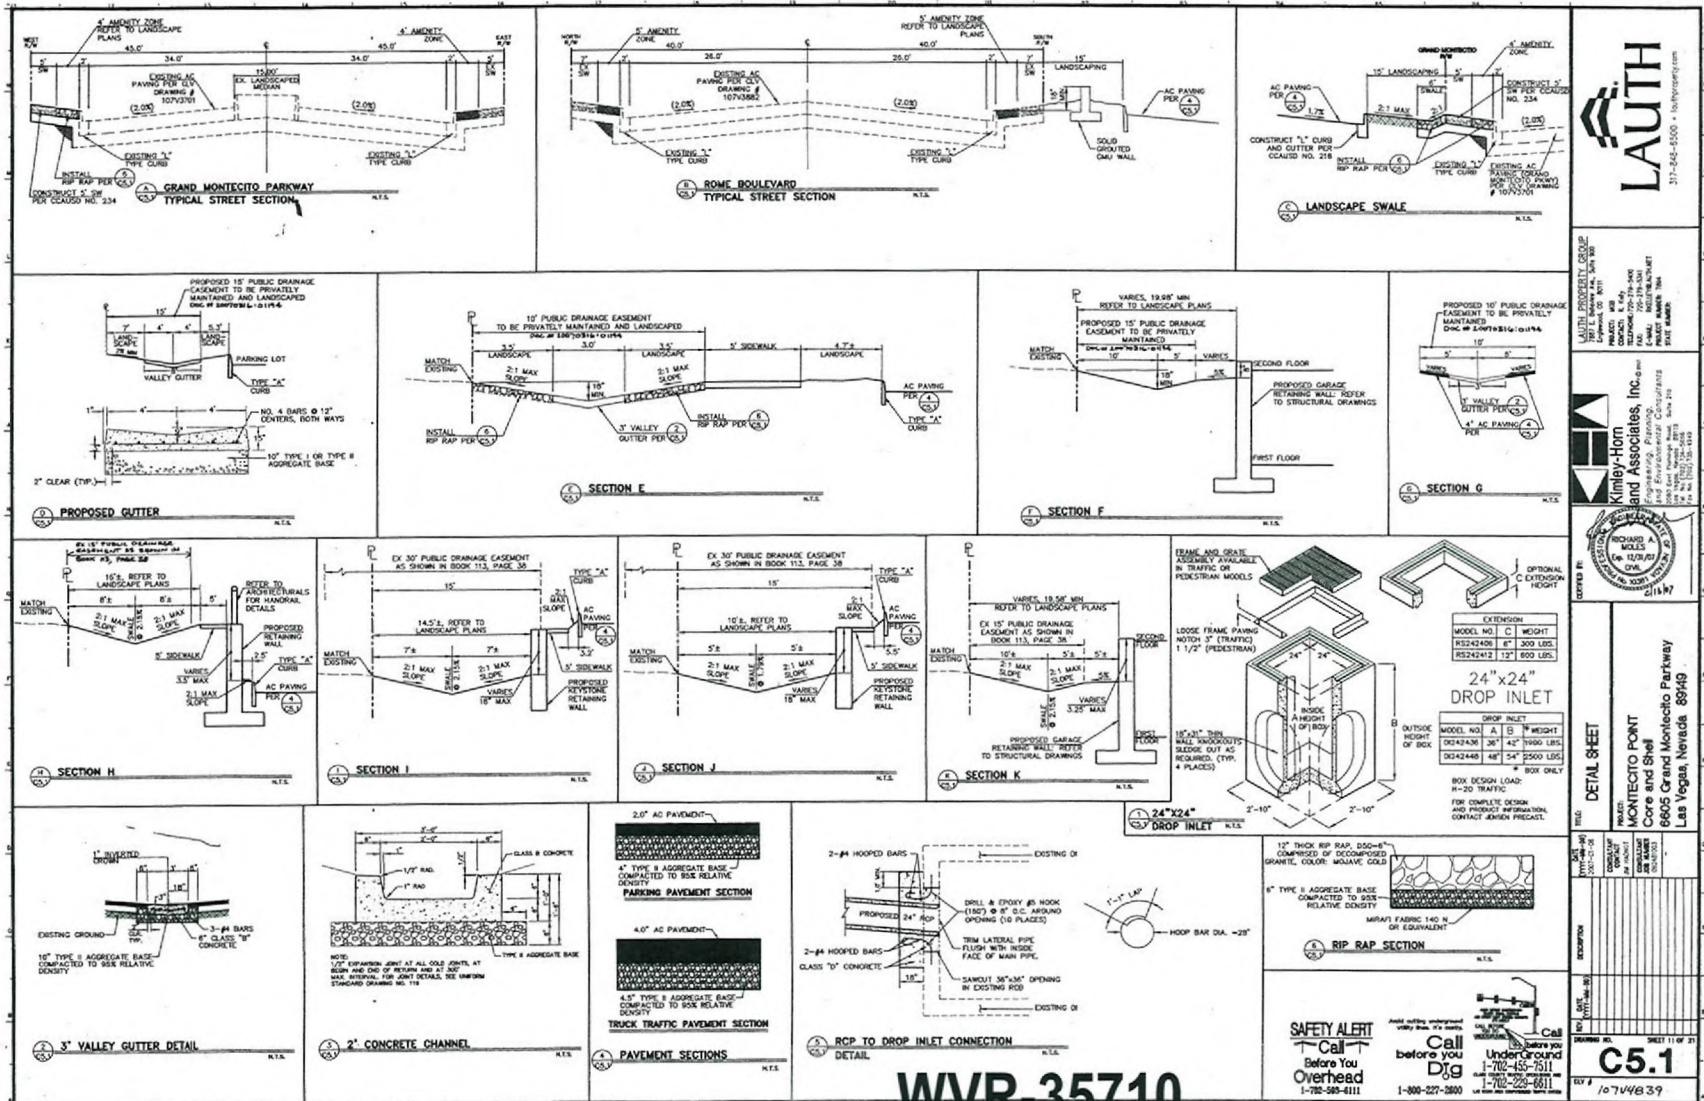


LAUTH
217-545-4500 • lauth.com

Kimley-Horn and Associates, Inc.
1000 S. Baseline Road, Suite 200
Las Vegas, NV 89119
(702) 735-1100
www.kimley-horn.com


DETAIL SHEET
PROJECT: MONTECITO POINT
SHEET 11 OF 21

MONTECITO POINT
Core and Shell
6805 Grand Montecito Parkway
Las Vegas, Nevada 89149

WVR-35710
10/08/09 PC

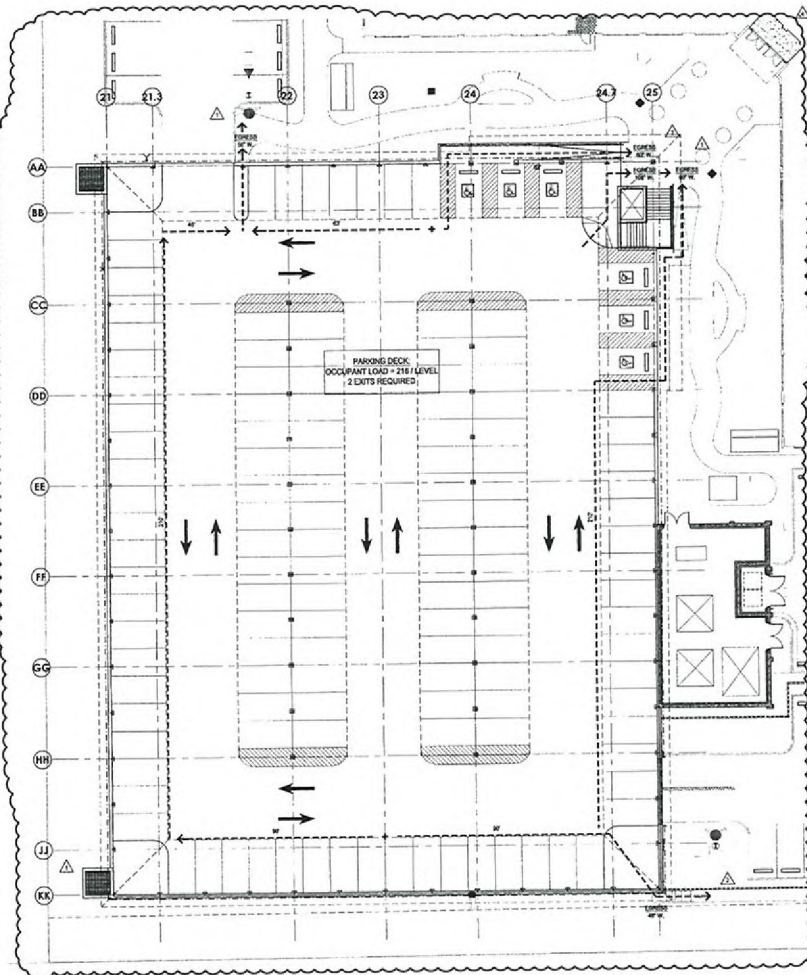

2 PARKING GARAGE EXITING PLAN (UPPER LEVEL)
1/8" = 1'-0"

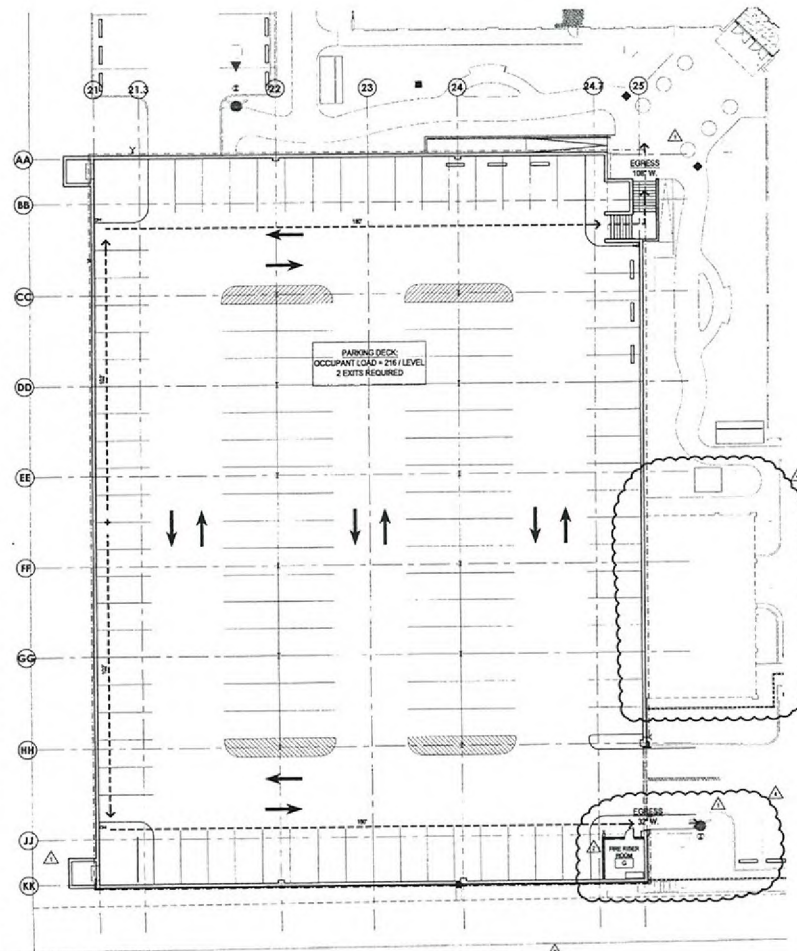

1 PARKING GARAGE EXITING PLAN (LOWER LEVEL)
1/8" = 1'-0"

WVR-35710
10/08/09 PC

NOTE:
1. PROVIDE 1-HOUR FIRE RATED ENCLOSURE AT FIRE RISK ROOM.
1-HOUR ENCLOSURE SHOWN IN 101-102.

SYMBOL LEGEND:

- F.E. FIRE EXTINGUISHER
- (E) F.E.C. FIRE EXTINGUISHER CABINET
- EX EXIT SIGN
- ONE HOUR FIRE ASSEMBLY
- TWO HOUR FIRE ASSEMBLY
- DIRECTION OF TRAVEL AND DISTANCE

LAUTH
866 848 6500 · www.lauth.net

LAUTH PROPERTY GROUP
PROJECT: MONTICITO OFFICE BUILDING



RECEIVED
DATE: 10/08/09
BY: [Signature]

PARKING GARAGE EXIT PLANS
MONTICITO OFFICE BUILDING
Coca and Spill
Monticito Parkway
Las Vegas, Nevada

REVISIONS

NO.	DATE	DESCRIPTION
1	10/08/09	ISSUED FOR PERMIT

DRAWING
A-050
TITLE: PARKING GARAGE EXIT PLANS

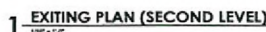

SYMBOL LEGEND:

- RECEIVED
AUG 21 2009


AREA AND OCCUPANCY:			
SECOND LEVEL			

SECOND LEVEL - GROSS FLOOR AREA
BUSINESS AREA (100 S.F. PER OCCUPANT) 30,247 S.F. = 303 OCCUPANTS



LAUTH
866.848.6500 • www.lauth.net

LAUTH PROPERTY GROUP

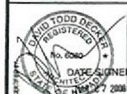SEM
NEVADA LLC

TITLE
EXISTING PLAN (SECOND FLOOR)

PROJECT
MONTECITO OFFICE BUILDING
Core and Shell

Montecito Parkway
Las Vegas, Nevada

12-20-02
(continued)
Page 1























A-053					
EXTENDING PLAN THIRD LINE					



RECEIVED
AUG 21 2009
CITY OF LAS VEGAS
PLANNING & DEVELOPMENT





SYMBOL LEGEND:

RECEIVED
AUG 21 2009
CITY OF LAS VEGAS
PLANNING & DEVELOPMENT

AREA AND OCCUPANCY:			
SIXTH LEVEL			
001	NOT USED		
002	NOT USED		
003	ELEVATOR LOBBY	279 S.F.	0 OCCUPANTS
004	NOT USED		
005	NOT USED		
006	NOT USED		
007	STAIR W	210 S.F.	0 OCCUPANTS
008	STAIR E	48 S.F.	0 OCCUPANTS
009	STAIR B	210 S.F.	0 OCCUPANTS

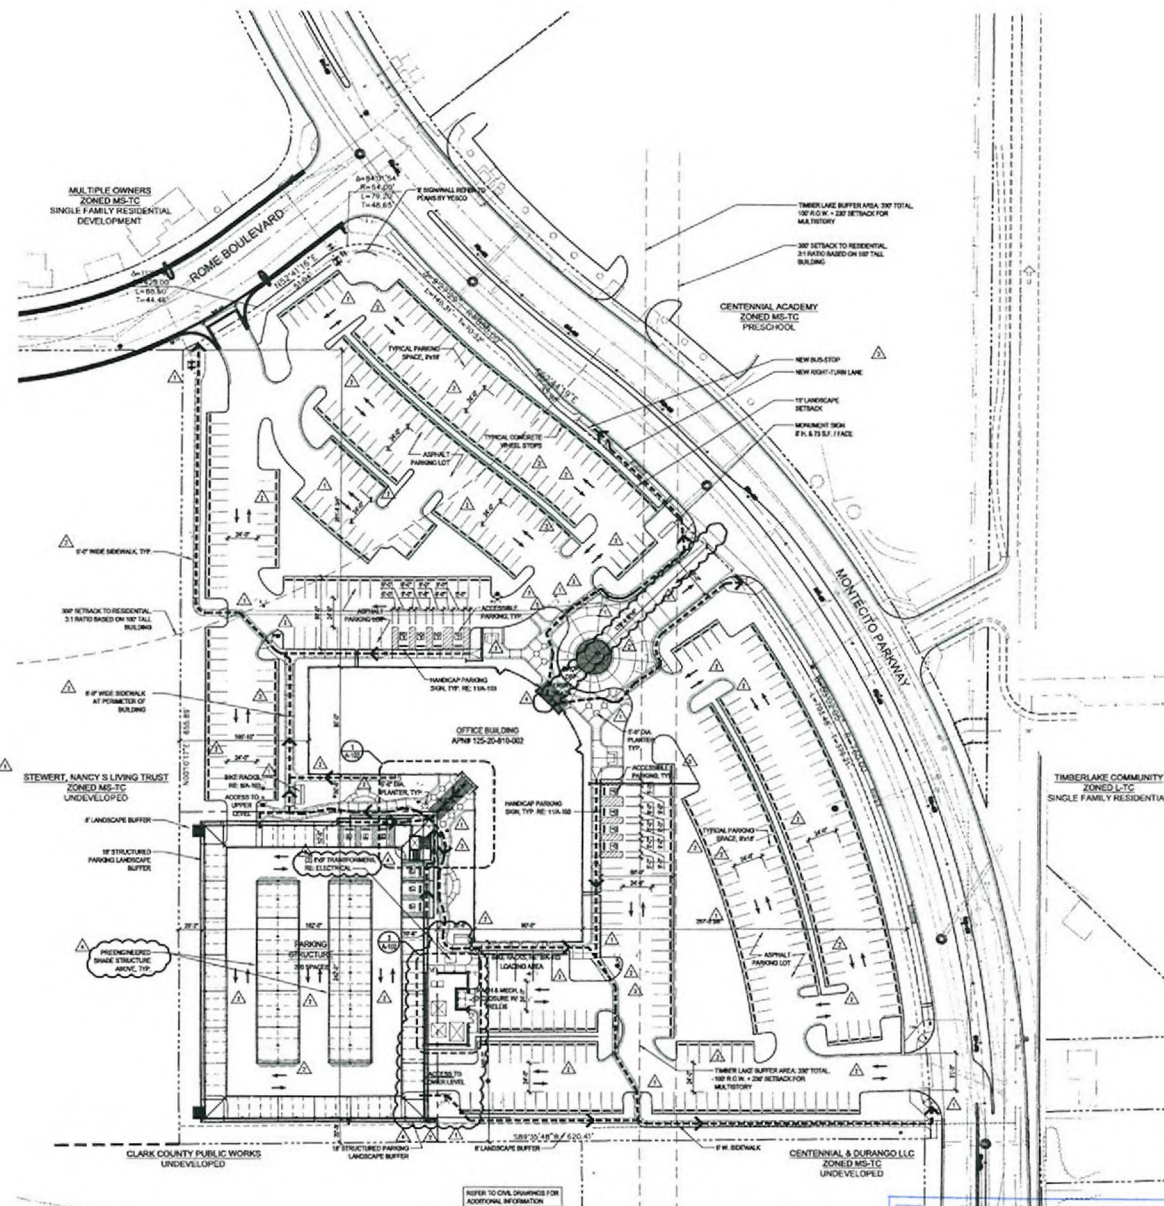

WVR-35710
10/08/09 PC

1 SITE PLAN
 1"=40'



RECEIVED
AUG 21 2009
 CITY OF LAS VEGAS
 PLANNING & DEVELOPMENT

- GENERAL NOTES:**
1. REFER TO CIVIL DRAWINGS FOR HORIZONTAL CONTROL, ELEVATION, FINISH AND UTILITIES. REFER TO LANDSCAPING FOR PLANT CONTROLS AND DETAILS.
 2. REFER TO ELECTRICAL DOCUMENTS FOR SITE LIGHTING.
 3. COORDINATE UTILITIES WITH THE APPROPRIATE PROVIDER.
 4. PROVIDE TYPICAL PARKING SPACES AT 9'x18' UNLESS NOTED OTHERWISE.
 5. PROVIDE 4' WIDE YELLOW PARKING LOT STRIPING TYPICAL, UNLESS NOTED OTHERWISE.
 6. PROVIDE 4' THICK CONCRETE PAVING WITH 18" R/W. REINFORCING BROOM FINISH WHERE NOTED. PROVIDE CROWN JOINTS AT 10' O.C. AND SEALED DOWNWARD JOINTS AT 30' O.C. UNLESS NOTED OTHERWISE.
 7. PROVIDE 4' THICK CONCRETE MEDIAN WITH MEDIUM BROOM FINISH OVER 4" AGGREGATE BASE. PROVIDE SAW-CUT CONTRA JOINTS AT 10' O.C. UNLESS NOTED OTHERWISE. RAUPTS SHALL NOT EXCEED 1/4" IN THE DIRECTION OF TRAVEL OR EXCEED 1/4" CROSS SLIP.
 8. MAINTAIN POSITIVE DRAINAGE AWAY FROM THE BUILDING. MINIMUM OF 1/4" IN 10' FEET.
 9. REFER TO CIVIL DRAWINGS FOR SITE SPECIFIC PARKING REQUIREMENTS AND VISUAL PARKING DESIGNATION.
 10. REFER TO CIVIL DRAWINGS FOR PARKING AND AS A COMPLAINT ORIGIN.
 11. REFER TO LANDSCAPE DRAWINGS FOR LANDSCAPING AROUND BUILDING AND AT PARKING AREAS.

SITE DATA:

SITE AREA	8.11 ACRES

ACCESSIBLE ROUTE AND DIRECTION OF TRAVEL
 SLOPE SHALL NOT EXCEED 1/4" IN THE DIRECTION
 OF TRAVEL, OR EXCEED 1/4" CROSS SLIP.

LAUTH
 855 645 6500 • www.lauth.net

LAUTH PROPERTY GROUP
 PROJECT: WVR-35710
 LOCATION: MONTICITO OFFICE BUILDING
 SHEET: A-100
 DATE: 10/08/09



SEM
 CIVIL ENGINEER
 4775 CALLE BLVD
 SUITE 200
 LAS VEGAS, NV 89119

LAND TOOD DEEDS
 COUNTY: CLARK
 DISTRICT: 1
 DATE: 10/08/09

SITE PLAN
 MONTICITO OFFICE BUILDING
 Core and Shell
 Montecito Parkway
 Las Vegas, Nevada

NO.	REVISION	DATE	BY	CHKD	APP'D
1	ISSUED FOR PERMIT	10/08/09	SEM	SEM	SEM

SWINGING NO. SHEET OF
A-100
 SITE PLAN

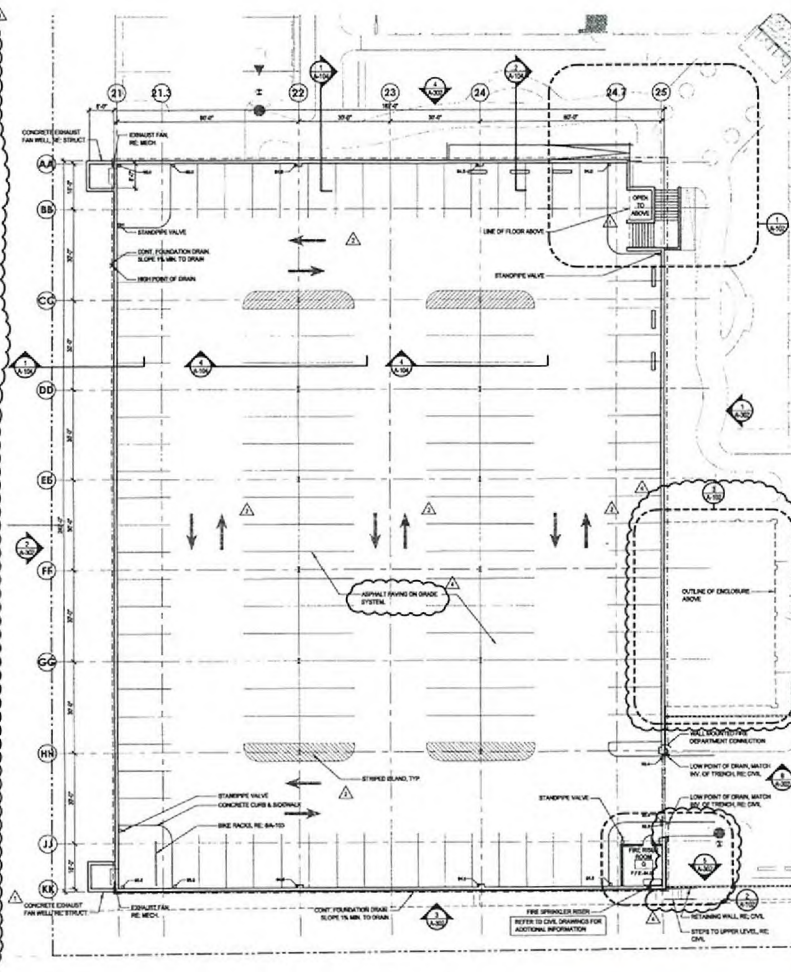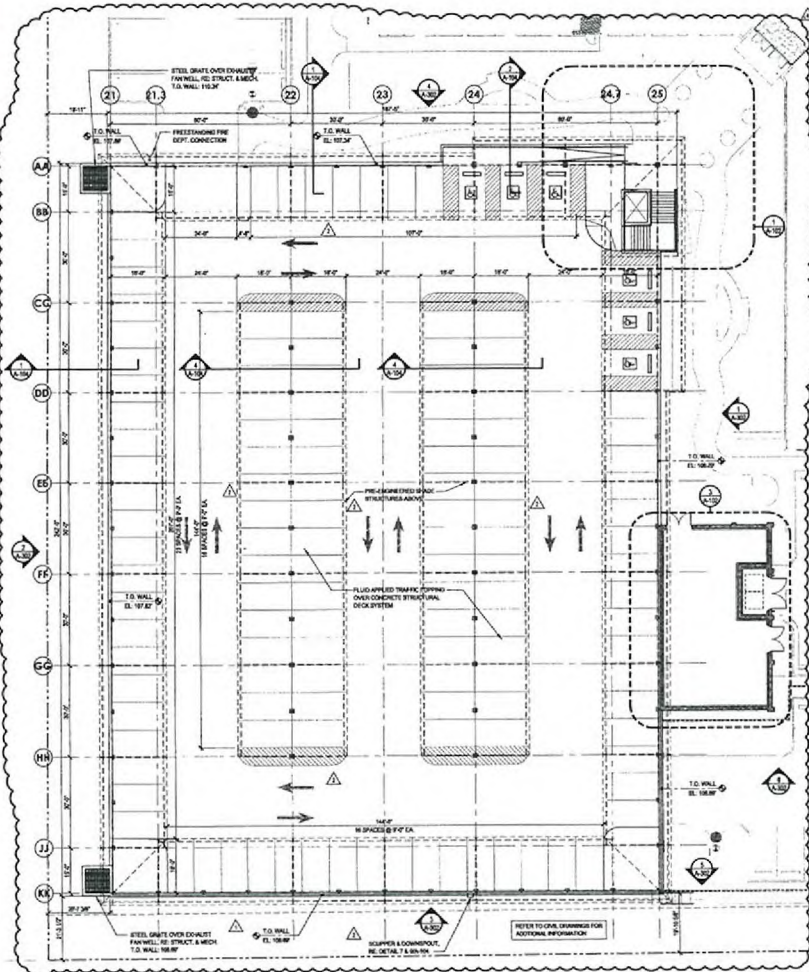

- FLOOR SYSTEMS**
 ACTUAL THICKNESS OF FLOOR SYSTEM SHALL BE SHOWN AND NOTED ON DRAWING. REFER TO SPECIFICATIONS FOR FLOOR SYSTEMS.
 STRUCTURAL FLOOR SYSTEM CONCRETE SLAB ON METAL DECK, REFER TO SPECIFICATIONS FOR FLOOR SYSTEMS.
 CONCRETE PAVING ON GRADE SYSTEM, REFER TO SPECIFICATIONS FOR FLOOR SYSTEMS.

LAUTH
856.848.6500 • www.lauth.net

SEM
SPECIALTY ENGINEERING & MANAGEMENT
477 Corporate Blvd
Suite 200
Las Vegas, NV 89101
www.sem-nv.com

RECEIVED
AUG 21 2009
CITY OF LAS VEGAS
PLANNING & DEVELOPMENT


PARKING GARAGE PLANS
 MONTECITO OFFICE BUILDING
 Core and Shell
 Montecito Parkway
 Las Vegas, Nevada

REVISIONS

NO.	DATE	DESCRIPTION
1	10/08/09	10/08/09 PC


DATE 10/08/09
BY [Signature]
CHECKED [Signature]
APPROVED [Signature]
SCALE 1/8" = 1'-0"
SHEET A-101
TOTAL PARKING GARAGE PLANS

WVR-35710
10/08/09 PC

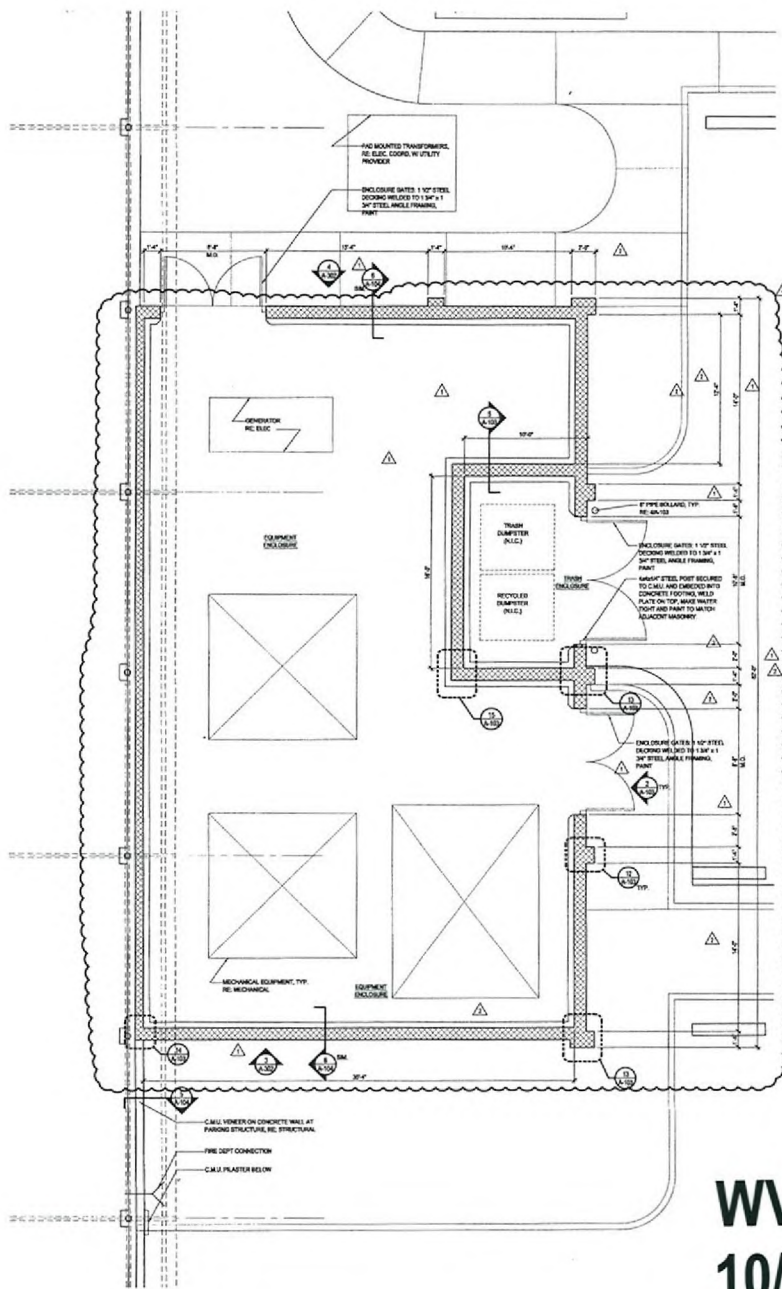


3 ENLARGED ENCLOSURE PLAN
1/4" = 1'-0"


WVR-35710
10/08/09 PC

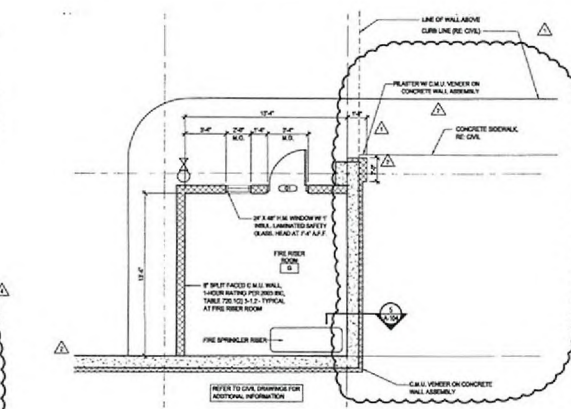

2 ENLARGED FIRE RISER PLAN
1/4" = 1'-0"

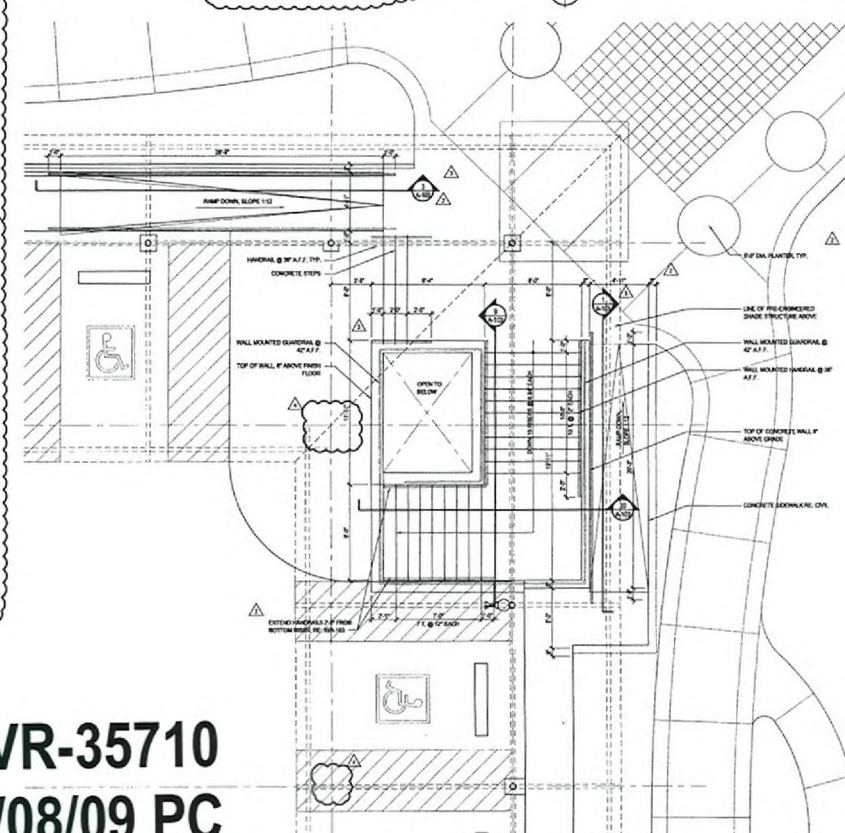

1 ENLARGED ENTRY PLAZA PLAN
1/4" = 1'-0"

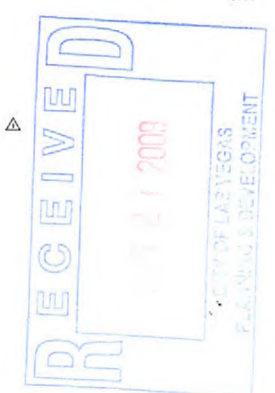

LAUTH
866 646 6500 • www.lauth.net

LAUTH PROPERTY GROUP
PROJECT: MONTICITO OFFICE BUILDING



AND YODanis
REGISTERED PROFESSIONAL ENGINEER
DATE: 10/1/2009
BY: [Signature]


SITE DETAILS
PROJECT: MONTICITO OFFICE BUILDING
Core and Shell
Monticito Parkway
Las Vegas, Nevada

DATE	DESCRIPTION	BY	CHECKED
10/1/2009	10/08/09 PC		


Sheet of 10
A-102
ENLARGED SITE PLAN

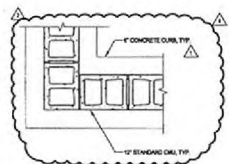


15 EQUIPMENT ENCLOSURE DETAIL
3/4" x 1/2"

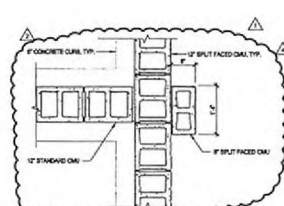


13 TRASH ENCLOSURE DETAIL
3/4" x 1/2"

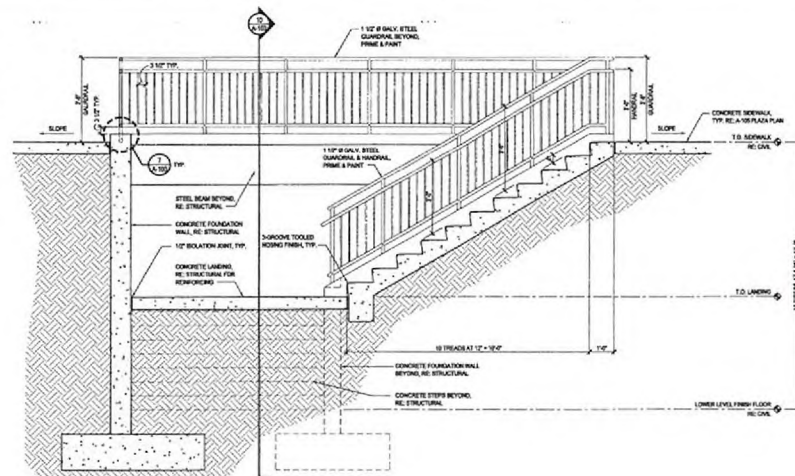


9 PARKING GARAGE STAIR SECTION
1/2" x 1/2"

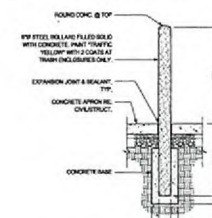


4 PIPE BOLLARD
1/2" x 1/2"

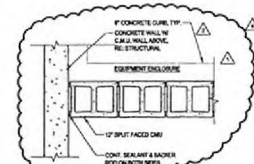


14 EQUIPMENT ENCLOSURE DETAIL
3/4" x 1/2"

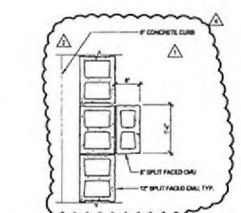


12 EQUIPMENT ENCLOSURE DETAIL
3/4" x 1/2"

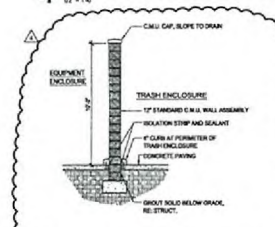


5 ENCLOSURE WALL SECTION
1/2" x 1/2"

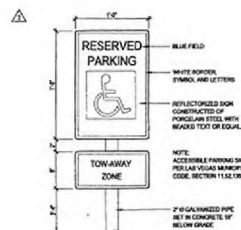


11 HANDICAP PARKING SIGN
1/2" x 1/2"

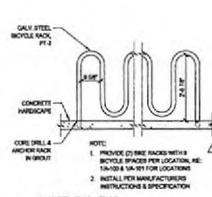


8 BIKE RACK
1/2" x 1/2"

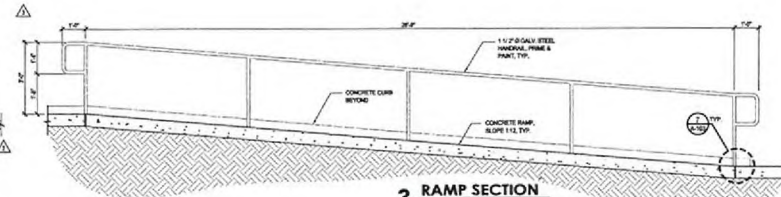


3 RAMP SECTION
1/2" x 1/2"

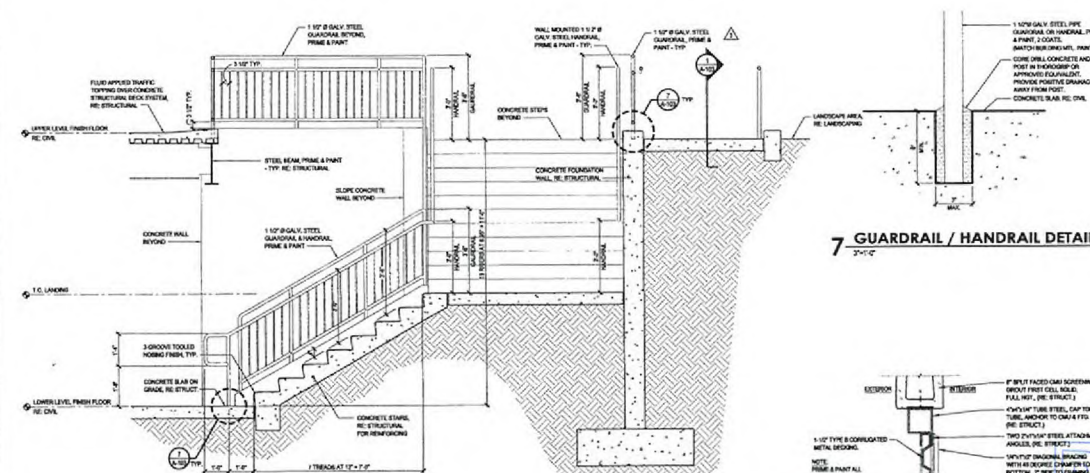


10 PARKING GARAGE STAIR SECTION
1/2" x 1/2"

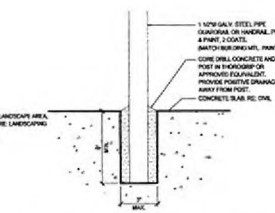


7 GUARDRAIL / HANDRAIL DETAIL
3/4" x 1/2"

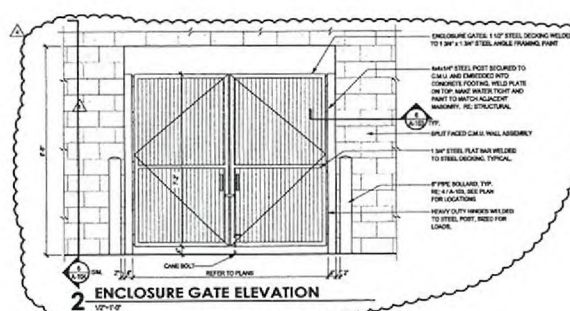

2 ENCLOSURE GATE ELEVATION
1/2" x 1/2"

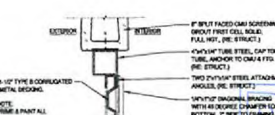

6 ENCLOSURE DOOR DETAIL
1/2" x 1/2"

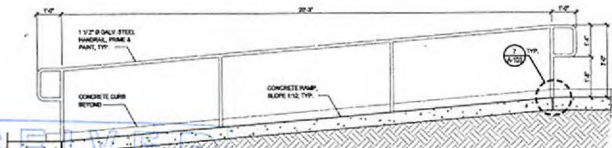

1 RAMP SECTION
1/2" x 1/2"

WVR-35710
10/08/09 PC

LAUTH
866.848.6500 • www.lauth.net

LAUTH PROPERTY GROUP
PROJECT: MONTECITO OFFICE BUILDING
CORE AND SHELL
MONTECITO PARKWAY
LAS VEGAS, NEVADA

SEM
SPECIALTY ENGINEERING
1175 S. LAS VEGAS BLVD.
SUITE 200
LAS VEGAS, NV 89102
702.735.1234



DATE: 10/08/09
BY: [Signature]
CHECKED BY: [Signature]
APPROVED BY: [Signature]

SITE DETAILS
PROJECT: MONTECITO OFFICE BUILDING
CORE AND SHELL
MONTECITO PARKWAY
LAS VEGAS, NEVADA

NO.	DATE	DESCRIPTION	BY	CHECKED	APPROVED
1	10/08/09	ISSUED FOR PERMIT	[Signature]	[Signature]	[Signature]
2	10/08/09	REVISED	[Signature]	[Signature]	[Signature]
3	10/08/09	REVISED	[Signature]	[Signature]	[Signature]
A-103
SITE DETAILS

RECEIVED
CITY OF LAS VEGAS
PLANNING & DEVELOPMENT




BOOKS OF WORK RELATED TO COMMON AREA INTERIORS IS INTENDED TO CONVEY A GENERAL LEVEL OF QUALITY AND MIN. STANDARDS. DESIGN OF COMMON AREAS/SPACES WILL BE FURTHER REFINED AND FINISH MATERIAL SELECTIONS COMPLETED WITH FUTURE SET OF DESIGN DOCUMENTS.

[illegible]

[illegible]


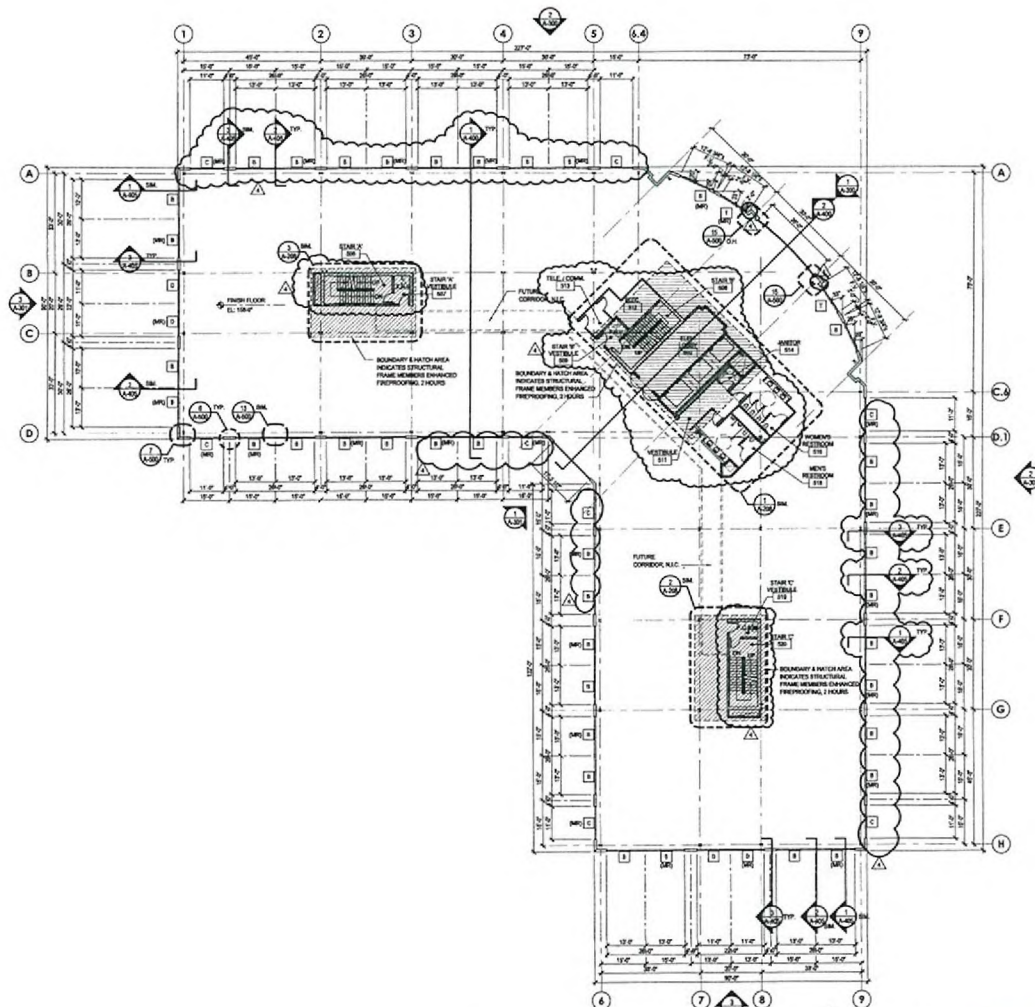

1 FLOOR PLAN (FIFTH LEVEL)
1/8" = 1'-0"

SYMBOL LEGEND:
- F.C.A. FLOOR CONTROL ASSEMBLY
- F.F.A. FIRE FIGHTING ASSEMBLY

SCOPE OF WORK:
NOTE: IF MORE RELATED TO CORRIDOR AREA INTERIOR IS
INTENDED TO CORRECT A GENERAL LEVEL OF QUALITY AND MINIMUM
STANDARD. DESIGN OF CORRIDOR AREA SPACES WILL BE DETERMINED
BASED ON FINISH MATERIAL SELECTIONS COMPLETED WITH A
FUTURE SET OF DESIGN DOCUMENTS.

- FLOOR SYSTEMS**
STRUCTURAL FLOOR SYSTEM: CONCRETE SLAB ON METAL DECK, REFER TO STRUCTURAL. PROVIDE TRAFFIC BEARINGS AT ALL CONTROL JOINTS.
CONCRETE FLOOR SYSTEM: CONCRETE SLAB ON METAL DECK, REFER TO STRUCTURAL. PROVIDE TRAFFIC BEARINGS AT ALL CONTROL JOINTS.
- ROOF SYSTEMS**
MEMBRANE ROOF SYSTEM: MECHANICALLY FASTENED T.P.O. ROOFING SYSTEM OVER A 2" INSULATION. PROVIDE TRAFFIC BEARINGS AT ALL CONTROL JOINTS.
PART OF PRE-ENGINEERED ASSEMBLY CONSIDERED BELOW.
- EXTERIOR WALL SYSTEMS**
EXTERIOR WALL SYSTEM: UNFINISHED BRICK & MORTAR BARRIER OVER 8" BRICK. PROVIDE TRAFFIC BEARINGS AT ALL CONTROL JOINTS.
PROVIDE 1/2" FIBER GLASS BATT INSULATION (R-19).
- WINDOW SYSTEMS**
ALUMINUM WINDOW SYSTEM: SYSTEM ANCHORED ALUMINUM WINDOW WALL. PROVIDE TRAFFIC BEARINGS AT ALL CONTROL JOINTS.
- INTERIOR WALL SYSTEMS**
NO. 1. TYPICAL INTERIOR WALL SYSTEM: 5/8" METAL STUD AT 16" O.C. WITH 5/8" GYPSUM BOARD. PROVIDE TRAFFIC BEARINGS AT ALL CONTROL JOINTS.
- FIRE RESISTANCE RATINGS**
STRUCTURAL FRAME MEMBERS: PROVIDE 2-HOUR RATING U.L. WITH 1 1/2" FIBER GLASS COLUMNS AND BEAMS WITH SPRAY APPLIED FIRE-PROOFING.
FLOOR CONSTRUCTION: 4-HOUR RATING U.L. WITH 1 1/2" FIBER GLASS COLUMNS AND BEAMS WITH SPRAY APPLIED FIRE-PROOFING.
WVR-35710
10/08/09 PC

LAUTH
866.846.6500 • www.lauth.net

LAUTH ARCHITECTS
ARCHITECT
1000 S. LAS VEGAS BLVD., SUITE 200
LAS VEGAS, NV 89102
TEL: 702.735.1111
FAX: 702.735.1112
WWW.LAUTH.NET

SEM
AT NEVADA LLC
4777 COMMERCE BLVD.
SUITE 200
LAS VEGAS, NV 89118
TEL: 702.735.1111
FAX: 702.735.1112
WWW.SEM-ATNEVADA.COM


DATE 10/08/09
BY [Signature]
SCALE 1/8" = 1'-0"

FLOOR PLAN (FIFTH LEVEL)
MONTECITO OFFICE BUILDING
Core and Shell
Montecito Parkway
Las Vegas, Nevada

GENERAL NOTES:
1. FINISH FLOOR ELEVATION OF 108'-0" CORRESPONDING TO 5.0 S.F.E. ELEVATION OF 108'-0" AS A GATEWAY POINT, SEE C.A.
2. ALL INTERIOR DIMENSIONS ARE FROM FINISHED FACE OF WALL UNLESS NOTED OTHERWISE.
3. ALL INTERIOR WALLS ARE TYPE 1, UNLESS NOTED OTHERWISE.
4. NOT USED.
5. PROVIDE 2-HOUR FIRE RATED ENCLOSURE AT EXIT PASSAGEWAYS, STAIR & ELEVATOR ENCLOSURES AND EXTENDING 2-HOUR UNLESS NOTED OTHERWISE.
6. PROVIDE ADA COMPLIANT FIVE (5) EXITS/STAIRWAYS AS REQUIRED BY GOVERNING ADOPTED ORDINANCE. VERIFY ALL LOCATIONS WITH FIRE DEPARTMENT AND INSPECTED PRIOR TO INSTALLATION.
7. ALL ANGLE WALLS SHOWN ARE 45° UNLESS NOTED OTHERWISE.
8. REFER TO ARCHITECT'S SET FOR WALL PANEL ELEVATIONS.
9. REFER TO ARCHITECT'S SET FOR WALL PANEL ELEVATIONS.

ABBREVIATIONS LEGEND:
(M) MIRROR

REVISIONS:
NO. DESCRIPTION
1. 10/08/09
2. 10/08/09
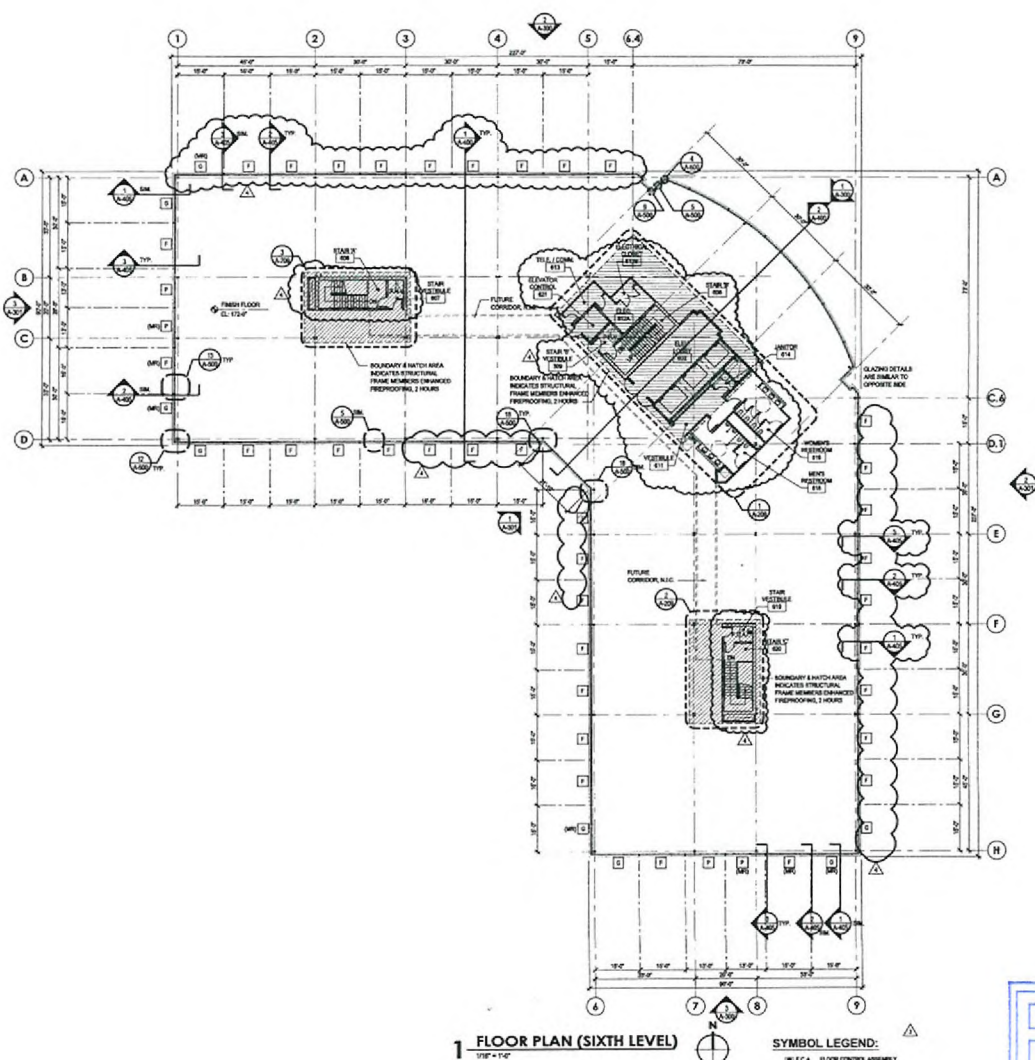

1 FLOOR PLAN (SIXTH LEVEL)
1/8" = 1'-0"

SYMBOL LEGEND:
 3/4" F.C. FLOOR FINISH

SCOPE OF WORK:
 SCOPE OF WORK RELATES TO COMMON AREA INTERIORS IS
 INTENDED TO PROVIDE A GENERAL LEVEL OF QUALITY AND MINIMUM
 STANDARDS. DESIGN OF COMMON AREA SPACES WILL BE FURTHER
 REFINED AND FROM MATERIAL SELECTIONS COMPLETED WITH A
 FUTURE SET OF DESIGN DOCUMENTS.



FLOOR SYSTEMS







ABBREVIATIONS LEGEND:
 DIM: DIMENSION
 FIN: FINISH

GENERAL NOTES:
 1. FINISH FLOOR ELEVATION OF 100'0" CORRESPONDING TO U.S. S. ELEVATION OF 3280'0" AS A SATISFACTORY REF. DIM.
 2. ALL INTERIOR DIMENSIONS ARE FROM FINISHED FACE OF WALL UNLESS NOTED OTHERWISE.
 3. ALL INTERIOR WALLS ARE TYPE 1 UNLESS NOTED OTHERWISE.
 4. NOT USED.
 5. PROVIDE 3/4" X 1/2" FIRE RATED ENCLOSURE AT EXIST PASSAGEWAYS, STAIR & ELEVATOR ENCLOSURES AND EXTENDING 34" HOUR ENCLOSURE BURNING 4" MIN. 4".
 6. PROVIDE ADA COMPLIANT FIRE EXTINGUISHERS AS REQUIRED BY GOVERNING JURISDICTION. VERIFY ALL LOCATIONS WITH FIRE DEPARTMENT AND INSPECT PRIOR TO INSTALLATION.
 7. ALL ANGLE WALLS SHOWN ARE 45° UNLESS NOTED OTHERWISE.
 8. REFER TO A-205 FOR INTERIOR FINISHES.
 9. REFER TO SHEET A-205 FOR WALL PANEL ELEVATIONS.

LAUTH
 866 848 6500 • www.lauth.net

LAUTH PROPERTY GROUP
 PROJECT: CORE AND SHELL
 LOCATION: MONTICELLO PARKWAY
 PRODUCT: CORE AND SHELL
 DATE: 10/08/09


SEM
 OF NEVADA LLC
 1111 COMMERCE BLVD.
 SUITE 200
 LAS VEGAS, NV 89101
 702.251.1111

RECEIVED
 AUG 21 2009
 CITY OF LAS VEGAS
 PLANNING & DEVELOPMENT

FLOOR PLAN (SIXTH LEVEL)
 MONTICELLO OFFICE BUILDING
 Core and Shell
 Monticello Parkway
 Las Vegas, Nevada

CHANGING NO. 1
SHEET 1
OF 1
FLOOR PLAN (SIXTH LEVEL)

WVR-35710
10/08/09 PC

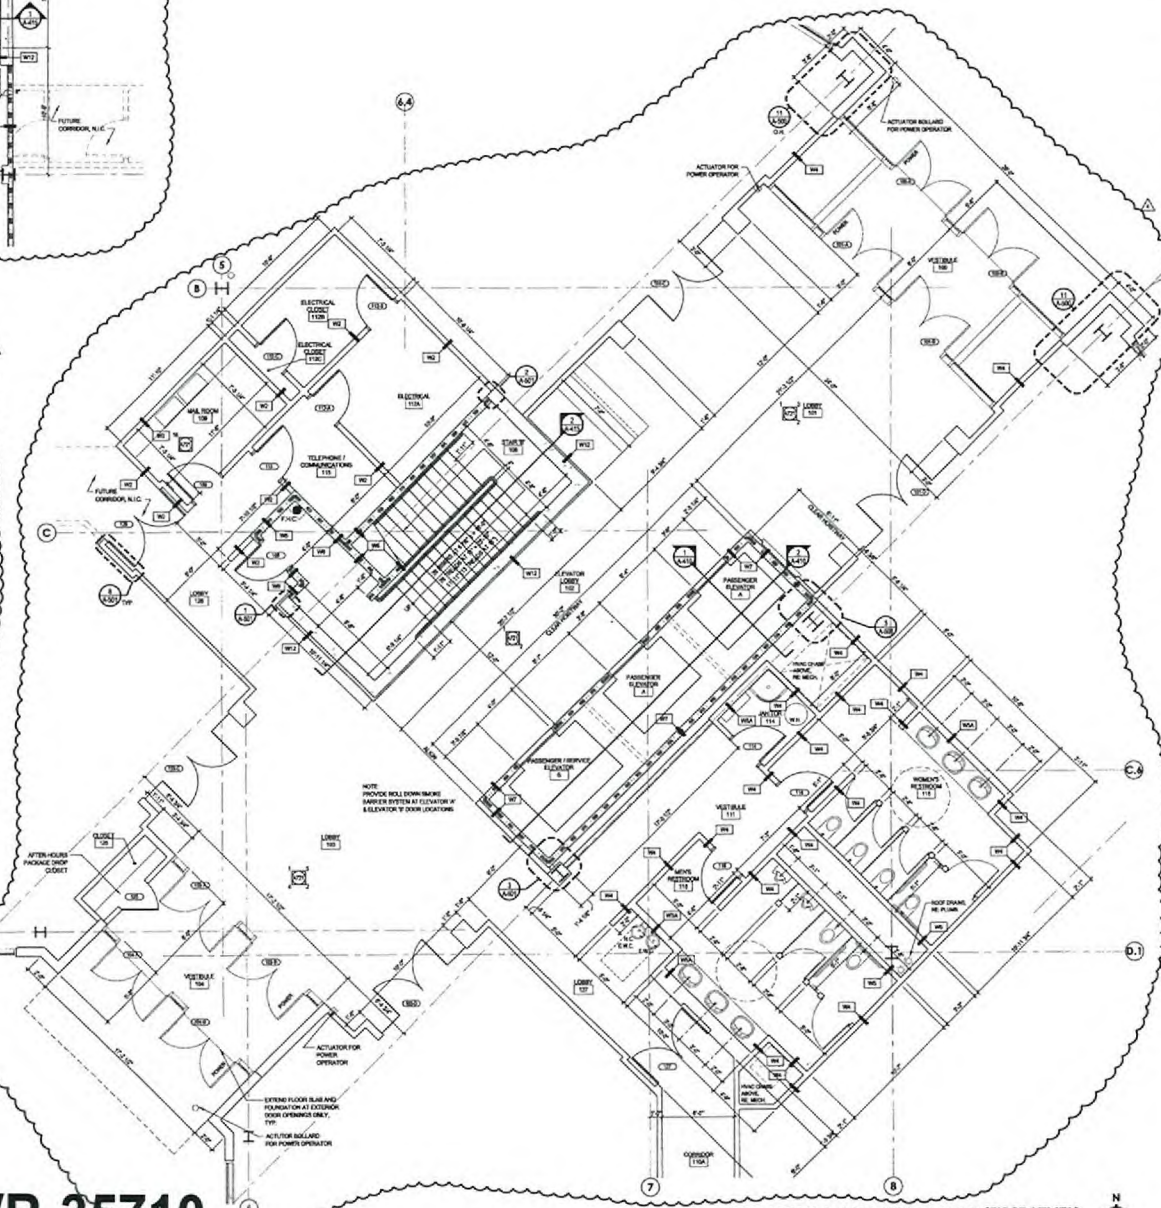

3 ENLARGED STAIR A PLAN (FIRST LEVEL)

2 ENLARGED STAIR C PLAN (FIRST LEVEL)

1 ENLARGED LOBBY / STAIR B / RESTROOM PLAN (FIRST LEVEL)
1/4" = 1'-0"




RECEIVED
AUG 21 2009
CITY OF LAS VEGAS
PLANNING & DEVELOPMENT

WVR-35710
10/08/09 PC

[illegible]

 LAUTH 856 649 6500 • www.lauth.net	
ENLARGED FLOOR PLANS (FIRST LEVEL)	
PROJECT: MONTECITO OFFICE BUILDING Core and Shell Montecito Parkway Las Vegas, Nevada	

 LAUTH 866 848 6500 • www.lauth.net	
	
ENLARGED FLOOR PLANS (FIRST LEVEL)	
MONTECITO OFFICE BUILDING Core and Shell Montecito Parkway Las Vegas, Nevada	
TITLE: _____ PROJECT: _____ DRAWN BY: _____ CHECKED BY: _____ DESIGNED BY: _____ DATE: _____ SCALE: _____ SHEET NO.: _____ OF _____	

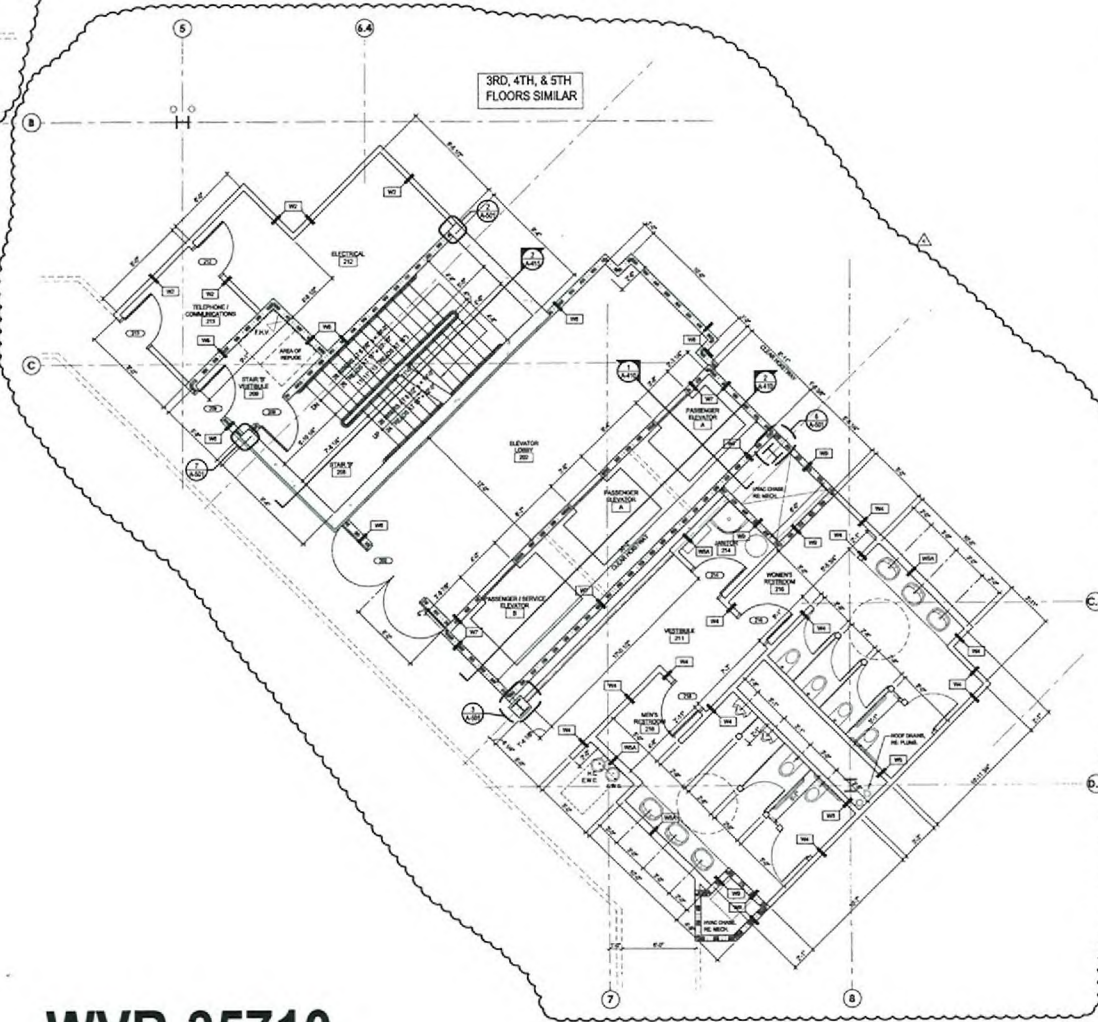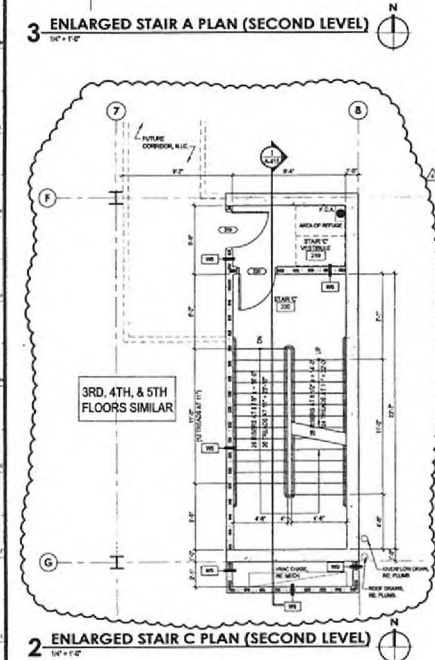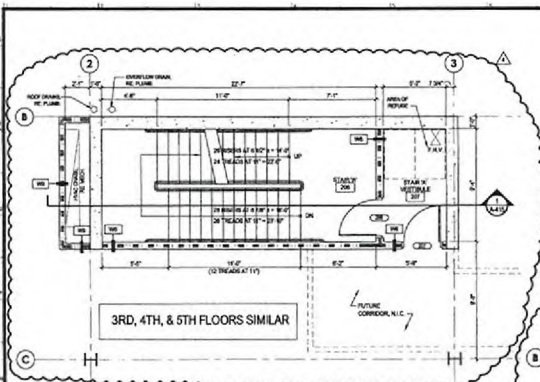

1 ENLARGED LOBBY / STAIR B / RESTROOM PLAN (SECOND LEVEL)
1/4" = 1'-0"


















SYMBOL LEGEND:






RECEIVED
AUG 21 2009
CITY OF LAS VEGAS
PLANNING & DEVELOPMENT

WVR-35710
10/08/09 PC

A-208


------------------	---------------------------	---------------------	------------	------------------------------	---












WVR-35710
10/08/09 PC

DRAWING NO.	SHEET
A-211	
TITLE:	
CEILING PLAN (SECOND FLOOR)	






--	--	---	--



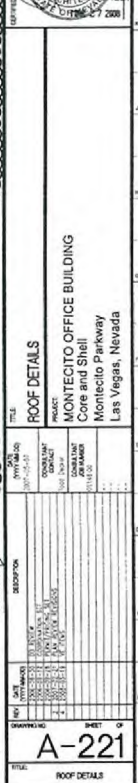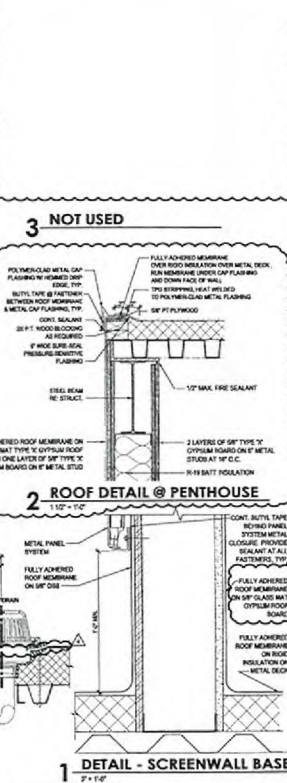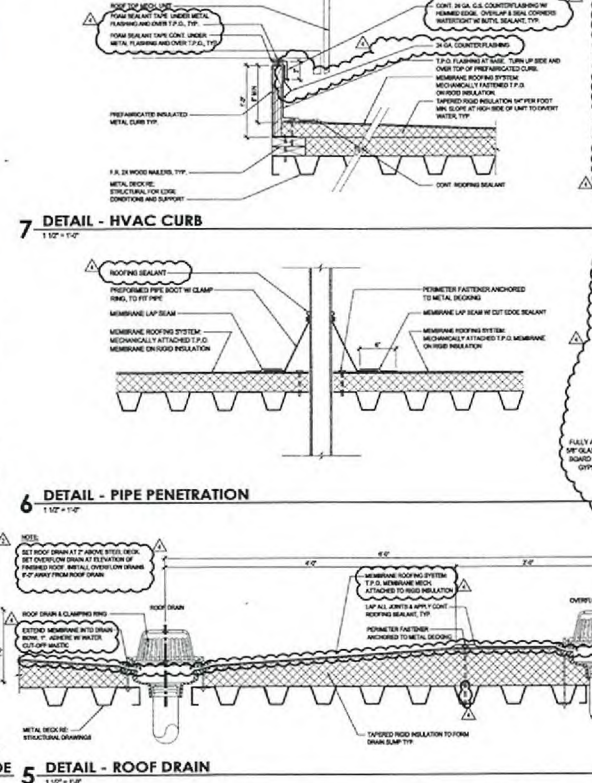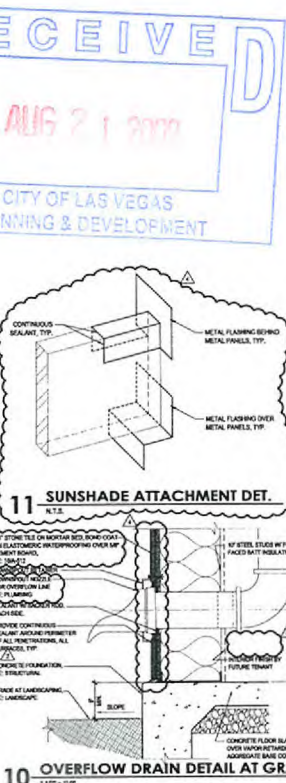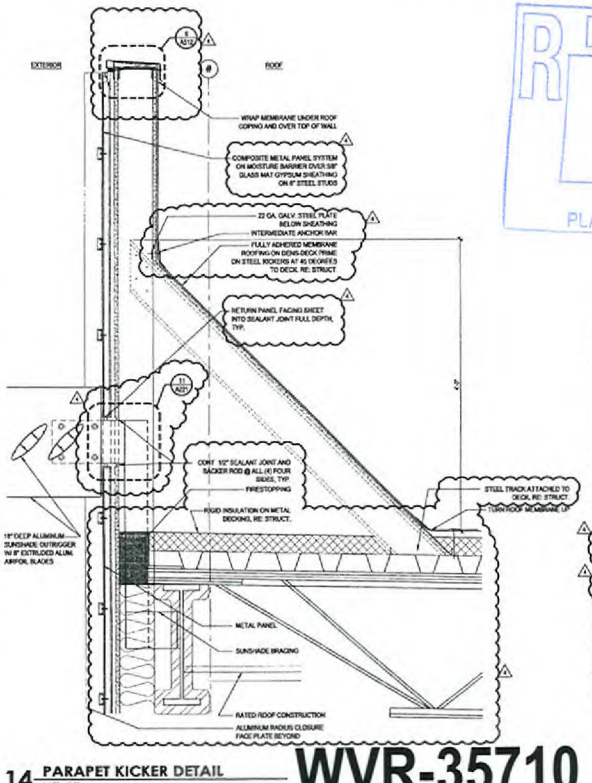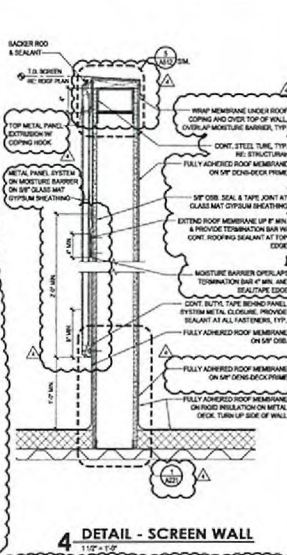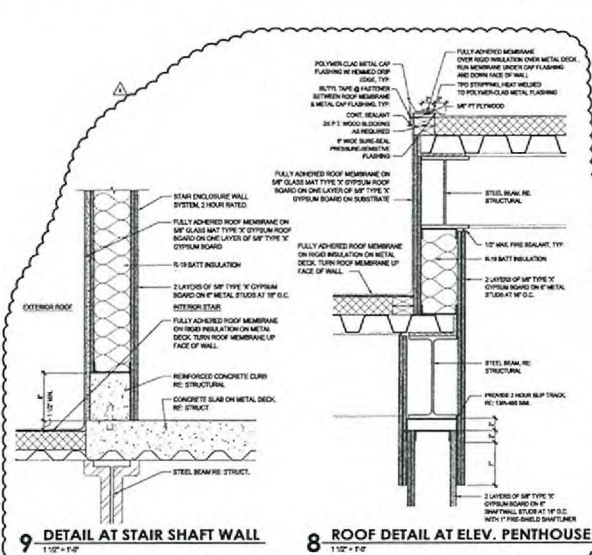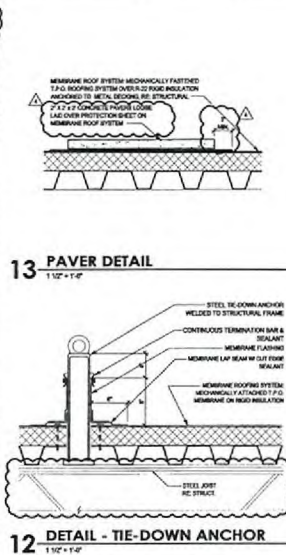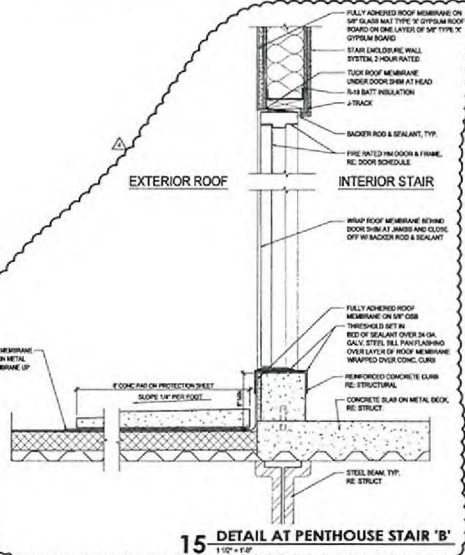

WVR-35710
10/08/09 PC

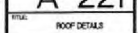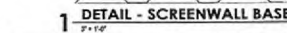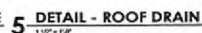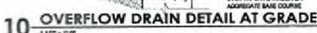

LAUTH
866 848 6300 • www.lauth.net

PROJECT: MONTECITO OFFICE BUILDING
CORE AND SHELL
TECHNICAL
MANAGER
LAUTH




DATE: 10/08/09
DRAWN BY: KYLE
CHECKED BY: KYLE
SCALE: AS SHOWN
SHEET: A-221
TOTAL: ROOF DETAILS





NO.	DESCRIPTION	DATE	BY	CHKD.
1	REVISION			
2	REVISION			
GENERAL NOTES:




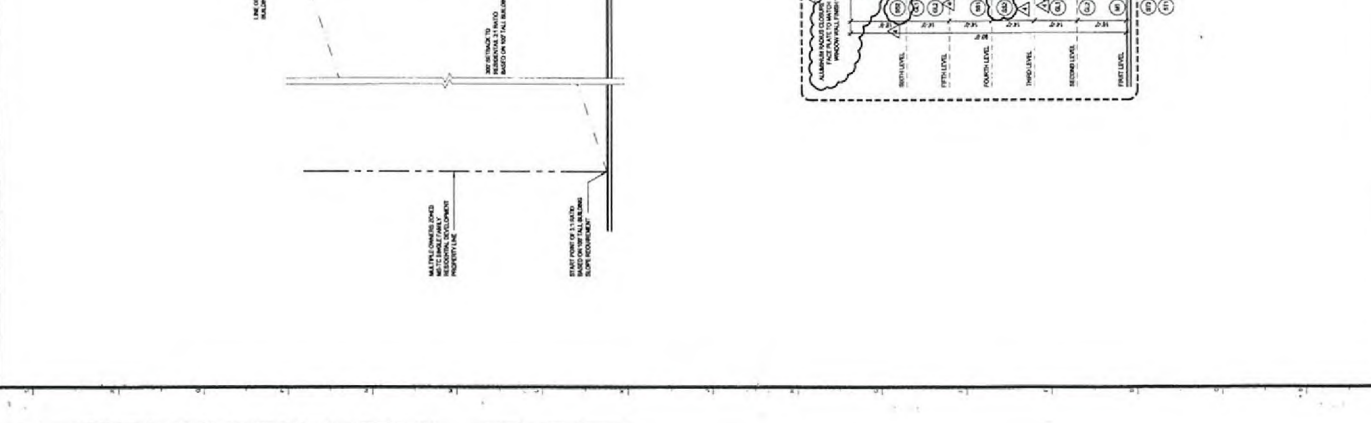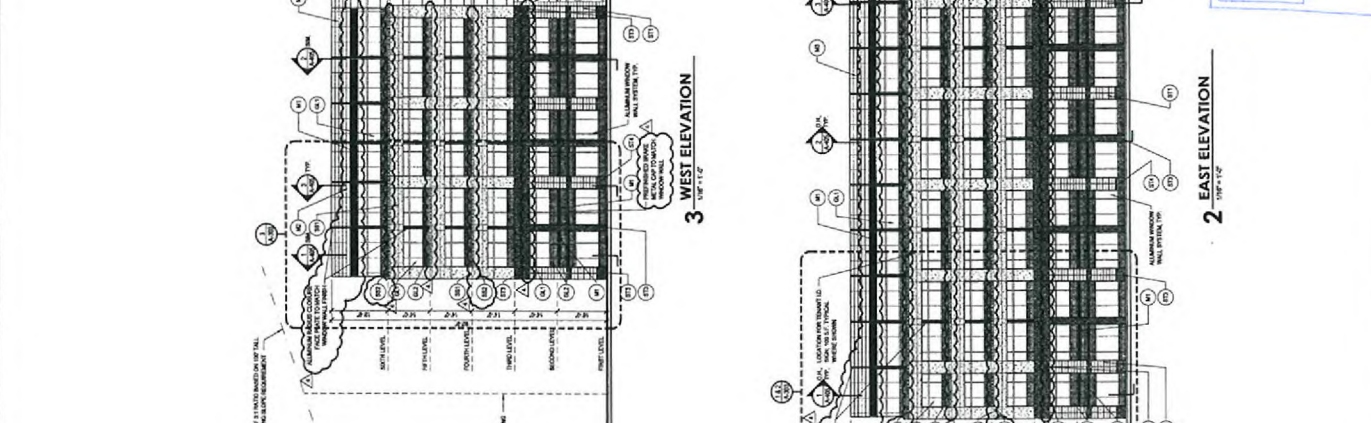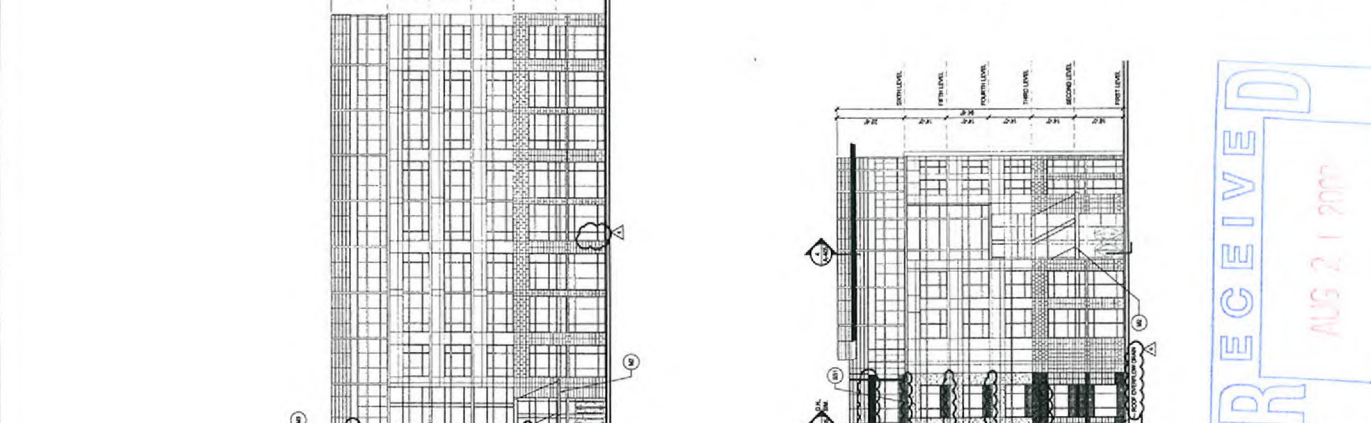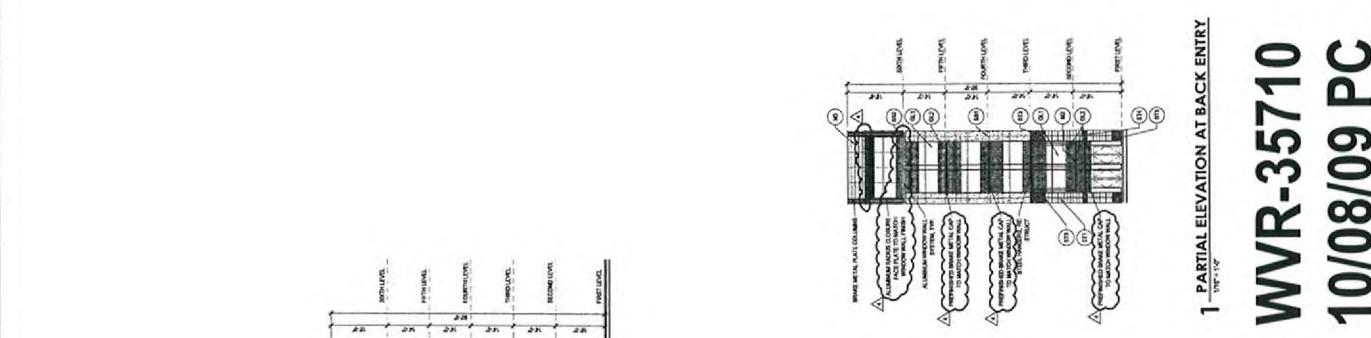

1 PARTIAL ELEVATION AT BACK ENTRY
TYPE 1-10'


WVR-35710
10/08/09 PC

RECEIVED
AUG 21 2009
CITY OF LAS VEGAS
PLANNING & DEVELOPMENT

FLOOR SYSTEMS




 

--	--

TITLE	WALL SECTIONS
-------	---------------

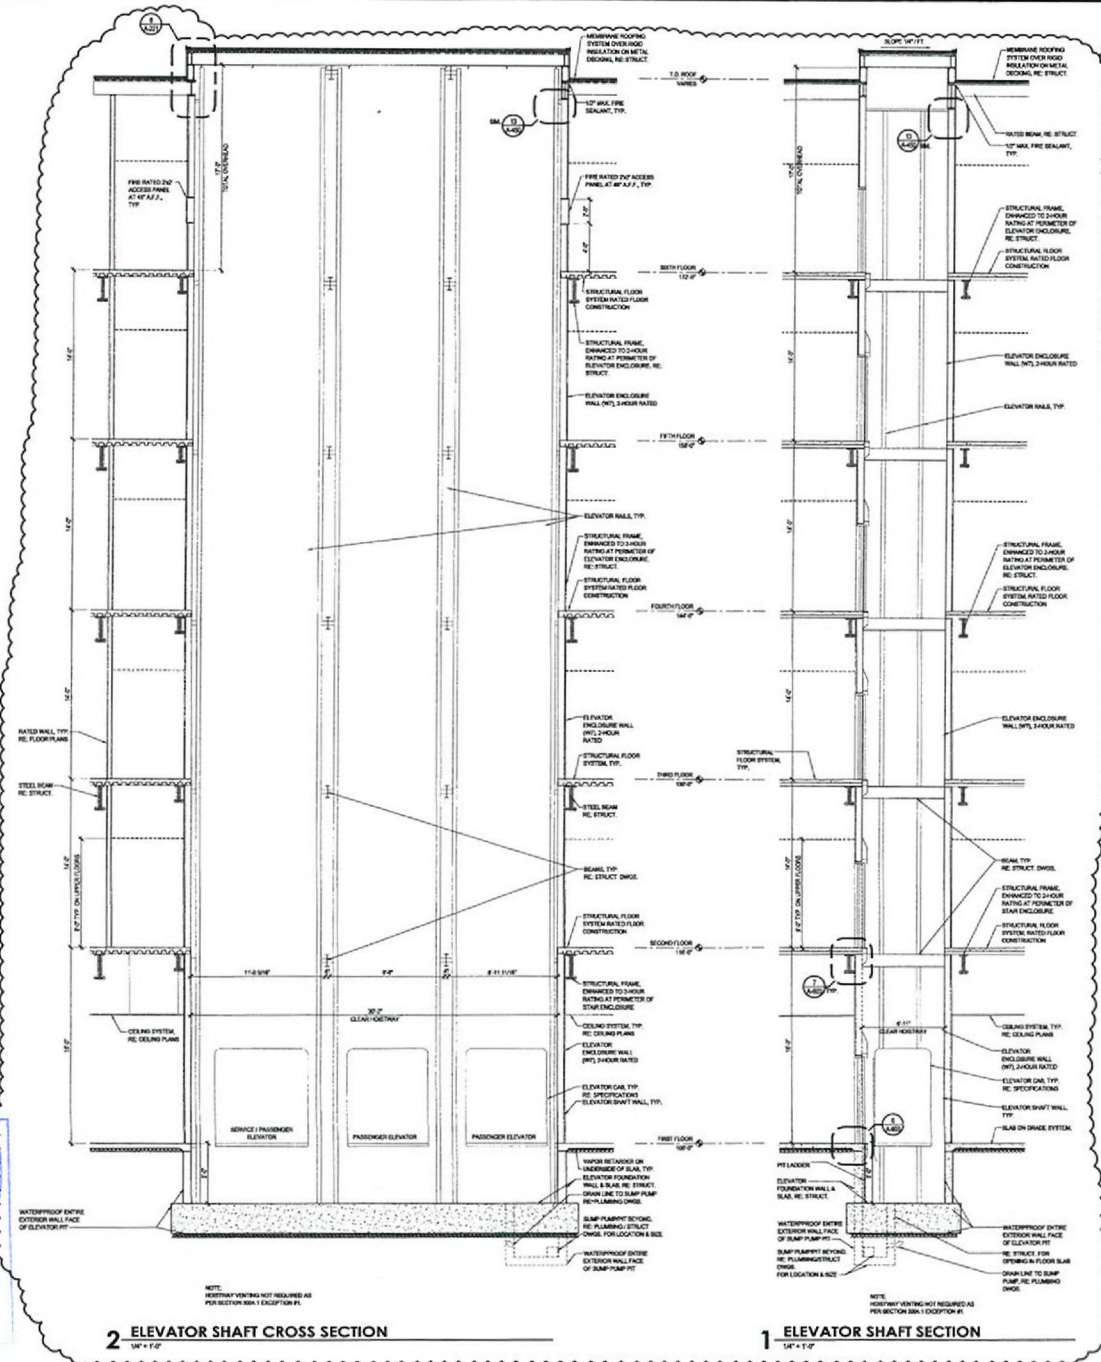

WVR-35710
10/08/09 PC

LAUTH
866 448 6500 • www.lauth.net


LAUTH PROPERTY GROUP
PROJECT: MONTICITO OFFICE BUILDING
LOCATION: MONTICITO PARKWAY
SHEET: 10/08/09 PC

SEM
BY NEVADA, LLC
10/08/09 PC

APPROVED
DATE: 10/08/09
BY: [Signature]

ELEVATOR SECTIONS
MONTICITO OFFICE BUILDING
Core and Shell
Monticito Parkway
Las Vegas, Nevada

NO.	DESCRIPTION	DATE	BY	CHECKED	APPROVED
1	REVISION				
2	REVISION				
3	REVISION				
4	REVISION				
5	REVISION				

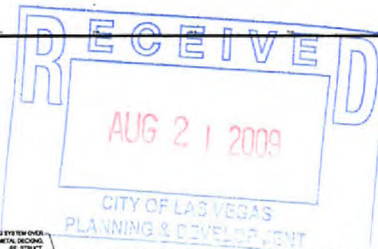

LAUTH
855 848 6500 • www.lauth.net

LAUTH ARCHITECTURE
PROJECT: MONTECITO OFFICE BUILDING
CLIENT: CITY OF LAS VEGAS
ARCHITECT: LAUTH ARCHITECTURE
DATE: 08/21/09


SEM
ON BEHALF OF
CITY OF LAS VEGAS
DATE: 08/21/09

DATE: 08/21/09
DATE: 08/21/09

STAR SECTIONS
MONTECITO OFFICE BUILDING
Core and Shell
Montecito Parkway
Las Vegas, Nevada










STAR SECTIONS

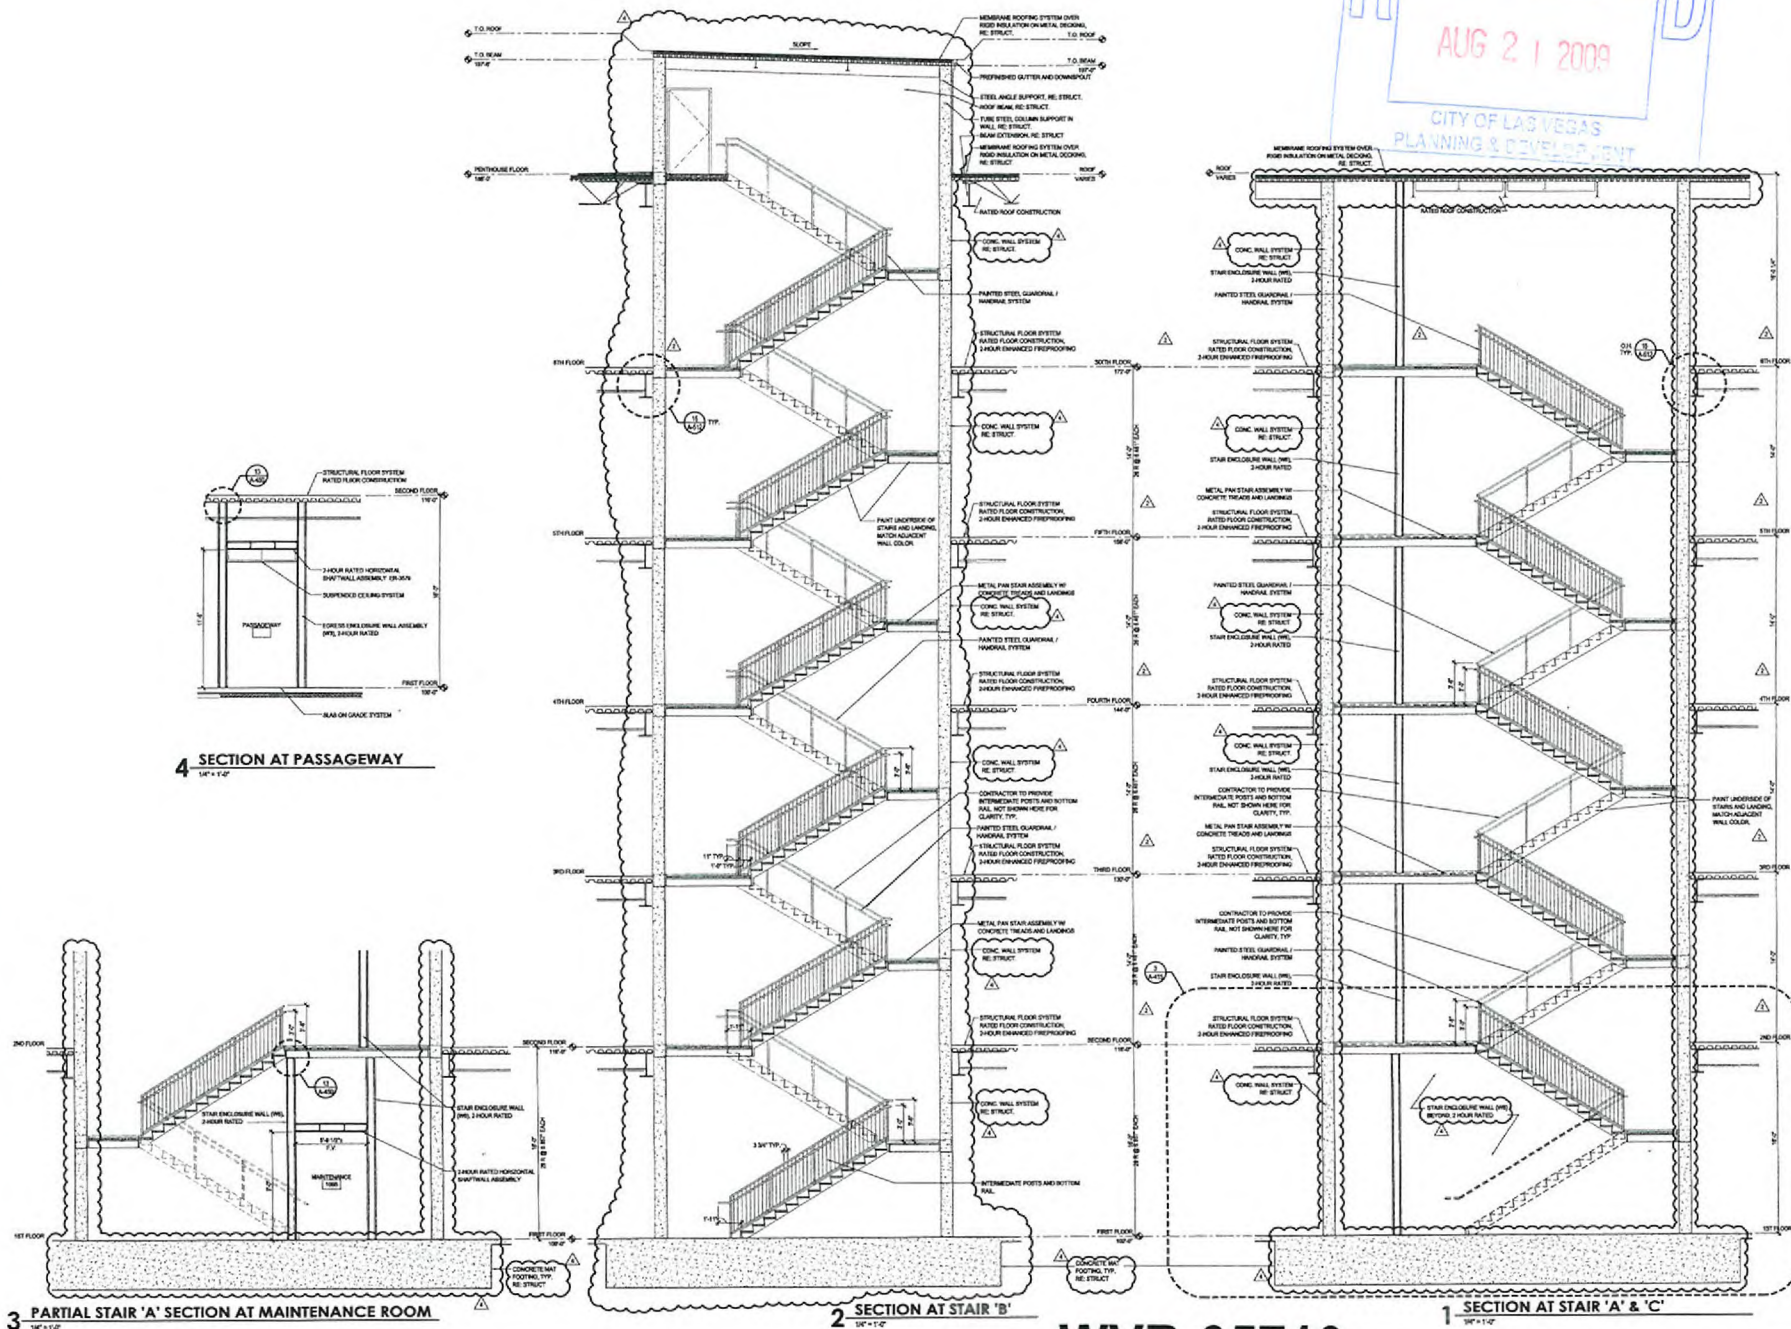

WVR-35710
10/08/09 PC

RECEIVED
AUG 21 2009
CITY OF LAS VEGAS
PLANNING & DEVELOPMENT

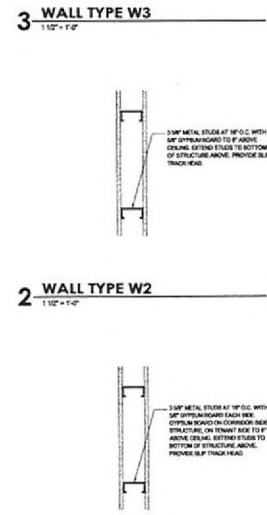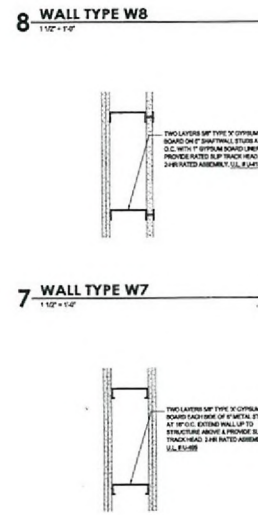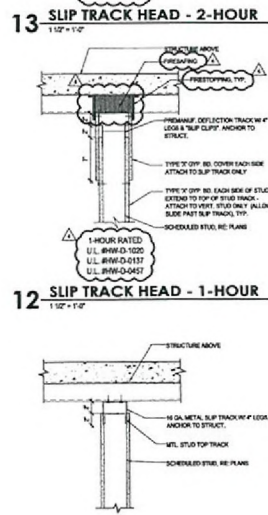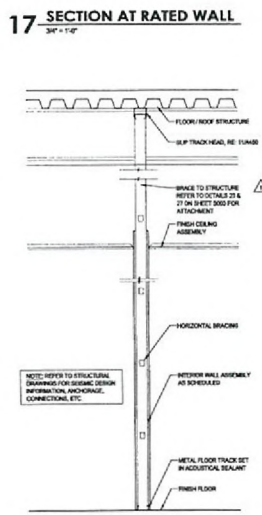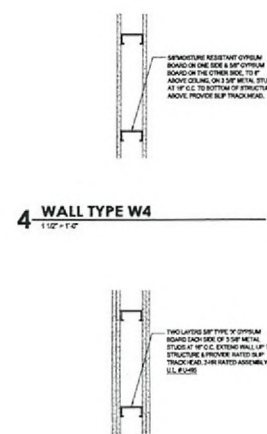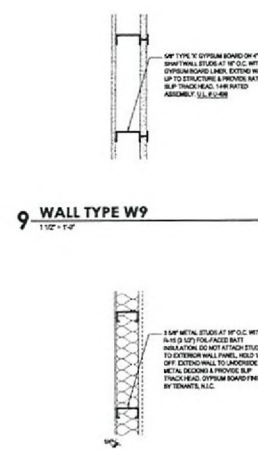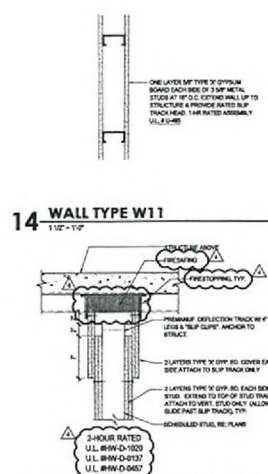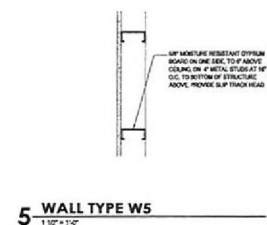


LAUTH
866 848 6500 • www.lauth.net

SEM
OF NEVADA LLC

1377 S. Colorado Blvd.
Suite 200
Denver CO 80246
303.220.8900
303.220.0700 Fax


LAUTH PROPERTY GROUP

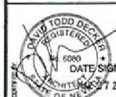

TITLE	WALL TYPES

[illegible]

RECEIVED
AUG 21 2009

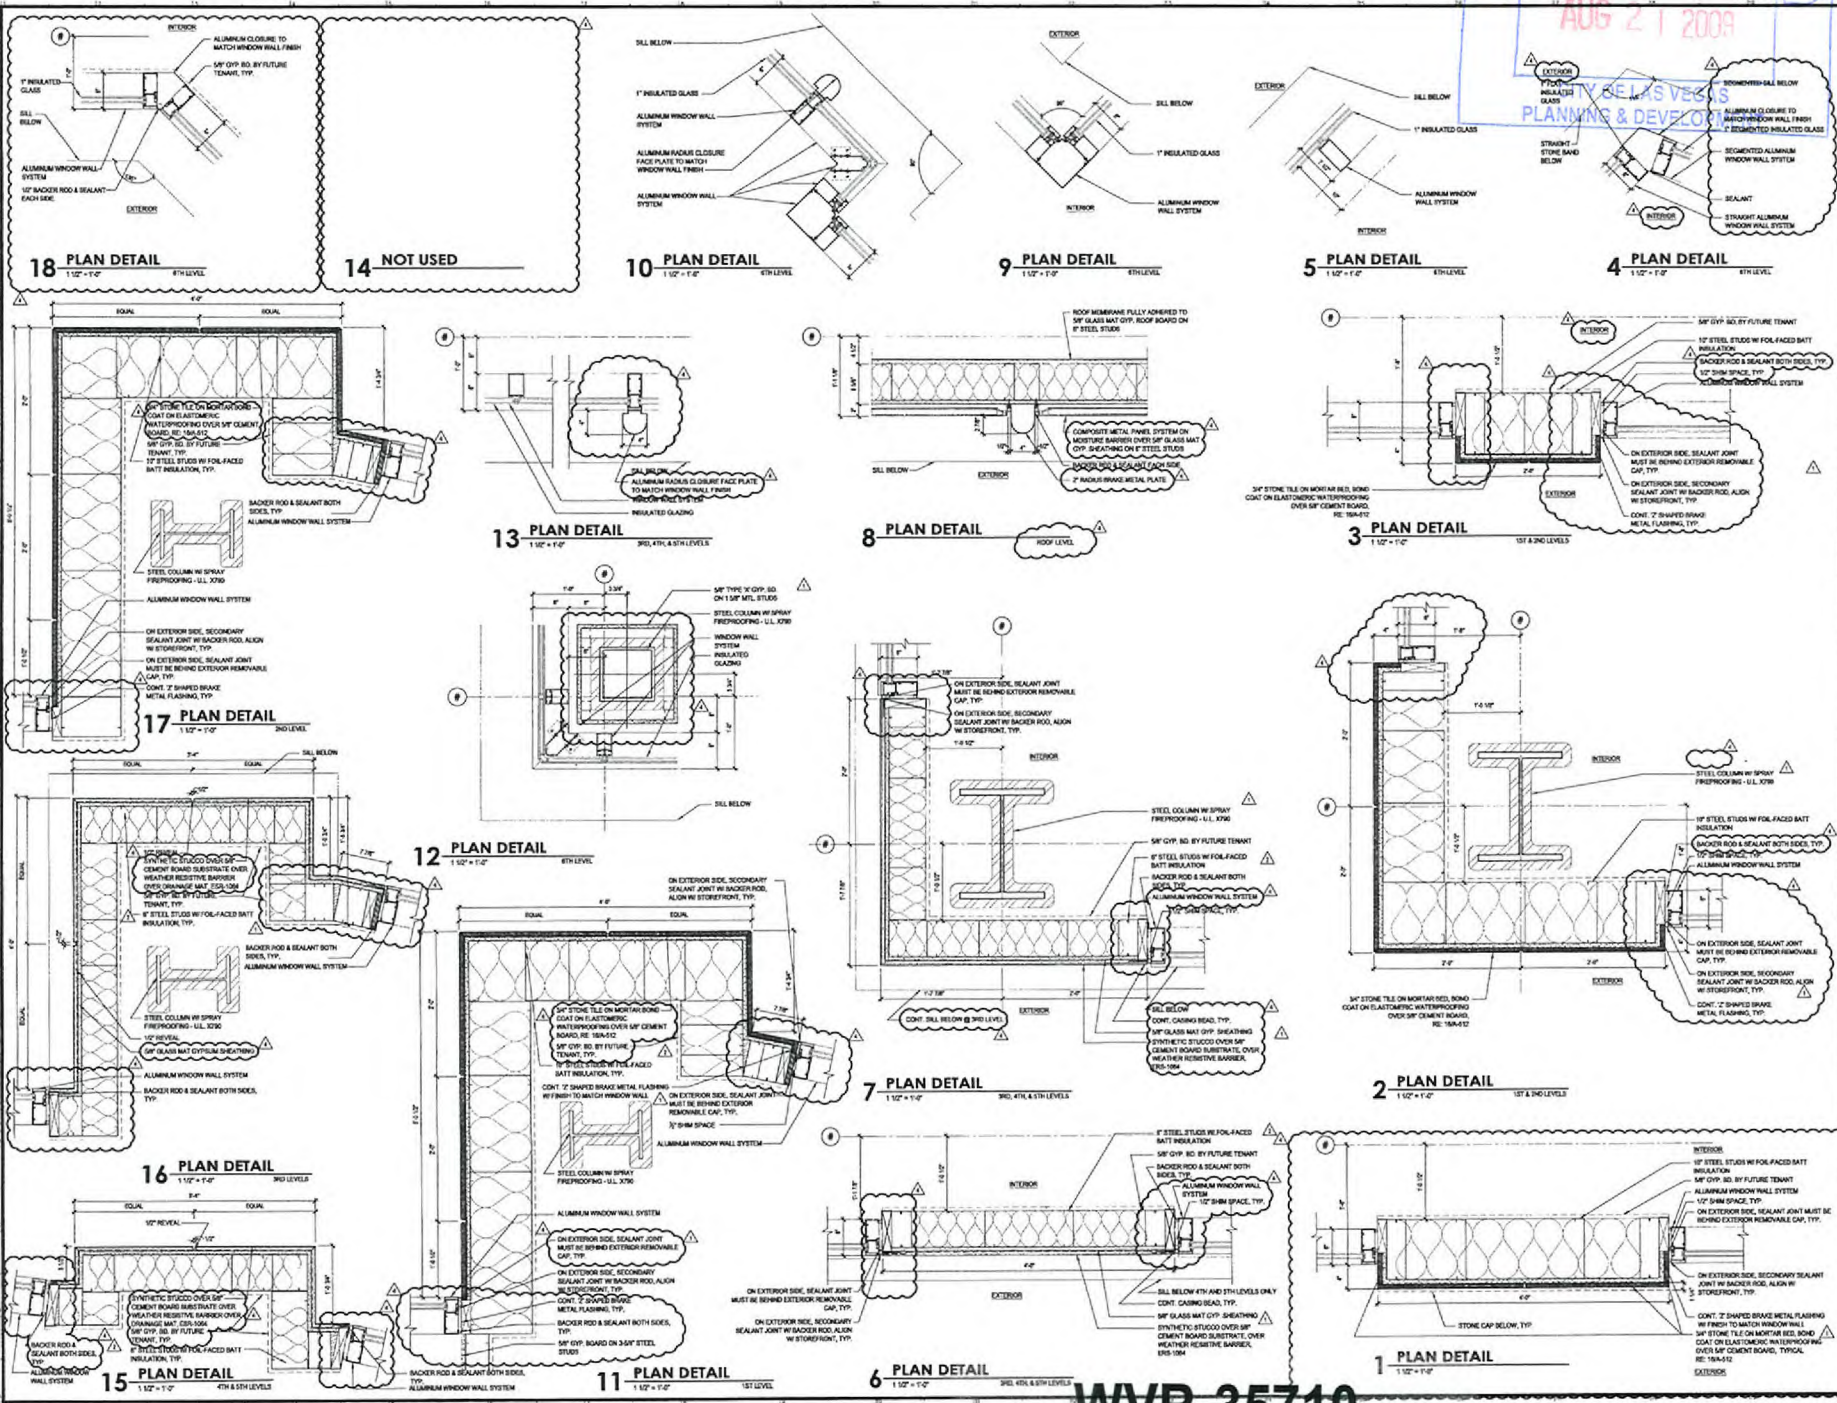

LAUTH
866 848 6500 • www.lauth.net

LAUTH PROJECT GROUP
PROJECT: MONTECITO OFFICE BUILDING
ARCHITECT: SEM
DATE: 08/08/09


SEM
OF NEVADA, LLC
4745 Colorado Blvd.
Suite 200
Las Vegas, NV 89149
702.735.2274


PLAN DETAILS
MONTECITO OFFICE BUILDING
Core and Shell
Montecito Parkway
Las Vegas, Nevada

DATE	08/08/09	BY	WTB
REVISION	08/08/09	BY	WTB
01	08/08/09	WTB	WTB
02	08/08/09	WTB	WTB
WVR-35710
10/08/09 PC

 













	C	D	E	F
1				
2				
0

1

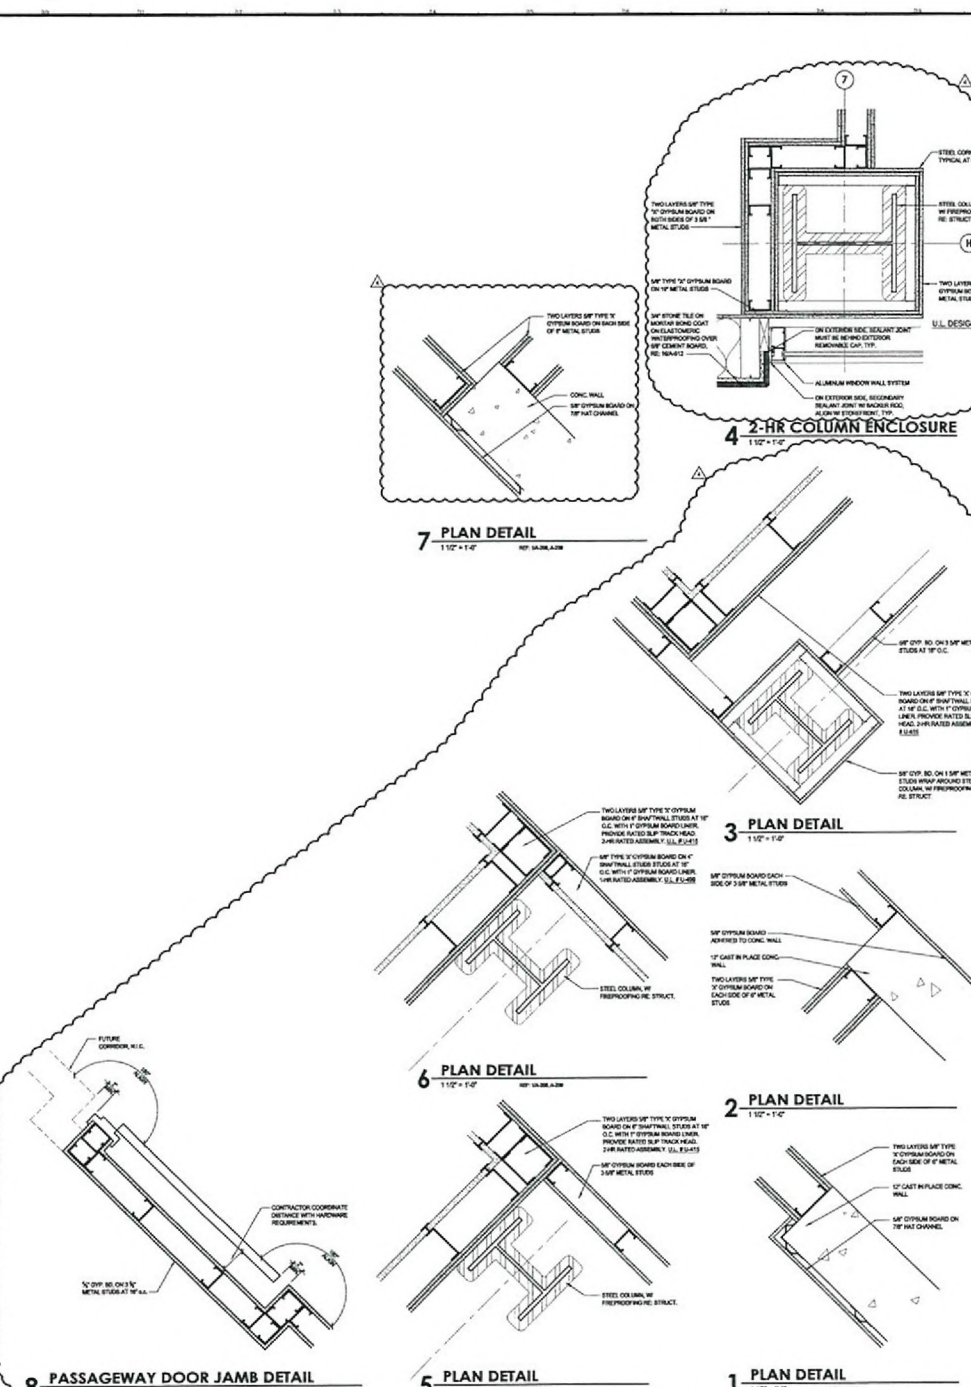

RECEIVED
AUG 21 2009
CITY OF LAS VEGAS
PLANNING & DEVELOPMENT
WVR-35710
10/08/09 PC

RECEIVED
AUG 21 2009
 CITY OF LAS VEGAS
 PLANNING & DEVELOPMENT

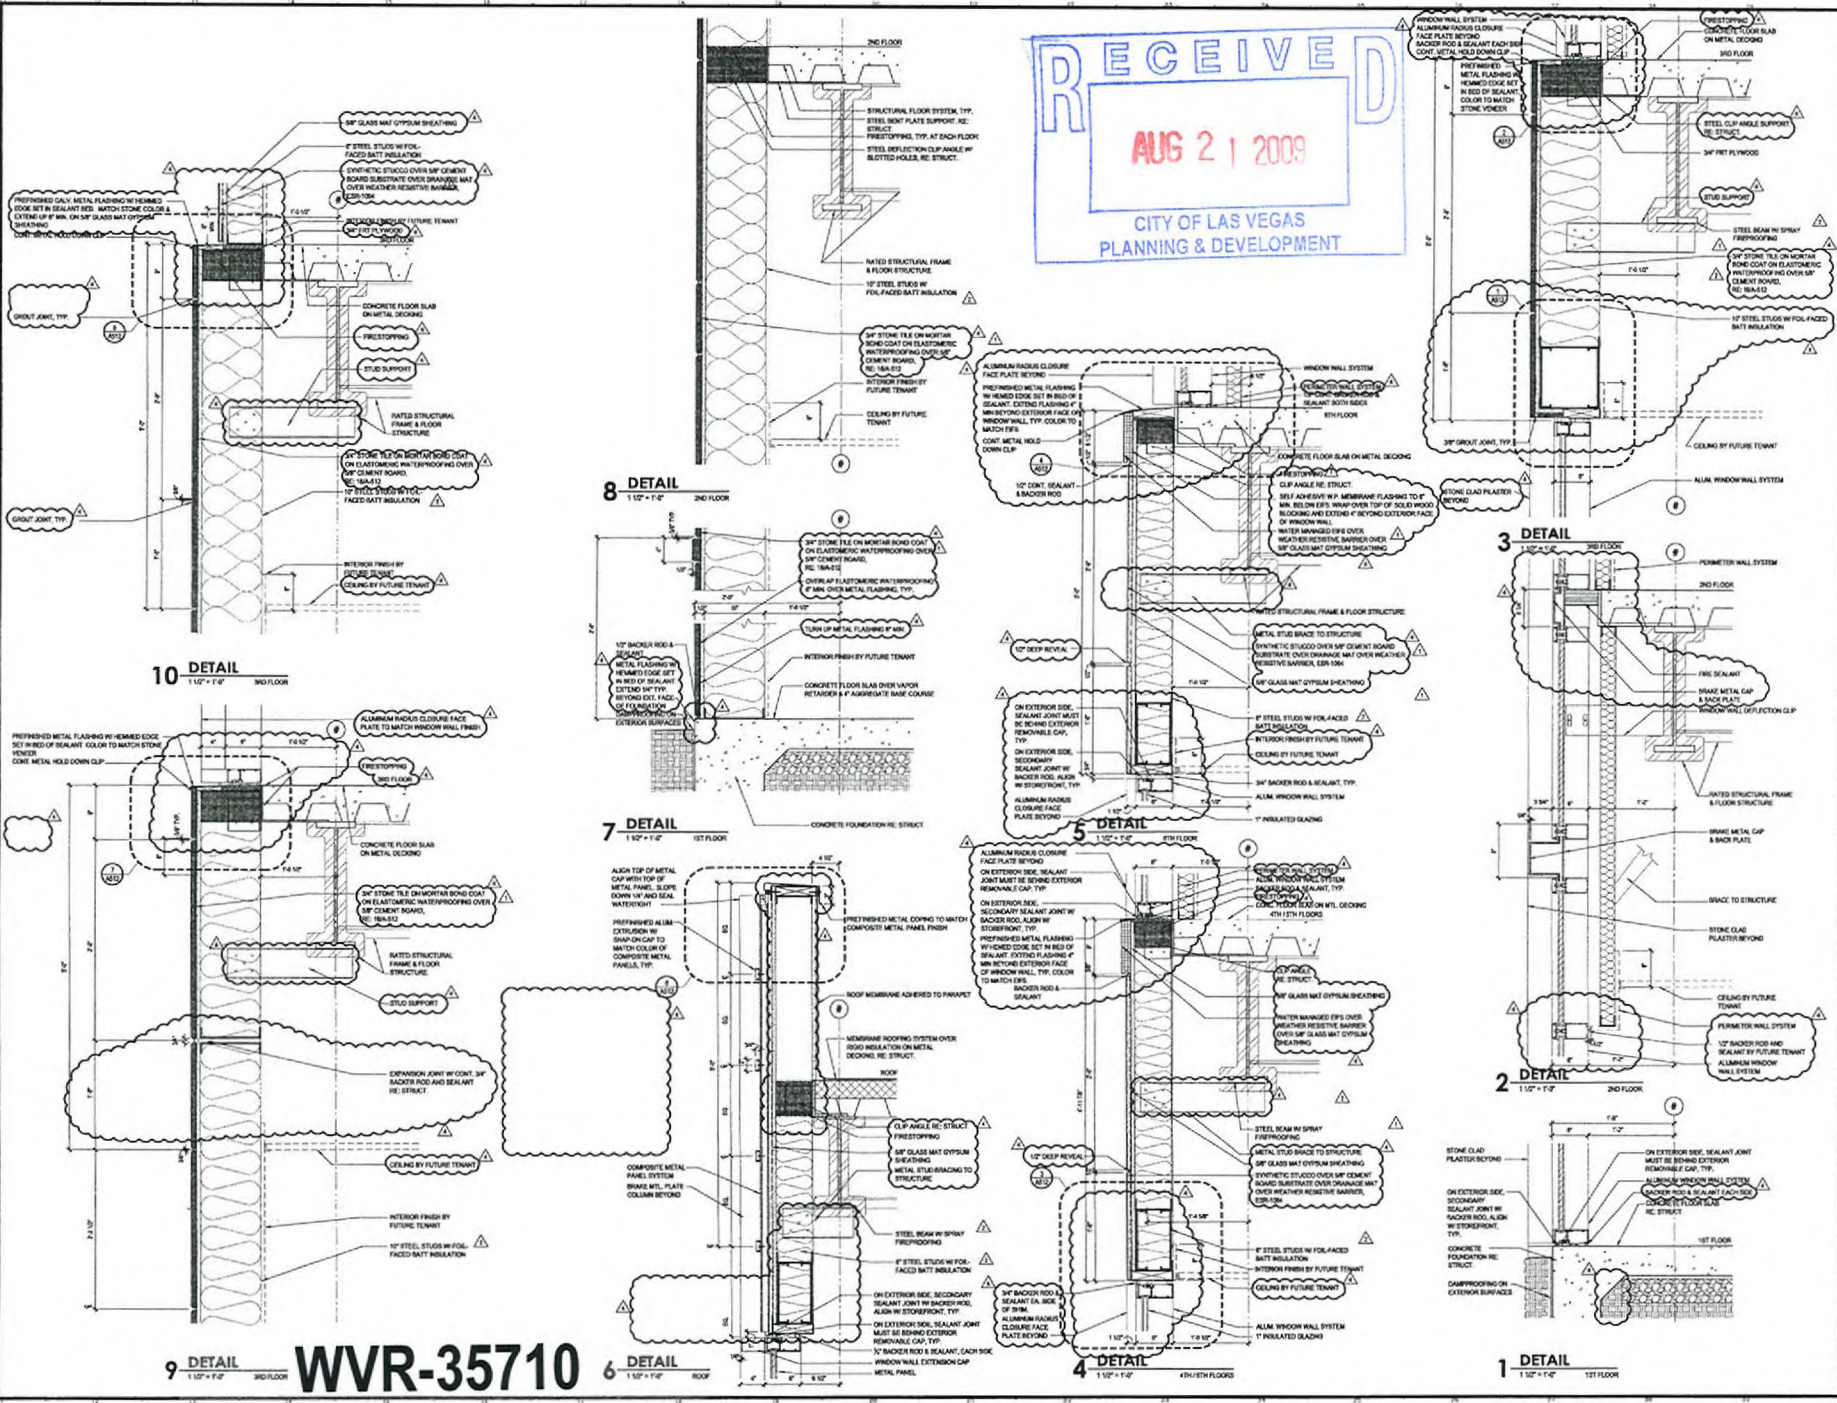

LAUTH
 866 848 6500 • www.lauth.net


SEM
 866 848 6500 • www.sem.com

SECTION DETAILS
 MONTECITO OFFICE BUILDING
 Core and Shell
 Montecito Parkway
 Las Vegas, Nevada




REVISIONS

NO.	DATE	DESCRIPTION
1	10/08/09	PC

SECTION DETAILS
A-510

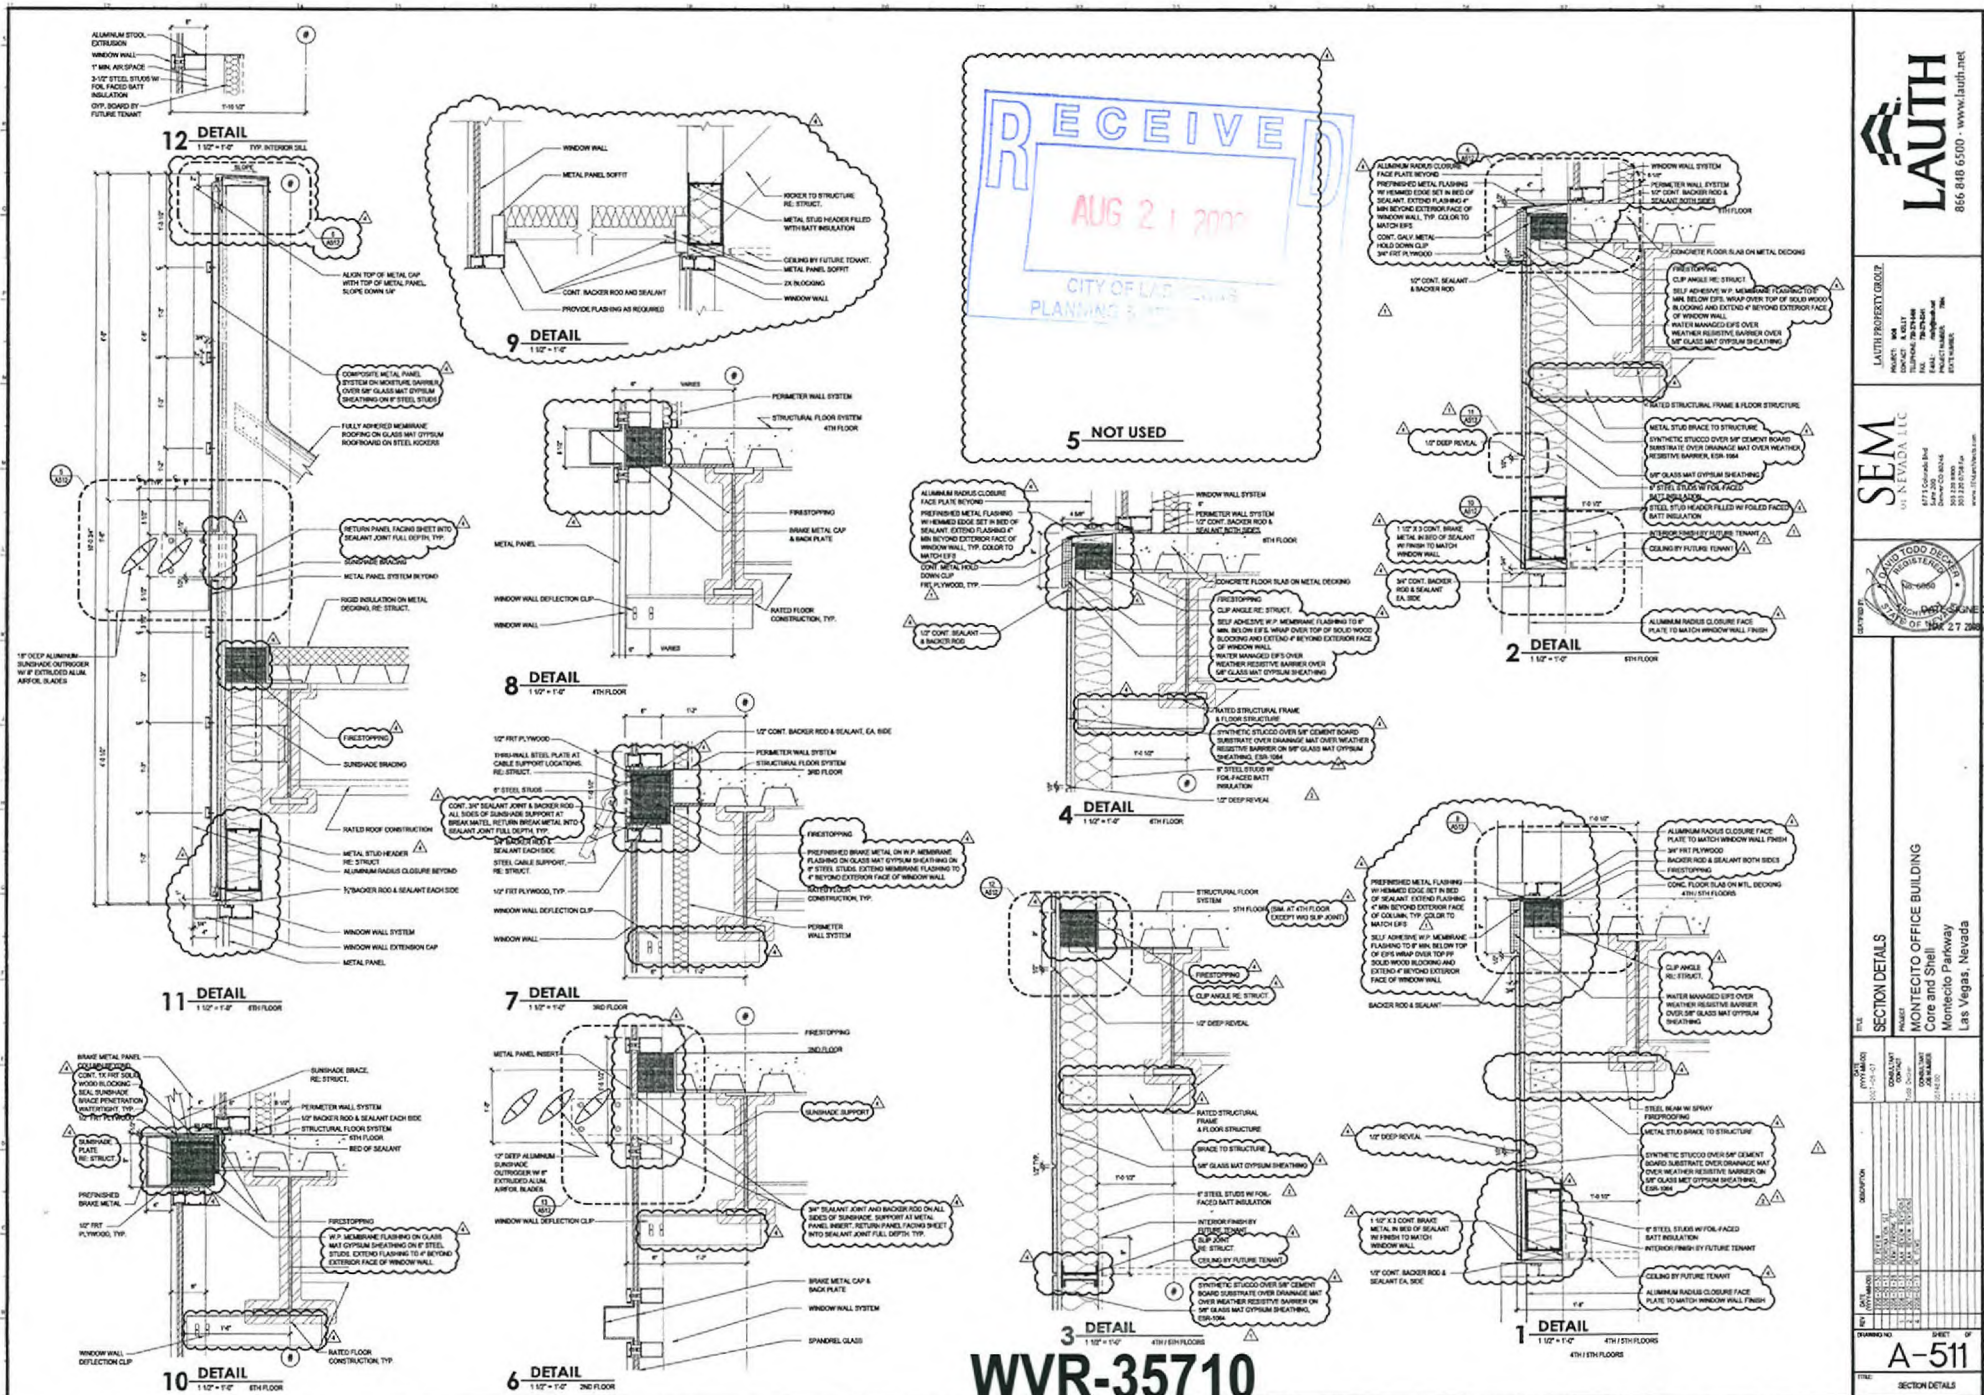

RECEIVED
AUG 21 2009
CITY OF LAS VEGAS
PLANNING & DEVELOPMENT

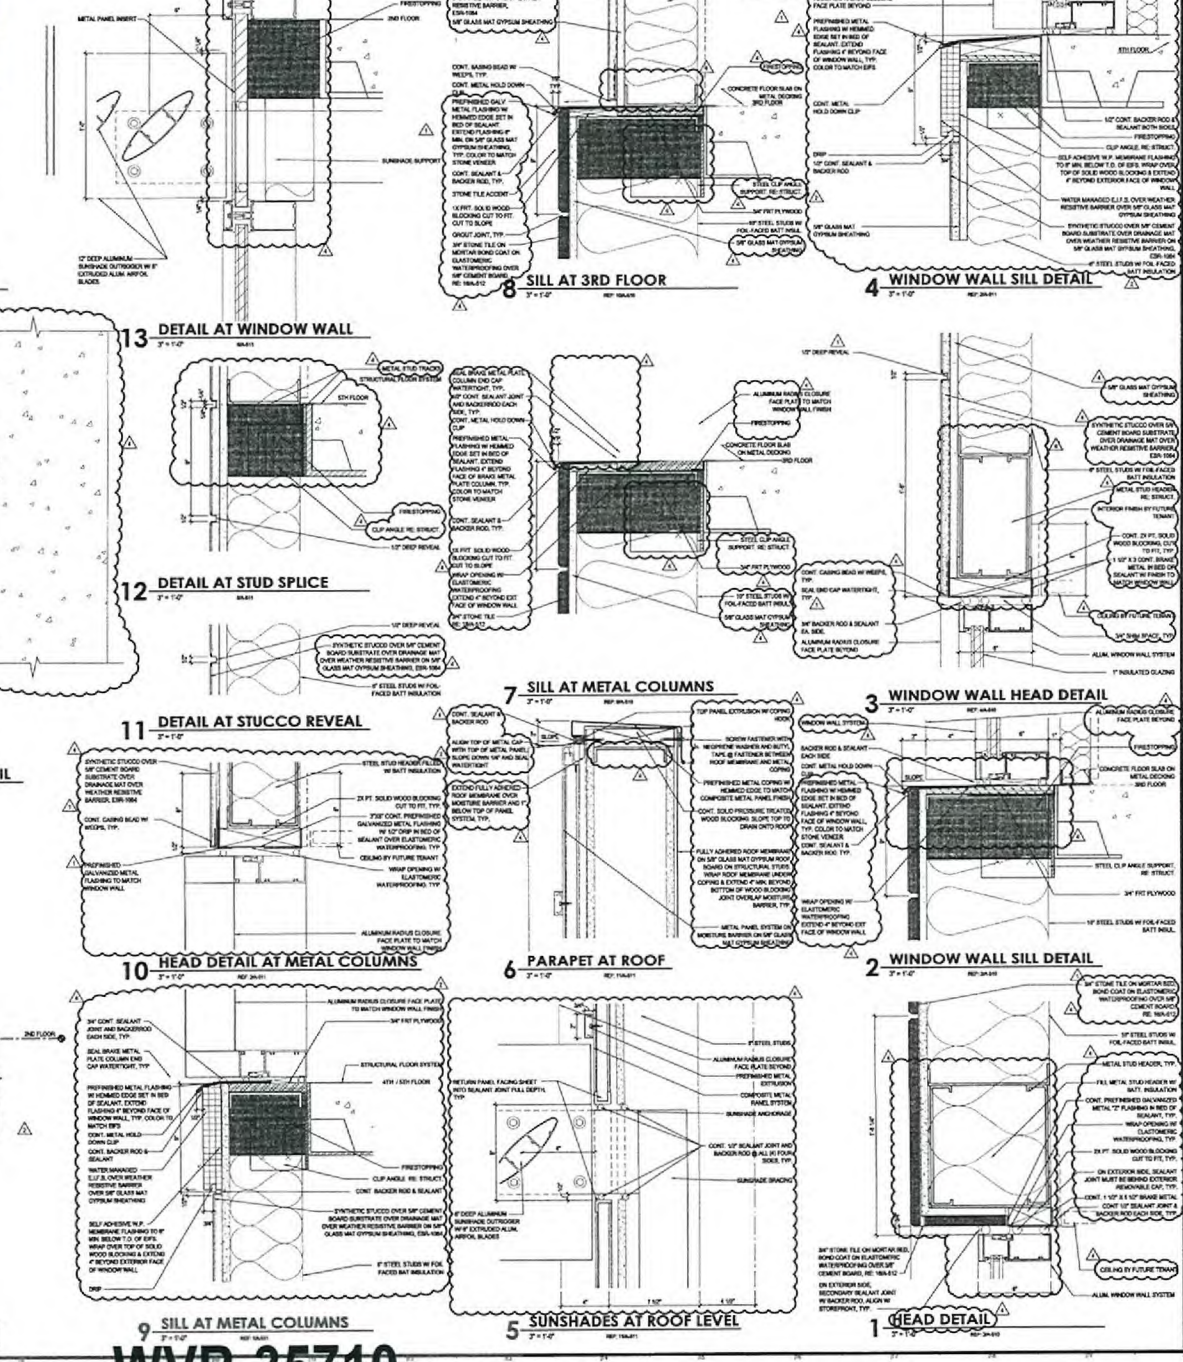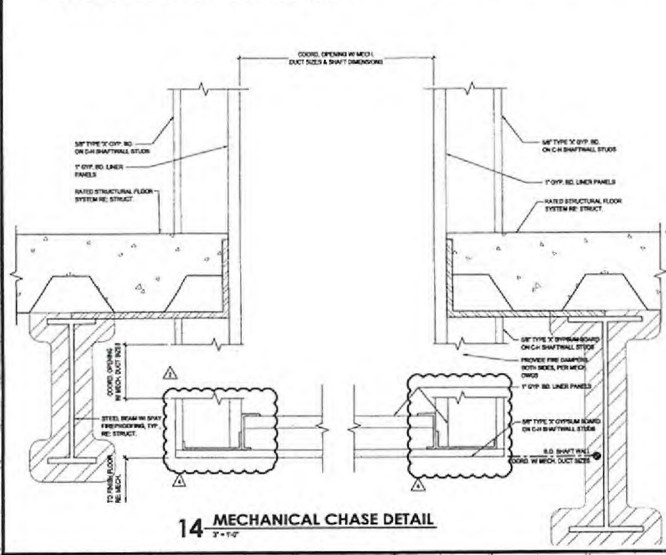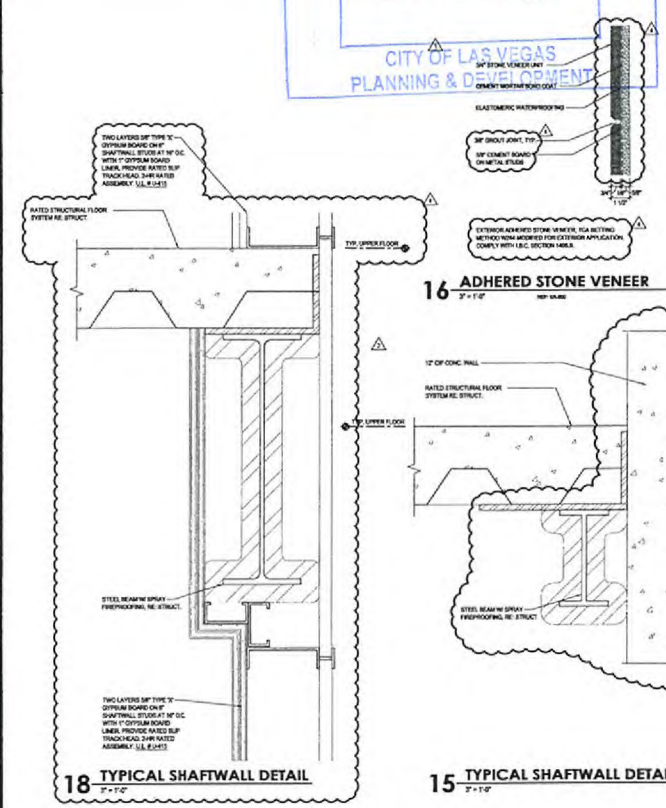

LAUTH
866 848 6500 • www.lauth.net


SEM
IN NEVADA LLC

SECTION DETAILS
MONTECITO OFFICE BUILDING
Core and Shell
Montecito Parkway
Las Vegas, Nevada


A-512
SECTION DETAILS

[illegible]


WVR-35710
10/08/09 PC

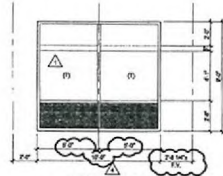


18 WINDOW T

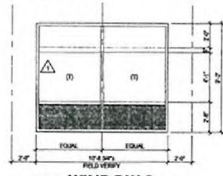


17 WINDOW S

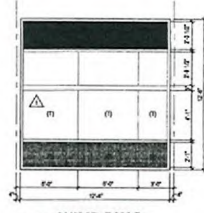


14 WINDOW P

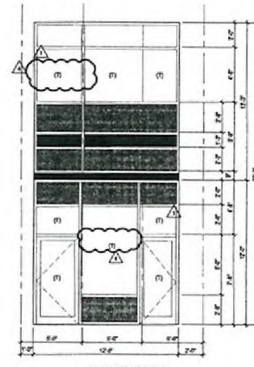


11 WINDOW L

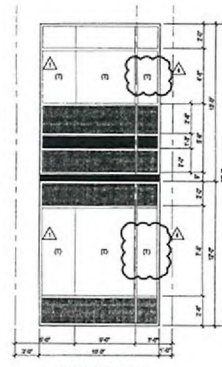


8 WINDOW H

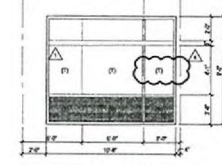


4 WINDOW D

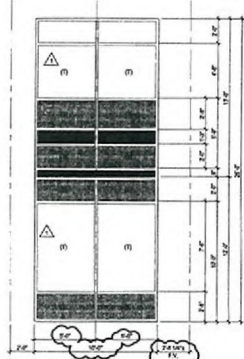


16 WINDOW R

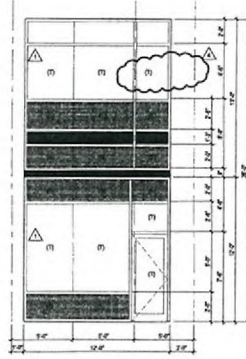


13 WINDOW N

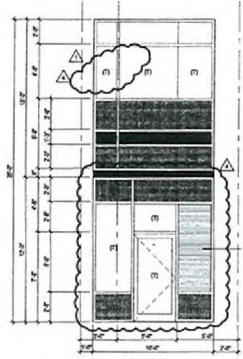


10 WINDOW K

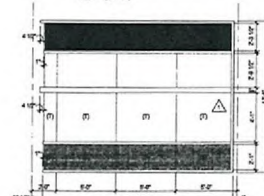


7 WINDOW G

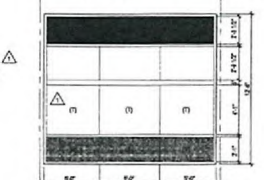


6 WINDOW F

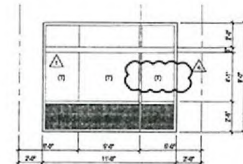


3 WINDOW C

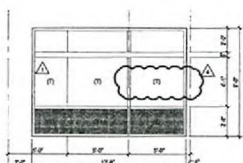

2 WINDOW B

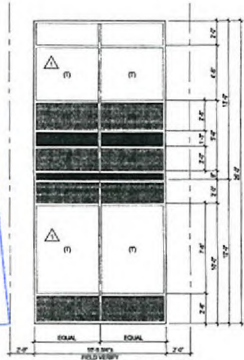


15 WINDOW Q

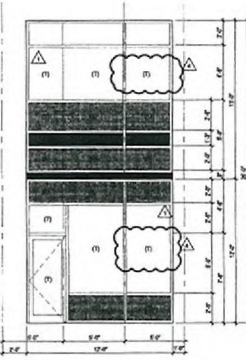


12 WINDOW M
14'0" x 10'0"



9 WINDOW J
14'0" x 10'0"

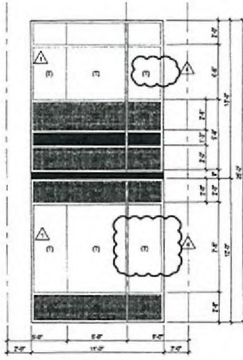

5 WINDOW E
14'0" x 10'0"

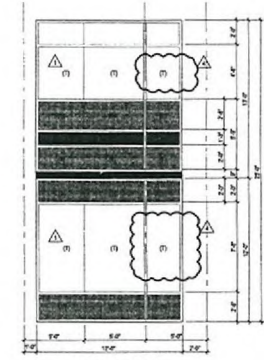

1 WINDOW A
14'0" x 10'0"

GENERAL NOTES:

1. ALL EXTERIOR WINDOW AND DOOR ASSEMBLIES SHALL CONFORM TO IBC SECTION 711.4.1.
2. ALL GLASS UNITS AND GLAZING SHALL CONFORM TO IBC SECTION 711.4.2 AND 711.4.3.

ABBREVIATIONS LEGEND:

- (S) SPANGLER GLASS
(T) TINTED

LAUTH
866 848 6500 · www.lauth.net

LAUTH PROPERTY GROUP
PROJECT: 848
OWNER: SEM
DESIGNER: LAUTH
DATE: 10/08/09
PROJECT NAME: MONTICITO OFFICE BUILDING
FILE NAME: A-602

SEM
N.V. LLC
1111 S. Las Vegas Blvd.
Suite 1000
Las Vegas, NV 89101

REGISTERED
ARCHITECT
DATE SIGNED
OF YEAR 27 2009

WINDOW ELEVATIONS
MONTICITO OFFICE BUILDING
Core and Shell
Monticito Parkway
Las Vegas, Nevada



DATE	DESCRIPTION	BY	CHECKED
10/08/09	WINDOW ELEVATIONS	LAUTH	LAUTH
10/08/09	WINDOW ELEVATIONS	LAUTH	LAUTH
WINDOW ELEVATIONS




RECEIVED
AUG 21 2009
CITY OF LAS VEGAS
PLANNING & DEVELOPMENT

WVR-35710
10/08/09 PC


WVR-35710
10/08/09 PC

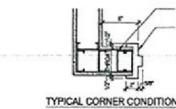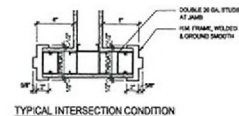


5 TYPICAL JAMB DETAILS

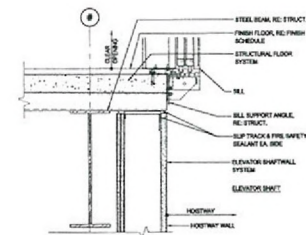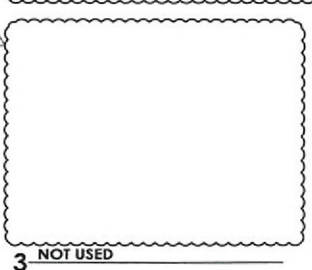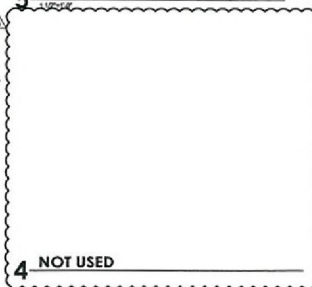


7 ELEVATOR SILL DETAIL

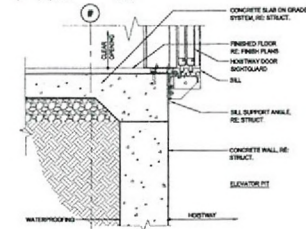

6 ELEVATOR SILL DETAIL

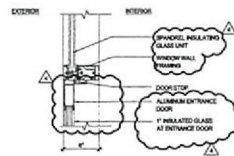

2 WINDOW WALL / ENTRANCE DOOR HEAD

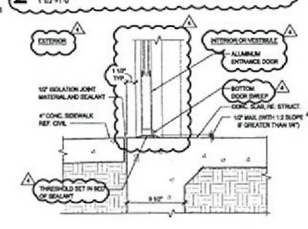

1 WINDOW WALL DOOR SILL

LAUTH
866 848 6500 · www.lauth.net

LAUTH PROPERTY GROUP

SEM
ON: NEVADA, LLC
4775 Colorado Blvd.
Suite 200
Las Vegas, NV 89144
888.222.8888
www.semllc.com

DATE DESIGNED: 10/27/09
DATE OF REVIEW: 10/27/09

WINDOW + DOOR DETAILS
PROJECT: MONTECITO OFFICE BUILDING
Core and Shell
Montecito Parkway
Las Vegas, Nevada

NO.	DESCRIPTION	DATE	BY	CHECKED
1	WINDOW + DOOR DETAILS	10/27/09	LAUTH	LAUTH


A-603
WINDOW + DOOR DETAILS




LAUTH
866 648 5500 - www.lauth.net

LAUTH PROPERTY GROUP



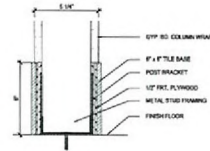


5 TOILET PARTITION AT BASE
3" x 1'-0"

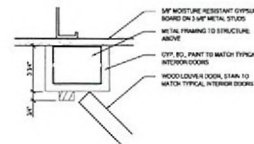


4 TOILET PARTITION COLUMN
3" x 1'-0"

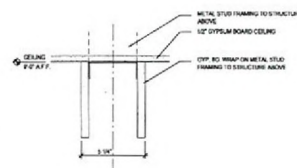

3 TOILET PARTITION AT HEAD
3" x 1'-0"

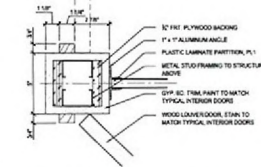


2 TOILET PARTITION COLUMN
3" x 1'-0"

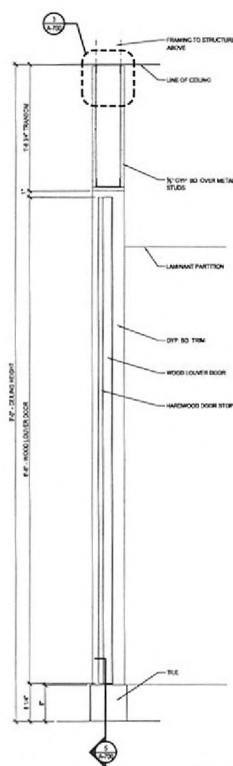

6 TOILET PARTITION SECTION
1'-0\"/>

- TYPICAL RESTROOM AND JANITOR ACCESSORIES**
ALL FIXTURES BY KOBROCK UNLESS NOTED OTHERWISE
- ① GRAB BAR, 36\"/>

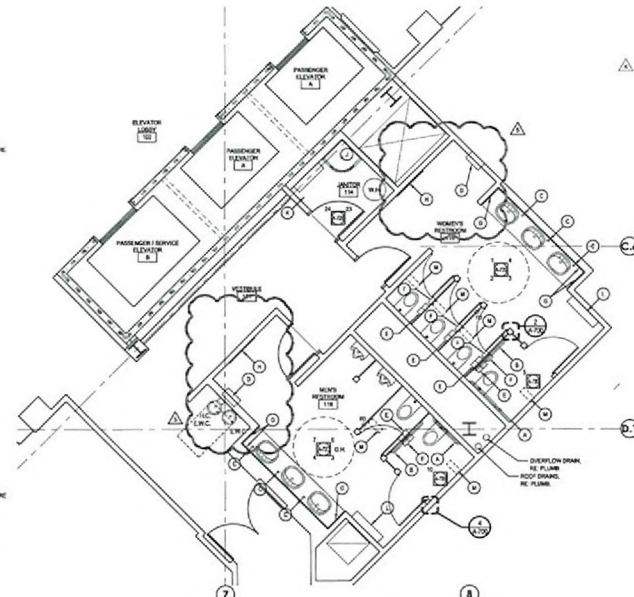

1 TYPICAL RESTROOM ACCESSORY PLAN
1'-0\"/>

WVR-35710
10/08/09 PC

SCALE: 1/8\"/>

RESTROOM ACCESSORY PLAN

PROJECT:
MONTECITO OFFICE BUILDING
Core and Shell
Montecito Parkway
Las Vegas, Nevada


DATE:
10/08/09

DESCRIPTION:
RESTROOM ACCESSORY PLAN


DATE:
10/08/09

SCALE:
1/8\"/>


SHEET:
A-700

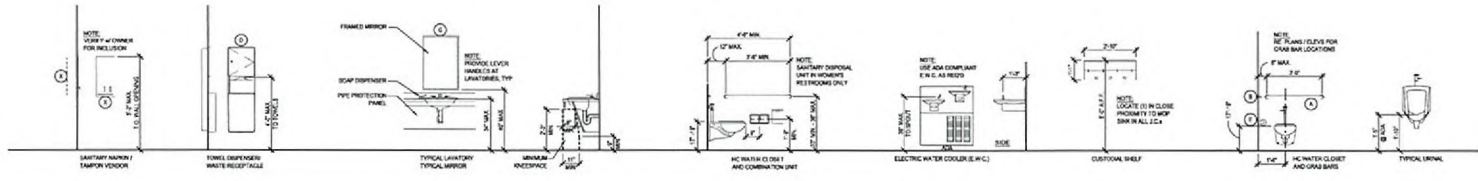


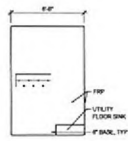


24 JANITOR RM 114, TYP.
1/4" x 1/2"

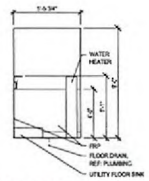


23 JANITOR RM 114, TYP.
1/4" x 1/2"

25 ACCESSIBILITY GUIDELINES
3/4" x 1/2"


NOTE: EMPTY AND METAL ACCESSORIES AND FIXTURES FOR MEN GUARANTEES AND AS REQUIRED BY THE MANUFACTURER TO MEET ACCESSIBILITY REQUIREMENTS AND USABILITY.

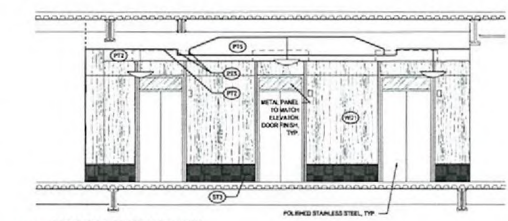

20 UPPER LEVEL LOBBY
1/4" x 1/2"

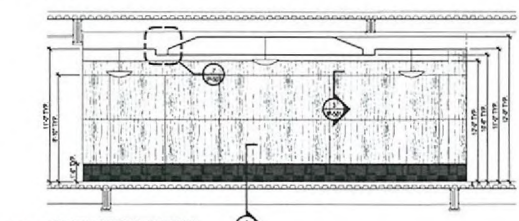


12 UPPER LEVEL LOBBY
1/4" x 1/2"

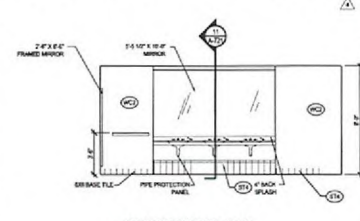


4 WOMEN RM 116
1/4" x 1/2"

16 NOT USED

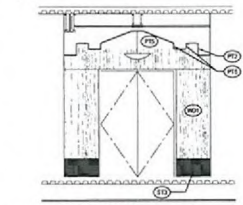


15 UPPER LEVEL LOBBY
1/4" x 1/2"

8 NOT USED

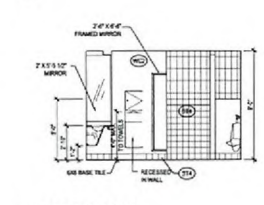


7 MEN RM 118
1/4" x 1/2"

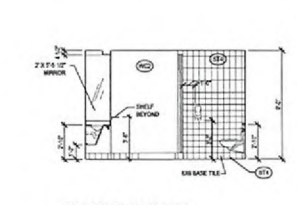

3 WOMEN RM 116
1/4" x 1/2"


19 NOT USED

14 NOT USED

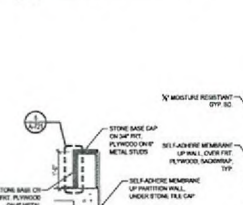


13 Planter Detail
3/4" x 1/2"


10 MEN RM 118, TYP.
1/4" x 1/2"

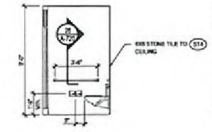

6 MEN RM 118
1/4" x 1/2"

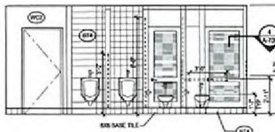

2 WOMEN RM 116
1/4" x 1/2"


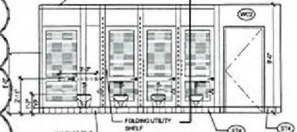


18 NOT USED

17 NOT USED

9 NOT USED

5 WOMEN RM 116, TYP.
1/4" x 1/2"

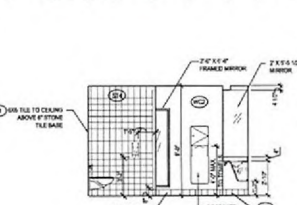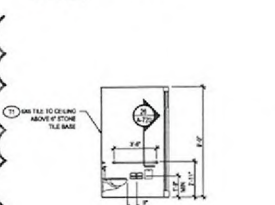

1 WOMEN RM 116
1/4" x 1/2"

WVR-35710
10/08/09 PC

21 NOT USED

RECEIVED
CITY OF LAS VEGAS
PLANNING & DEVELOPMENT
10/08/09

RECEIVED
 10/21/2009
 CITY OF LAS VEGAS
 PLANNING & DEVELOPMENT

- MATERIALS LEGEND:**
- (P1) CARPET - INDOOR SPOT (3037) - 280 GRAING
 - (P2) CARPET - BROWN BROWN LEON (3041) - CHORDS (1011)
 - (P3) CARPET - ALL COMMERCIAL - PLATEAU (3052) - 270 COLORADO
 - (P4) PLASTIC LAMINATE - NEVADA - CHAMBERLAIN PULVER TEXTURED (30001)
 - (P5) PAINT - WHITE BASE - 280 EMB
 - (P6) PAINT - BEIGE BASE - 280 EMB
 - (P7) PAINT - INTELLECTUAL GRAY - 280 EMB
 - (P8) PAINT - VORTEX - 280 EMB
 - (P9) PAINT - ALA WOOD - 280 EMB
 - (P10) STONE TILE - ARIZONA TILE - GRILLD SANDO
 - (P11) STONE TILE - ARIZONA TILE - TROPIC MARIANA
 - (P12) STONE TILE - CHAMBERLAIN PULVER
 - (P13) STONE TILE - ARIZONA TILE - BEING MARIANA (20117 & 1011)
 - (P14) PORCELAIN TILE
LAUTH
 866 648 6300 - www.lauth.net

LAUTH PROPERTY GROUP


INTERIOR ELEVATIONS
 MONTECITO OFFICE BUILDING
 Core and Shell
 Montecito Parkway
 Las Vegas, Nevada

WVR-35710
10/08/09 PC


A-721

10/08/09 PC


10/08/09 PC

10/08/09 PC

17 INTERIOR DETAILS
 12"x12"

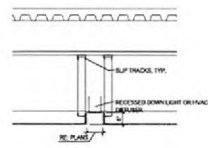


12 INTERIOR SECTION
 12"x12"

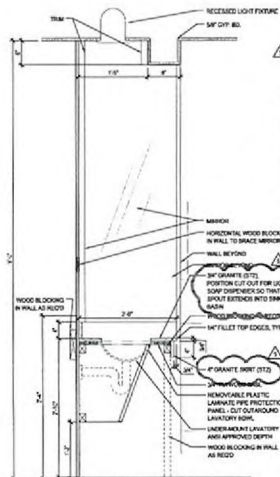


8 NOT USED

7 INTERIOR DETAILS
 12"x12"

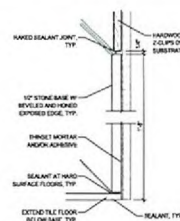


6 NOT USED

16 INTERIOR ELEVATIONS
 12"x12"

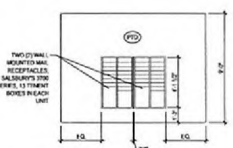


15 INTERIOR ELEVATIONS
 12"x12"

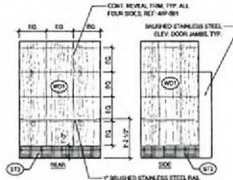

11 INTERIOR DETAILS
 12"x12"




14 INTERIOR DETAILS
 12"x12"

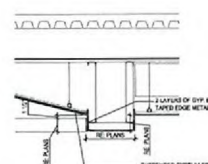


10 INTERIOR DETAILS
 12"x12"




13 INTERIOR DETAILS
 12"x12"

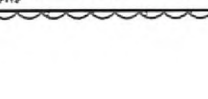


9 INTERIOR DETAILS
 12"x12"

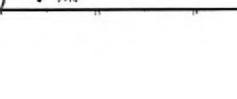


5 INTERIOR ELEVATIONS
 12"x12"

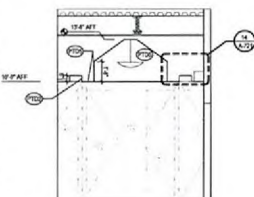


4 INTERIOR ELEVATIONS
 12"x12"

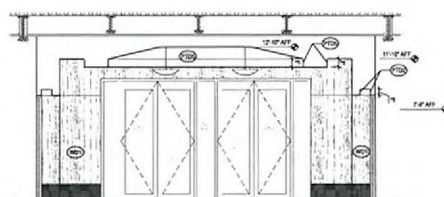

3 INTERIOR ELEVATIONS
 12"x12"

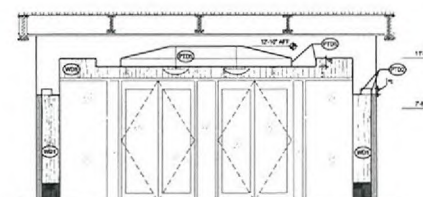

2 INTERIOR ELEVATIONS
 12"x12"

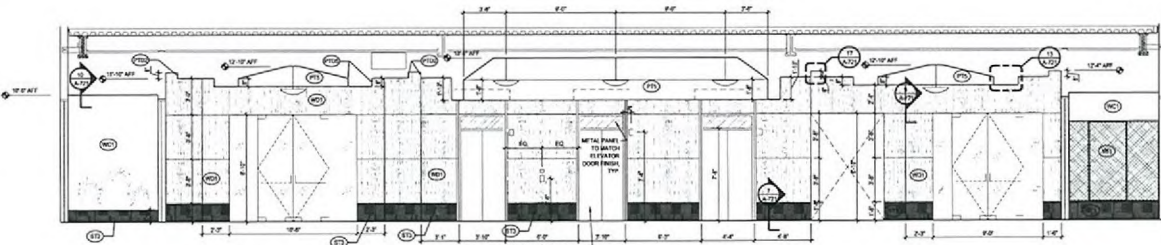

1 INTERIOR ELEVATIONS
 12"x12"

