



PLANNING & DEVELOPMENT DEPARTMENT

STATEMENT OF FINANCIAL INTEREST

Case Number: **SUP-35755** APN: 139-27-812-007

Name of Property Owner: 610 LLC COBLENTZ ALEXANDER & SLG LIVING TRUST

Name of Applicant: USVI

Name of Representative: CLOUDBREAK LAS VEGAS LLC

To the best of your knowledge, does the Mayor or any member of the City Council or Planning Commission have any financial interest in this or any other property with the property owner, applicant, the property owner or applicant's general or limited partners, or an officer of their corporation or limited liability company?

☐ Yes

☒ No

If yes, please indicate the member of the City Council or Planning Commission who is involved and list the name(s) of the person or persons with whom the City Official holds an interest. Also list the Assessor's Parcel Number if the property in which the interest is held is different from the case parcel.

City Official: _____

Partner(s): _____

APN: _____


Signature of Property Owner: _____


Print Name: Suzanne Feld

Subscribed and sworn before me CHERI LYNN QUIJANO

This 30th day of JULY, 2009

Notary Public in and for said County and State

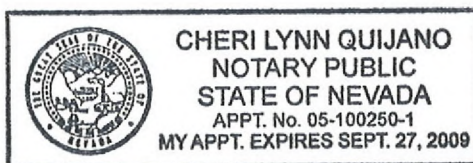

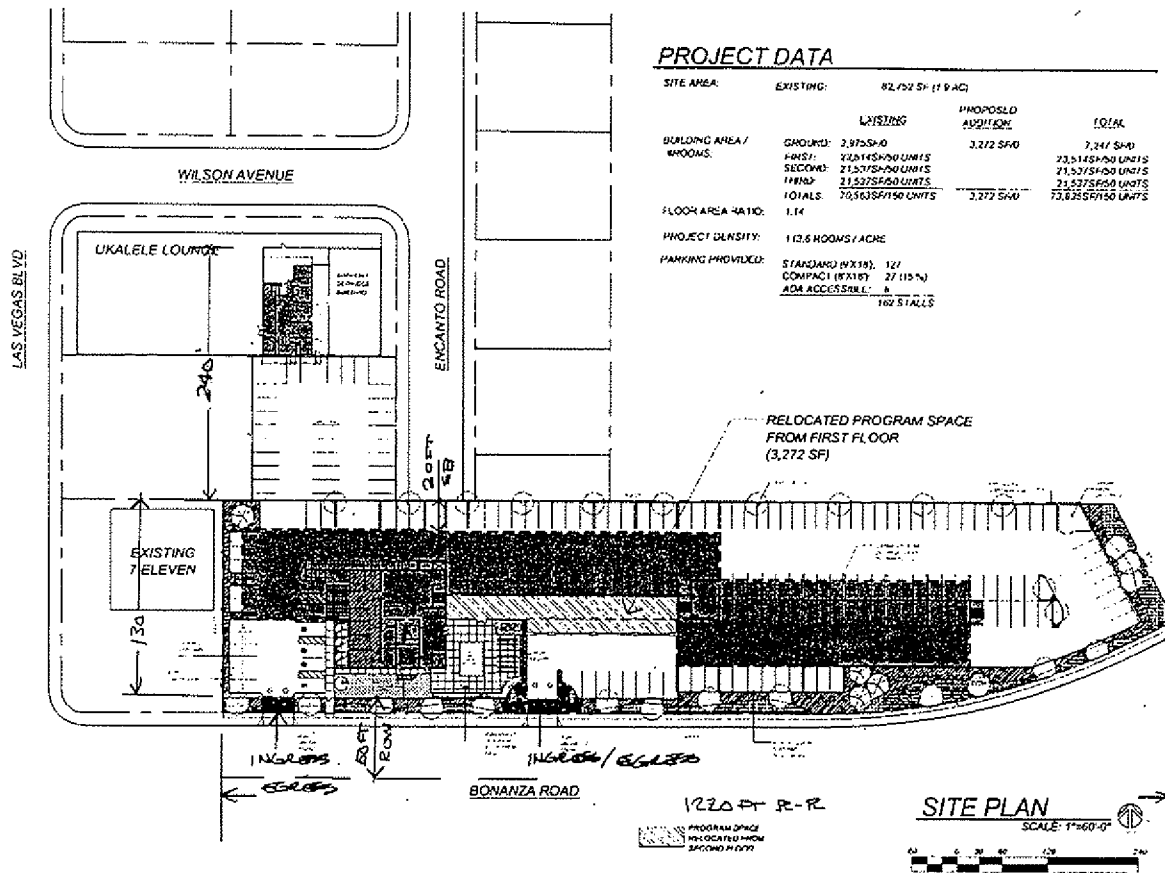

SUAREZ
ARCHITECTS, INC.


US VETS AT THE MEADOWS
LAS VEGAS, NEVADA


ALL RIGHTS RESERVED. NO PART OF THIS DOCUMENT MAY BE REPRODUCED OR TRANSMITTED IN ANY FORM OR BY ANY MEANS, ELECTRONIC OR MECHANICAL, WITHOUT PERMISSION IN WRITING FROM SUAREZ ARCHITECTS, INC.

DATE: 10/08/09
BY: [Signature]
FOR: [Signature]

1. []
2. []
3. []
4. []
5. []
6. []
7. []
8. []
9. []
10. []

SUP-35755
10/08/09 PC

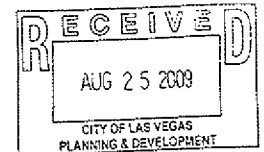

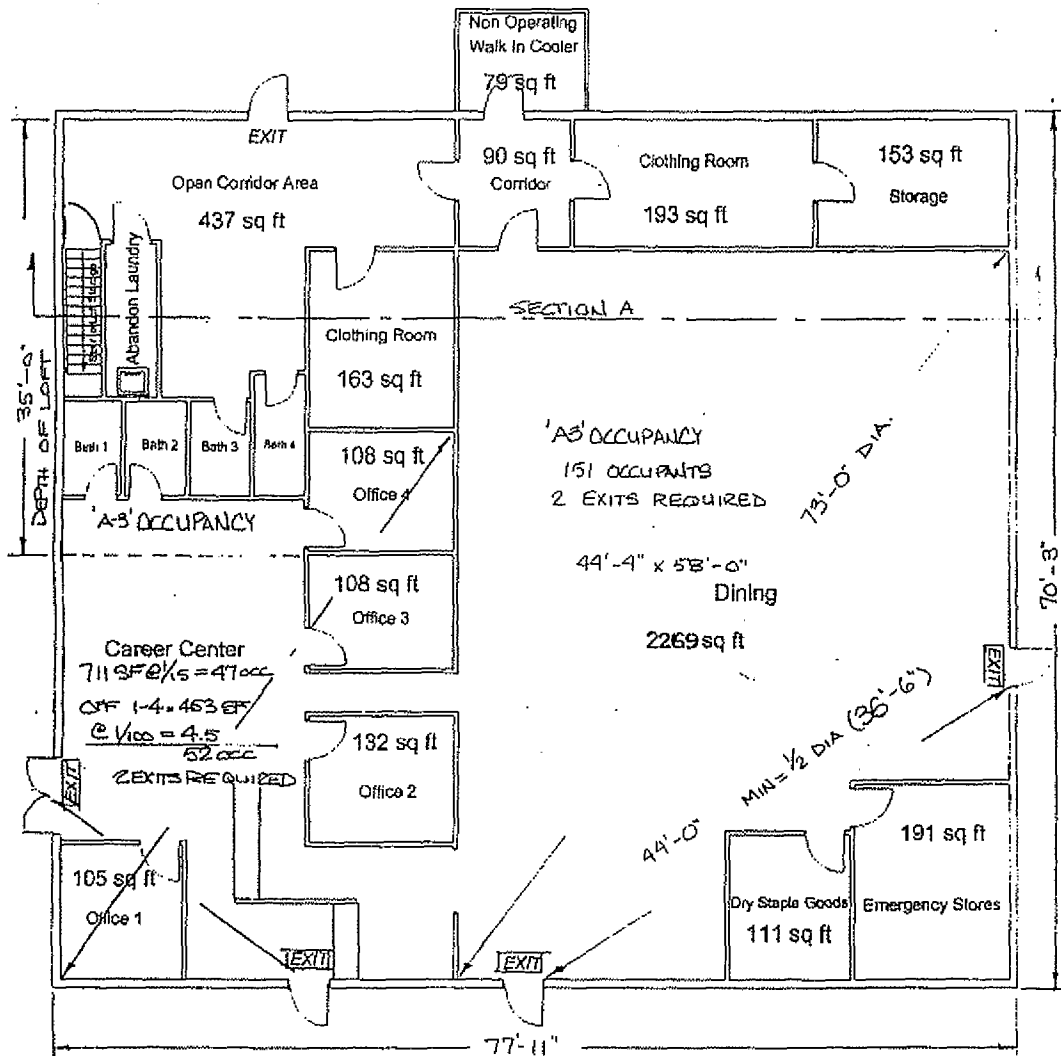

A3 OCC ROOMS TO HAVE
FIRE HARDWARE OF SIGN
(UNDER EXCEPT)
PER UBC 1007.2.5
A3 OCC ROOMS TO HAVE
OCCUPANCY POSTED
PER UBC 1007.2.6

PAGE A.1



5356 square feet
inside exterior
walls

5475 Total SF

SUP-35755
10/08/09 PC

