



PLANNING & DEVELOPMENT DEPARTMENT

STATEMENT OF FINANCIAL INTEREST

Case Number: VAR-35745 APN: 125-13-801-006
Name of Property Owner: KATHRYN LENHART/DARRELL PARSONS
Name of Applicant: KATHRYN LENHART/DARRELL PARSONS
Name of Representative: CHUCK LENHART

To the best of your knowledge, does the Mayor or any member of the City Council or Planning Commission have any financial interest in this or any other property with the property owner, applicant, the property owner or applicant's general or limited partners, or an officer of their corporation or limited liability company?

_____ Yes

X No

If yes, please indicate the member of the City Council or Planning Commission who is involved and list the name(s) of the person or persons with whom the City Official holds an interest. Also list the Assessor's Parcel Number if the property in which the interest is held is different from the case parcel.

City Official: _____

Partner(s): _____

APN: 125-13-801-006


Signature of Property Owner: Kathryn L. Lenhart Darrell Parsons


Print Name: Kathryn L. Lenhart / Darrell R. Parsons

Subscribed and sworn before me

This 11 day of Aug, 2009

Notary Public in and for said County and State

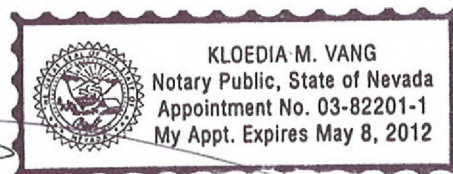


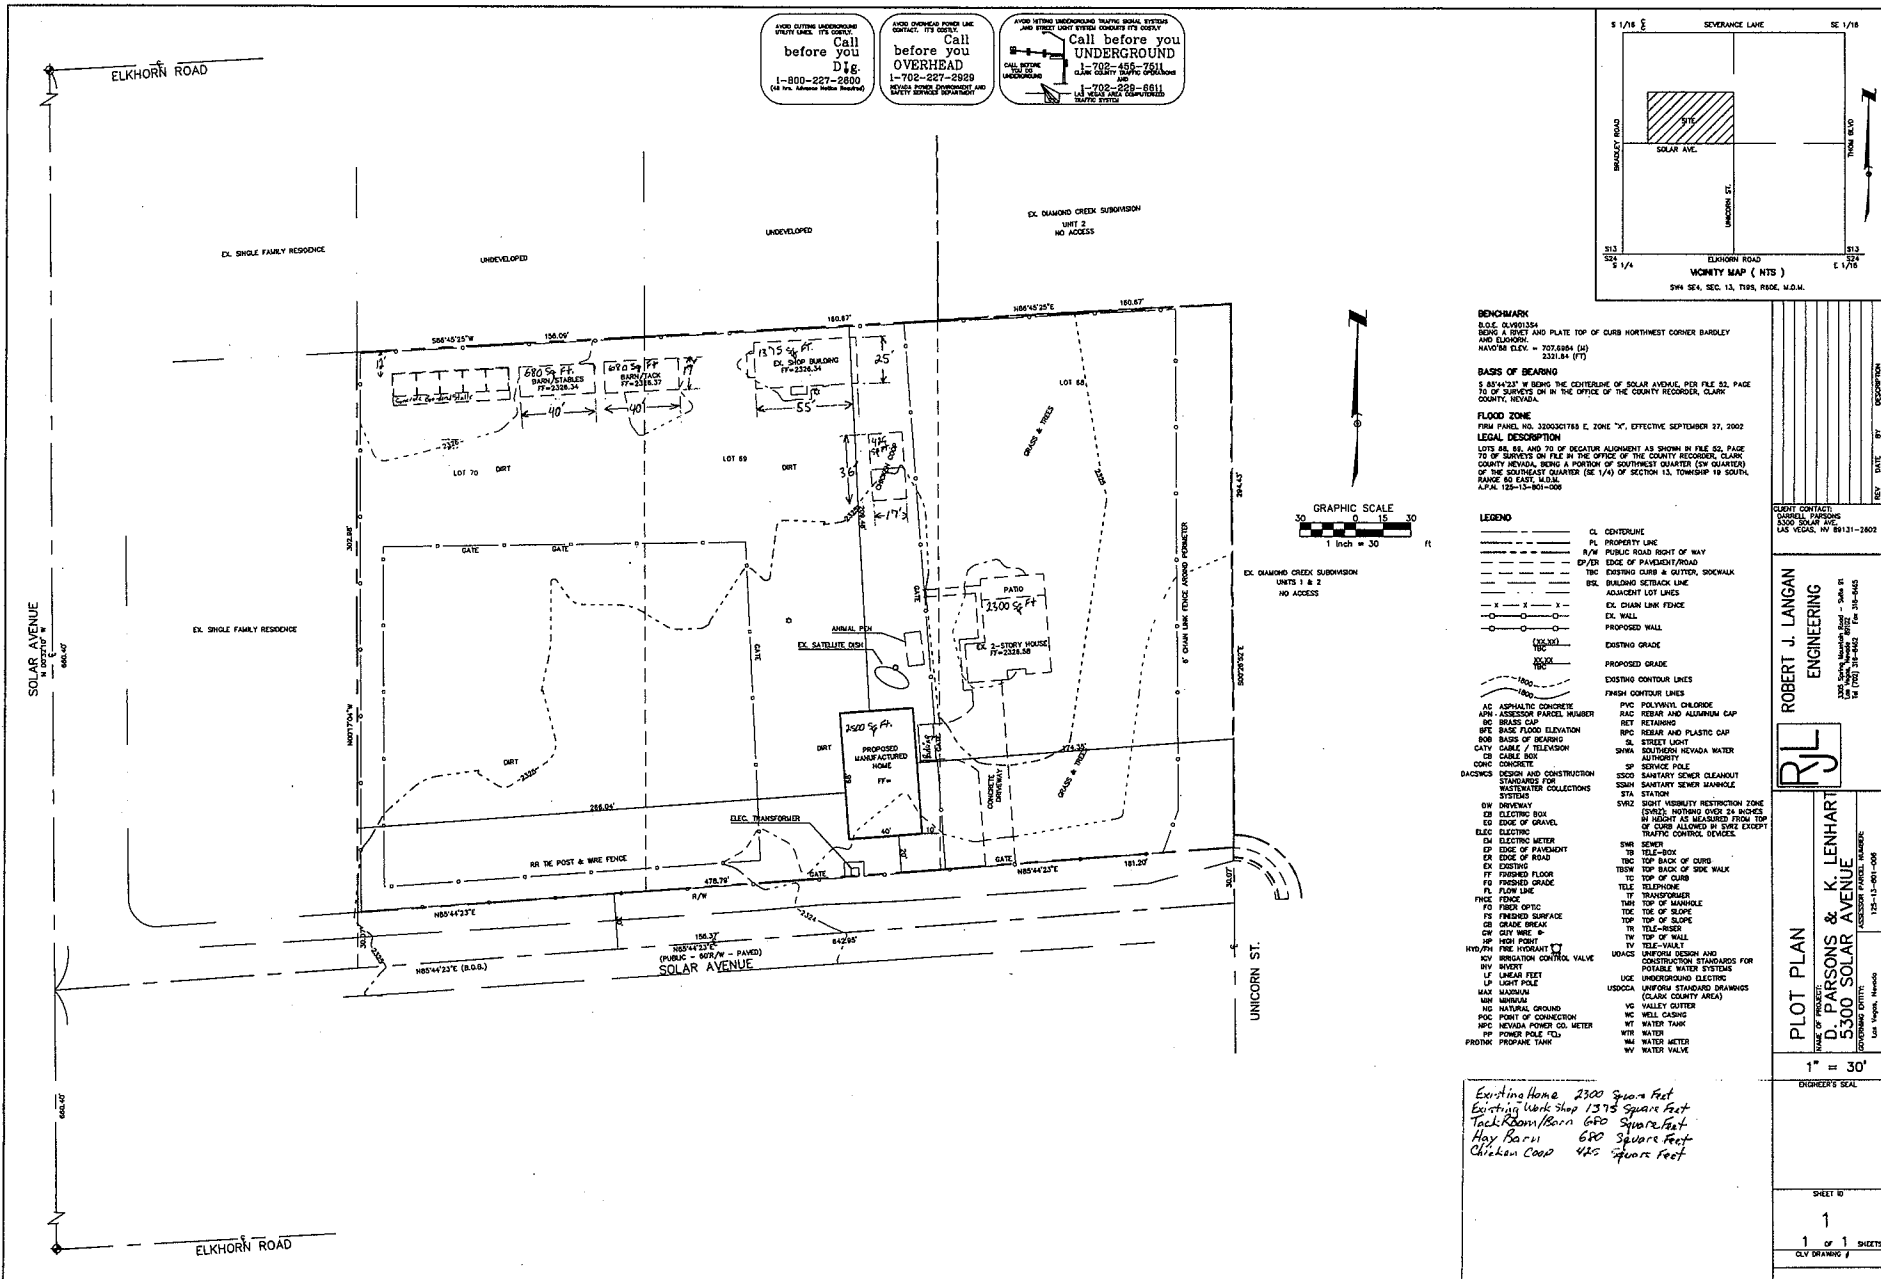

RECEIVED
SEP 21 2009

RECEIVED
AUG 25 2009

VAR-35745
SUP-35743
10/08/09 PC

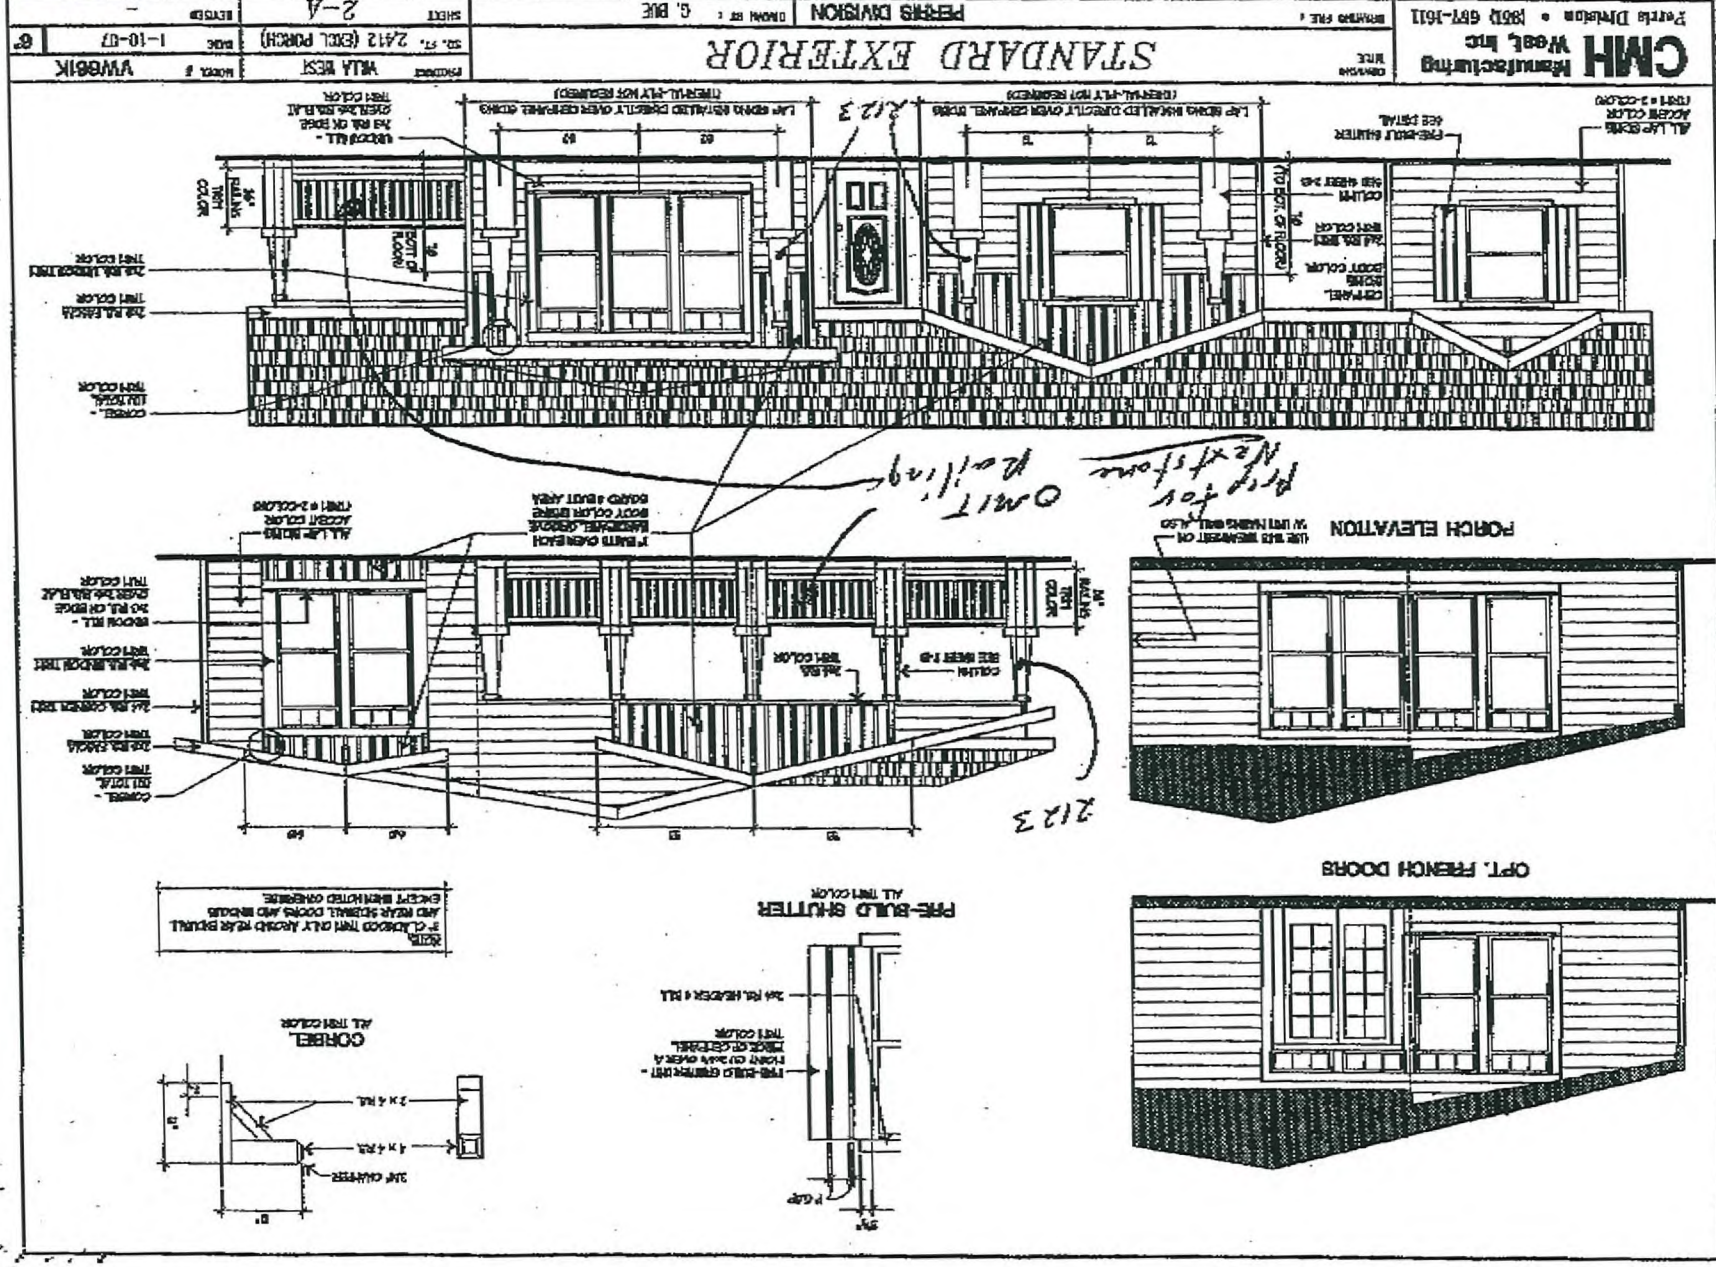


*Copy of Robert 6/3/09
Barrell Passers 6/3/09*

JUN-02-2009 17:54

GOLDEN WEST HOMES

P.005

Handwritten:
 6/2/09
 6/3/09
 Darrin
 P.005

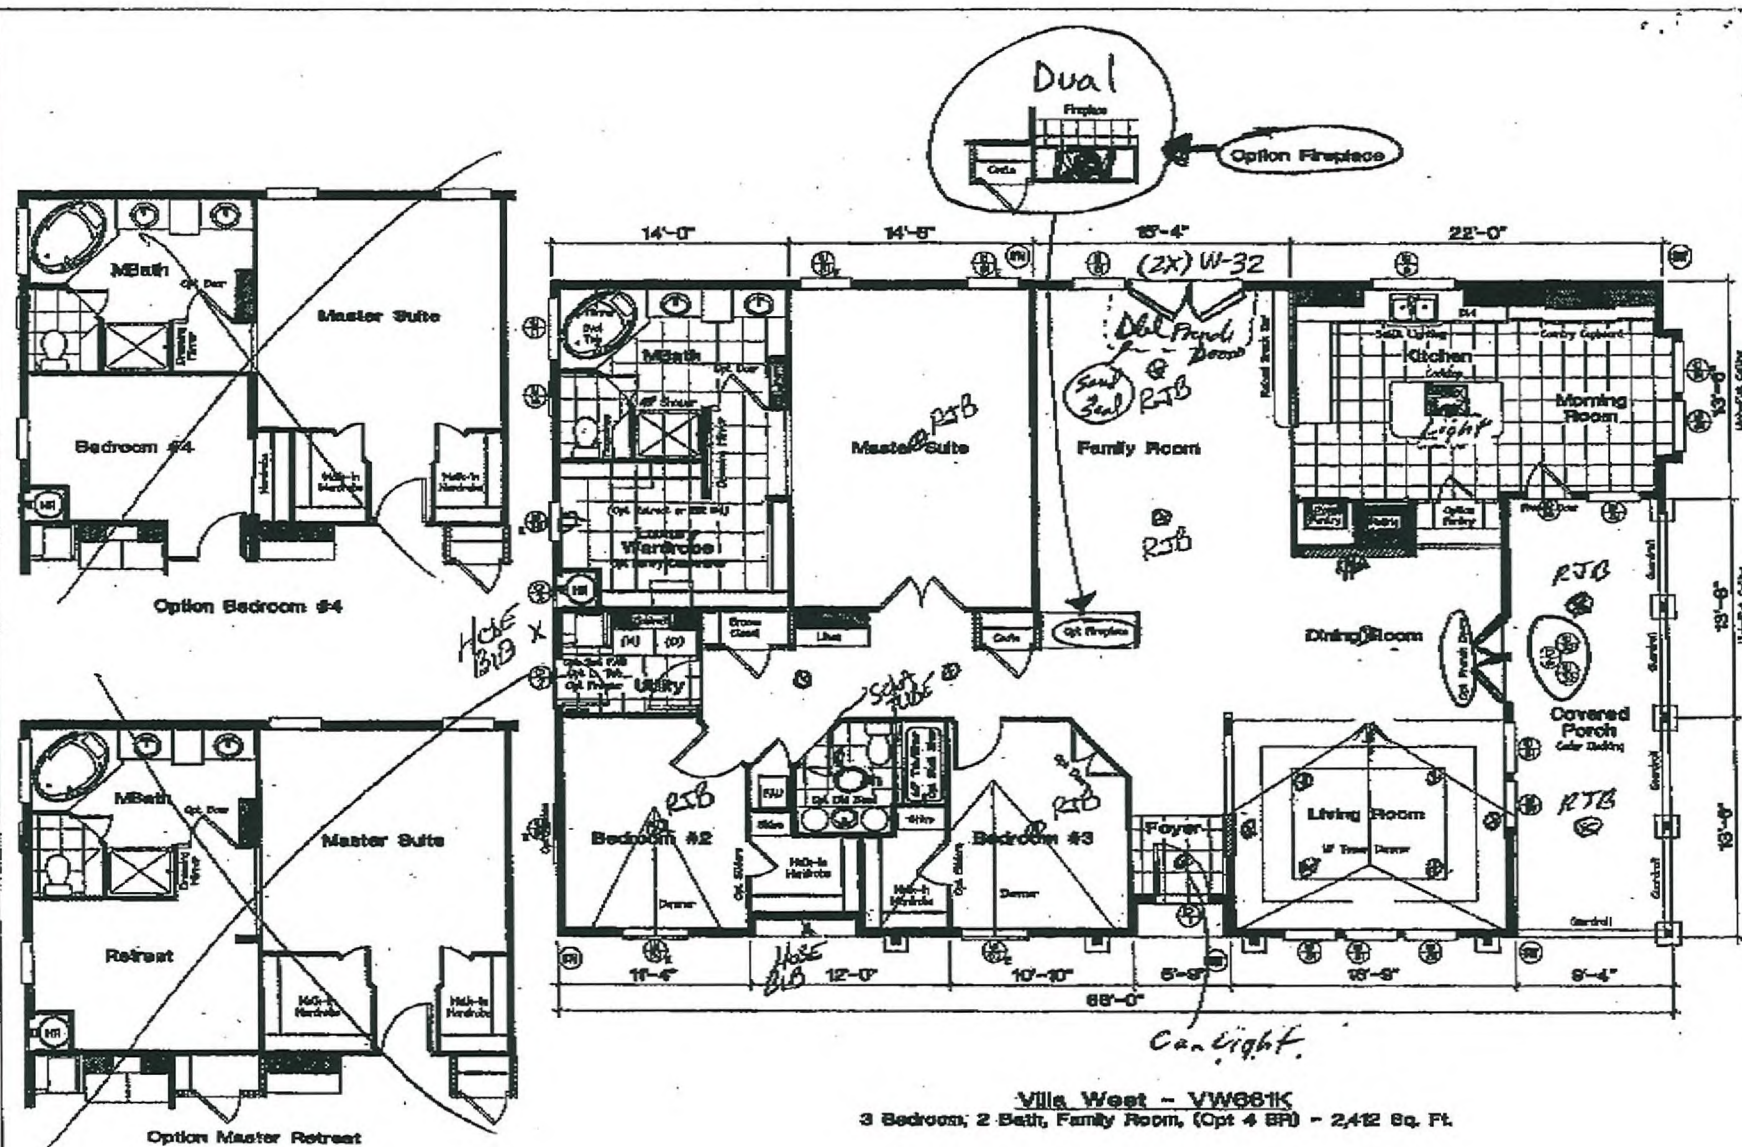

CMH Manufacturing
 West, Inc
 Perris Division • (951) 657-1611

ORIGINATOR
 TITLE

DRAWING FILE #

SALES FLOOR PLAN

PERRIS DIVISION

DRAWN BY: G. BUE

PRODUCT VILLA WEST

SQ. FT. 2,412 (EXCL PORCH)

SHEET 1-A1

MODEL # VW881K

DATE 1-10-07

REVISED -

VAR-35745
SUP-35743
10/08/09 PC

RECEIVED

AUG 25 2009